


SITE PLAN
SHOWING "AS BUILT" WATER DISTRIBUTION SYSTEM

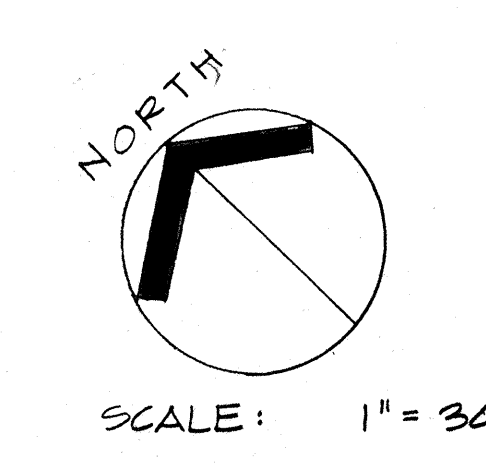

LEGEND
W.M. WATER METER

SEA PINES
CORPORATION

TOWN OF LONGBOAT KEY, FLORIDA		DESIGNED BY		PROJECT ENGINEER	
LONGBEACH VILLAGE SOUTH		DATE:		CHECKED BY	
8951 GULF OF MEXICO DRIVE		BY		DRAWN BY	
ENGINEER & ARCHITECT		REVISION		PROJECT NO.	
SHEET NUMBER		SCALE:		DATE:	
G-A		BY		CHECKED BY	
REVISION		BY		PROJECT NO.	
T.L.K. FILE NO.		BY		PROJECT NO.	
G-1217-103		BY		PROJECT NO.	