


S I T E P L A N

SHOWING "AS BUILT" WASTEWATER COLLECTION SYSTEM

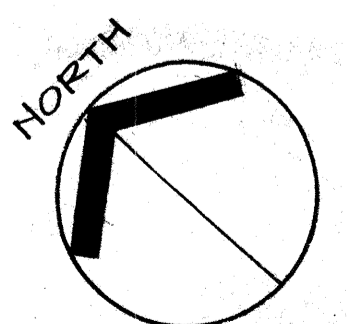

SCALE: 1" = 30'

DESIGNED BY	PROJECT ENGINEER	DATE	BY	SCALE	REVISION	L.T.R.	DATE
CHECKED BY	PROJECT NO.	DRAWN BY	REVISION				
<p>TOWN OF LONGBOAT KEY, FLORIDA LONGBEACH VILLAGE SOUTH 6951 GULF OF MEXICO DRIVE</p>							
<p>REVISION</p>							
<p>SHEET NUMBER 60-A</p>							
<p>T.L.K. FILE NO. 9-1217-365</p>							

SEA PINES
COWD