


S I T E P L A N
 SHOWING "AS BUILT" WASTEWATER COLLECTION SYSTEM

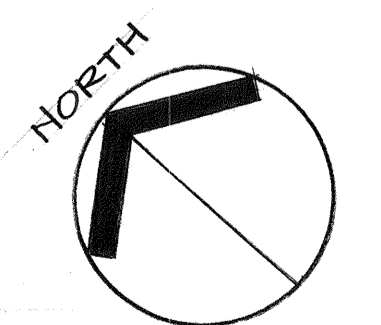

SCALE: 1" = 30'

SEA PINES
 COND

PROJECT ENGINEER James R. [Signature]	DESIGNED BY	DATE:	SCALE:	BY	REVISION	LTR.	DATE
PROJECT NO. 16578	CHECKED BY	CHECKED BY	DRAWN BY				
TOWN OF LONGBOAT KEY, FLORIDA LONGBEACH VILLAGE SOUTH 0951 GULF OF MEXICO DRIVE							
ENGINEER & LOCATION	SHEET NUMBER						
T.L.K. FILE NO.	REVISION						

SEA PINES

SEA PINES