


SITE PLAN
SHOWING "AS BUILT" WATER DISTRIBUTION SYSTEM

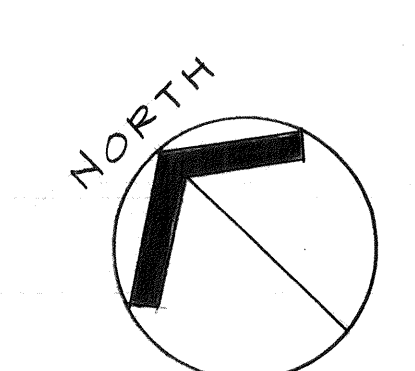

SCALE: 1" = 30'

LEGEND
W.M. WATER METER

SEA PIPES
CORRO.

PROJECT ENGINEER	DESIGNED BY	DATE:	SCALE:	BY	REVISION	L.T.R.	DATE	TOWN OF LONGBOAT KEY, FLORIDA
Checked by [Signature]	PROJECT NO.	CHECKED BY	DRAWN BY					LONGBEACH VILLAGE SOUTH
								6951 GULF OF MEXICO DRIVE
								ENGINEER'S LOCATION
								SHEET NUMBER
								REVISION
								T.L.K. FILE NO.

SEA PINES CONDO