
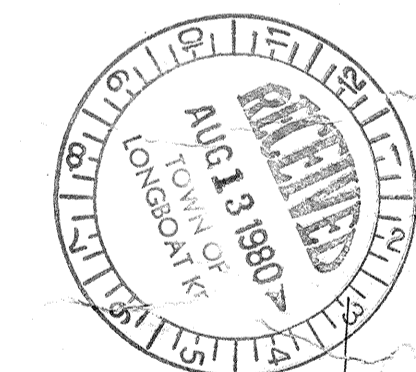


GULF OF MEXICO

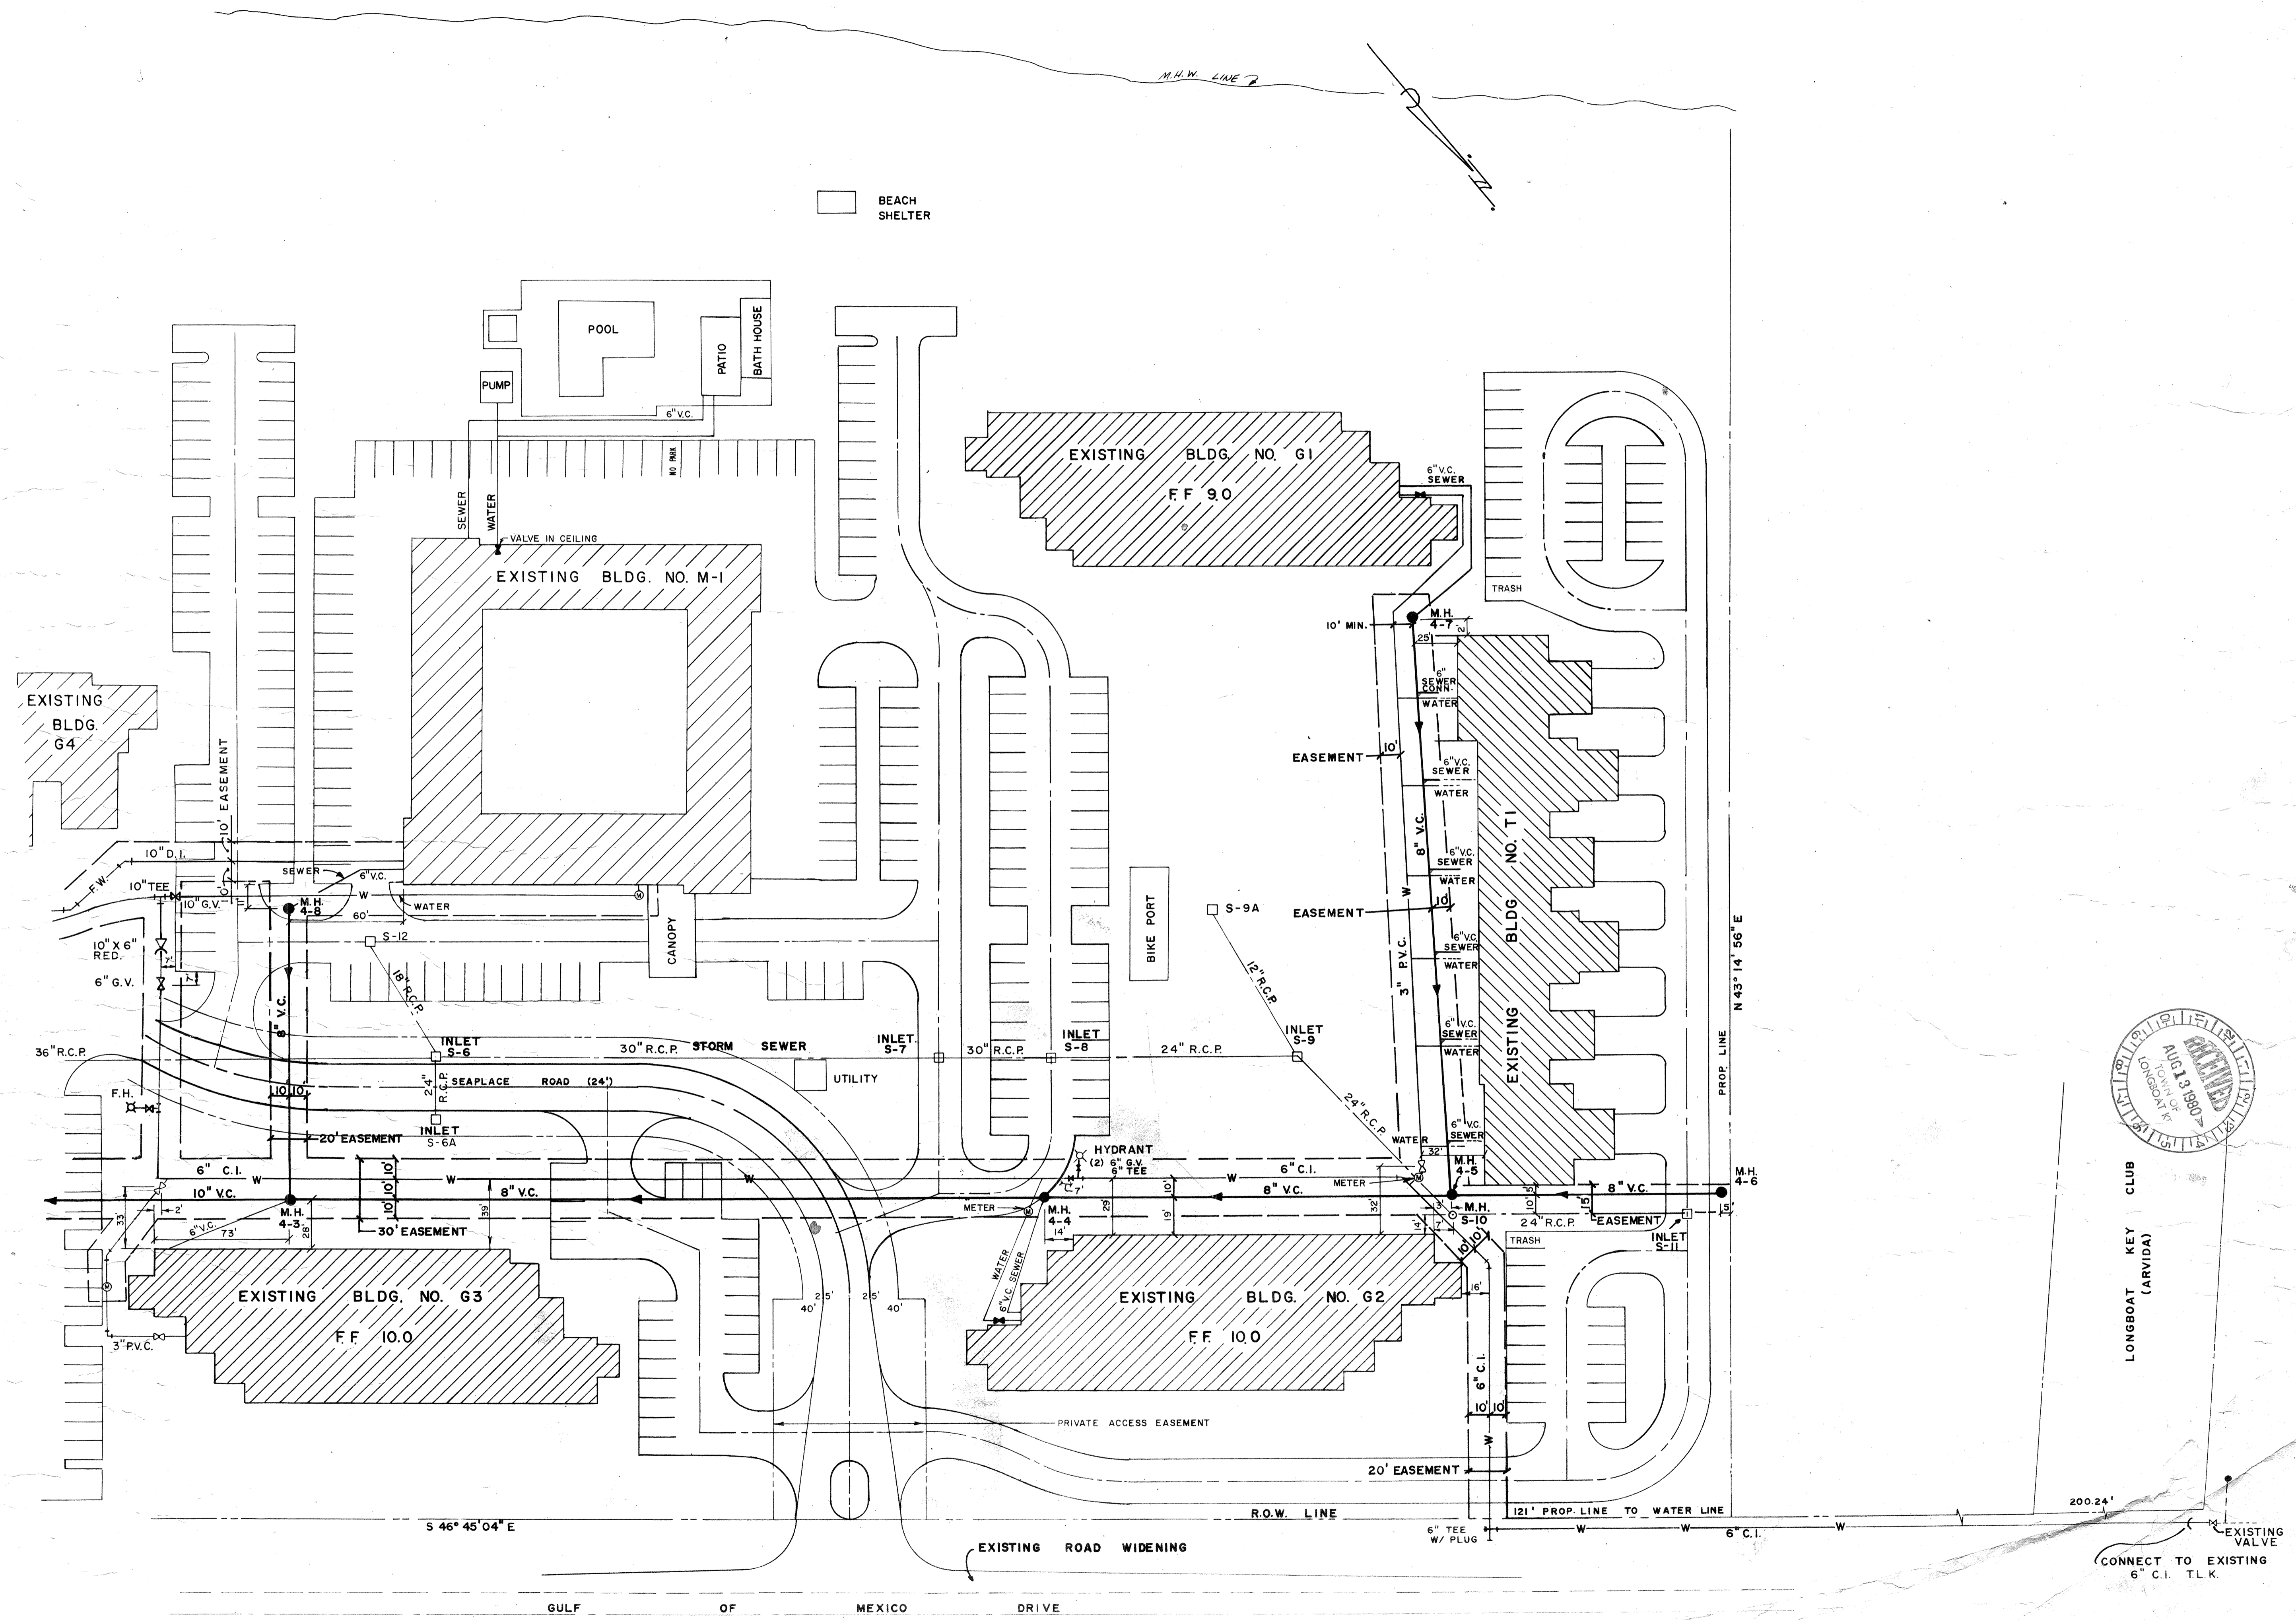

DESIGNED BY PROJECT ENGINEER	
DATE: 12-3-73	BY SCALE: 1" = 40'
REVISION	DRAWN BY G.L.B.
WAS SHT. NO. W/S-4-B	CHECKED BY PROJECT NO.
4-8-80	7-25-80
ADDED LOCATION DIMENSIONS, DELETED W/S - N-ND BLDG. 0-3.	
L.T.R. DATE	
TOWN OF LONGBOAT KEY, FLORIDA SEAPLACE WATER DISTRIBUTION & SEWAGE COLLECTION ENGINEER BENNETT & BISHOP INC. SARASOTA, FLA.	
SHEET NUMBER	217-060AB
REVISION	