


GULF OF MEXICO

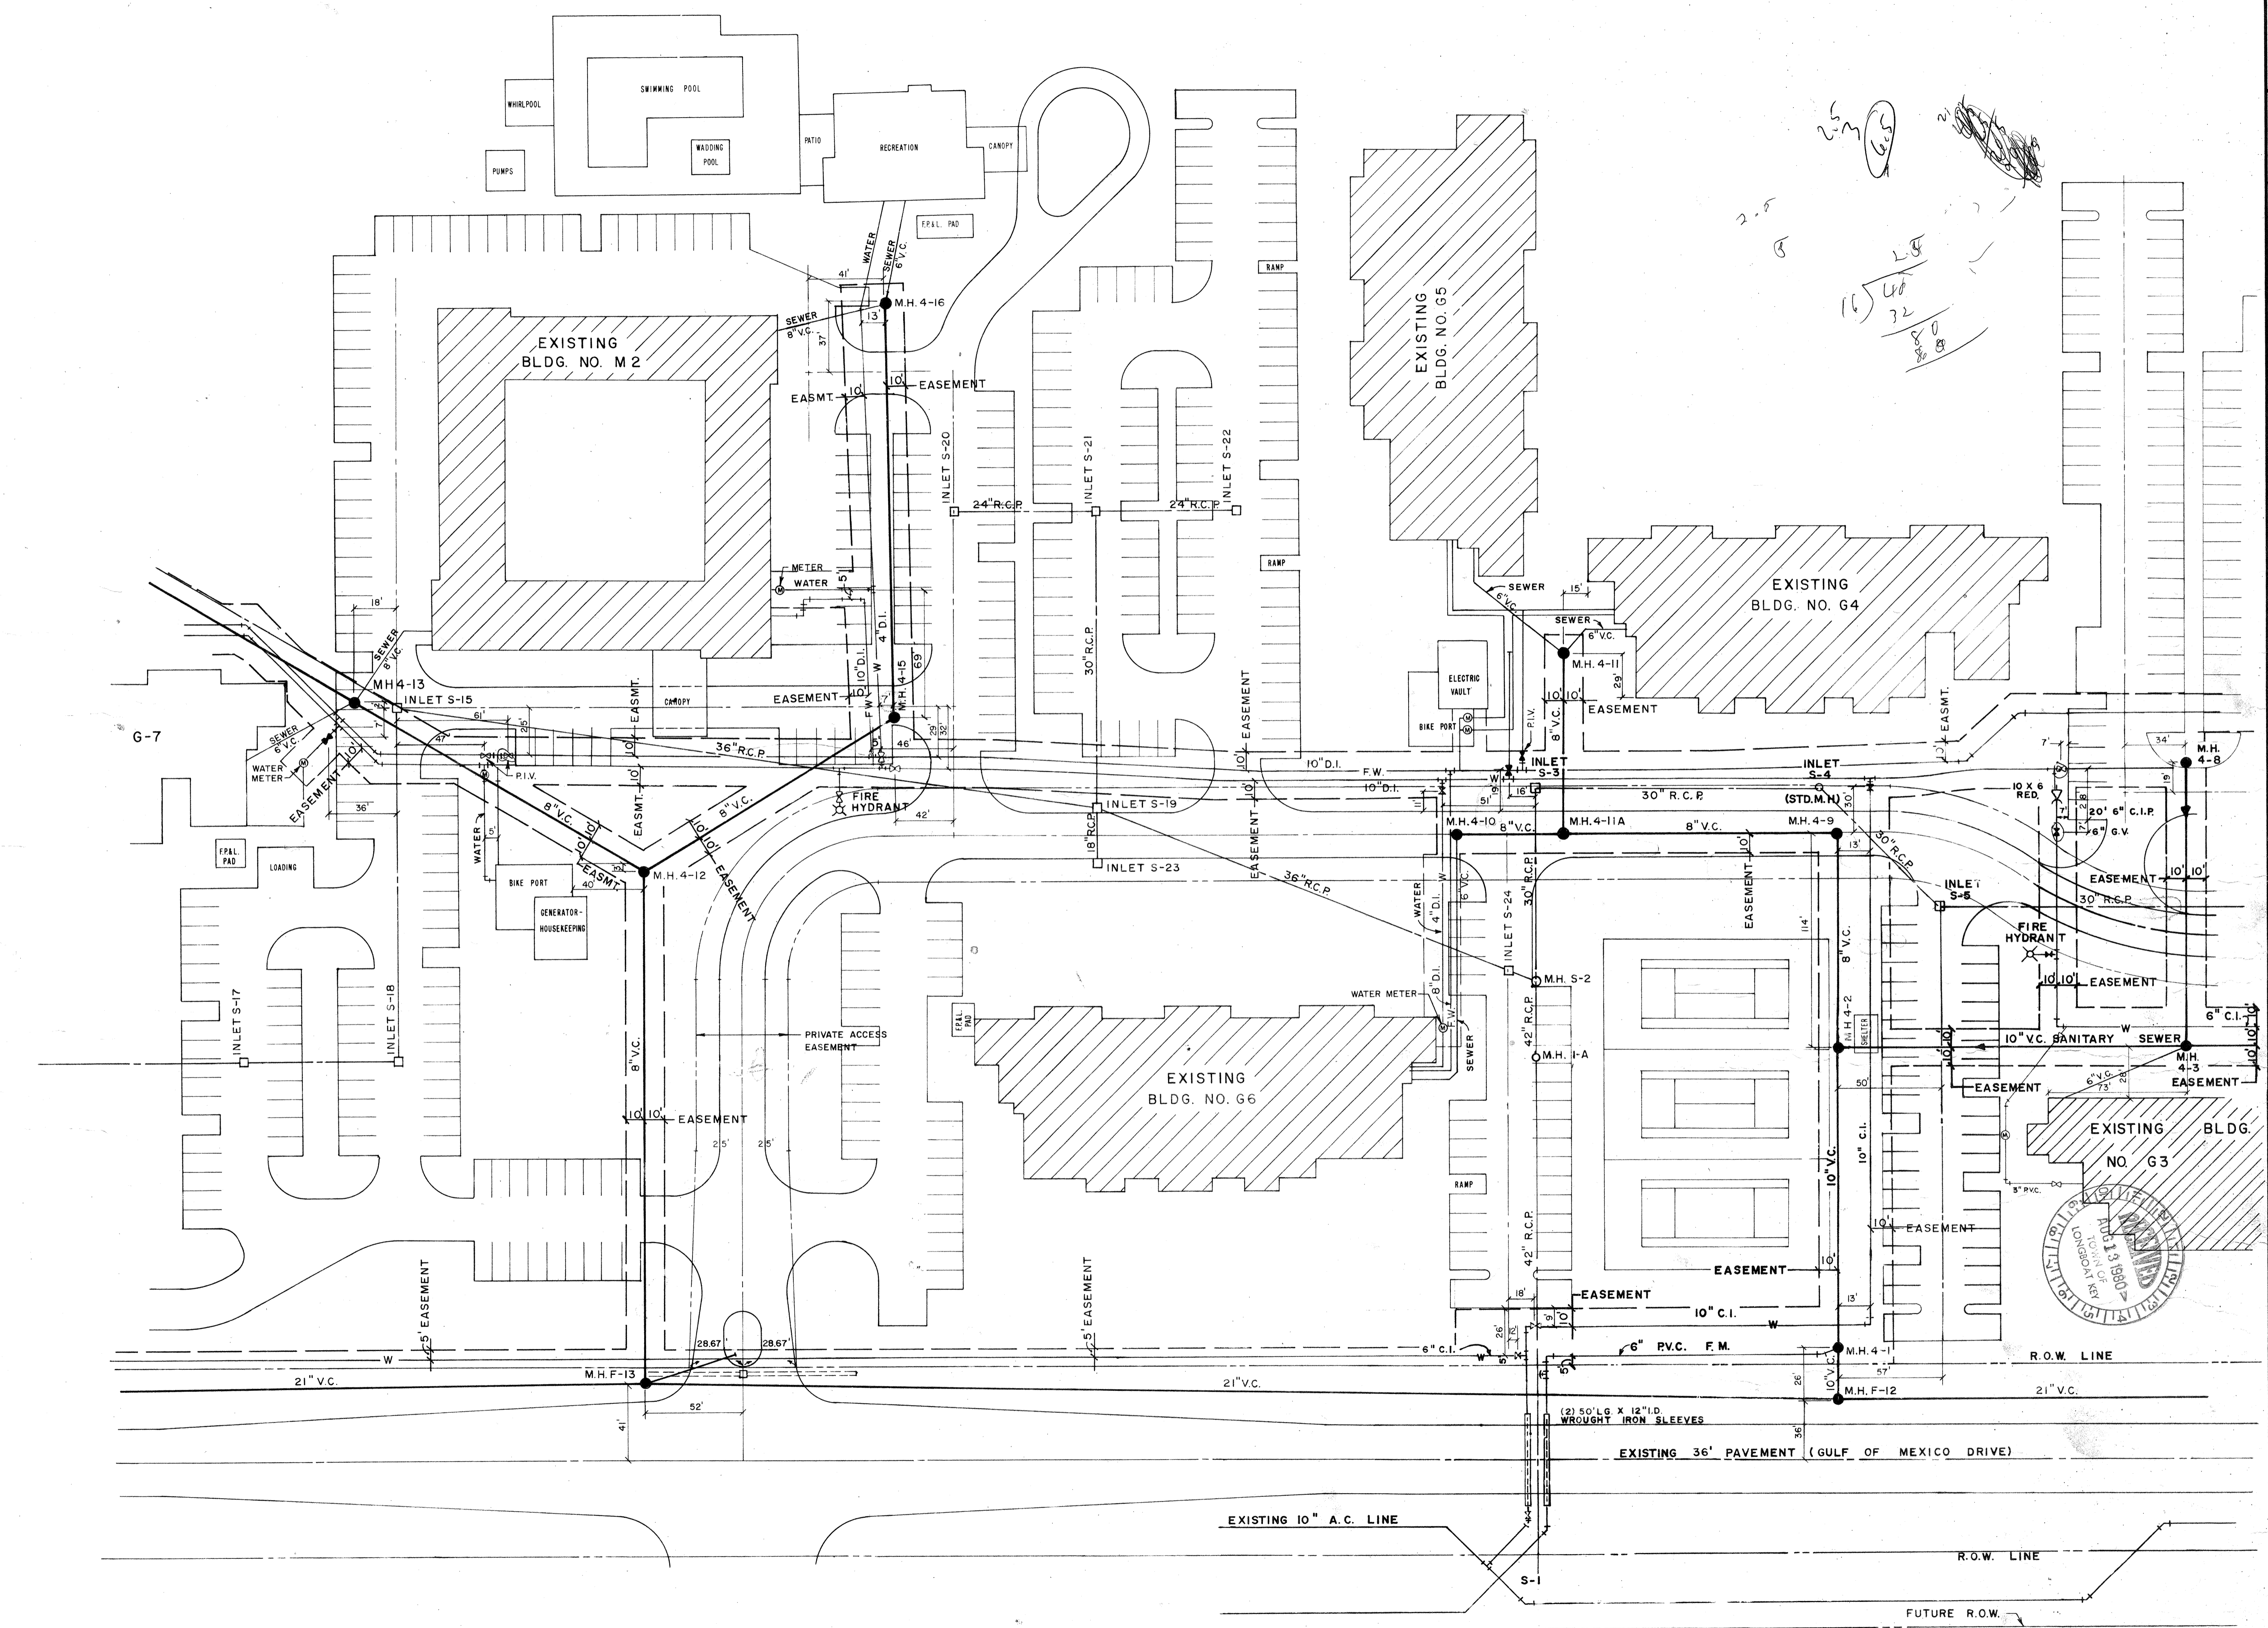

DESIGNED BY	PROJECT ENGINEER
DATE	12-3-73
SCALE	1" = 40'
CHECKED BY	G.L.B.
BY	R.A.B.
REVISION	WAS SHIT. NO. W/S-4 7-25-80 ADDED LOCATION DIMENSIONS DELETED W.S. N. SIDE BLDG G-4.
DATE	4-8-80
L.T.R.	
<b>TOWN OF LONGBOAT KEY, FLORIDA</b>	
<b>SEAPLACE</b>	
WATER DISTRIBUTION & SEWAGE COLLECTION	
ENGINEER BENNETT & BISHOP, INC., SARASOTA, FLA.	
SHEET NUMBER	217-061AB
REVISION	