


GULF OF MEXICO

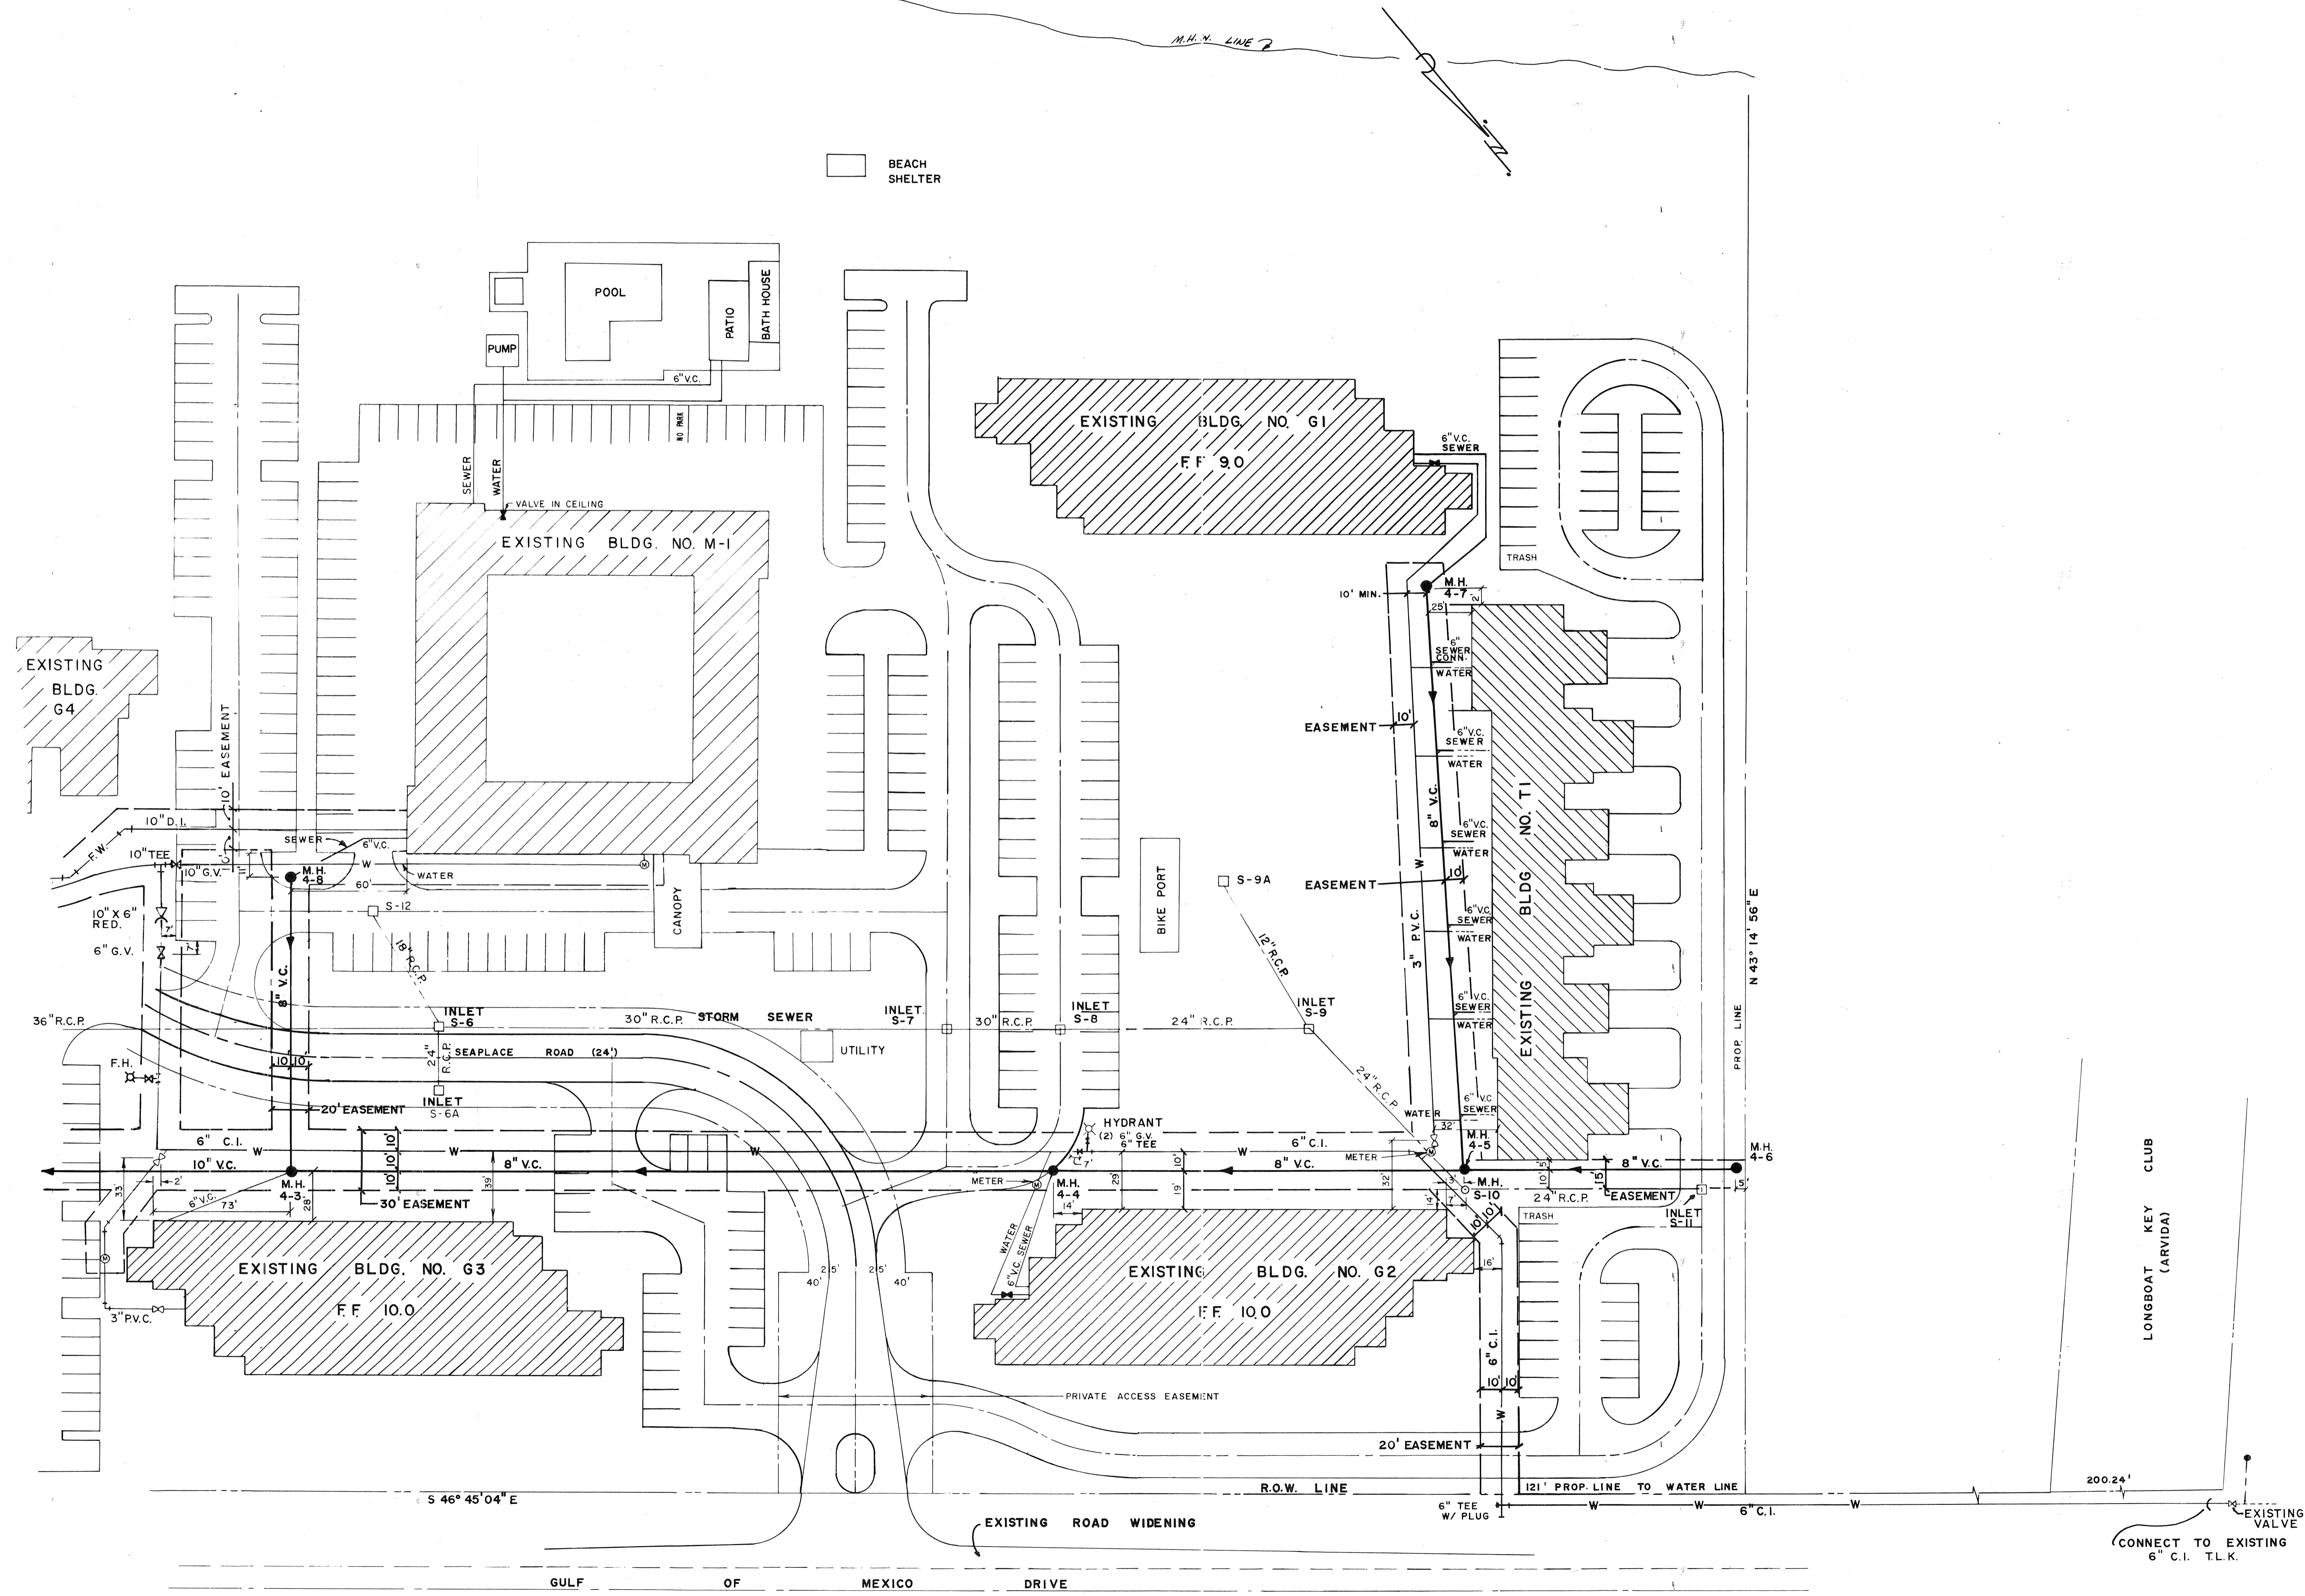

TOWN OF LONGBOAT KEY, FLORIDA		DESIGNED BY PROJECT ENGINEER	
SEA PLACE		DATE: 12-3-73	CHECKED BY PROJECT NO.
WATER DISTRIBUTION & SEWAGE COLLECTION		SCALE: 1" = 40'	DRAWN BY PROJECT NO.
ENGINEER BENNETT & BISHOP INC., SARASOTA, FLA.		BY R.A.B.	G.L.R.
SHEET NUMBER 217-060AB		REVISION	
REVISION		L.T.R. DATE: 4-8-80 7-25-80 WAS SHT. NO. W/S-4-B ADDED LOCATION DIMENSIONS, DELETED W.S.-N-END BLDG. G-3.	
T.L.K. FILE NO.		SEA PLACE	