


GULF OF MEXICO

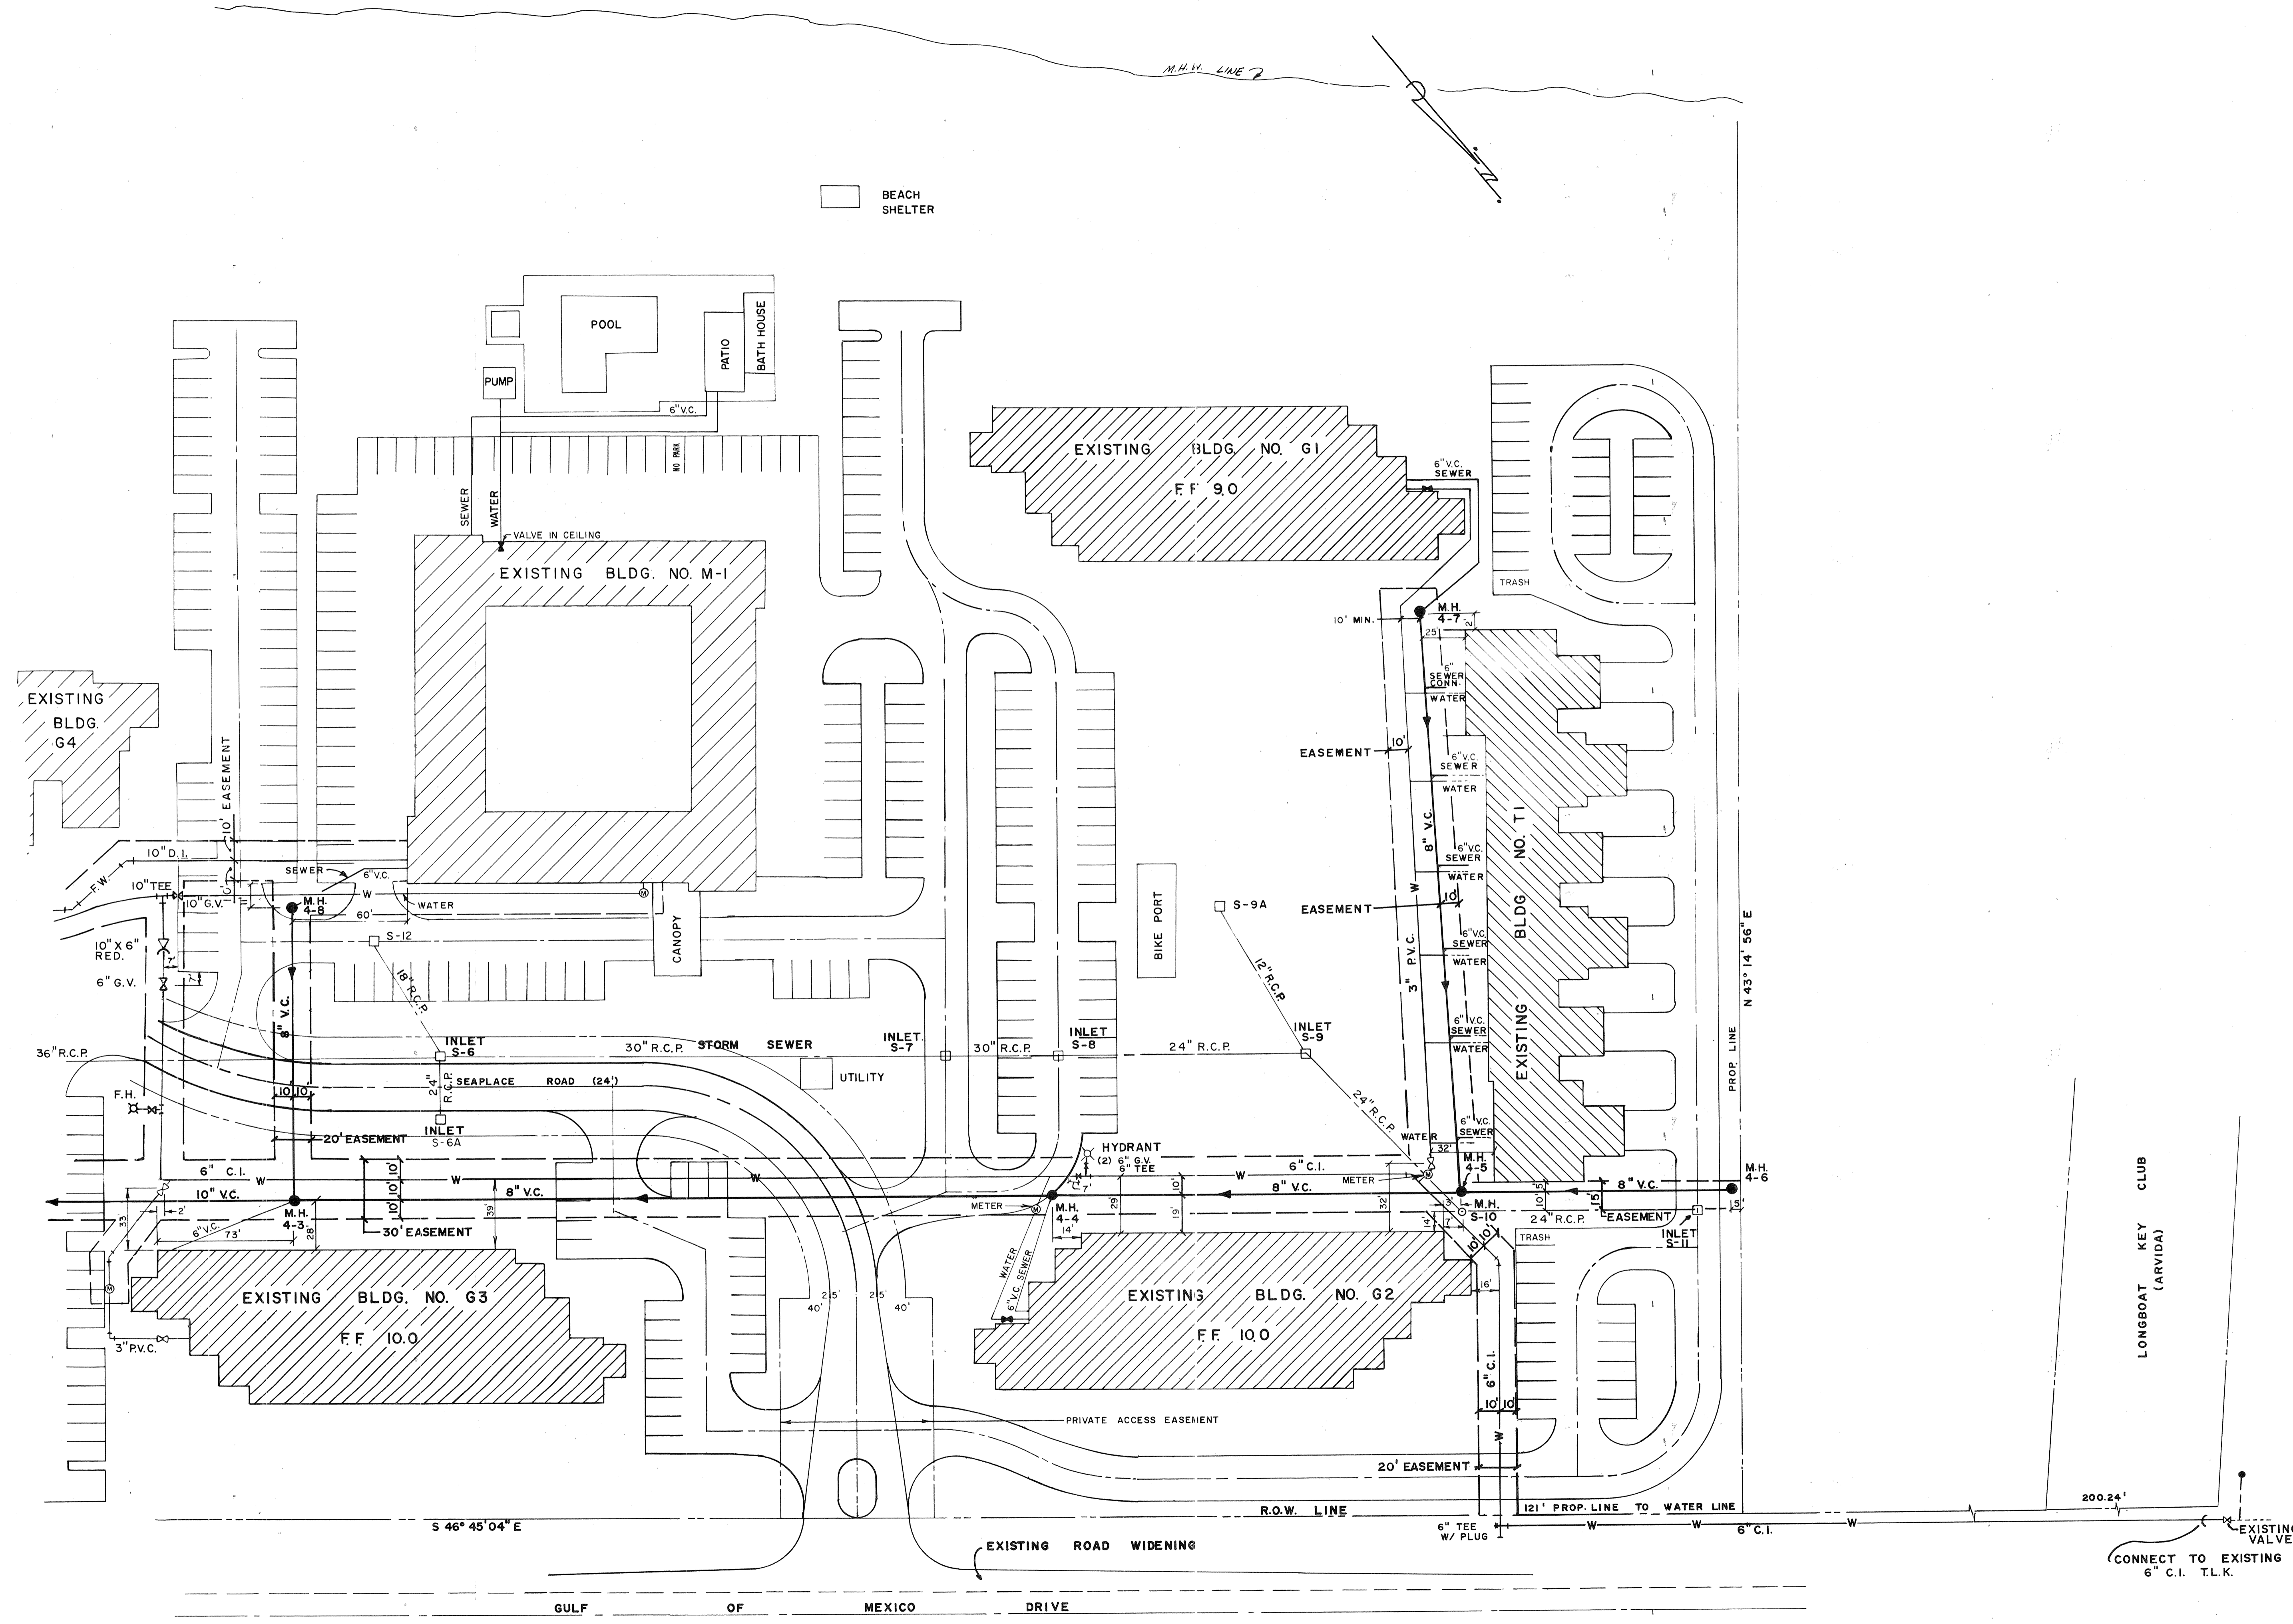

TOWN OF LONGBOAT KEY, FLORIDA		DESIGNED BY PROJECT ENGINEER	
SEAPLACE		DATE 12-3-73	CHECKED BY PROJECT NO.
WATER DISTRIBUTION & SEWAGE COLLECTION		SCALE 1" = 40'	DRAWN BY G.L.B.
ENGINEER BENNETT & BISHOP INC., SARASOTA, FLA.		BY R.A.B.	
REVISION		DATE 4-8-80	REVISION WAS SHT. NO. W/S-4-B
		DATE 7-25-80	REVISION ADDED LOCATION DIMENSIONS, DELETED W.S.-N END BLDG. G-3.
SHEET NUMBER 217-060AB		T.L.K. FILE NO.	