


NOTES
 UNIT NO - 4 digit numbers, 1st digit is Bldg No.
 2nd digit is Floor Level, 3rd & 4th
 digits are Unit Numbers

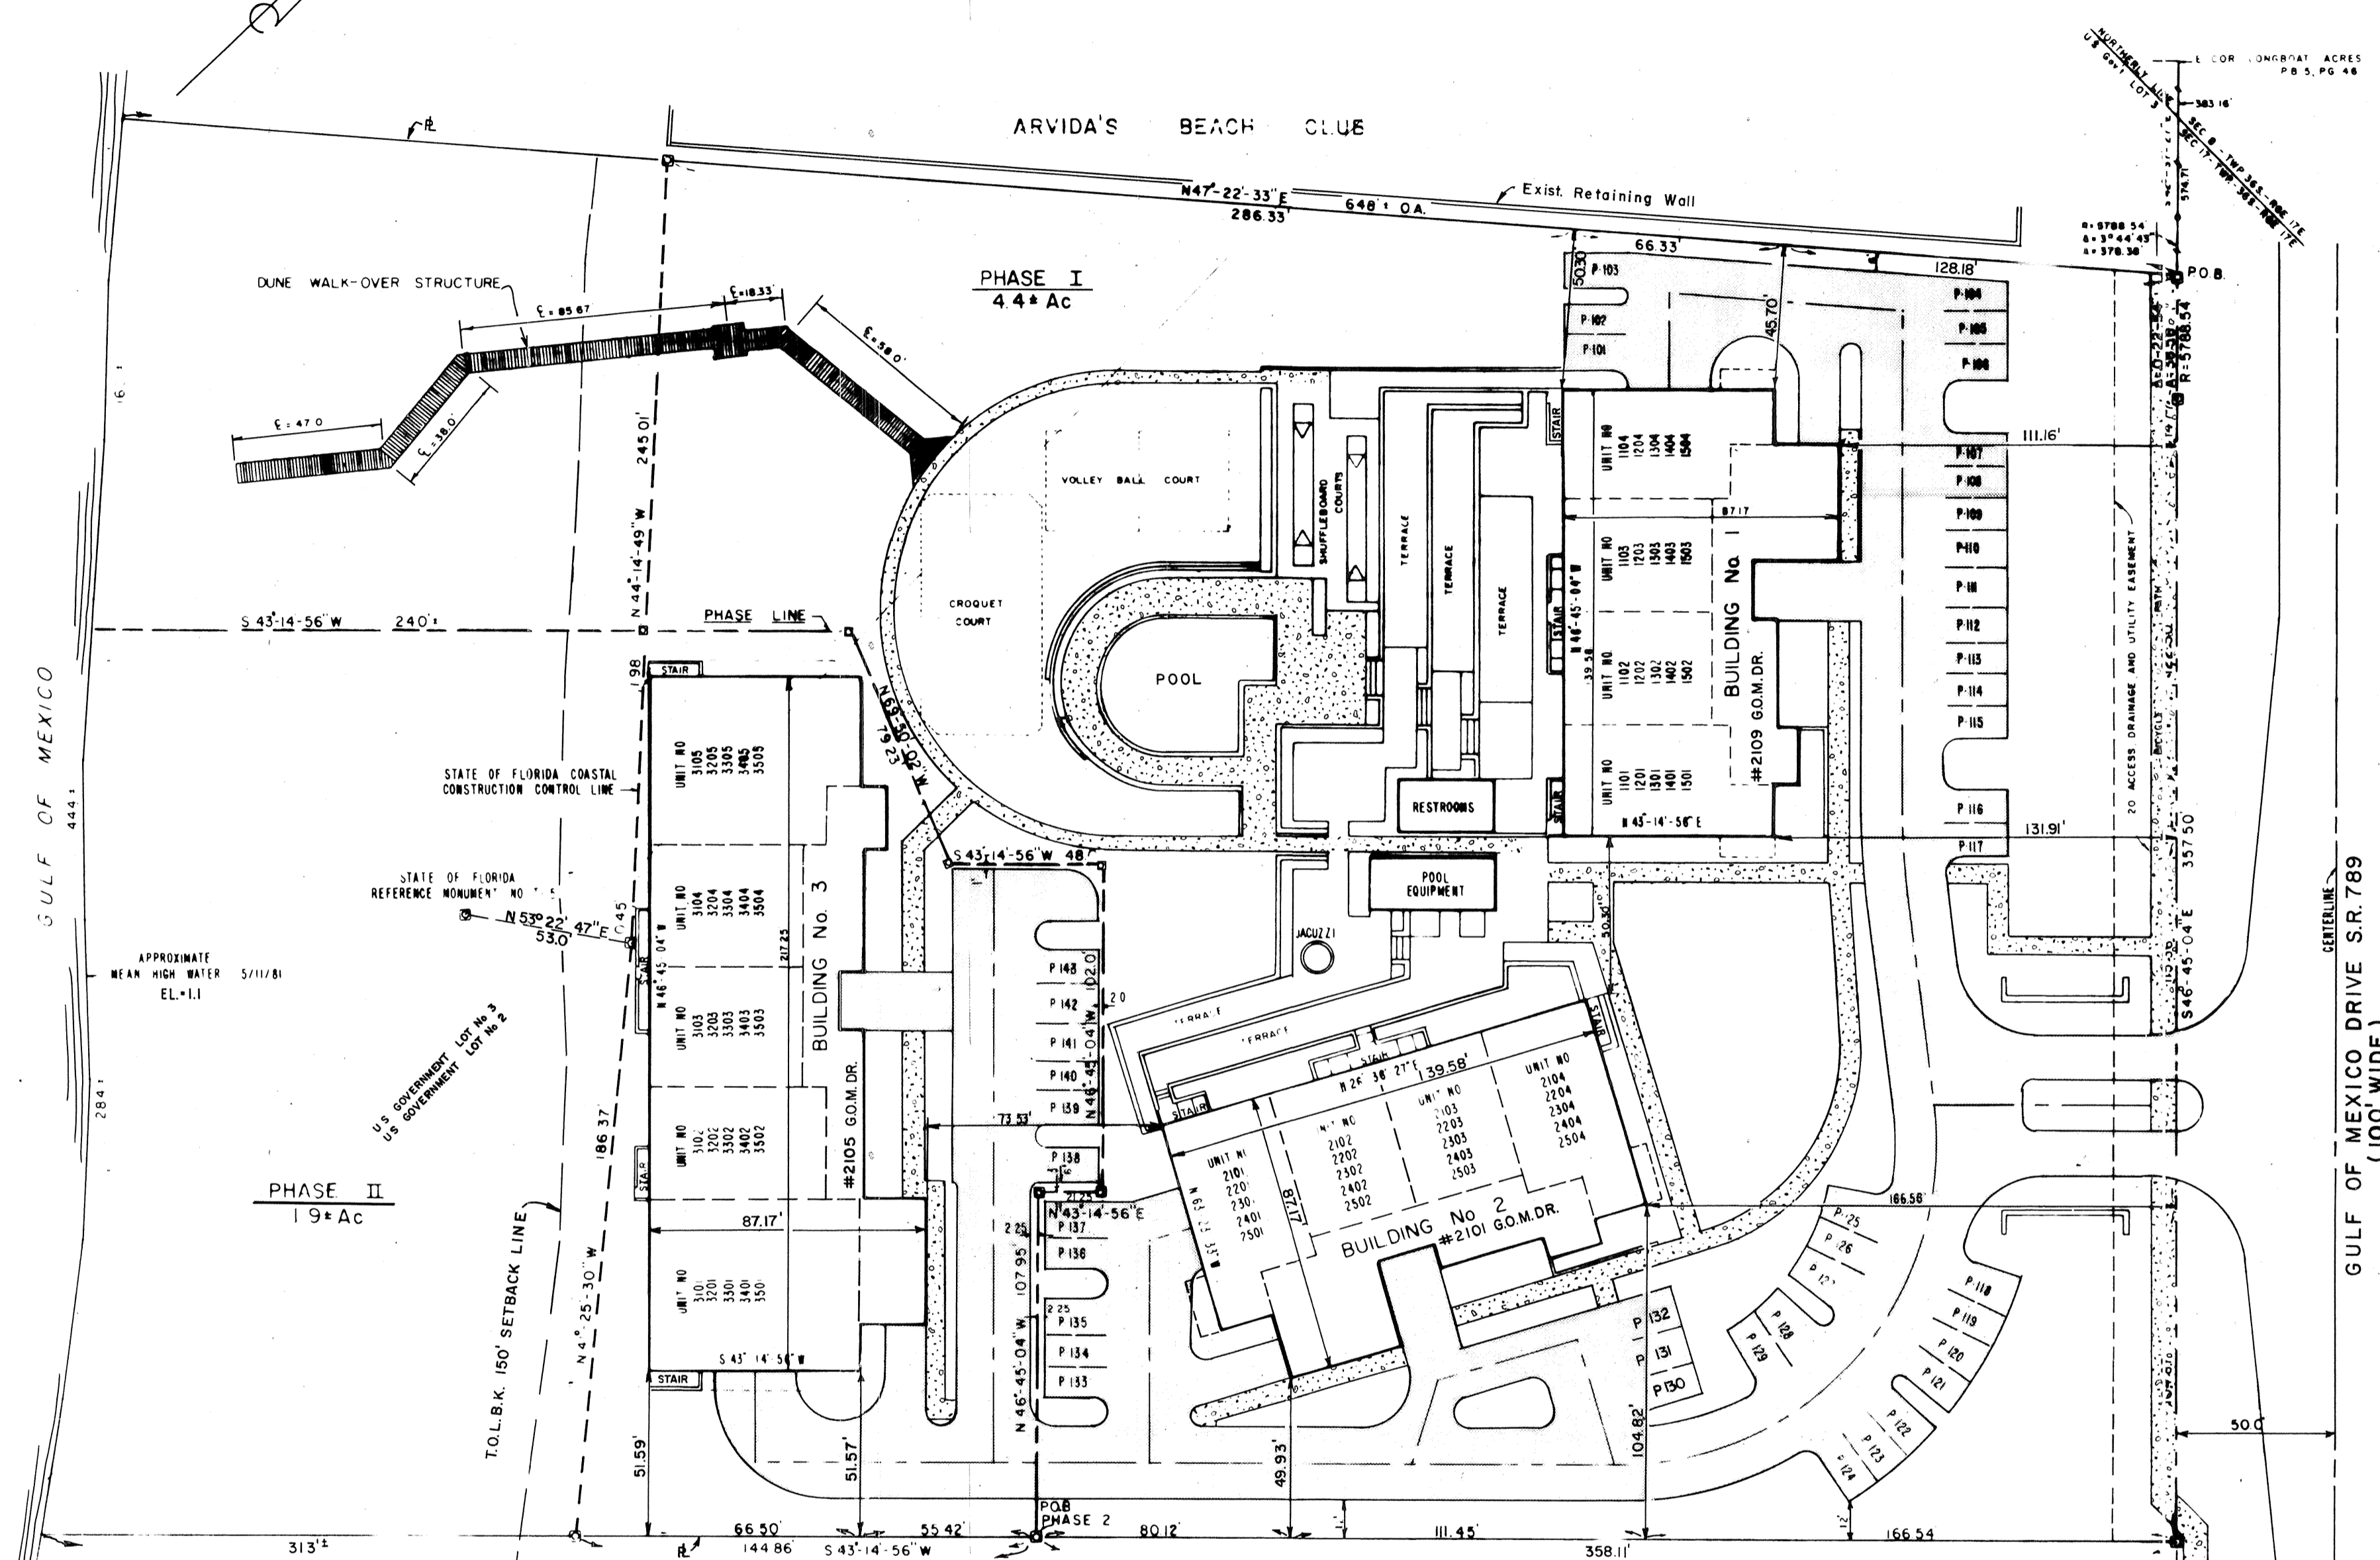

SEAPLACE I CONDOMINIUM
 CB 7 PG 9
MASTER PLOT PLAN

- LEGEND**
- — PERMANENT REFERENCE MONUMENT
 - B.L.P. — BUILDING LOCATION POINT
 - P 109 — PARKING SPACE
 - PC 205 — COVERED PARKING SPACE

| | | | |
|--|--|------------------------------|------------------------|
| TOWN OF LONGBOAT KEY, FLORIDA | | DESIGNED BY PROJECT ENGINEER | |
| ARVIDA CORPORATION | | DATE | CHECKED BY PROJECT NO. |
| AS BUILT | | SCALE: 1" = 40' | DRAWN BY PROJECT NO. |
| ENGINEER & SURVEYORS | | BY R.W.C. | BY R.W.C. |
| BENNETT & BISHOP INC., ENGINEERS & SURVEYORS | | REVISION | REVISION |
| 4509 BEE RIDGE ROAD SARASOTA, FLORIDA | | DATE 7-3-65 | ADDED M.H.W. EL. |
| SHEET NUMBER | | 191-537AB | |
| REVISION | | T.L.K. FILE NO. | |