


NOTES
 UNIT NO - 4 digit numbers, 1st digit is Bldg No.,
 2nd digit is Floor Level, 3rd & 4th
 digits are Unit Numbers.

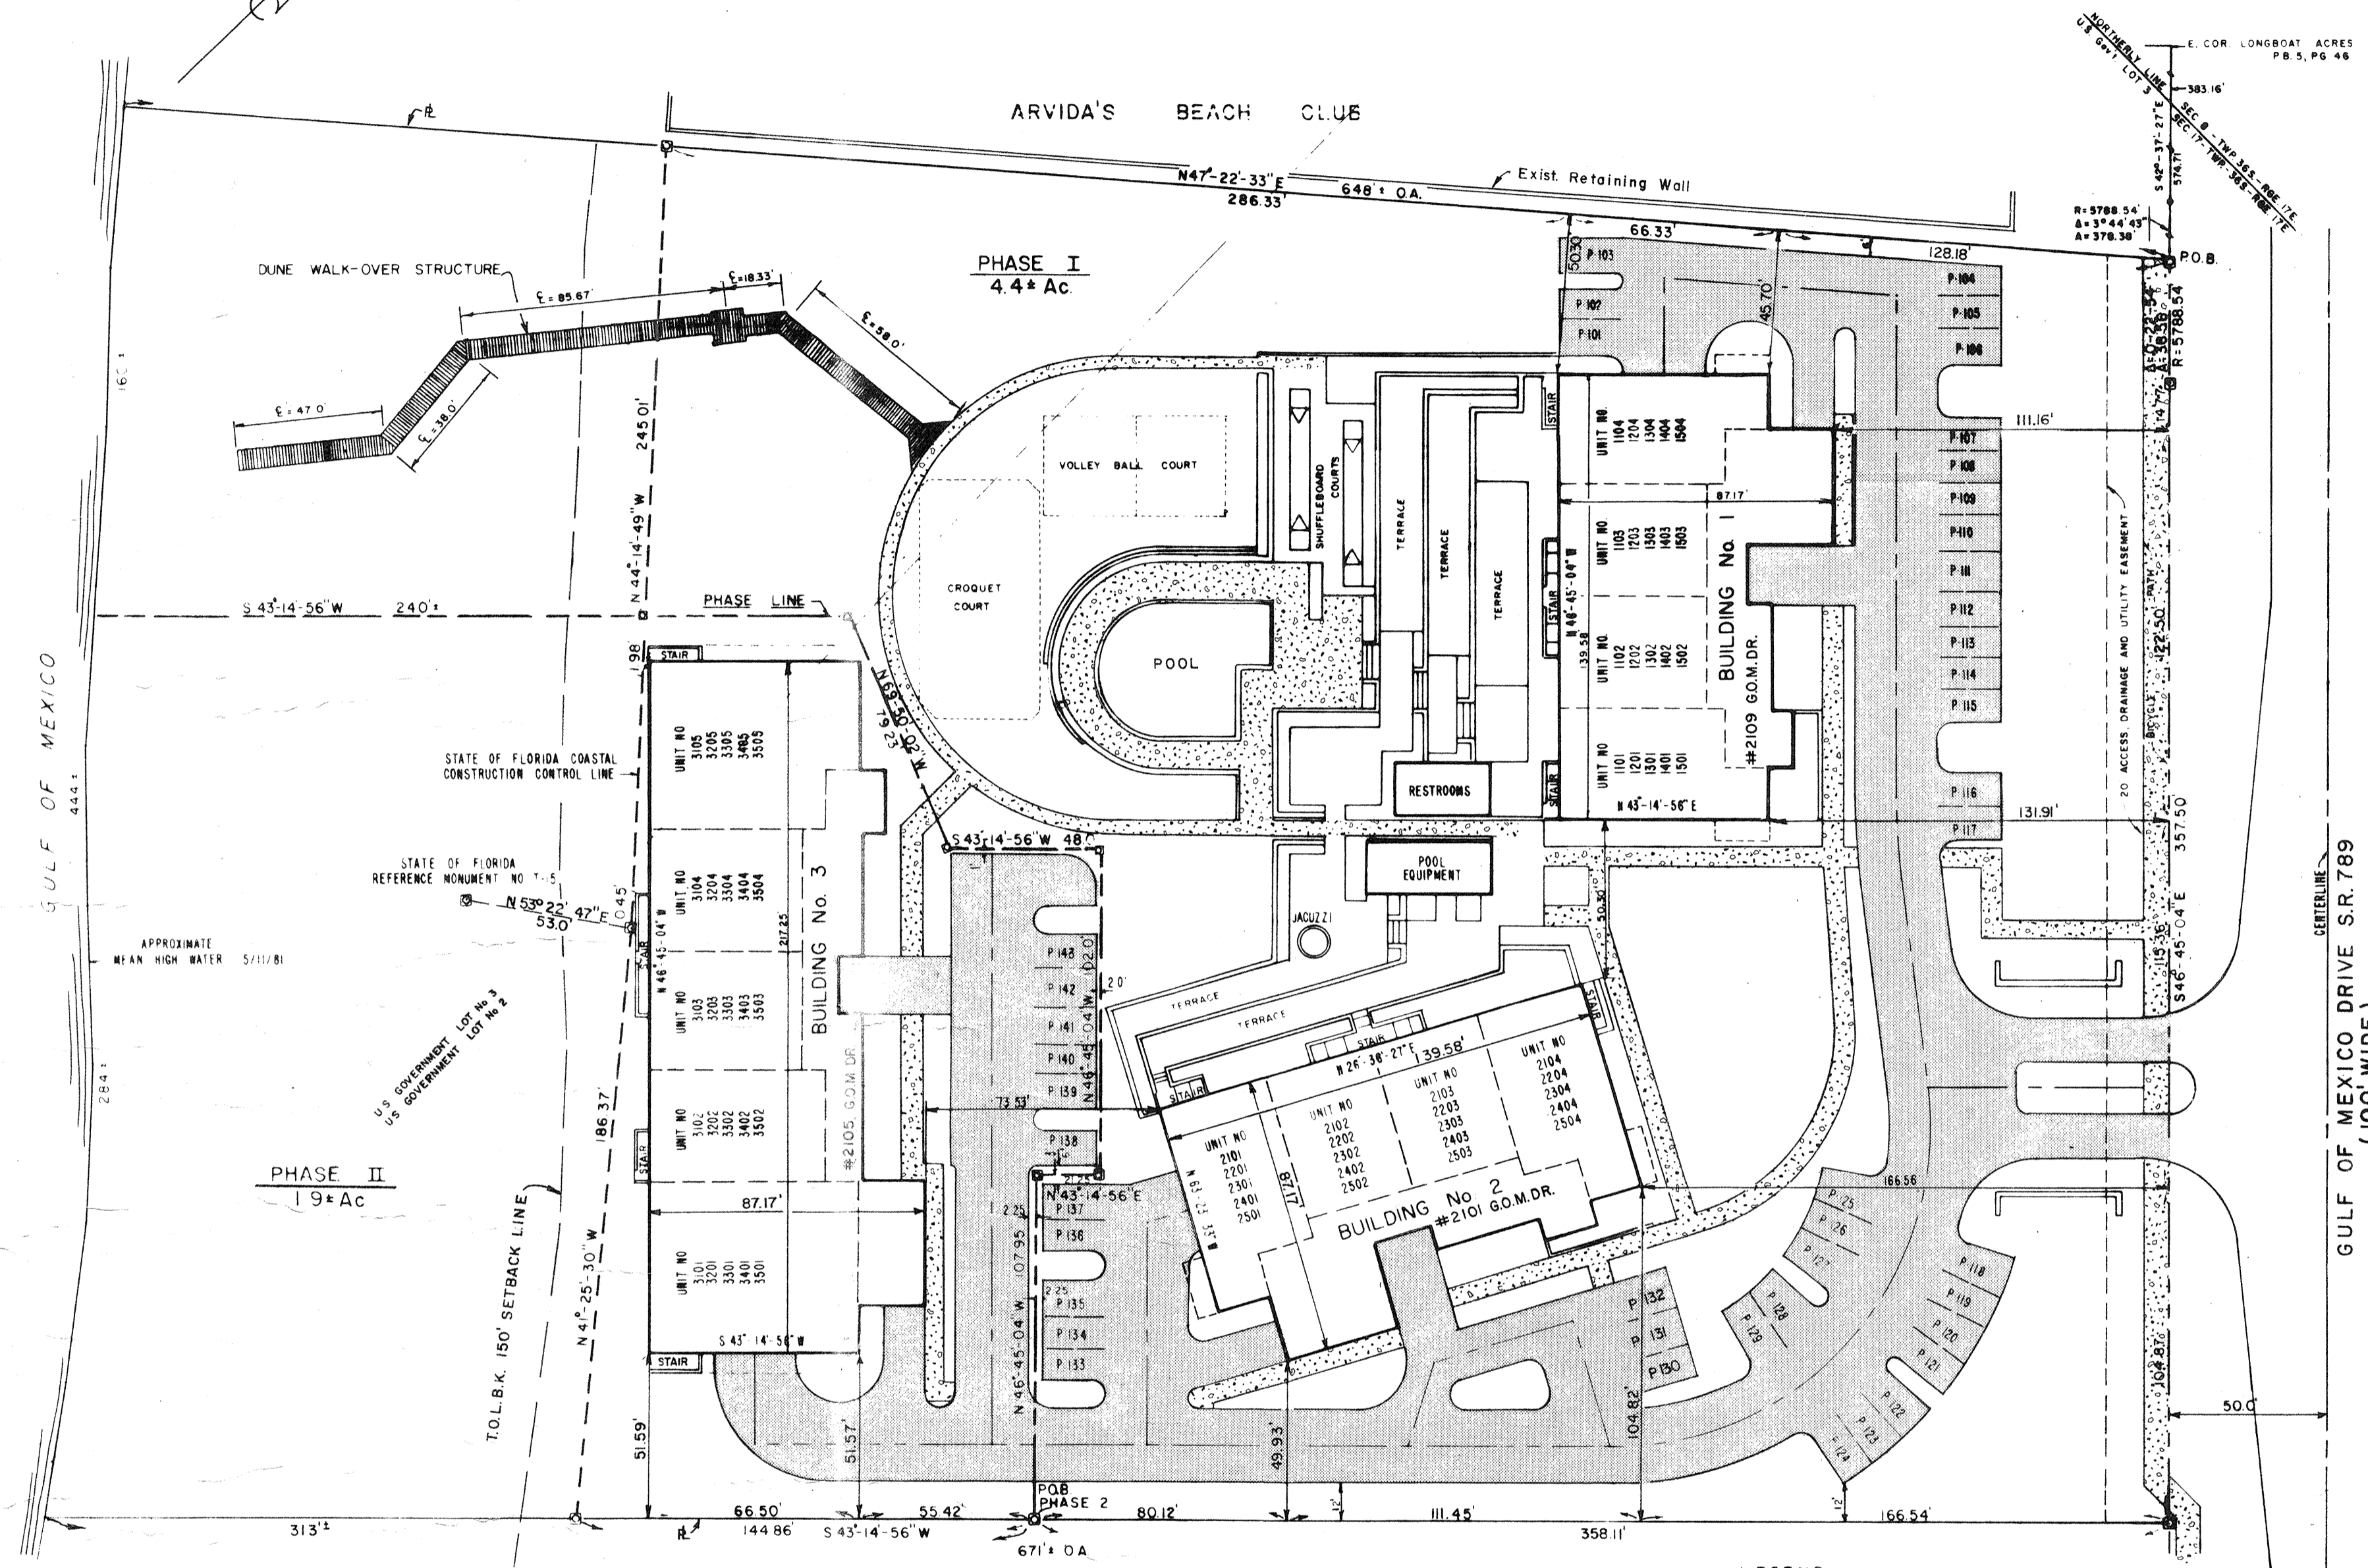

SEAPLACE I CONDOMINIUM
 CB 7 PG 9
MASTER PLOT PLAN

- LEGEND**
- ⊙ — PERMANENT REFERENCE MONUMENT
 - B.L.P. — BUILDING LOCATION POINT
 - P. 109 — PARKING SPACE
 - PC 205 — COVERED PARKING SPACE

SHEET NUMBER 191-537A	REVISION	BY	DATE	DESIGNED BY	PROJECT ENGINEER
		BY	DATE	CHECKED BY	PROJECT ENGINEER
TOWN OF LONGBOAT KEY, FLORIDA		SCALE: 1" = 40'		DRAWN BY: RWC	
ARVIDA CORPORATION		DRAWN BY: RWC		CHECKED BY: E.V.	
SUNSET BEACH		DRAWN BY: RWC		CHECKED BY: E.V.	
AS BUILT		DRAWN BY: RWC		CHECKED BY: E.V.	
BENNETT B. BISHOP, INC., ENGINEERS & SURVEYORS		DRAWN BY: RWC		CHECKED BY: E.V.	
3500 BEE BIRD ROAD		DRAWN BY: RWC		CHECKED BY: E.V.	
SARASOTA, FLORIDA		DRAWN BY: RWC		CHECKED BY: E.V.	