


SEAPLACE CONDOMINIUM

PROPERTY LINE

S.R. 789

GULF OF MEXICO DRIVE (100' WIDE)

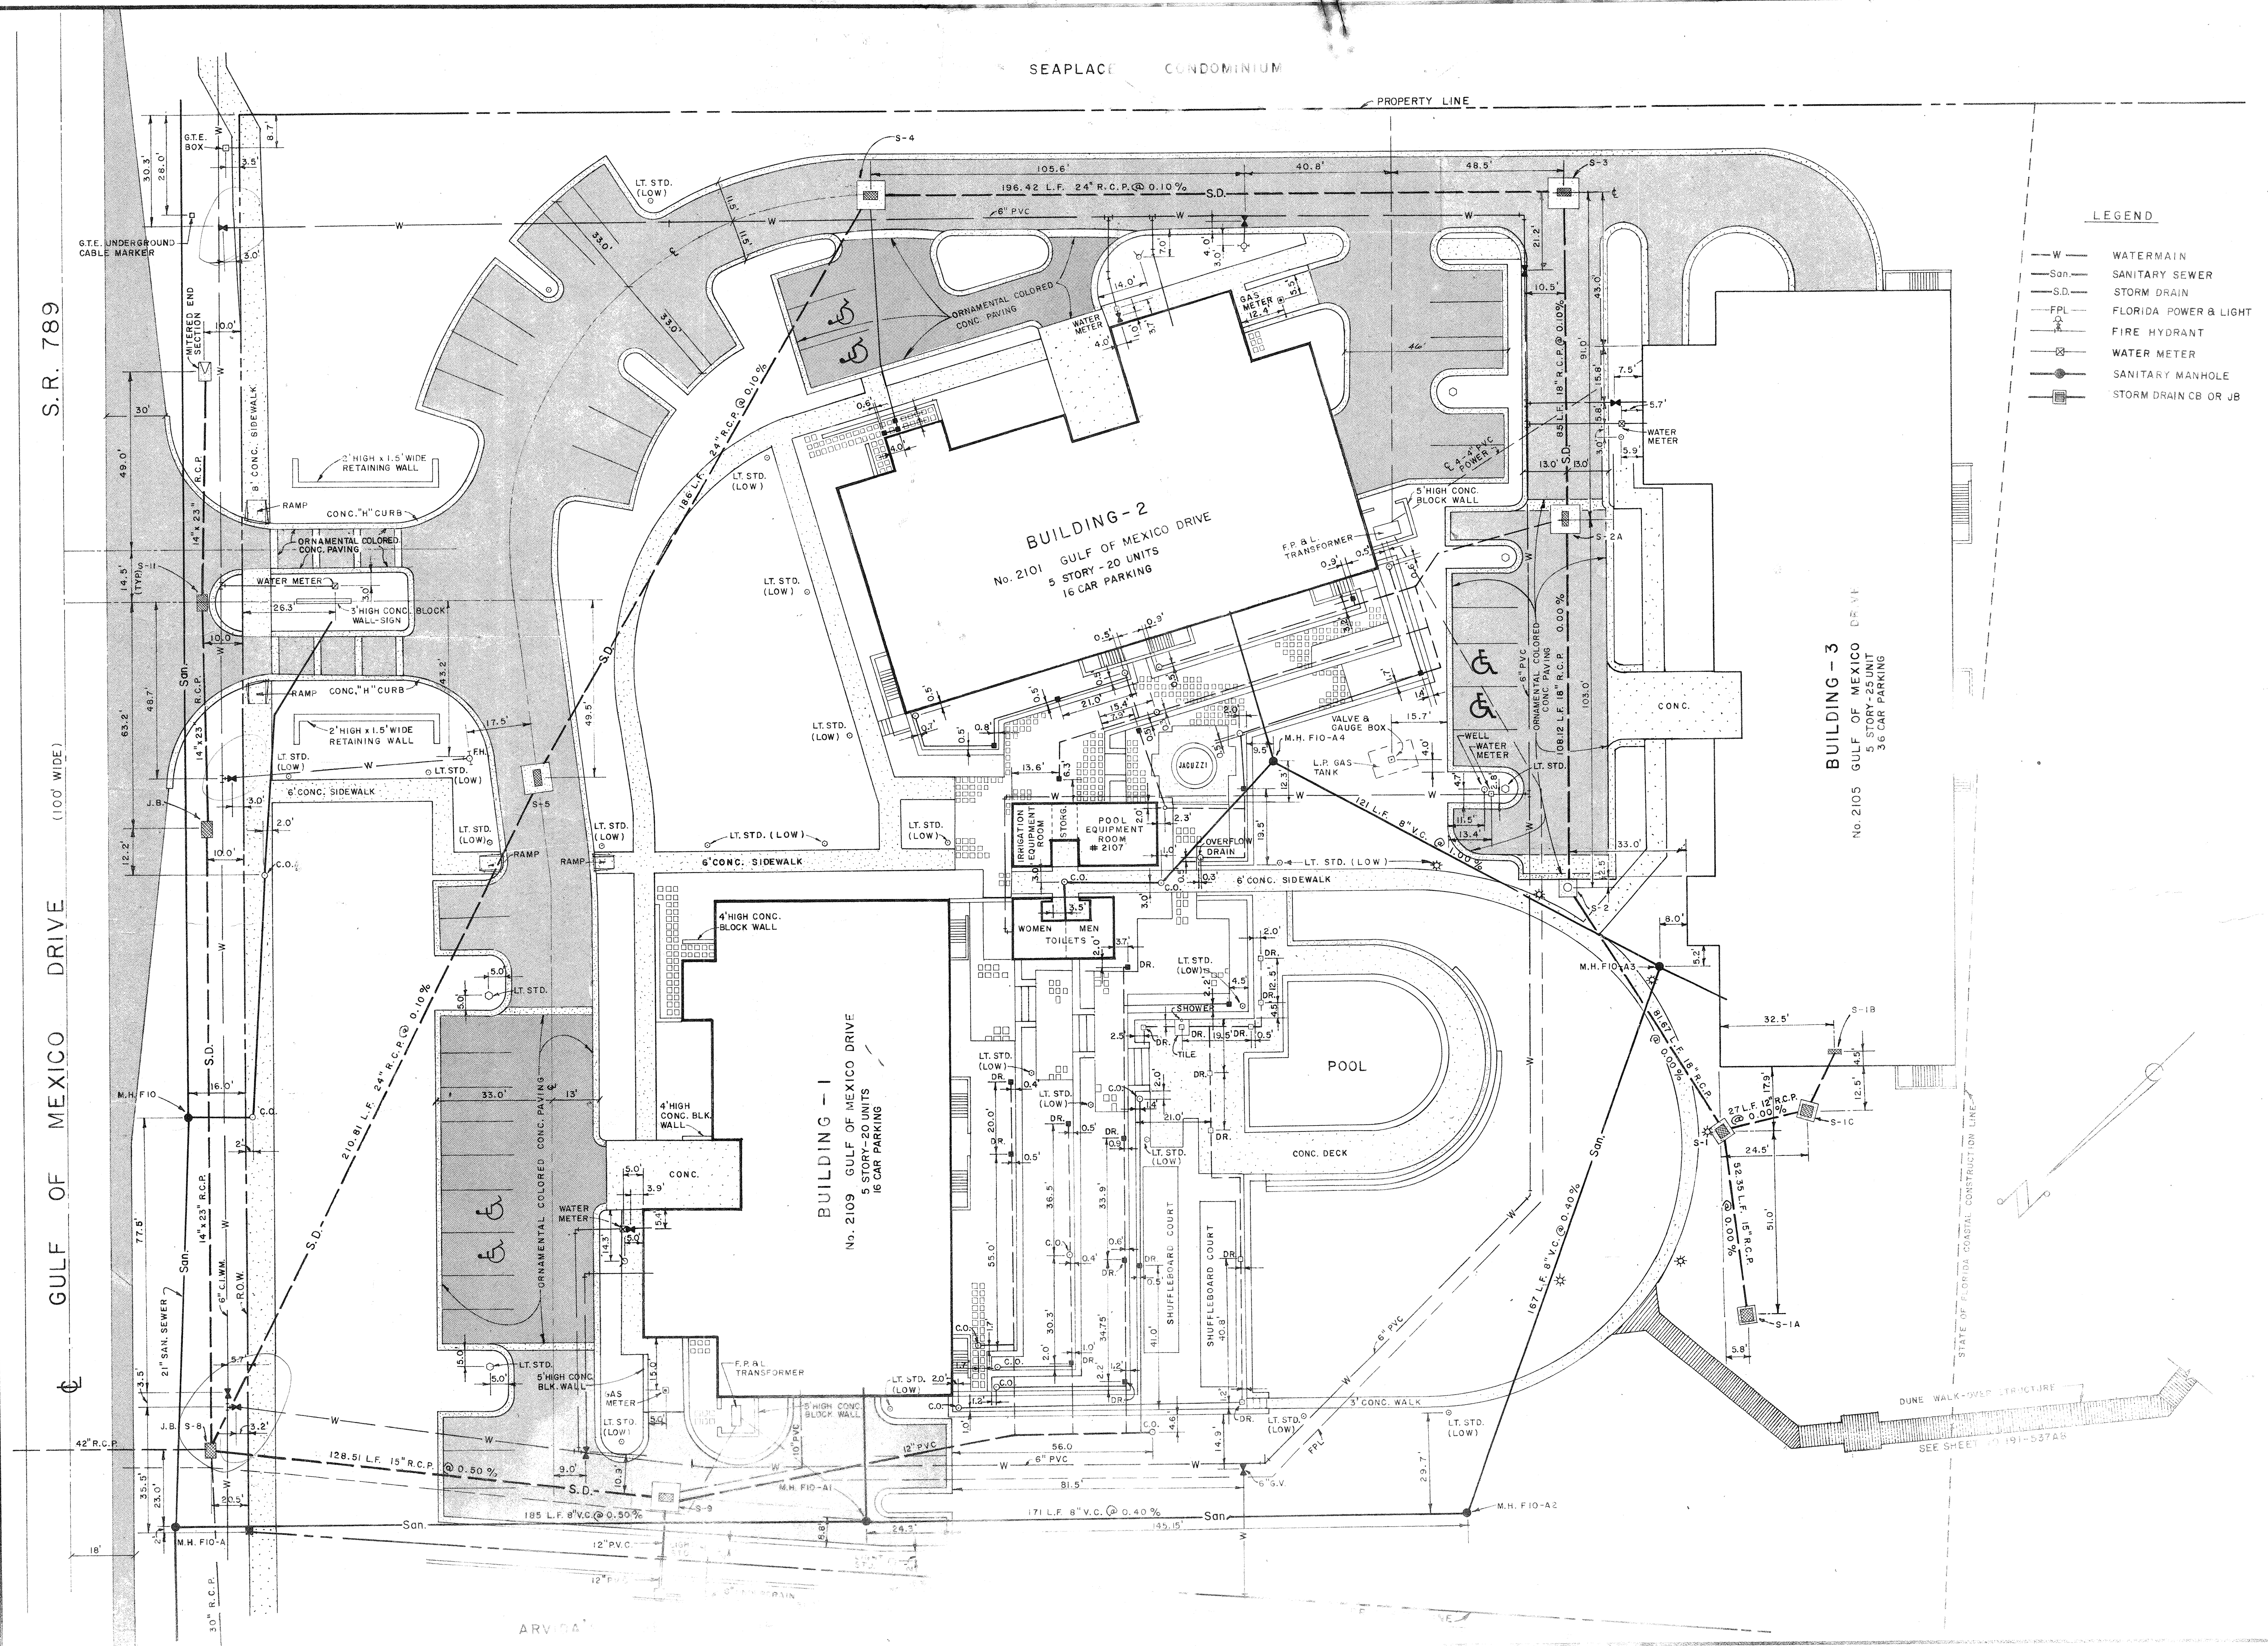

LEGEND

- W — WATERMAIN
- San — SANITARY SEWER
- S.D. — STORM DRAIN
- FPL — FLORIDA POWER & LIGHT
- FH — FIRE HYDRANT
- [Symbol] — WATER METER
- [Symbol] — SANITARY MANHOLE
- [Symbol] — STORM DRAIN CB OR JB

DESIGNED BY	PROJECT ENGINEER
DATE:	11.1.20
CHECKED BY	PROJECT NO.
DRAWN BY	
BY	
REVISION	
L.T.R.	DATE
TOWN OF LONGBOAT KEY, FLORIDA ARVIDA CORPORATION SUNSET BEACH AS-BUILT ENGINEERS & SURVEYORS 4509 BEE RIDGE ROAD SARASOTA, FLORIDA	
SHEET NUMBER	191-538A
REVISION	

STATE OF FLORIDA COASTAL CONSTRUCTION LINE

DUNE WALK-OVER STRUCTURE
SEE SHEET 191-537A-B

ARVIDA