


ROOF PLAN
1/4" = 1'-0"

GENERAL NOTES




INDICATES ACCESS PANEL. PANELS MUST LIFT OUT INDEPENDENTLY


- TRELLIS DETAILS SHALL MATCH TRELLIS DETAILS FOR BLDGS. 1, 2, AND 3
- ALL FLASHING SHALL BE STAINLESS STL. FLASHING AT ROOF PENETRATIONS AND PARAPET SHALL COMPLY W/ SMACNA
- COORDINATE LOCATION OF ROOF DRAINS AND VENTS W/ PENETRATIONS REQUIRED FOR POOL-RELATED EQUIP., VENTS, ETC.
- GEN. CONTRACTOR SHALL COORDINATE ALL ROOF PENETRATIONS NOT TO INTERRUPT PRIMARY TRELLIS FRAMING MEMBERS.
- PROVIDE TERNE-COATED STAINLESS ROOF VENTS AS FOLLOWS:
TOILET BLDG.: 20 SF TOTAL VENTED AREA
EQUIPMENT BLDG.: 28 SF TOTAL VENTED AREA
- ALL ROOF PENETRATING ELEMENTS (I.E. VENTS, FURNACE FLUES, ETC.) TO BE PAINTED
- REFER TO MECH., PLUMB., AND ELEC. DWGS. FOR VENTILATION AND FURNACE INFORMATION.

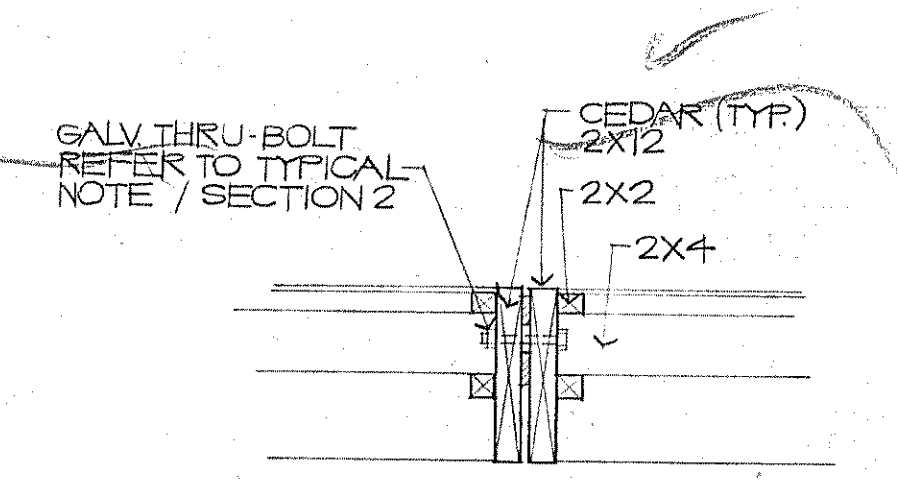


SECTION 1
TYP. 1" = 1'-0"

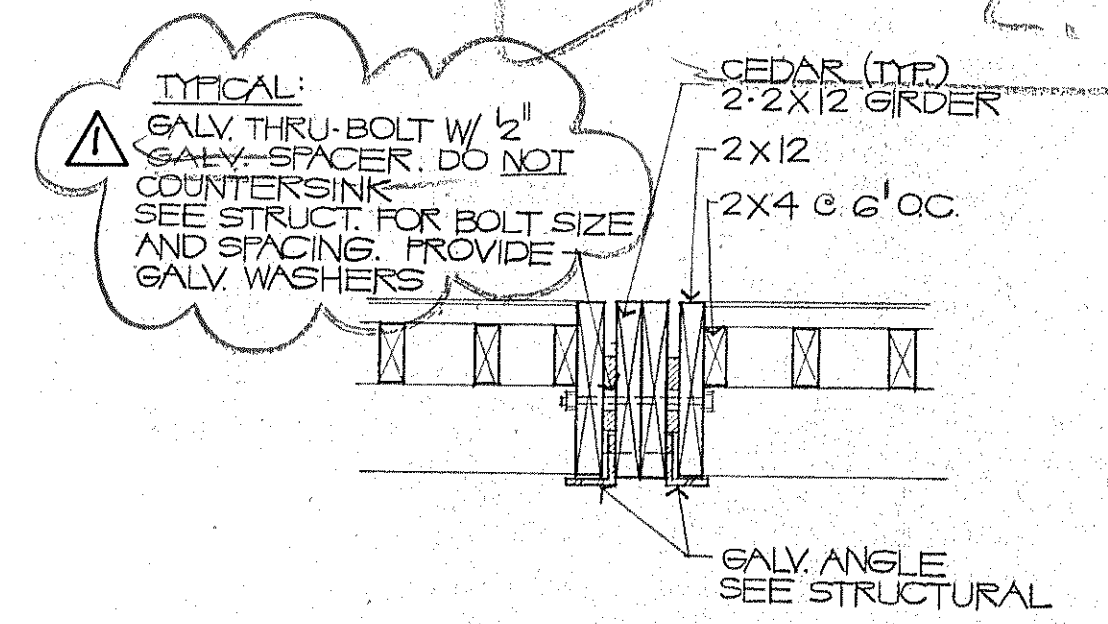


SECTION 2

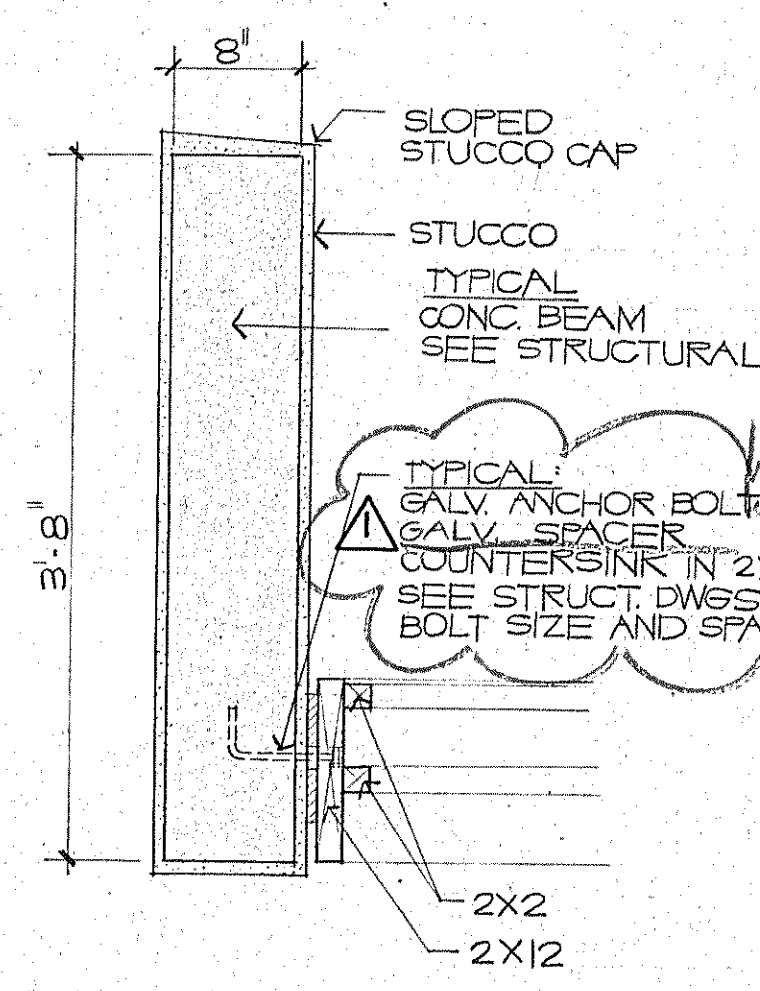

SECTION 3

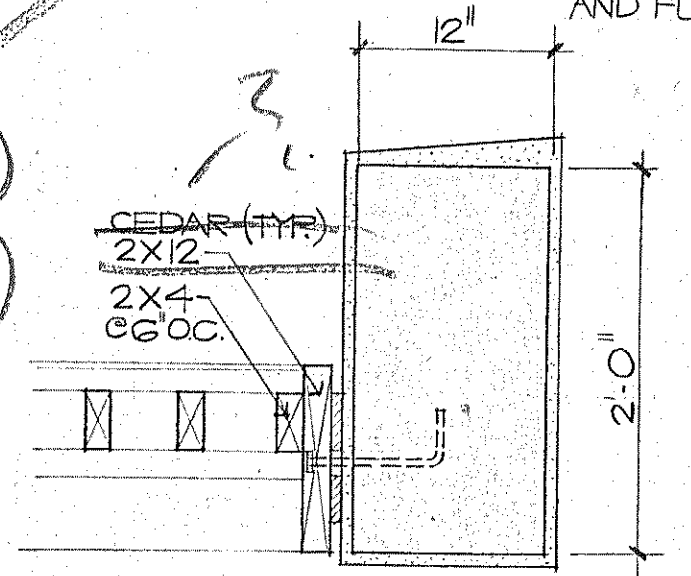

SECTION 4

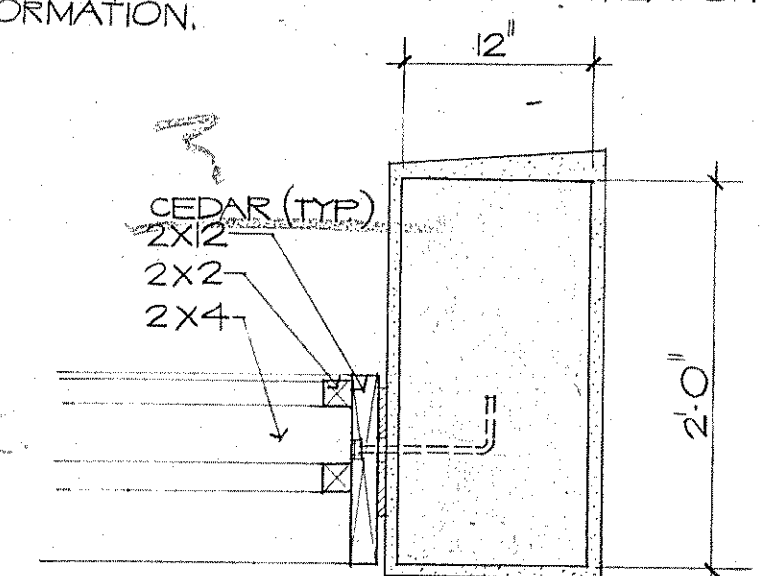

SECTION 5

NOTE: REFER TO STRUCTURAL DWGS. FOR CONNECTION SPECS. & DETAILS.