



SEE DETAILS AND MILLWORK SHOP DRWS. FOR SIZE & LOCATION OF KITCHEN CEILING LIGHTING.

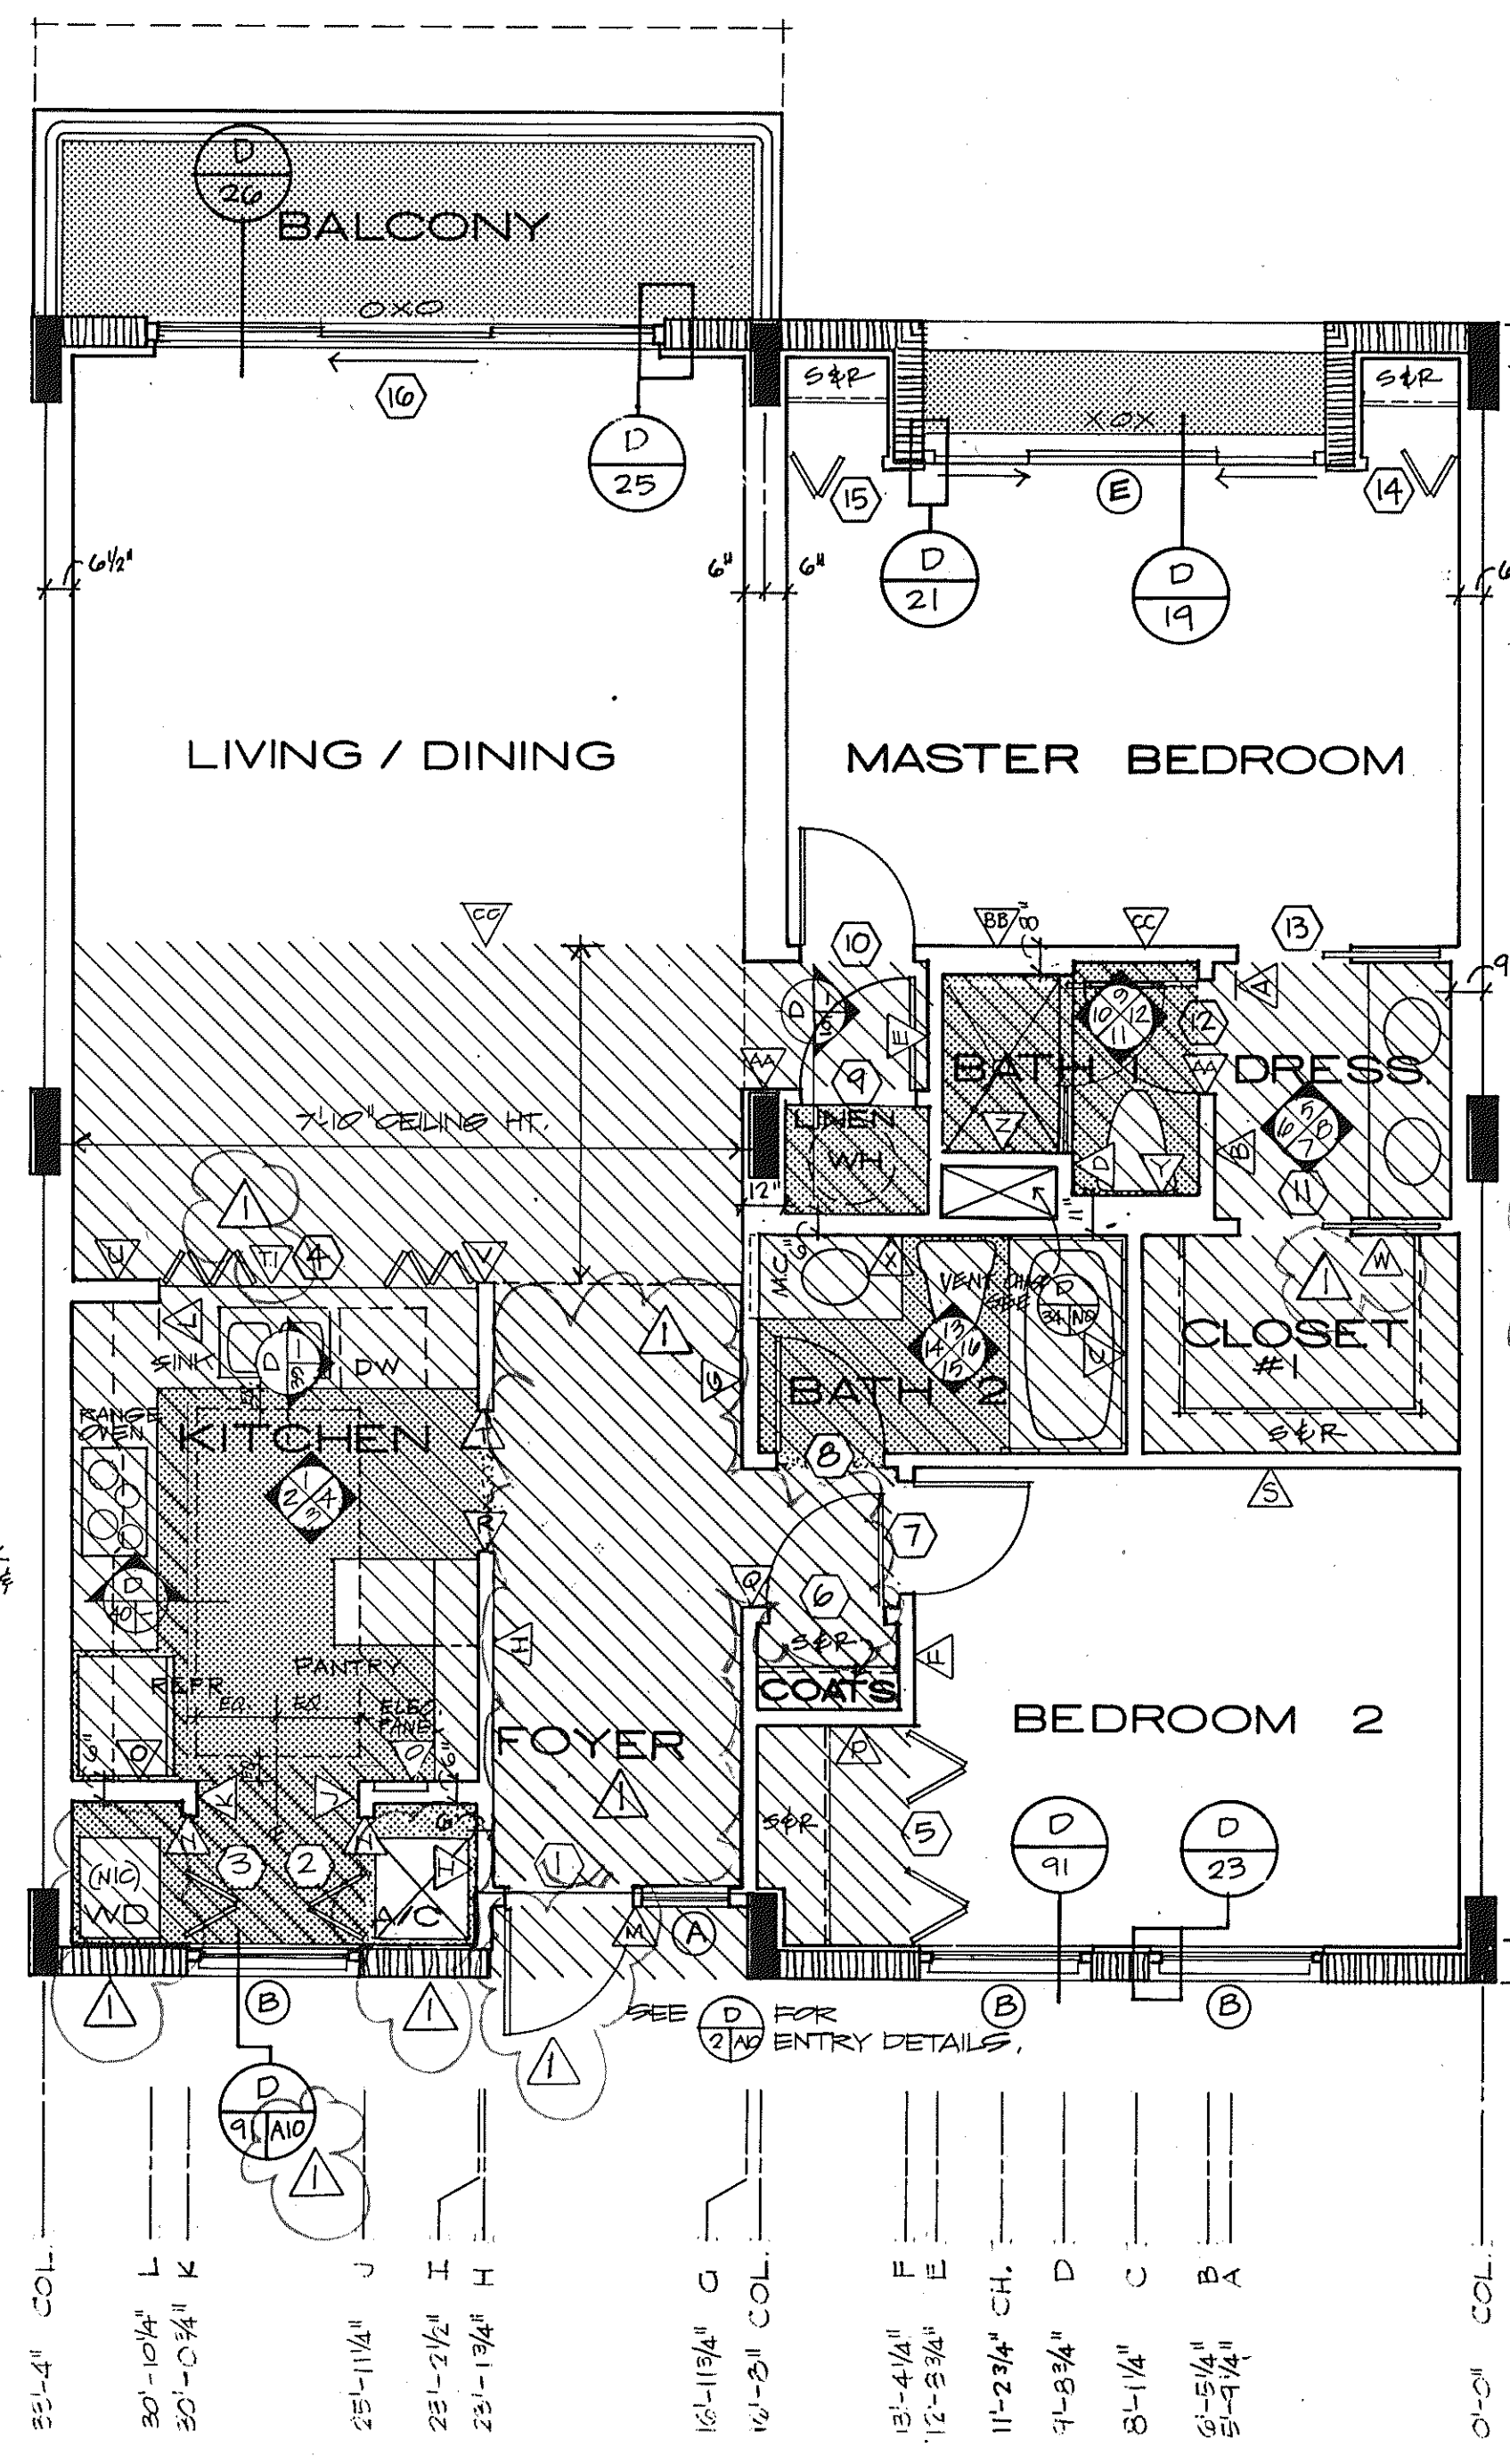

UNIT A LEFT

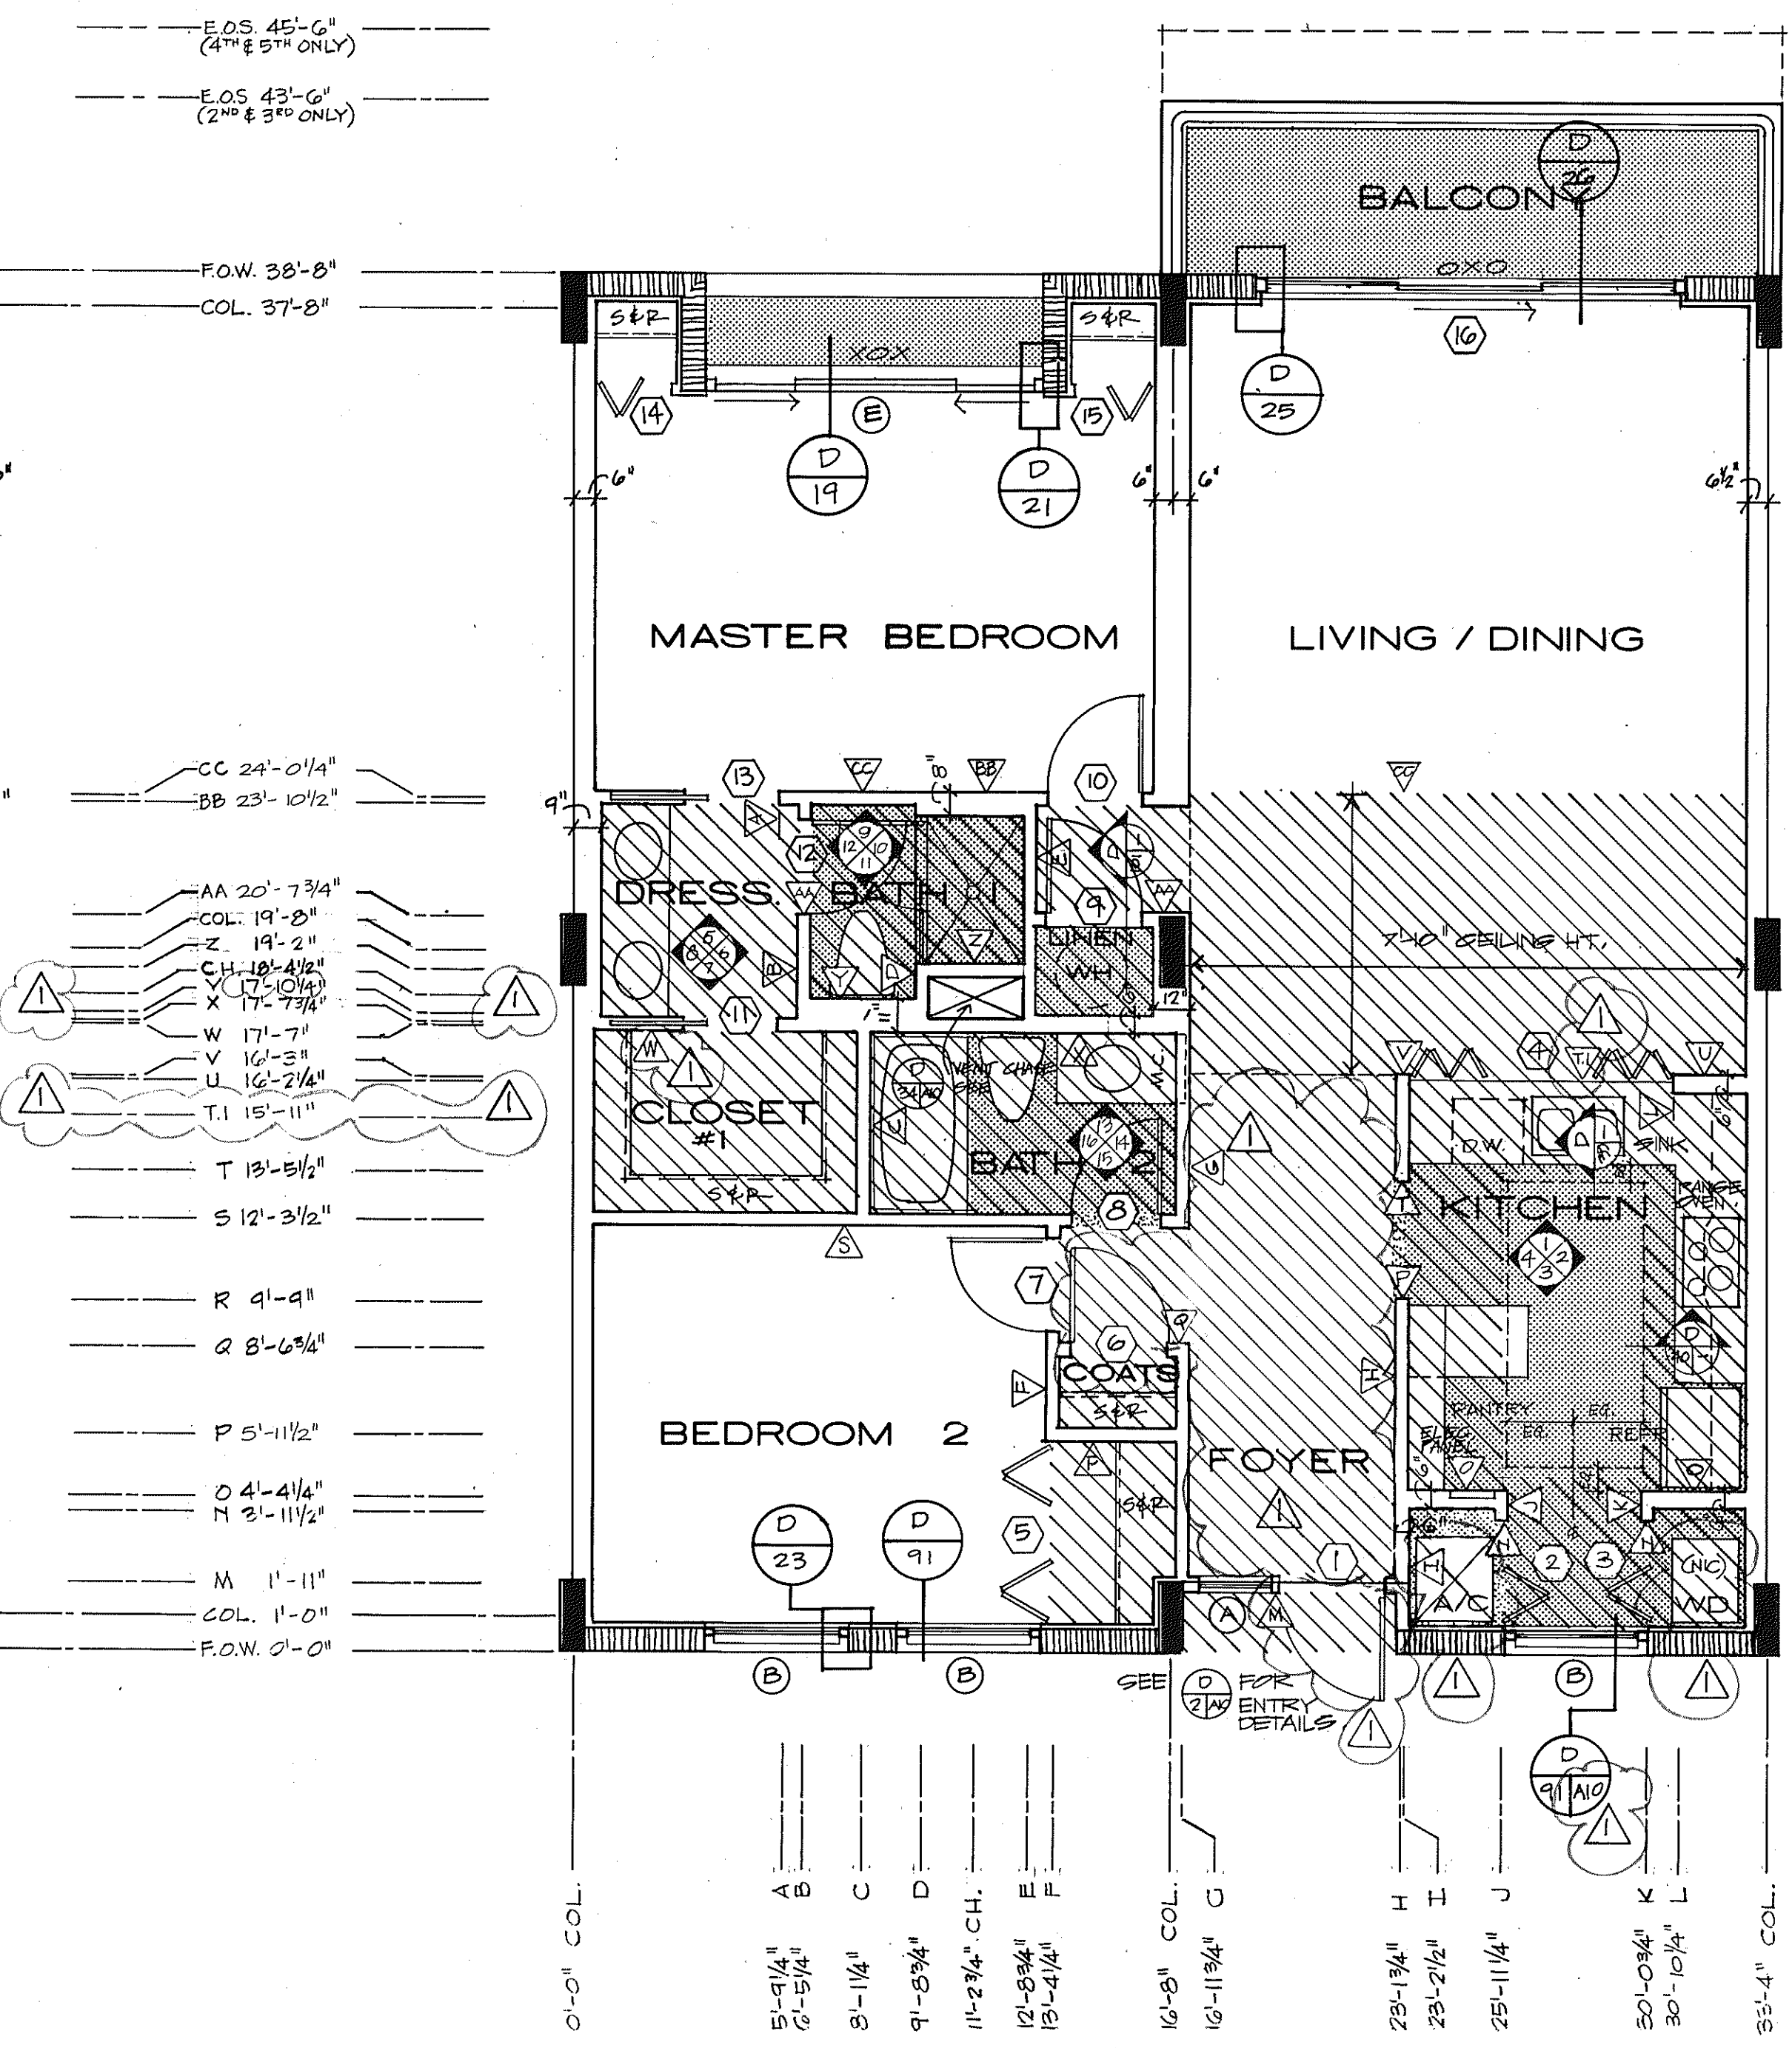

UNIT A RIGHT

NOTES

1. SEE 1/8" BLDG. PLANS FOR COL. & SHEAR WALL LOCATIONS.
2. ALL DROPPED CEILINGS ARE 7'-0" UNLESS OTHERWISE NOTED.
3. ALL DIMENSIONS ARE FROM CENTERLINE OF WALL.
4. SEE DETAIL BOOKLET FOR FLOOR, WINDOW & FINISH SCHEDULES.
5. SCREEN DOT TEXTURE DENOTES PAVERS, CER. TILE, VINYL TILE & VAT. SEE FINISH SCHEDULES FOR EXACT LOCATIONS.
6. VERIFY EXACT LOCATION OF LAVATORIES W/ ARCHITECT.
7. SEE SHEET A-9 FOR PLAN DIMENSIONING KEY.

ISSUED	10 DEC 82
REVISED	4-1-83
SHEET	A-10
OF	37