


OVERLAYS
COMPOSITE


3 23
4 24
5 25
6 26
7 27

FOR WALL OFFSET
DIMENSION SEE FIRST
FLOOR PLAN, 1/8" BLDG.
PLANS & DETAIL

PIPE
RAIL

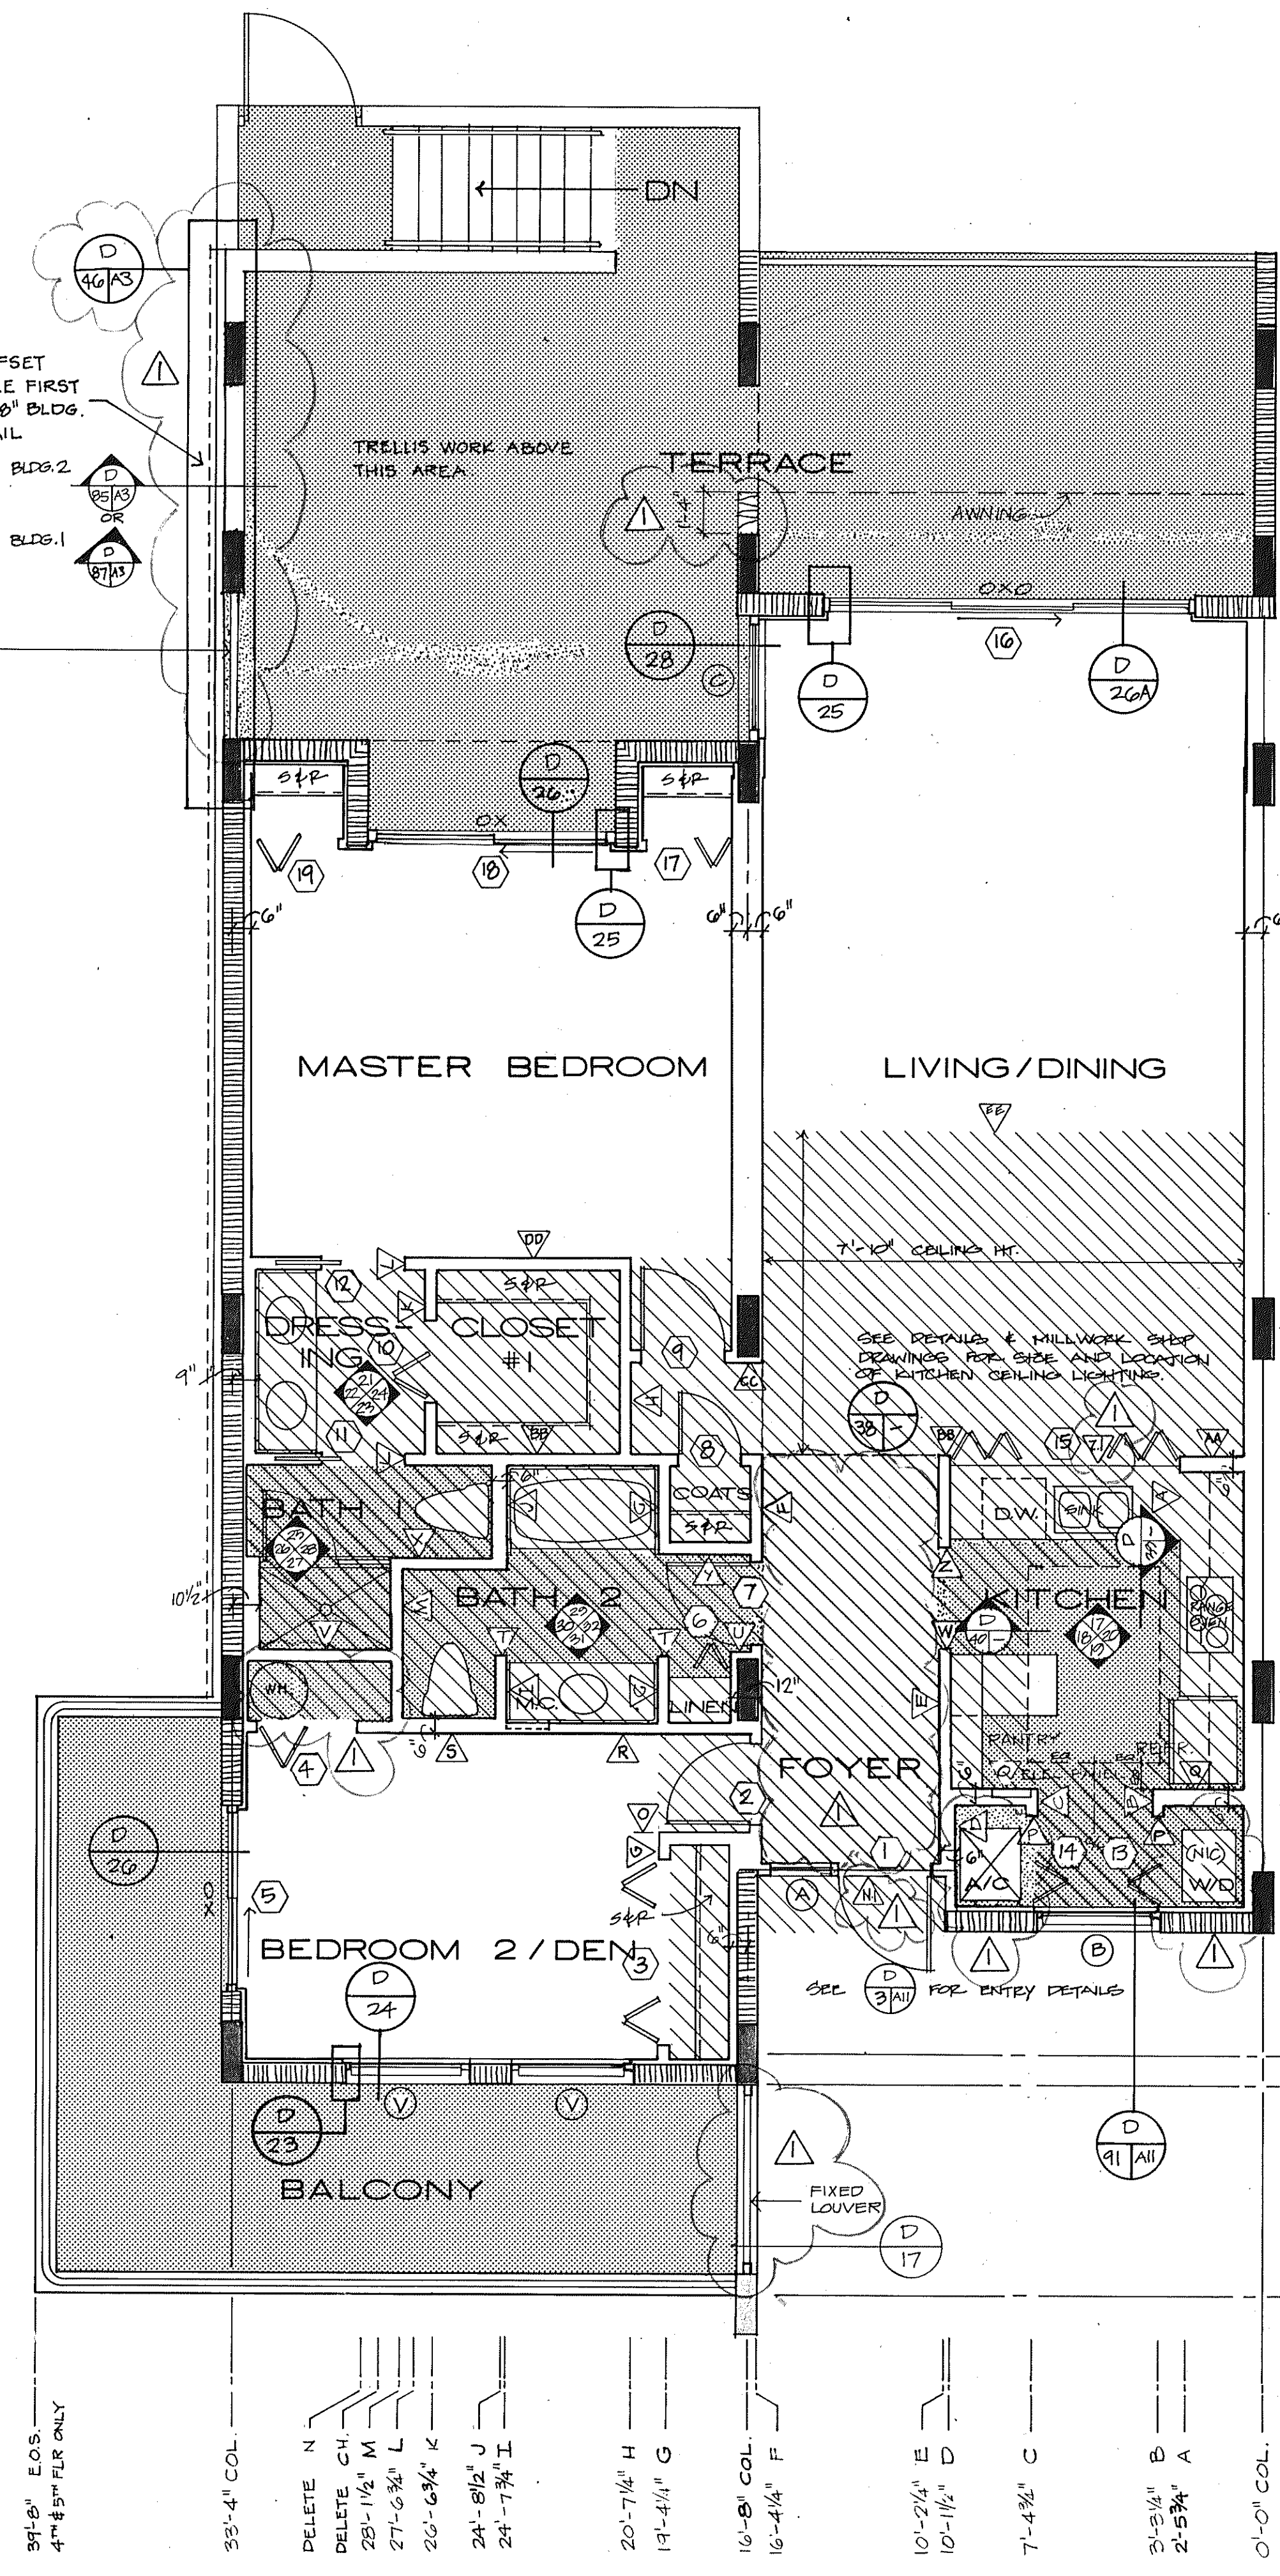

UNIT B+ LEFT

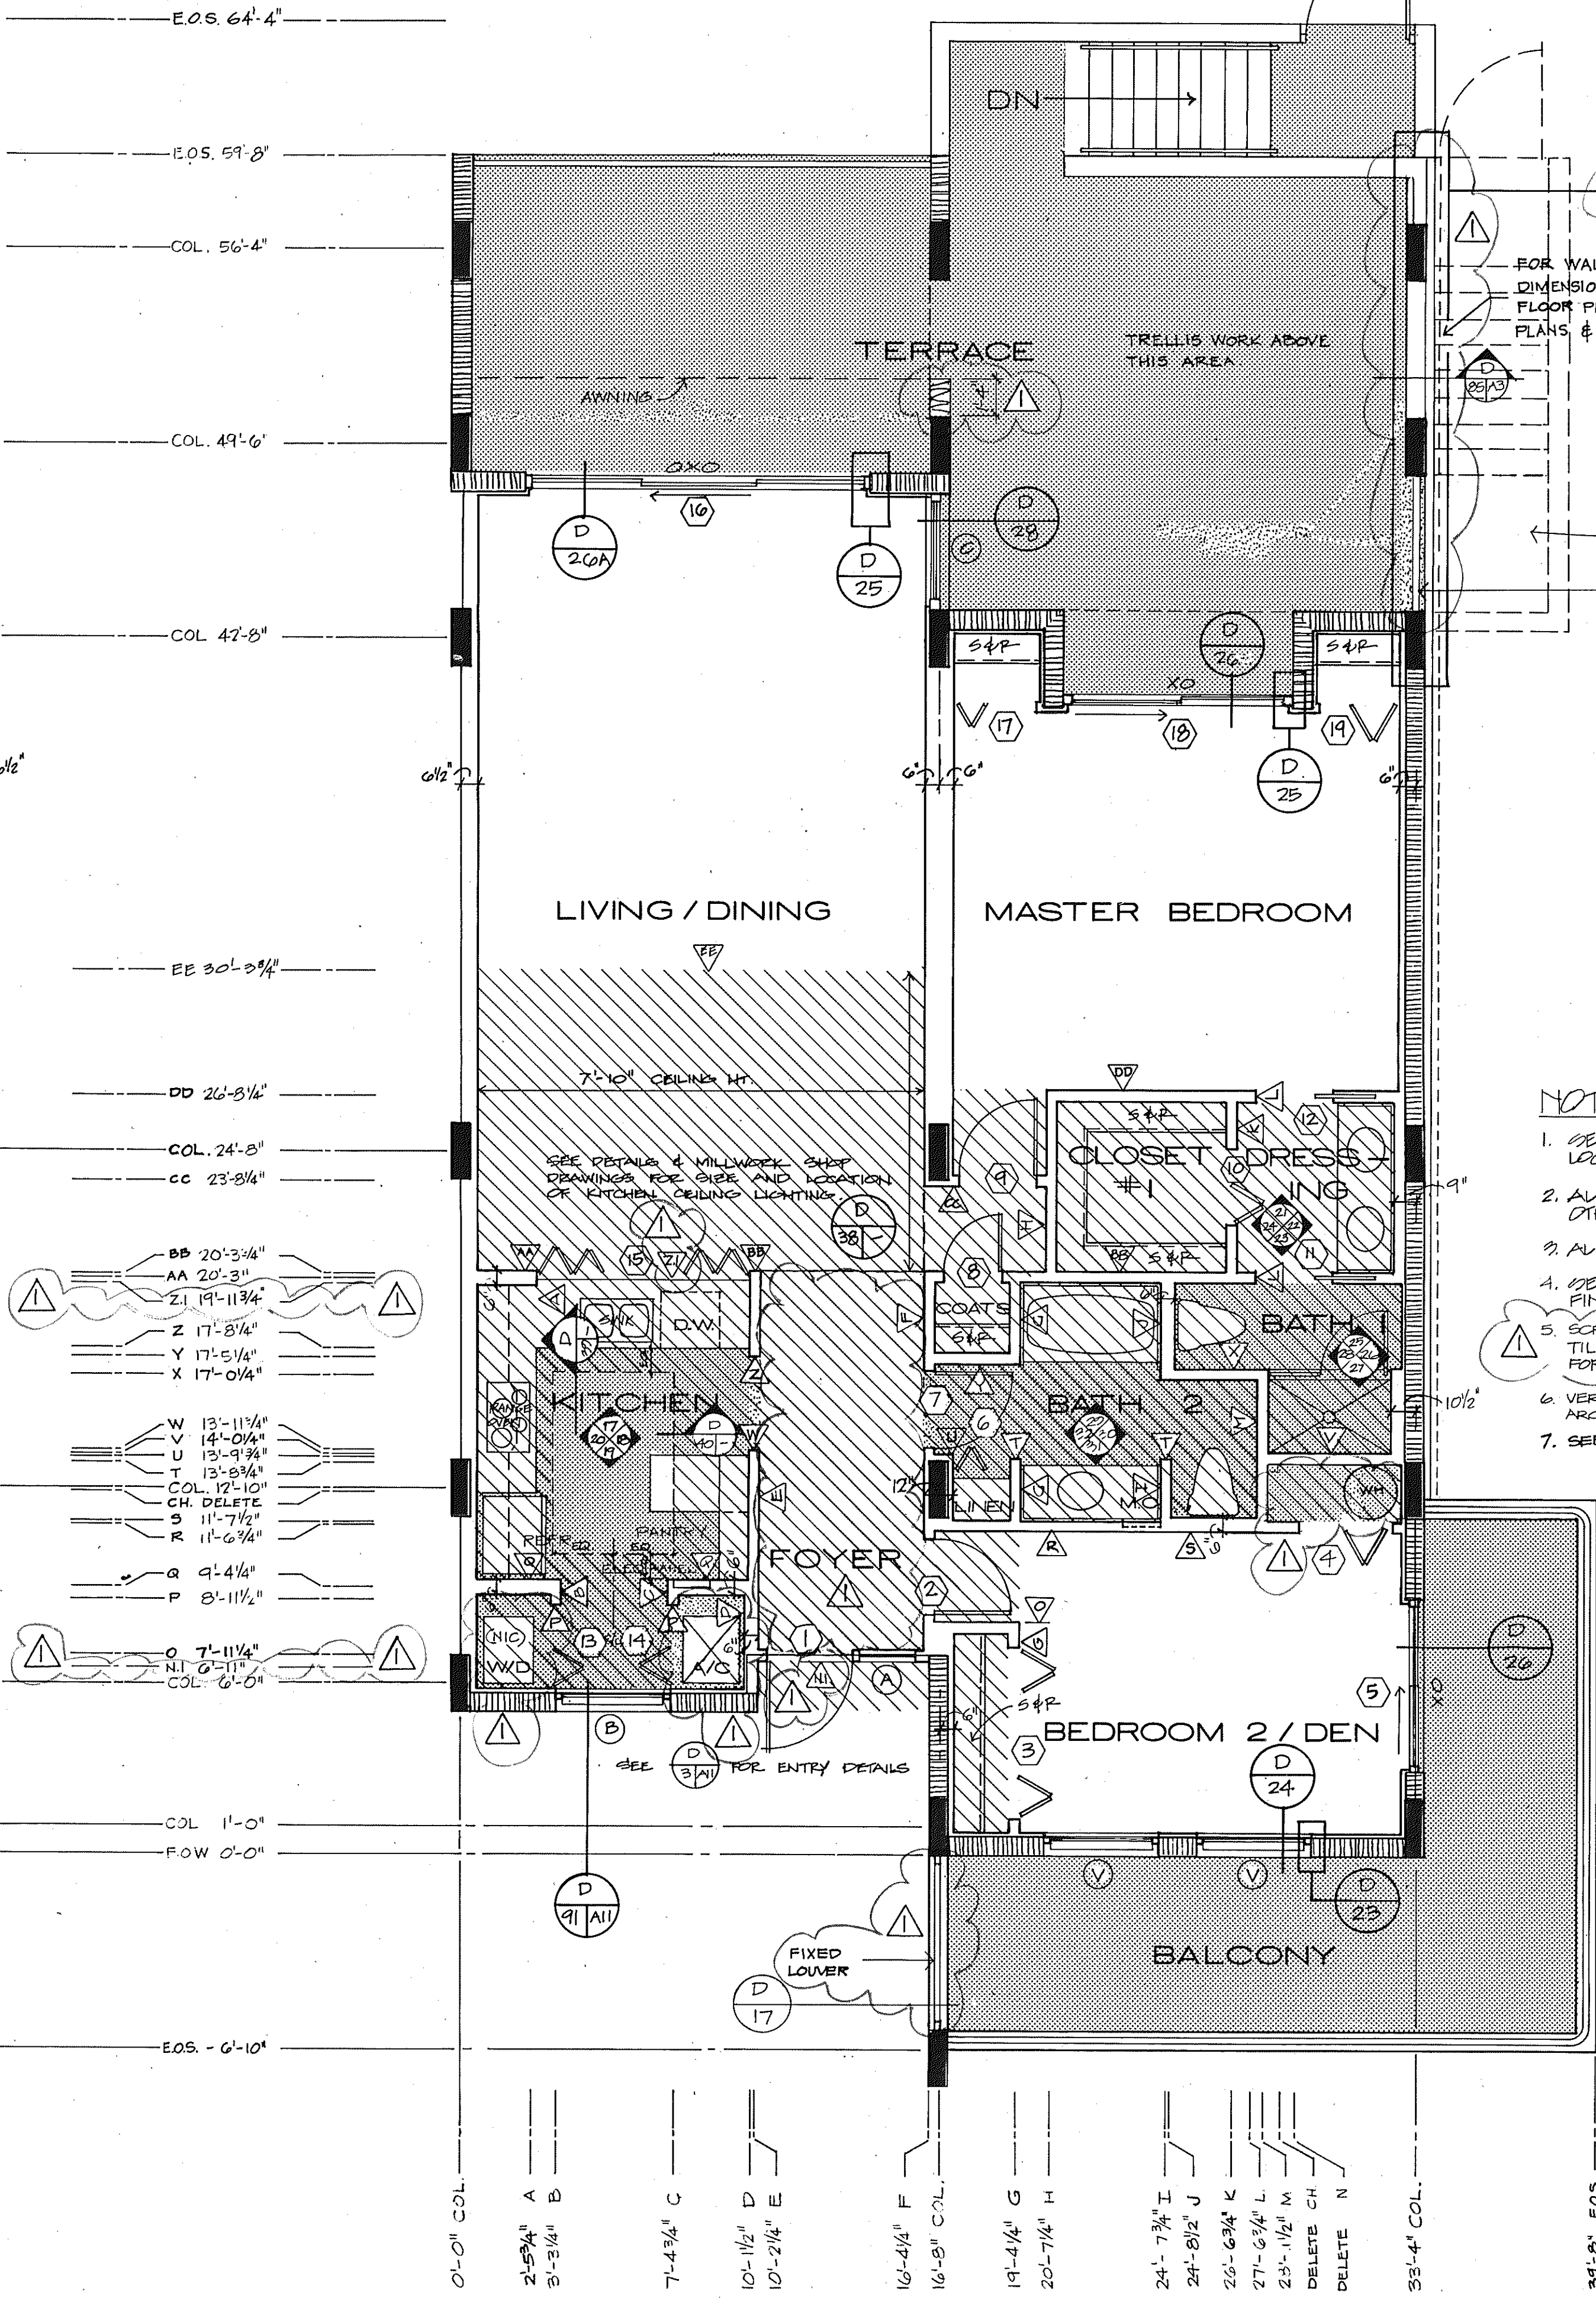

UNIT B+ RIGHT

NOTES

- SEE 1/8" BLDG. PLANS FOR COL. & SHEAR WALL LOCATIONS.
- ALL DROPPED CEILING ARE 7'-0" UNLESS OTHERWISE NOTED.
- ALL DIMENSIONS ARE FROM CENTERLINE OF WALL.
- SEE DETAIL BOULET FOR DOOR, WINDOW & FINISH SCHEDULES.
- SCREEN DOT TEXTURE DENOTES PAVERS, CER. TILE, VINYL TILE & VAT. SEE FINISH SCHEDULES FOR EXACT LOCATION.
- VERIFY EXACT LOCATION OF LAVATORIES W/ ARCHITECT.
- SEE SHEET A-9 FOR PLAN DIMENSIONING KEY.

89'-0" E.O.S.
4" x 8" FLR ONLY

33'-4" COL.

DELETE N
DELETE CH
29'-1 1/2" M
27'-6 3/4" L
20'-6 3/4" K
24'-8 1/2" J
24'-7 3/4" I

20'-7 1/2" H
19'-4 1/4" G

16'-8" COL.
16'-4 1/4" F

10'-2 1/4" E
10'-1 1/2" D

7'-4 3/4" C

3'-3 1/4" B
2'-5 3/4" A

0'-0" COL.

34'-5" E.O.S.
4" x 8" FLR ONLY

0'-0" COL.

2'-5 3/4" A
3'-3 1/4" B

7'-4 3/4" C

10'-1 1/2" D
10'-2 1/4" E

16'-4 1/4" F
16'-8" COL.

19'-4 1/4" G
20'-7 1/4" H

24'-7 3/4" I
24'-8 1/2" J
26'-6 3/4" K
27'-6 3/4" L
25'-1 1/2" M
DELETE CH
DELETE N

33'-4" COL.

SUNSET BEACH
OF LONG BEACH, CA
SURVEYORS

UNIT B+ PLANS 1/4" = 1'-0"
ARVDA CORPORATION · EDWARD J SEIBERT AIA ARCHITECT & PLANNER PA · THE SWA GROUP
BRABHAM KUHN DEBAY CONSULTING ENGINEERS · OLSEN WHITE & ASSOCIATES STRUCTURAL ENGINEERS · BENNETT & BISHOP INC CONSULTING ENGINEERS & SURVEYORS

ISSUED
10 DEC. 82

REVISED
4-1-83

SHEET
A.11
OF 37