


OVERLAY 1
COMPOSITE
1
2
NOTE:
BALCONY DEPTHS DIFFER FROM THIS DRAWING ON 4TH FLOOR. SEE 1/8" BLDG. PLANS. END WALLS OCCUR ON 4TH FLOOR. BALCONY. SEE 1/8" BLDG. PLANS.

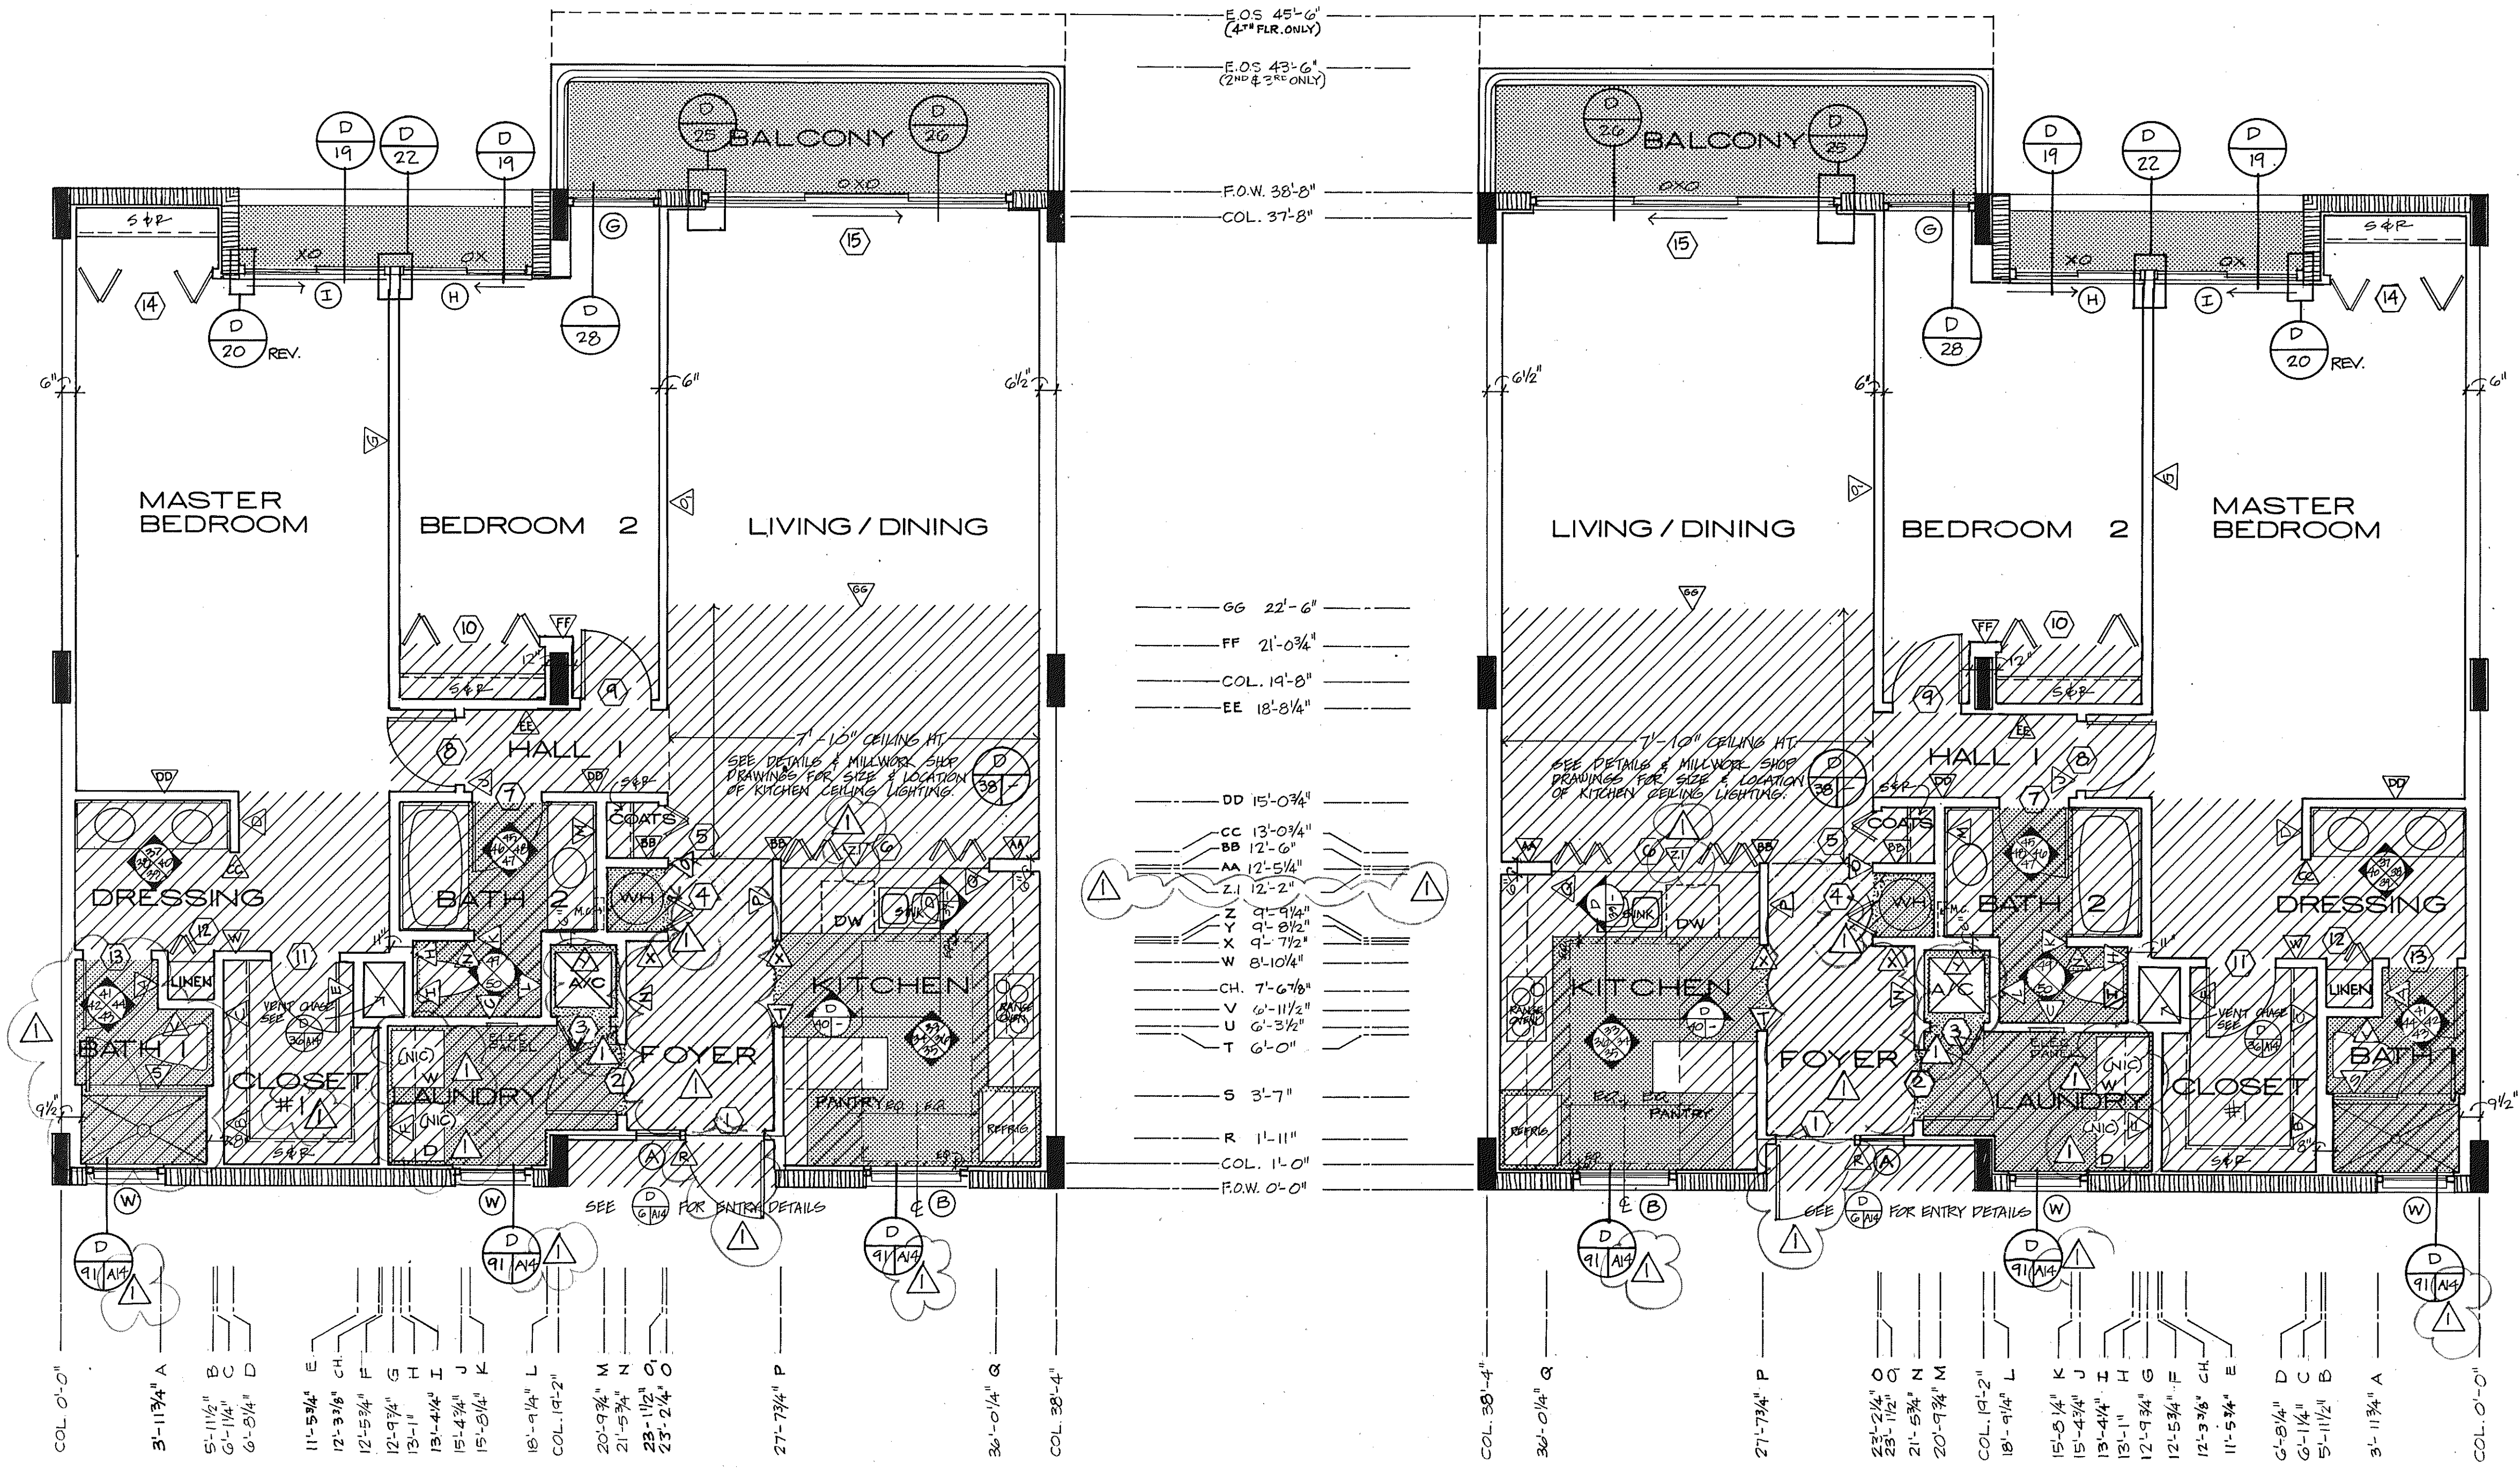

UNIT C LEFT

UNIT C RIGHT

- NOTES:
1. SEE 1/8" BLDG. PLANS FOR COL. & SHEAR WALL LOCATIONS.
 2. ALL DROPPED CEILINGS ARE 7'-0" UNLESS OTHERWISE NOTED.
 3. ALL DIMENSIONS ARE FROM CENTERLINE OF WALL.
 4. SEE DETAIL BOOKLET FOR DOOR, WINDOW & FINISH SCHEDULES.
 5. SCREEN DOT TEXTURE DENOTES PAVERS, CER TILE, VINYL TILE OR VAT. SEE FINISH SCHEDULES FOR EXACT LOCATIONS.
 6. VERIFY EXACT LOCATION OF LAVS. W/ ARCHITECT.
 7. DASHED LINE ABOVE THE WASHER/DRYER IS A CONTINUOUS UPPER CABINET W/ DOORS. CONSTRUCTION IS TO BE PER KITCHEN UPPER CABINETS EXCEPT DELETE ALL WOOD TRIM. PULLS TO BE RECESSED OAK.
 8. SEE SHEET A-9 FOR PLAN DIMENSIONING KEY.