
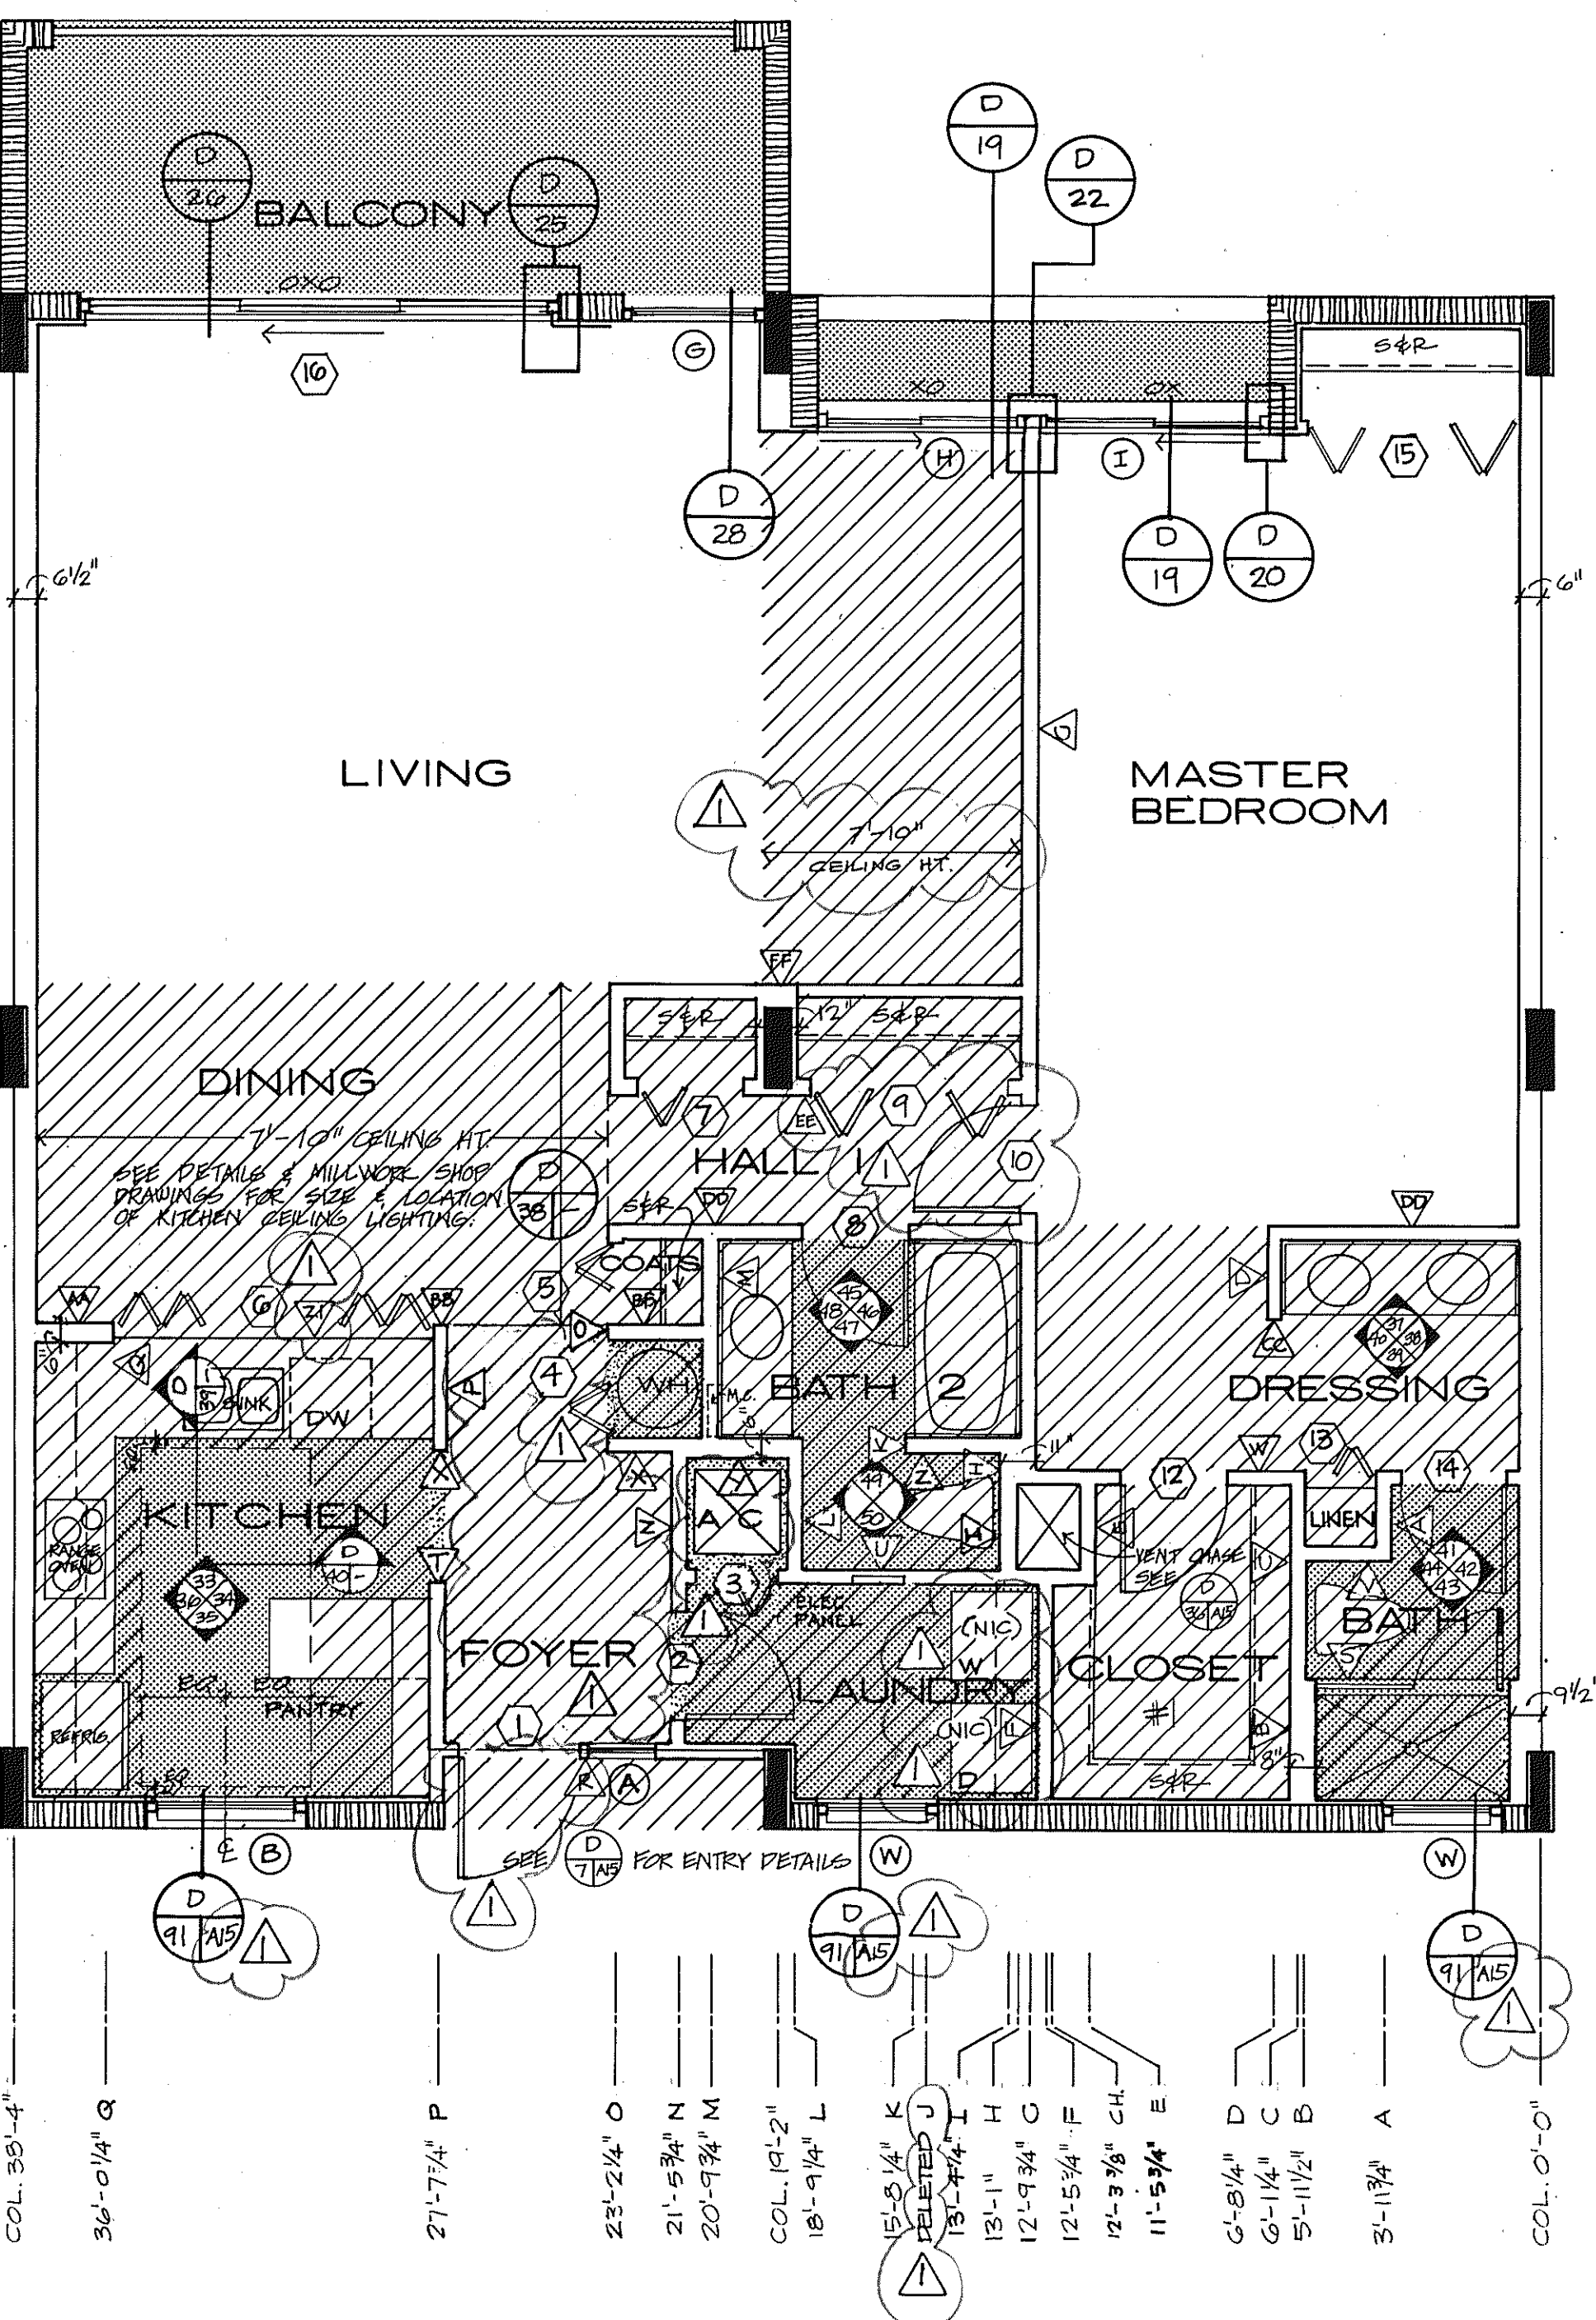


UNIT C MOD. LEFT

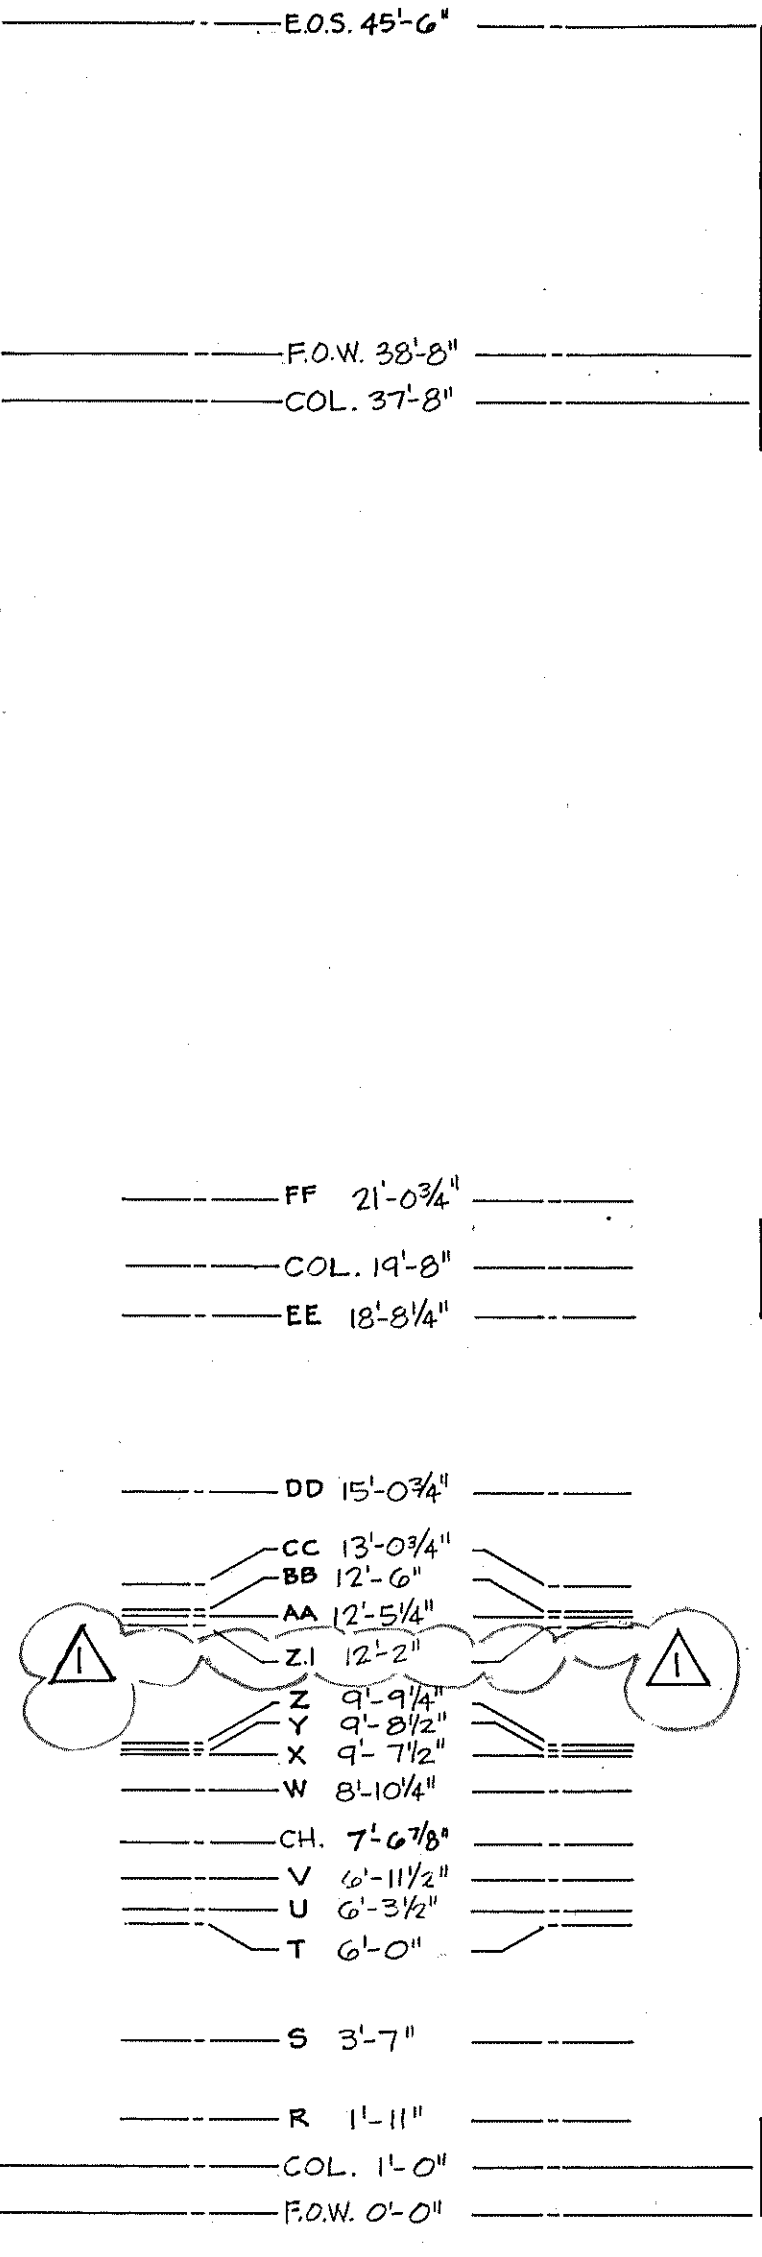

UNIT C MOD. RIGHT

- NOTES:
1. SEE 10" BLDG. PLANS FOR COL. & SHEAR WALL LOCATIONS.
  2. ALL DROPPED CEILING ARE 7'-0" UNLESS OTHERWISE NOTED.
  3. ALL DIMENSIONS ARE FROM CENTERLINE OF WALL.
  4. SEE DETAIL BOOKLET FOR DOOR, WINDOW & FINISH SCHEDULES.
  5. SCREEN DOT TEXTURE DENOTES PAVERS, CER. TILE, VINYL TILE OR VAT. SEE FINISH SCHEDULE FOR EXACT LOCATIONS.
  6. VERIFY EXACT LOCATION OF LAWS W/ ARCHITECT.
  7. DASHED LINE ABOVE THE WASHER/DRYER IS A CONTINUOUS UPPER CABINET W/DOORS. CONSTRUCTION IS TO BE PER THE KITCHEN UPPER CABINETS EXCEPT DELETE ALL WOOD TRIM. PULLS TO BE RECESSED OAK.
  8. SEE SHEET A-9 FOR PLAN DIMENSIONING KEY.