
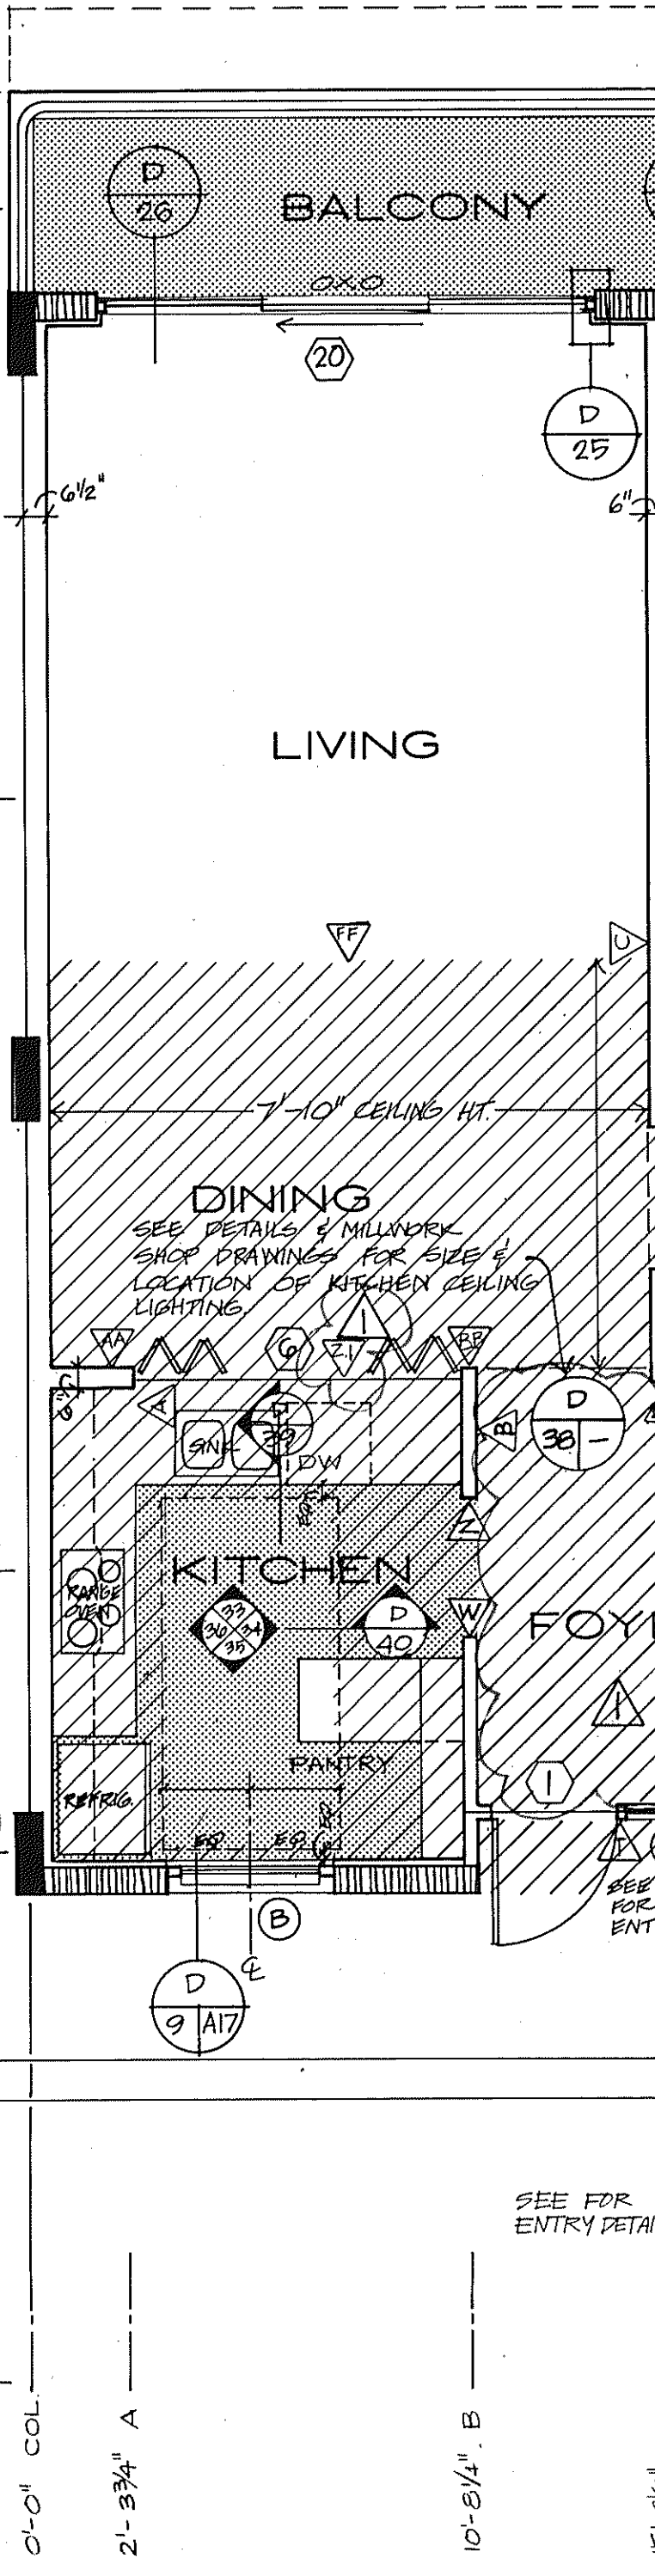
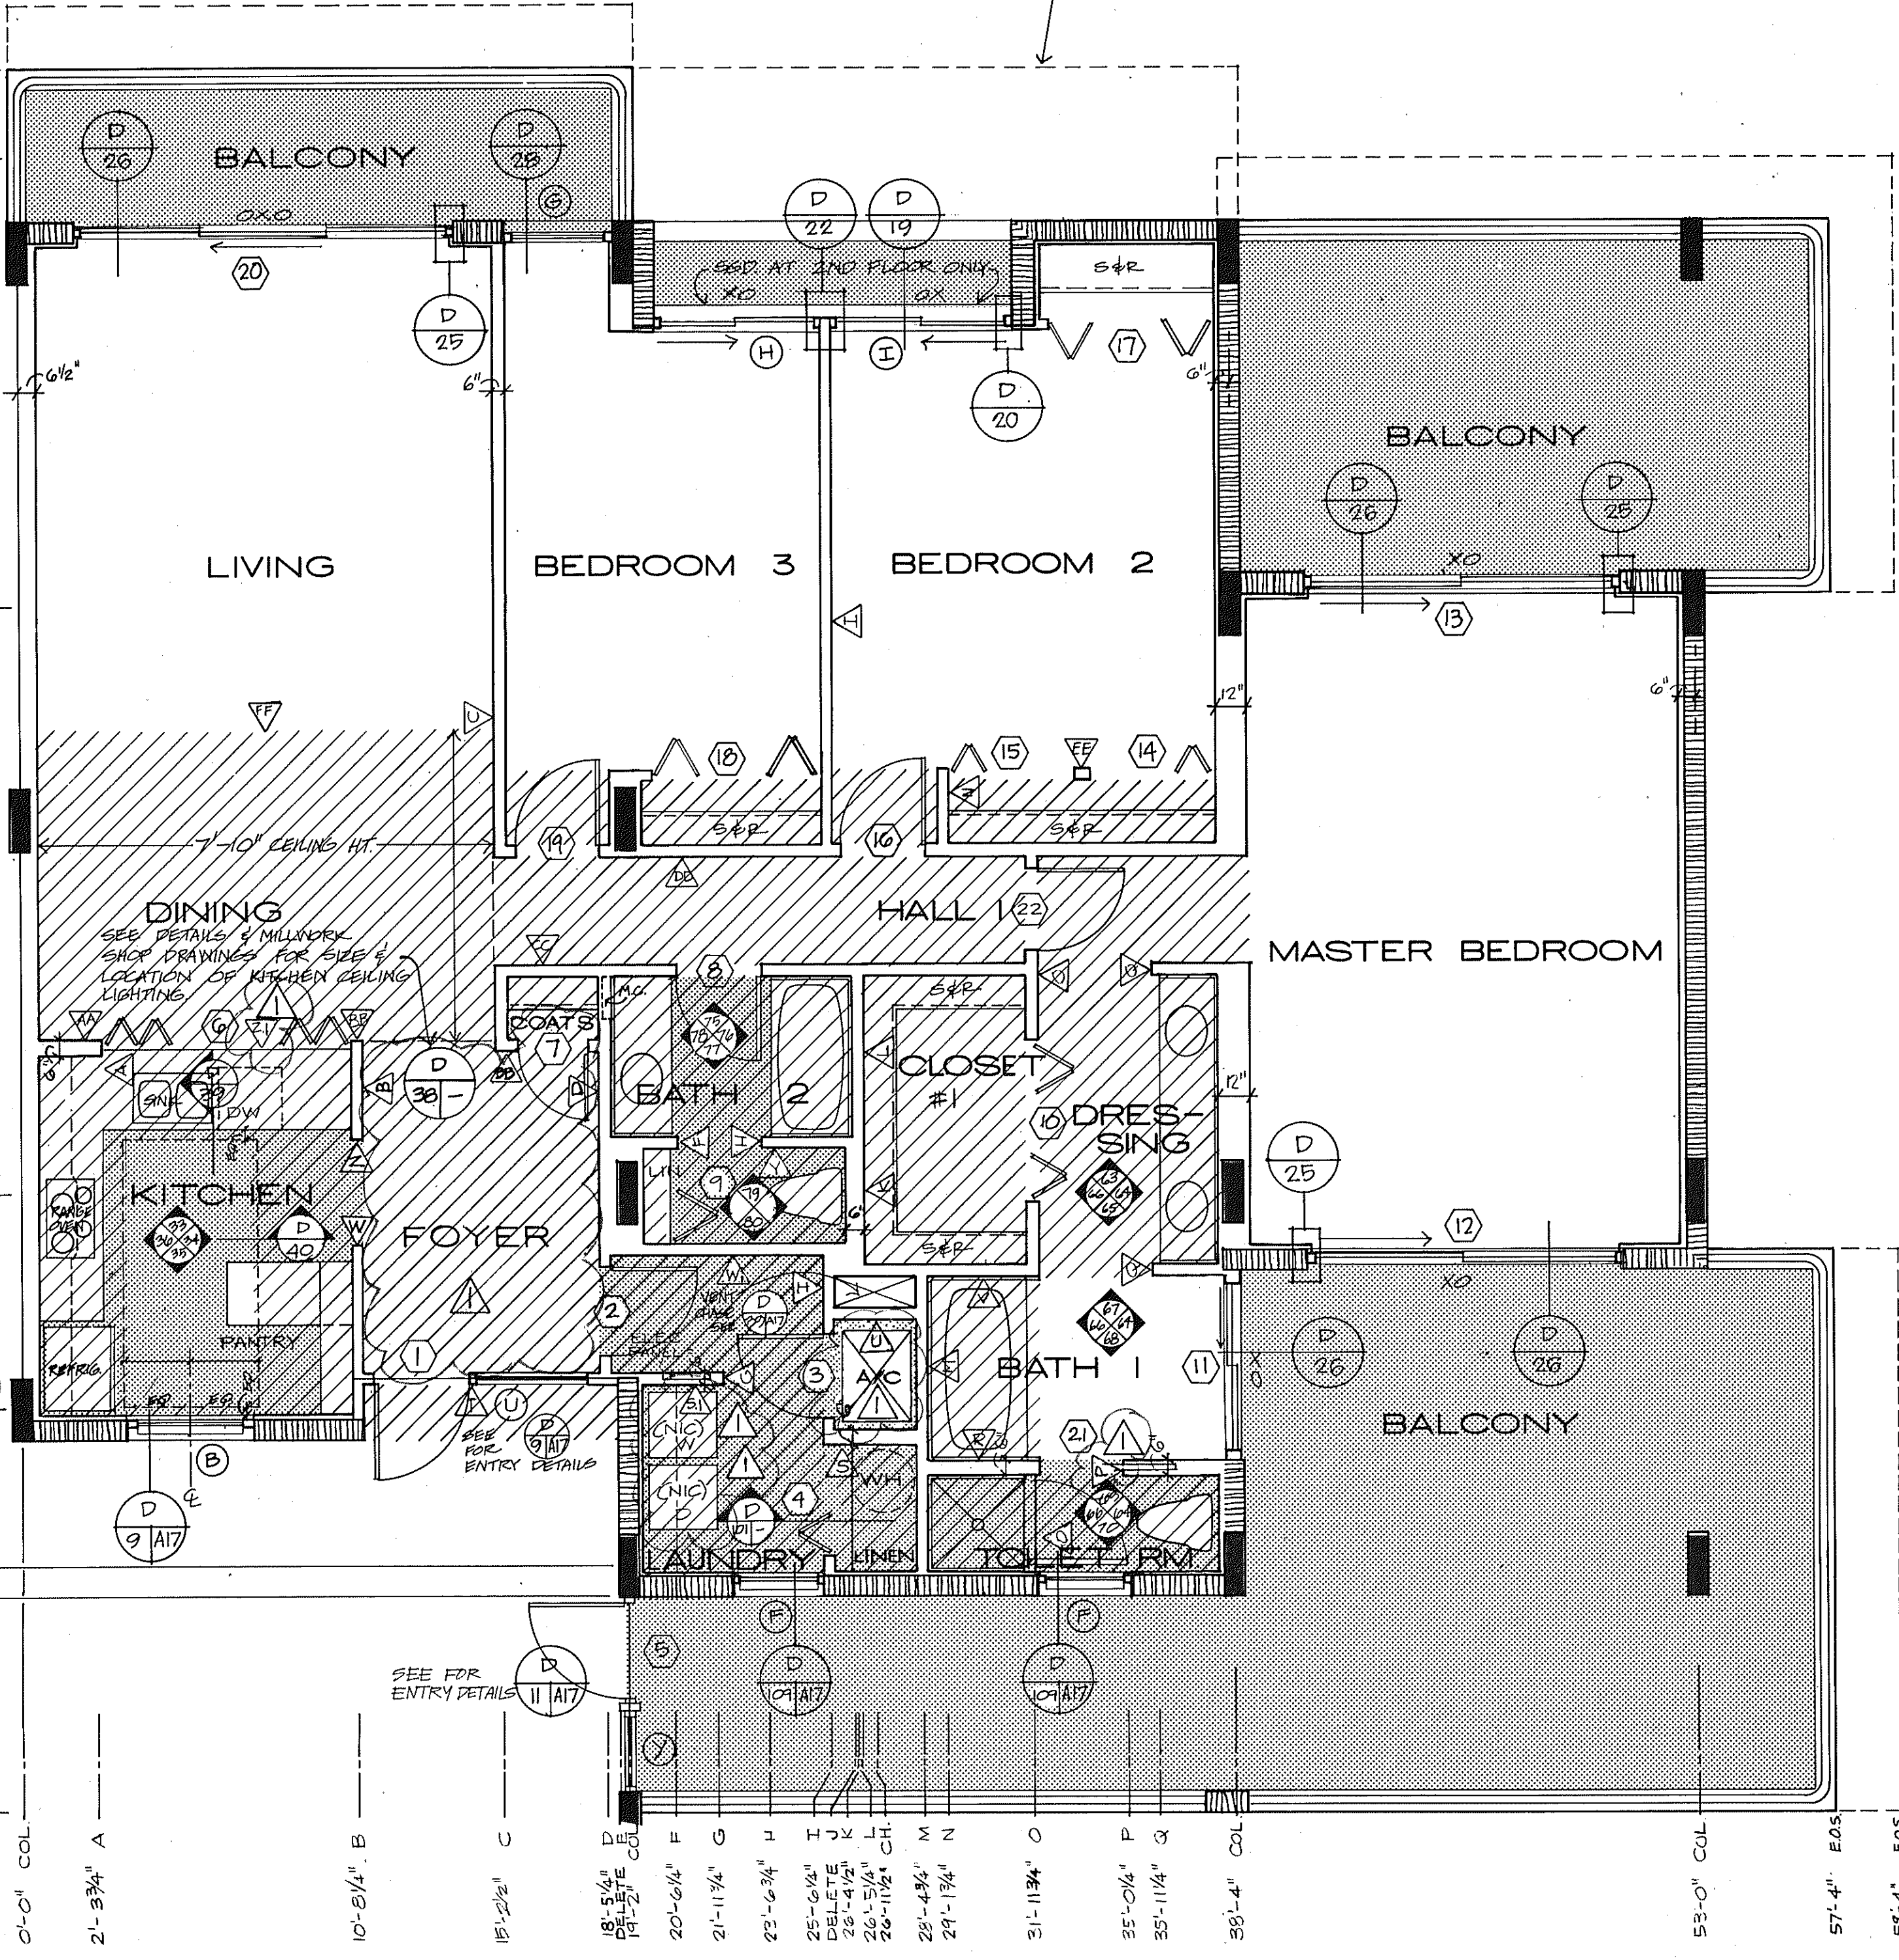
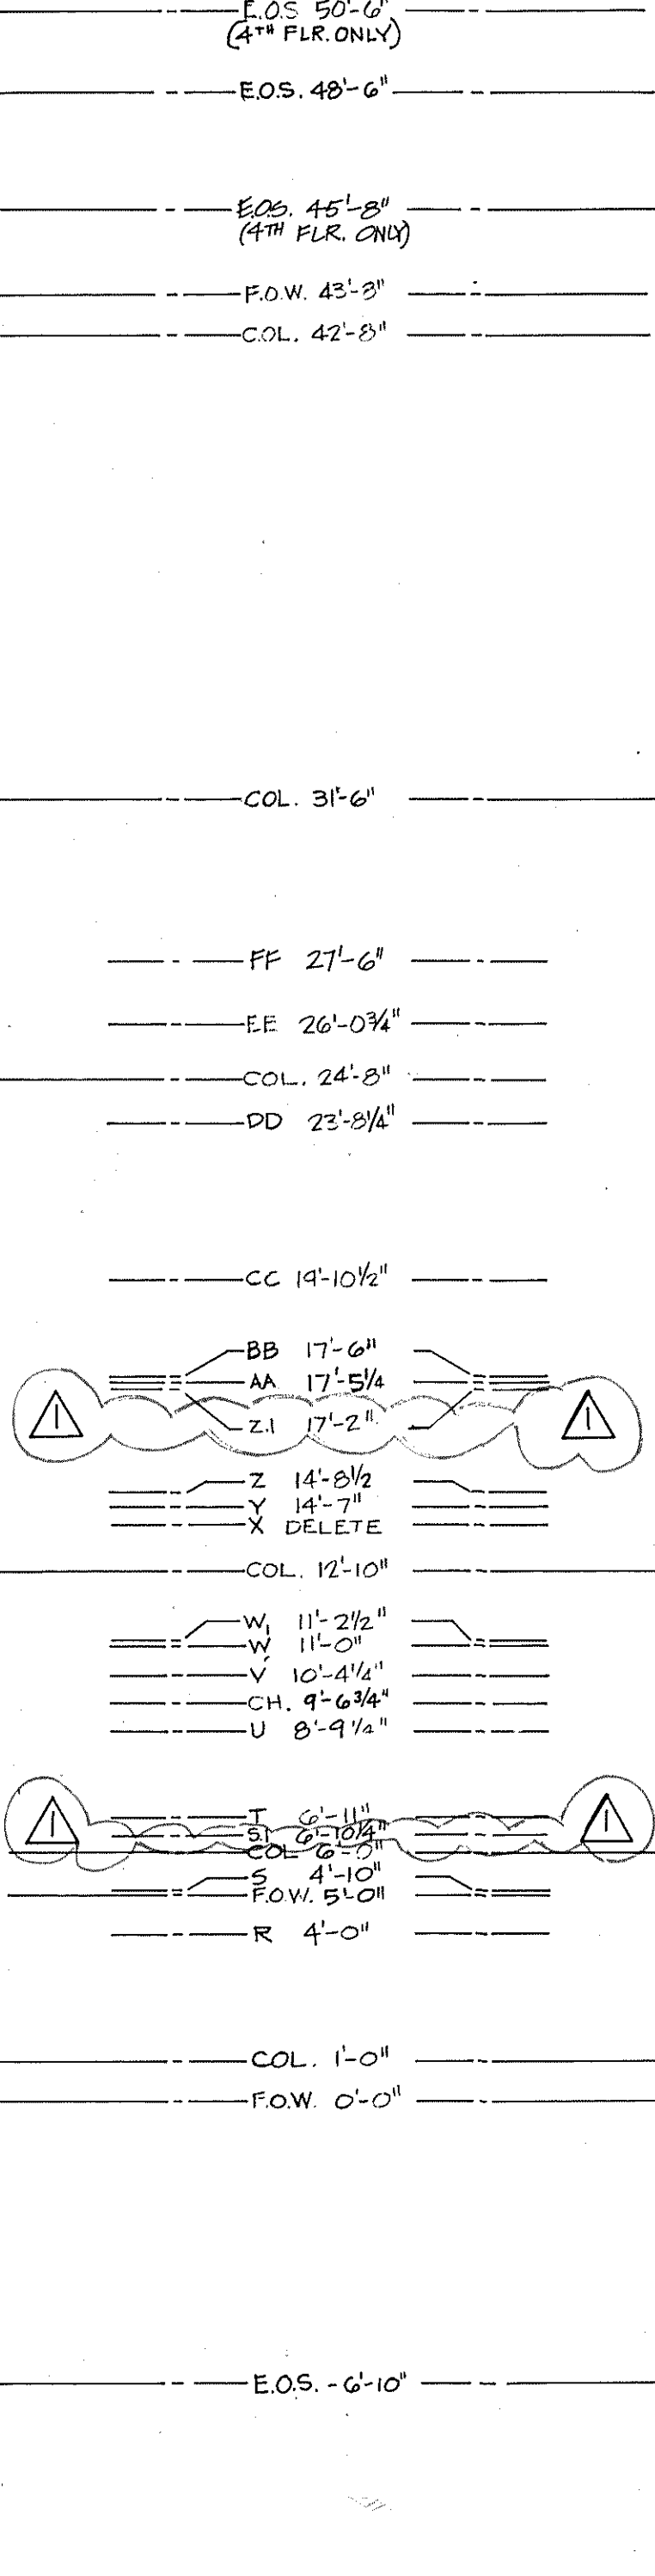


BALCONY @ 2ND FLR. ONLY
SEE 1/8" BLDG. PLANS

NOTE:
BALCONY DEPTHS DIFFER FROM THIS
DRAWING ON 4TH FLOOR. SEE 1/8"
BLDG. PLANS. END WALLS OCCUR ON
4TH FLOOR BALCONIES. SEE 1/8"
BLDG. PLANS.

BALCONY @ 2ND FLR. ONLY
SEE 1/8" BLDG. PLANS

43 43
44 44
45 45
46 46
47 47

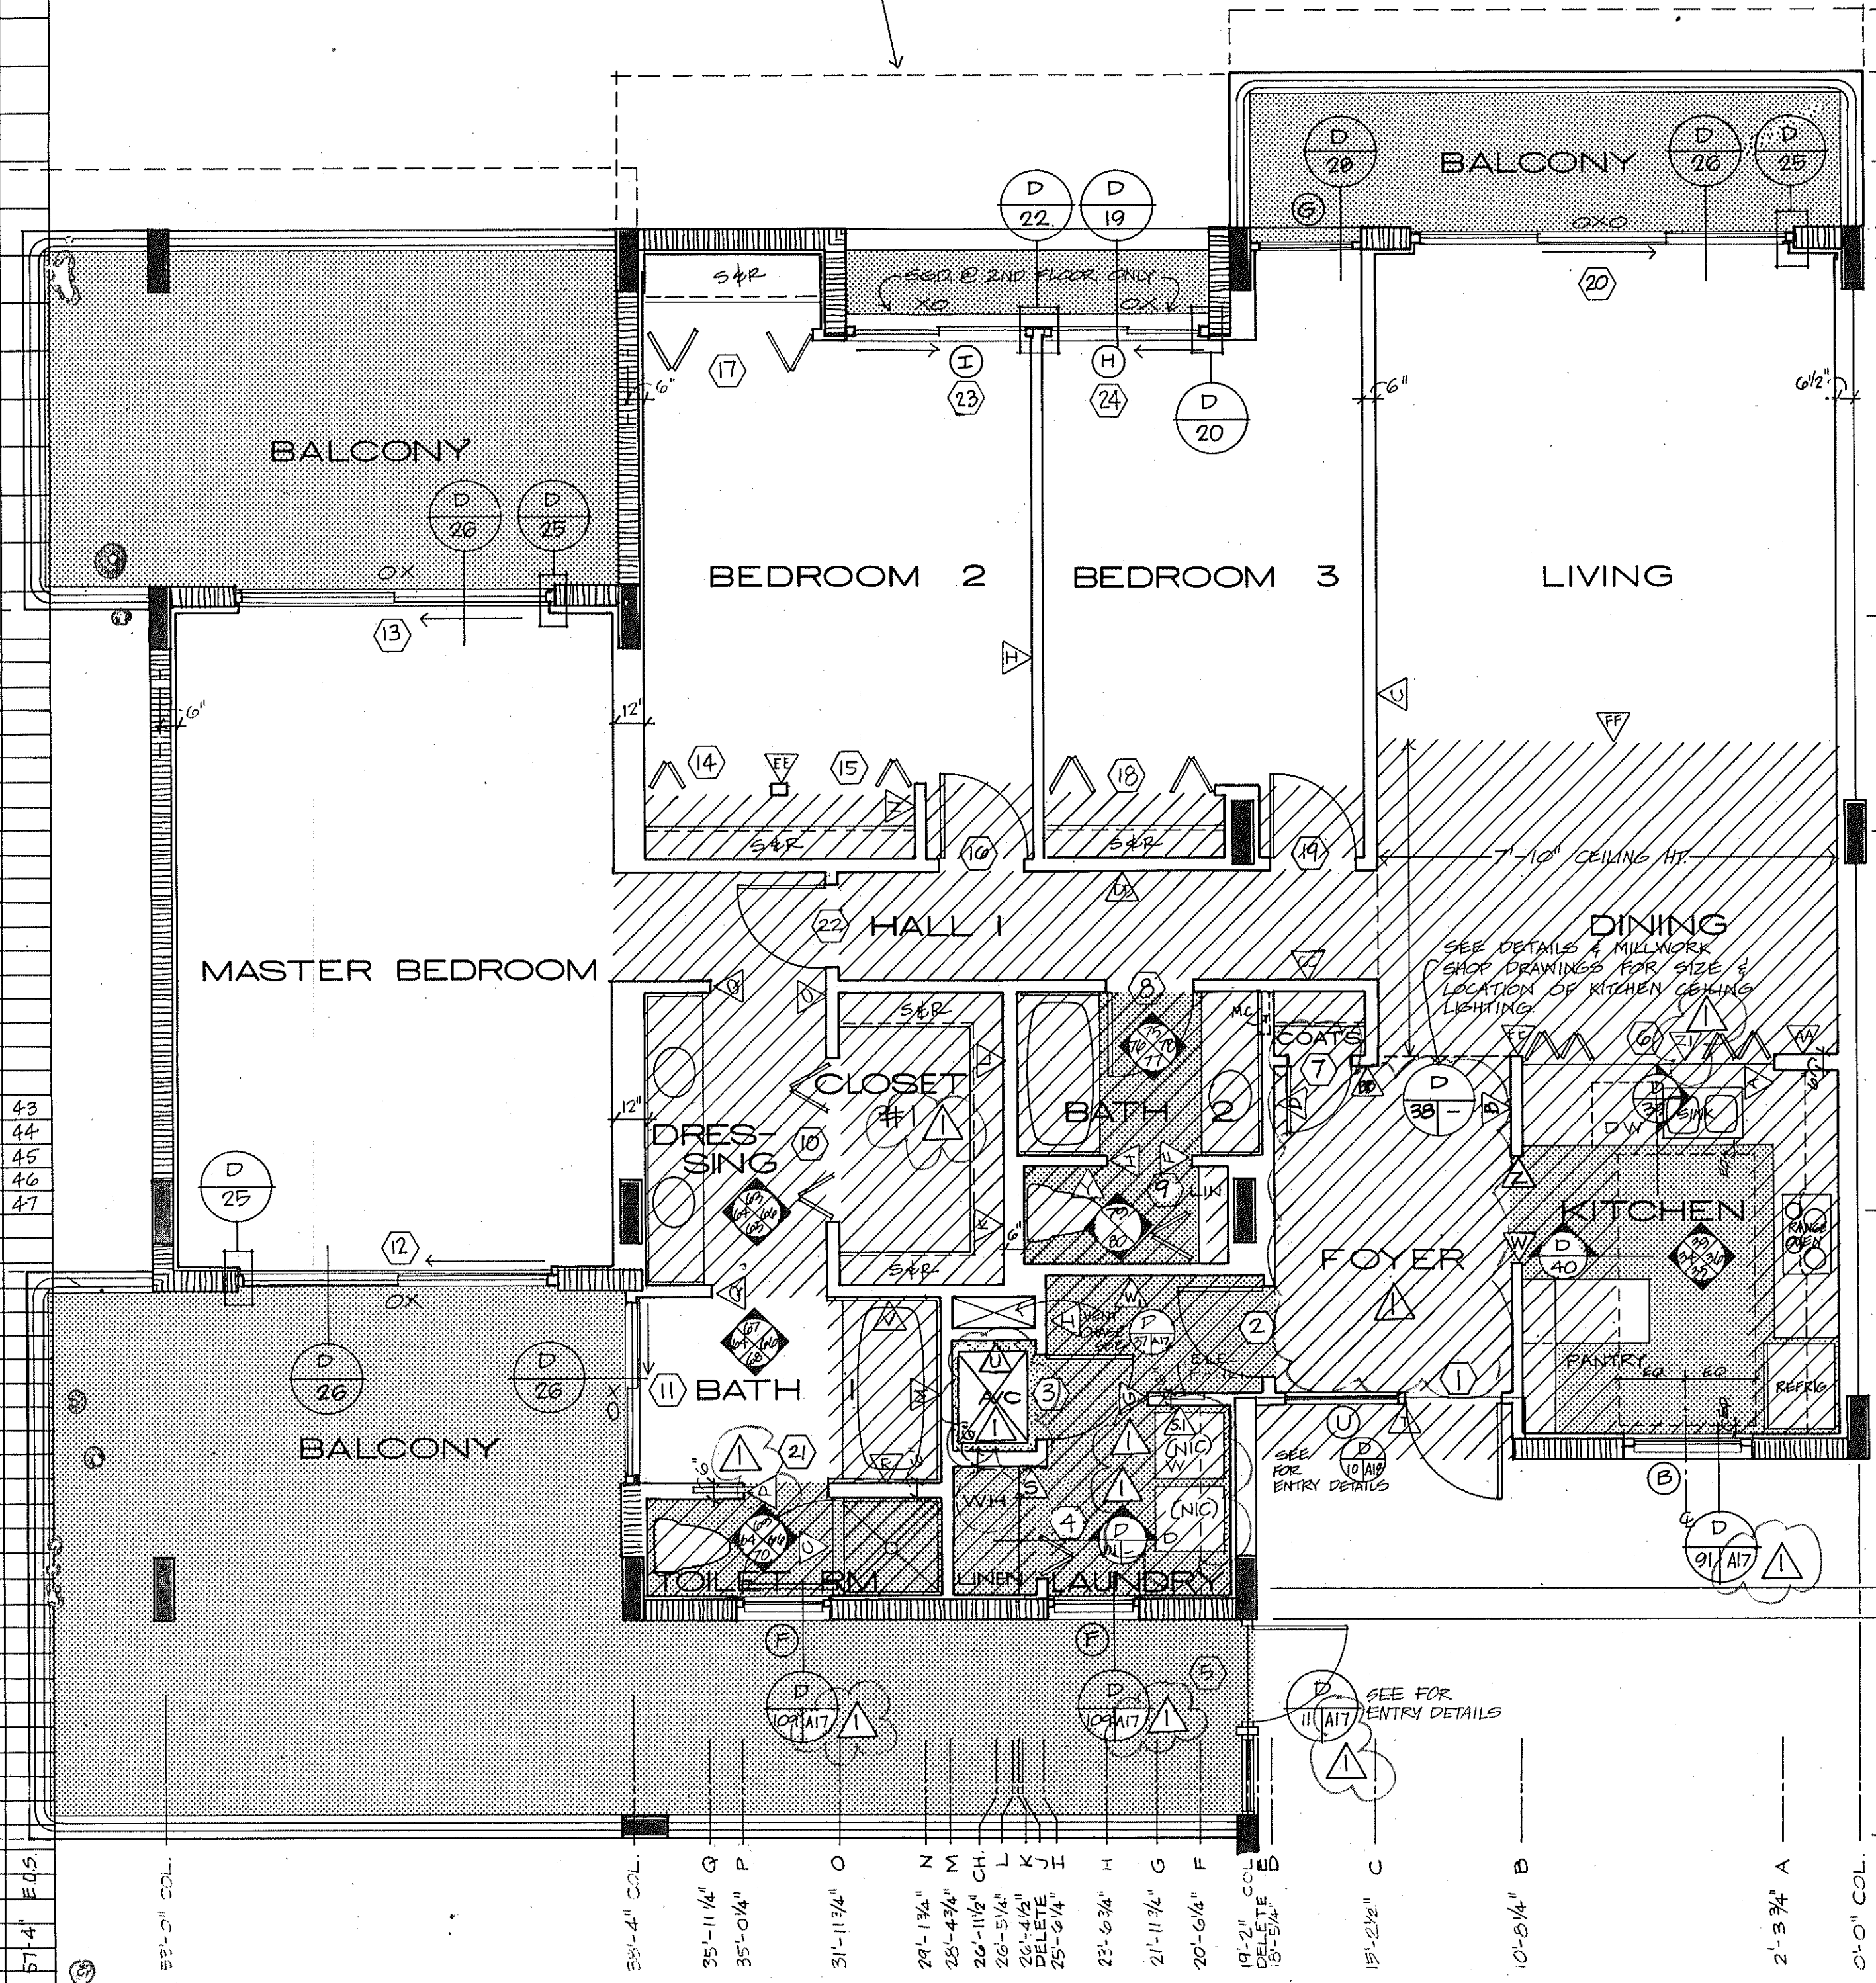

UNIT D LEFT

UNIT D RIGHT

8. SEE SHEET A-9 FOR
PLAN DIMENSIONING KEY.

- NOTES:
1. SEE 1/8" BLDG. PLANS FOR COLUMN & SHEAR WALL LOCATIONS
 2. ALL DROPPED CEILINGS ARE 7'-0" UNLESS OTHERWISE NOTED.
 3. ALL DIMENSIONS ARE FROM CENTERLINE OF WALL.
 4. SEE DETAIL BOOKLET FOR DOOR, WINDOW & FINISH SCHEDULES.
 5. SCREEN DOT TEXTURE DENOTES PAVERS, CER. TILE, VINYL-TILE OR SEE FINISH SCHEDULES FOR EXACT LOCATIONS.
 6. VERIFY EXACT LOCATION OF LAVS W/ ARCHITECT.
 7. DASHED LINE ABOVE THE WASHER/DRYER IS A CONTINUOUS UPPER CABINET W/ DOOR'S. CONSTRUCTION IS TO BE PER KITCHEN UPPER CABINETS EXCEPT DELETE ALL WOOD TRIM. PULLS TO BE RECESSED OAK.

ISSUED
10 DEC. 82

REVISED
4-1-83

SHEET

A-17

OF 37