


SLAB NOTES
 SLAB THICKNESS = 8" (EXCEPT WHERE NOTED ON TOP STEEL SHT.)
 CONCRETE STRENGTH = 4000 P.S.I.
 REINFORCING STEEL
 GRADE = A615-60
 PLACEMENT NOTES & DETAILS = SHT. #S-14
 (+) BARS ARE ADD BARS & ARE IN ADDITION TO GRID REINF. SHOWN ON PLAN.
 REFERENCE NOTES
 COLUMN SCHEDULE = SHT. #S-15
 SHEARWALL SCHEDULE = SHT. #S-16
 BEAM SCHEDULE = SHT. #S-17

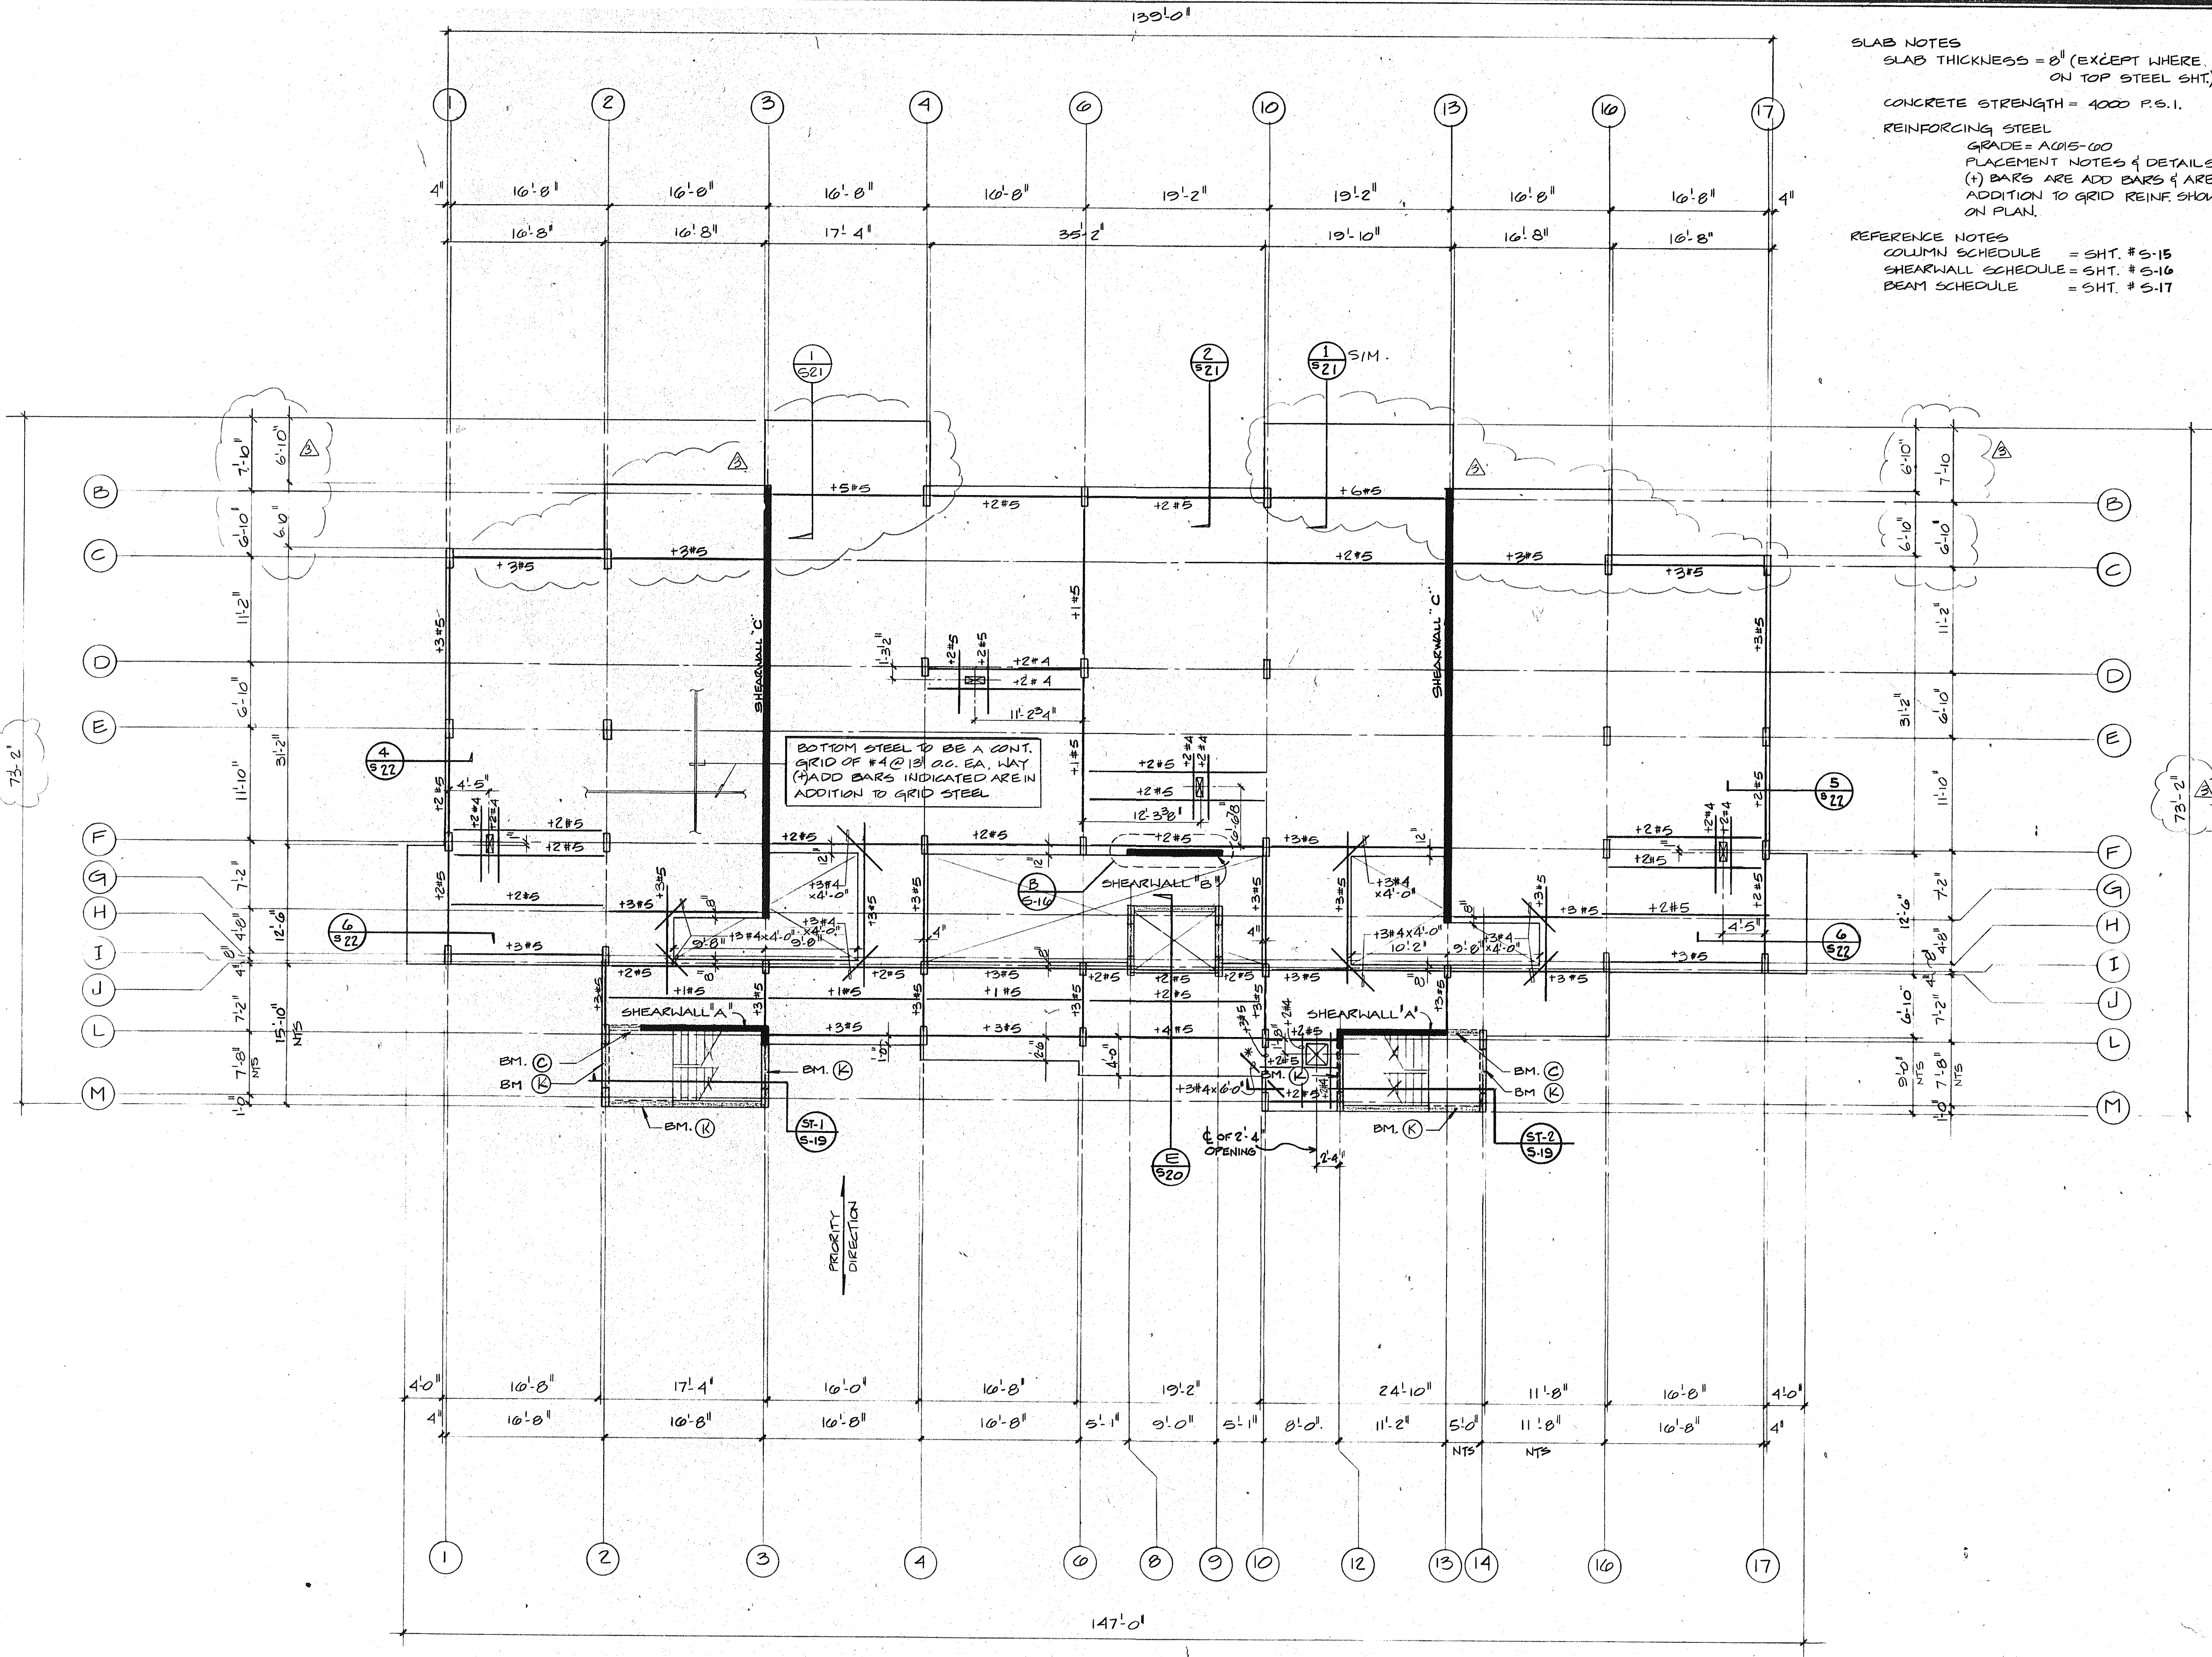

SUNSET BEACH
 OF LONG BEACH AT KEY
 BLDG. #1
 THIRD FLOOR
 BOTTOM STEEL PLAN
 1/8" = 1'-0"
 ISSUED 12-10-02
 REVISED 1-4-03
 11-11-03
 SHEET S.8 OF 24
 ARVIDA CORPORATION, EDWARD J. SEIBERT, ARCHITECT & PLANNER P.A., THE SWA GROUP
 BRABHAM, KUHN, DEBAY CONSULTING ENGINEERS, OLSEN, WHITE & ASSOCIATES STRUCTURAL ENGINEERS, BENNETT & BISHOP, INC. CONSULTING ENGINEERS & SURVEYORS