



- ① PHOTOCONTROL ON, PHOTOCONTROL OFF
- ② PHOTOCONTROL ON, TIME SWITCH OFF
- ③ TIME SWITCH ON, TIME SWITCH OFF

LIGHTING CONTROL DIAGRAM

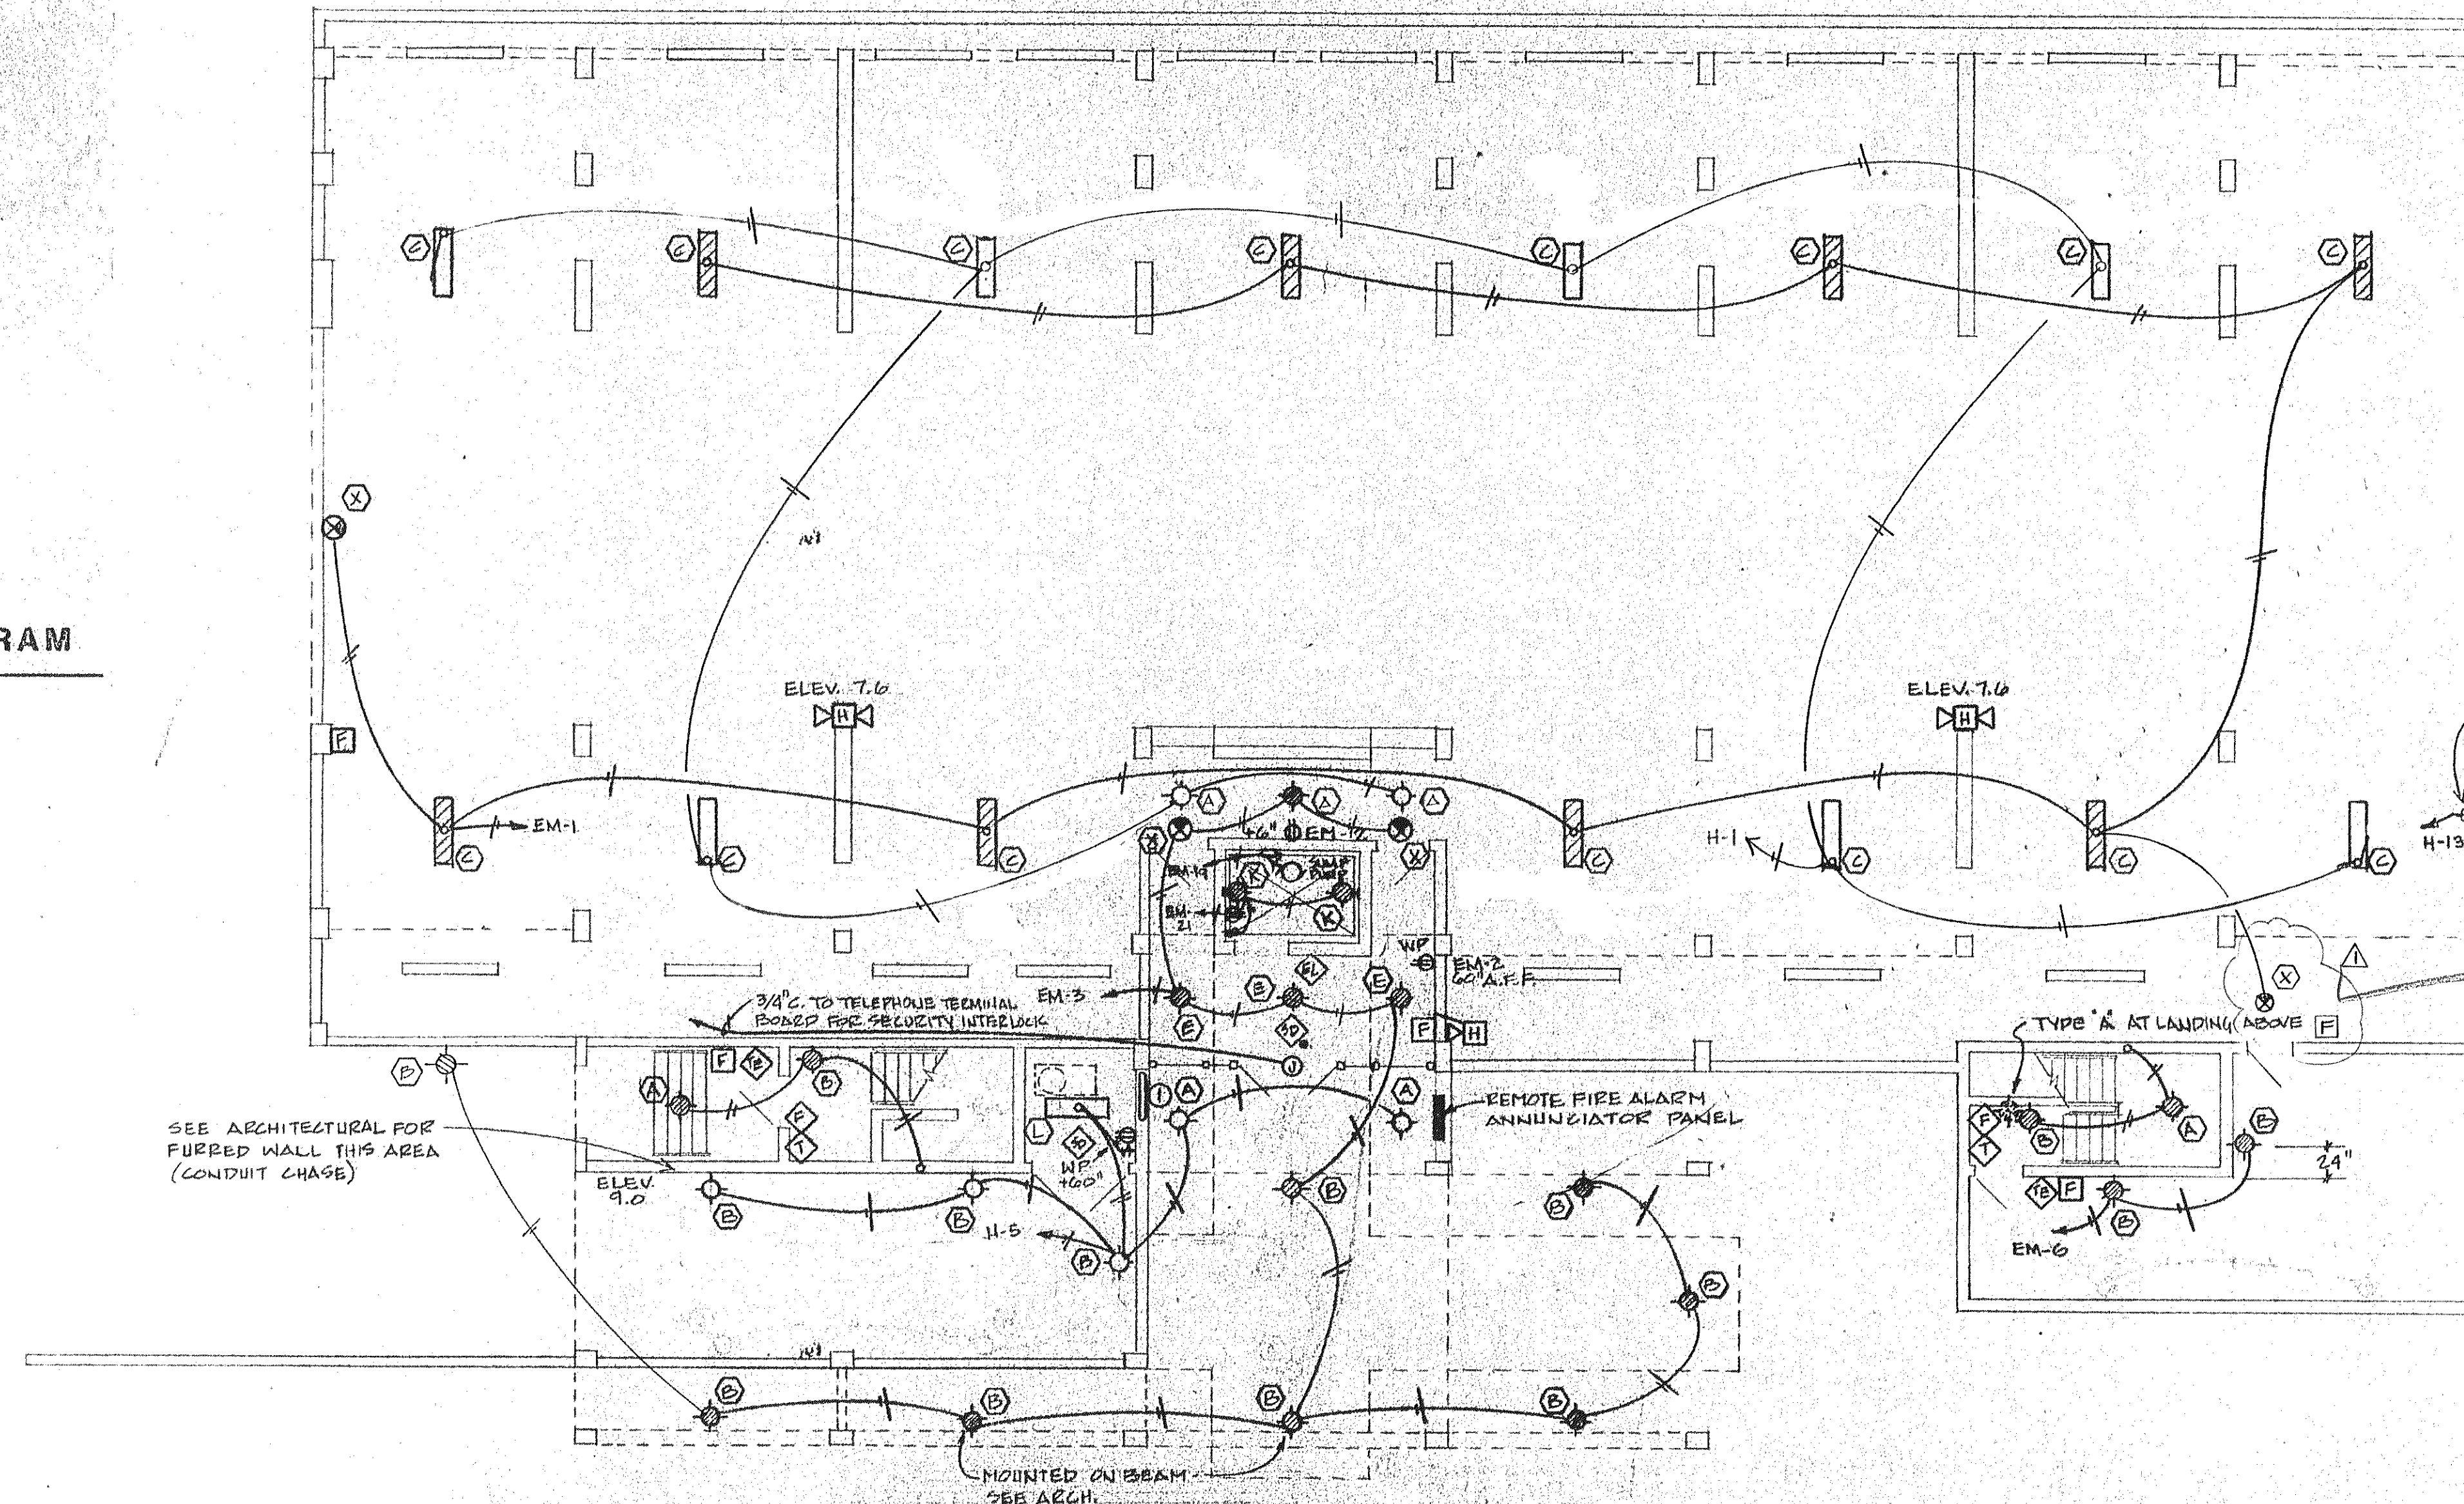

- 1. LOBBY FINISHED FLOOR
ACTUAL ELEVATION - 7.7 MSL.
- 2. ASSUMED ELEVATION OF LOBBY O.D
- 3. ALL ELEVATIONS INDICATED ARE RELATED TO ASSUMED ELEV. 0.0 UNLESS OTHERWISE INDICATED.

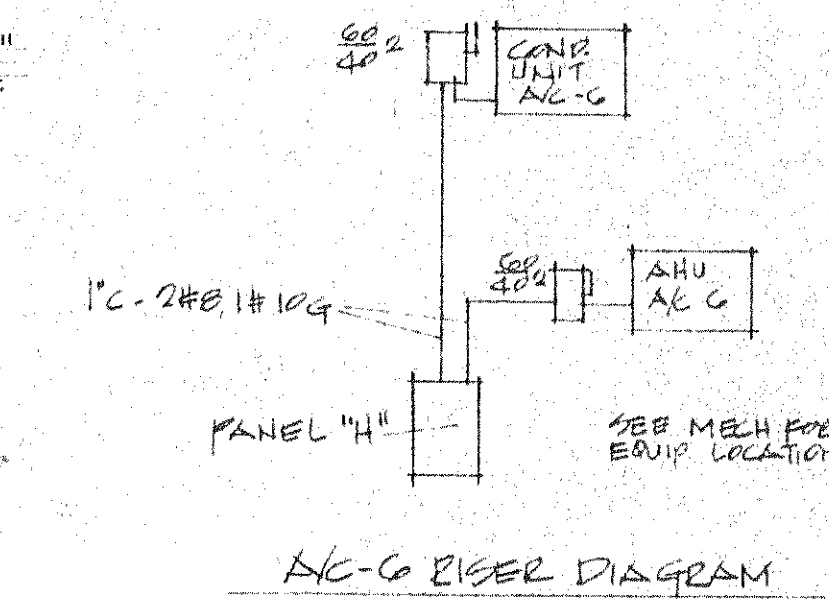

BUILDING 2 - GROUND FLOOR ELECTRICAL PLAN

scale 1/8" = 1'-0"

- ① TELEPHONE ENTRY SYSTEM - PEDESTAL MOUNTED TYPE TRIADON 600 SERIES. (PROVIDE 1" CONDUIT TO TELEPHONE TERMINAL BOARD)
- Ⓐ ② ALL LIGHT SWITCHES TO BE MOUNTED 48" ABOVE FIN. FLOOR.
- Ⓐ ③ ALL RECEPTACLES TO BE MOUNTED WITH CENTER LINE 18" ABOVE FIN. FLOOR.

SUNSET BEACH
 SOF LONGBOAT KEY
 ARVADA CORPORATION, EDWARD J. SEIBERT, AIA ARCHITECT & PLANNER, P.A., THE SWA GROUP, BRADHAM, KUHNS, DEBAY CONSULTING ENGINEERS, OLSEN, WHITE & ASSOCIATES' STRUCTURAL ENGINEERS, BENNETT & BISHOP, INC. CONSULTING ENGINEERS & SURVEYORS
 ISSUED
 REVISED
 APPENDIX
 6-23-82
 ACCESSIBILITY
 CODE REQ
 7-15-82
 SHEET
E