


UNIT 'C' LEFT AIR CONDITIONING
 scale: 1/8" = 1'-0"

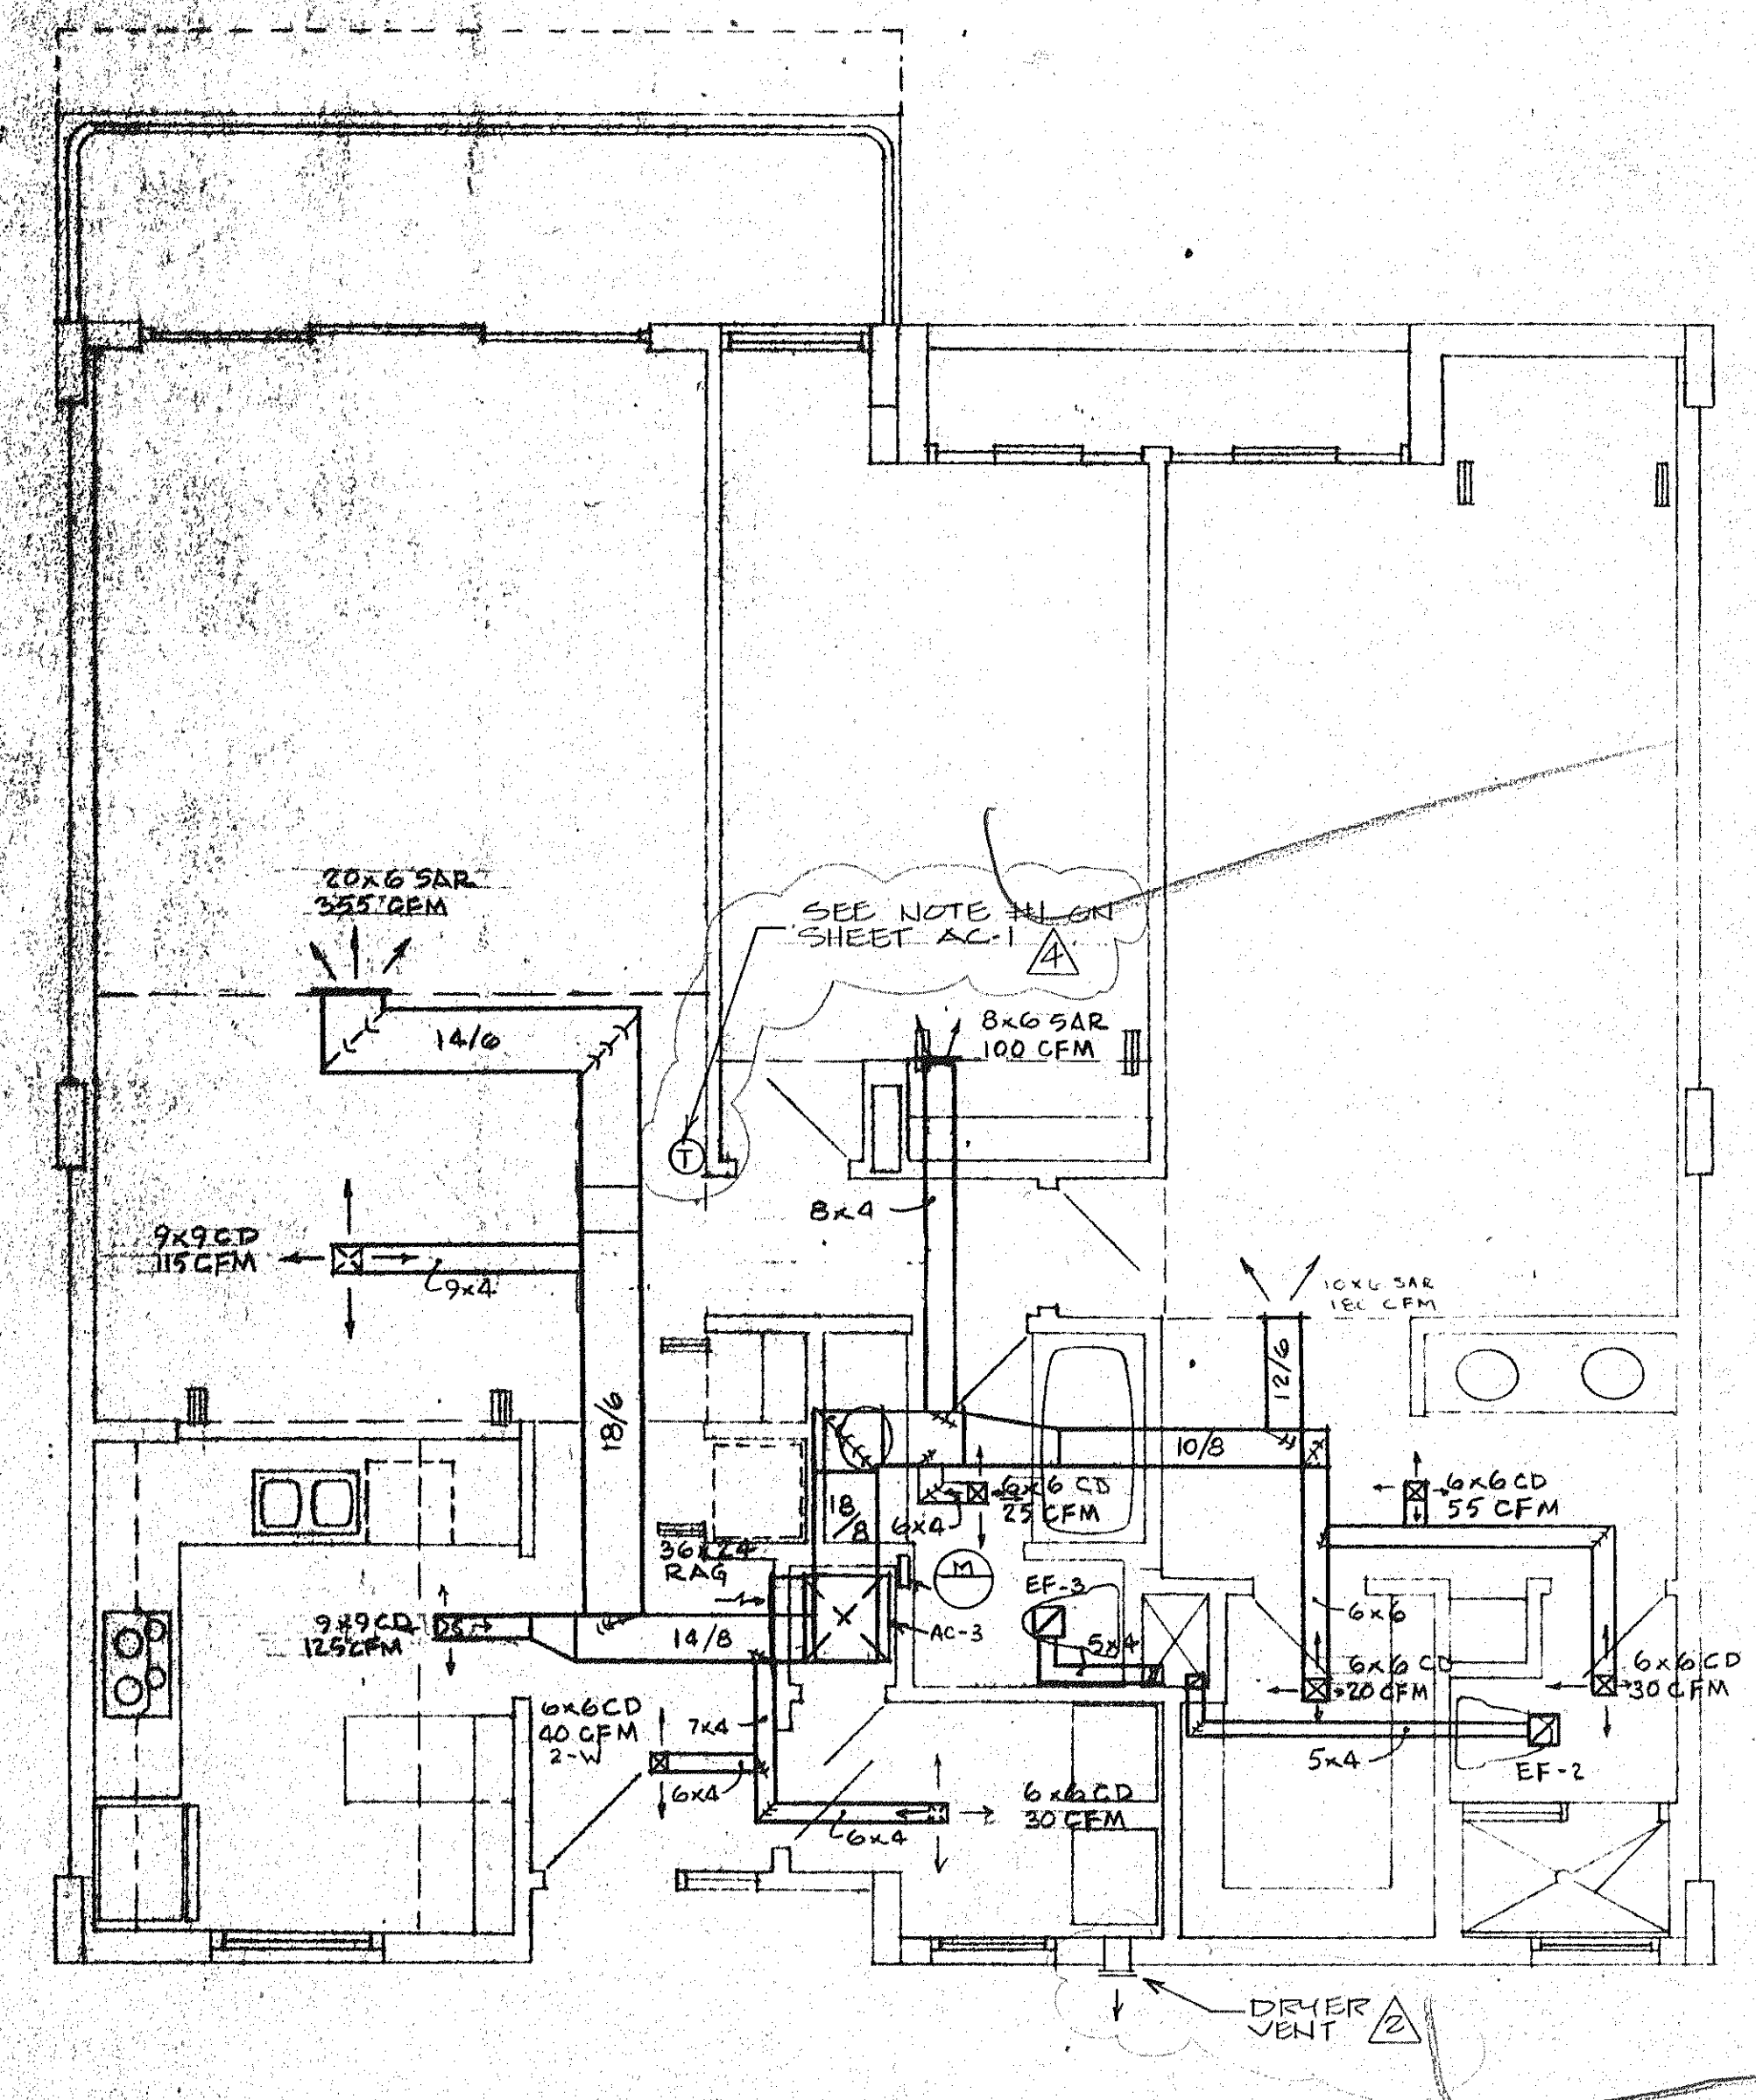

UNIT 'C' RIGHT AIR CONDITIONING
 scale: 1/8" = 1'-0"

ISSUED	4-1-72
REVISED	
DRYER VENT	7-20-72
ACCOUNTING	RJTS/TJS