


UNIT "C" MOD LEFT - AIR CONDITIONING

scale 1/4" : 1'-0"

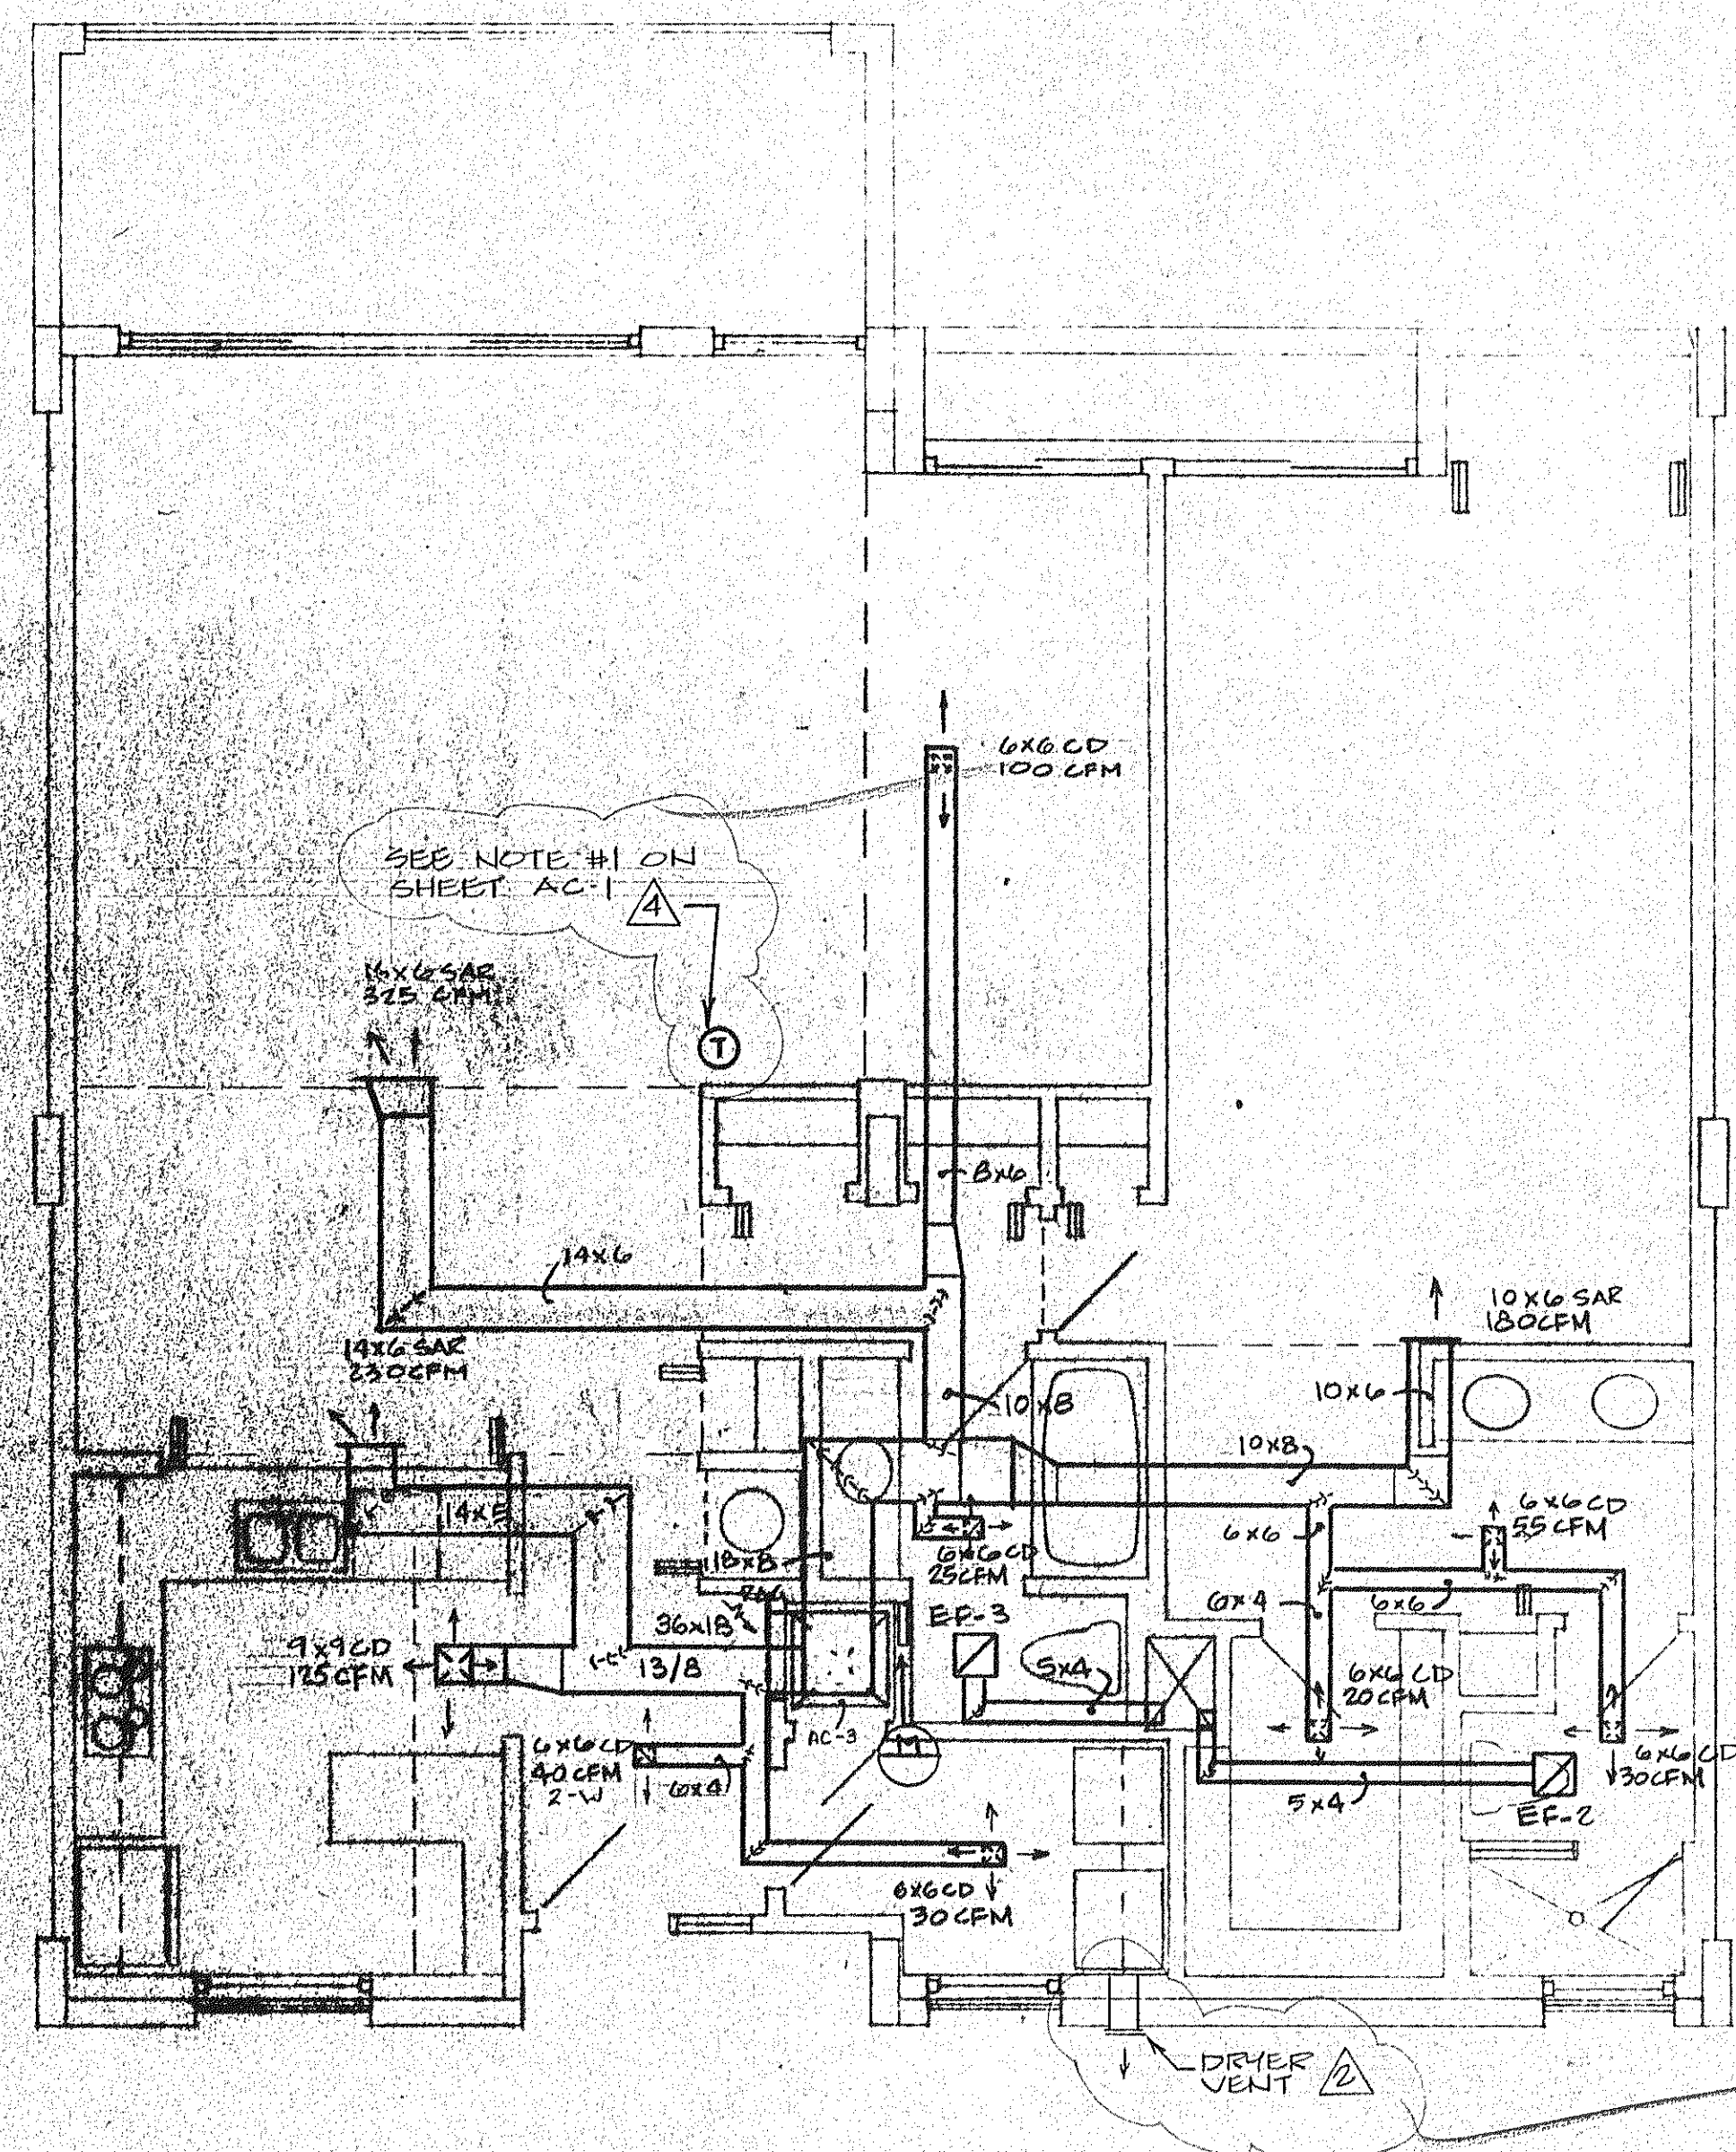

UNIT "C" MOD RIGHT - AIR CONDITIONING

scale 1/4" : 1'-0"

ISSUED	4-1-53
REVISED	
DRYER VENT	T-20-53
ACCESSIBILITY	Part 9 1-13-23
SHEET	
AC-7	
BLDG. 2	