



MARK-5 350 SERIES

- 3 13 XO-10
- 3R 13 Rev OX-10

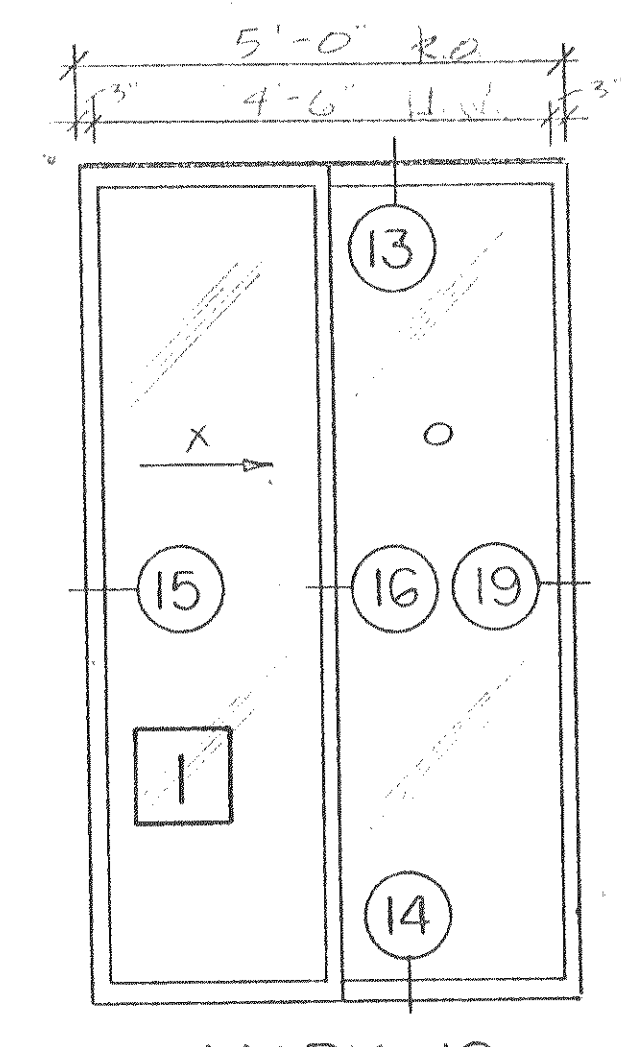


MARK-10 350 SERIES

- 1 13 XO-1
- 1R 13 Rev OX-1

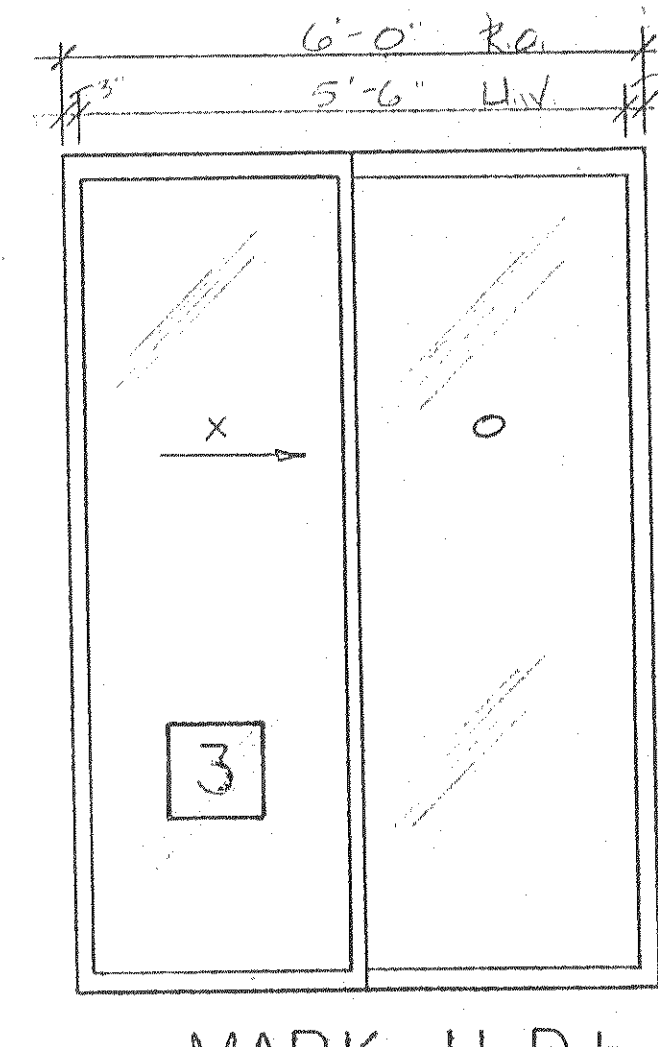


MARK-11 D+ 350 SERIES

- 3 11 D+ XO-1
- 3R 11 D+ Rev OX-1

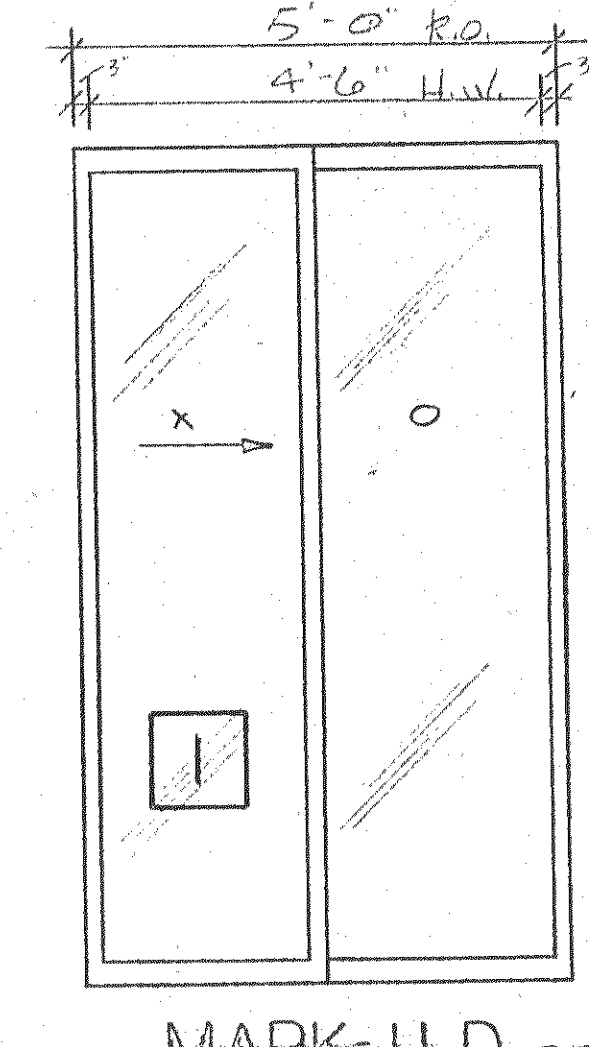


MARK-11 D 350 SERIES

- 1 11 D XO-3
- 1R 11 D Rev OX-3

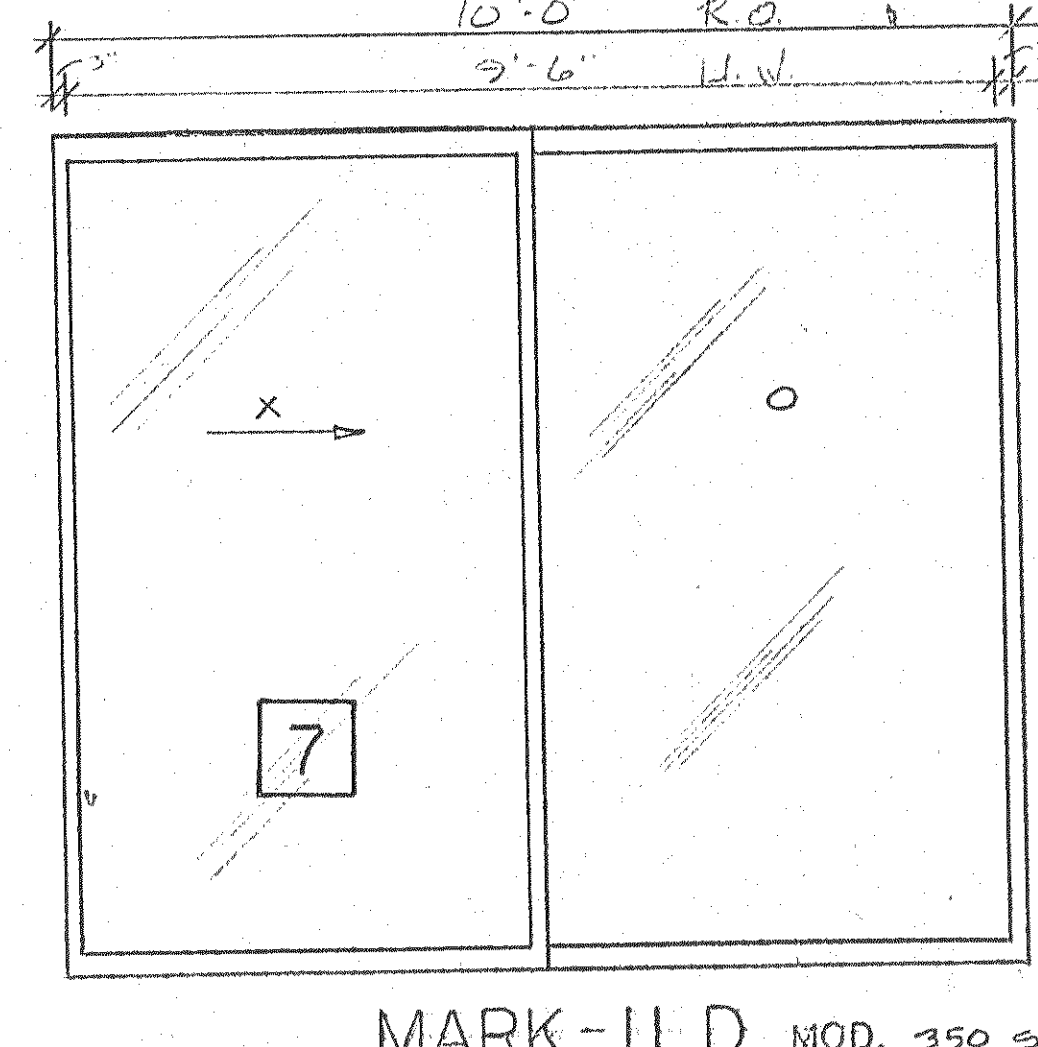

MARK-11 D MOD. 350 SERIES


- 7 11 D Mod XO-1
- 7R 11 D Mod Rev OX-1

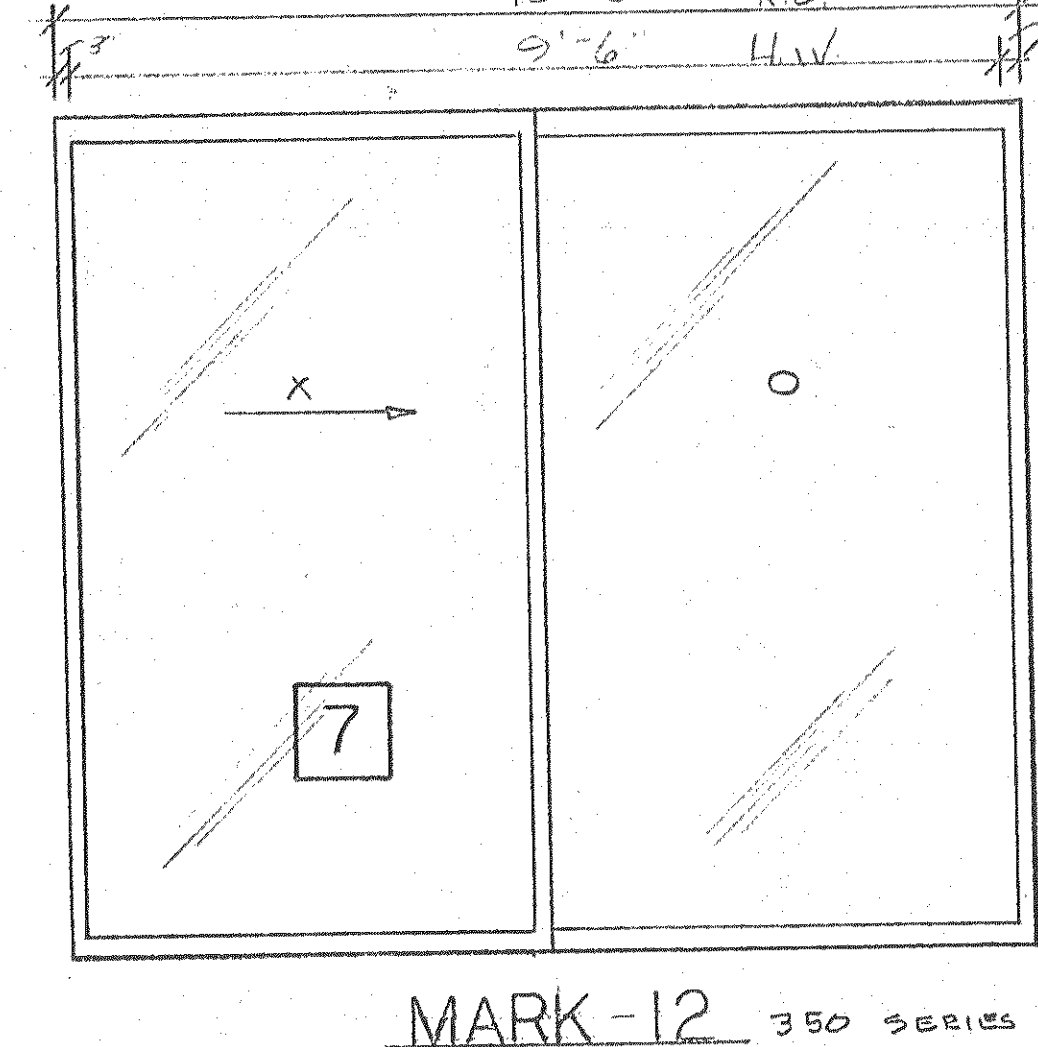

MARK-12 350 SERIES


- 7 12 XO-5
- 7R 12 Rev OX-5

"AS BUILT DRAWG"

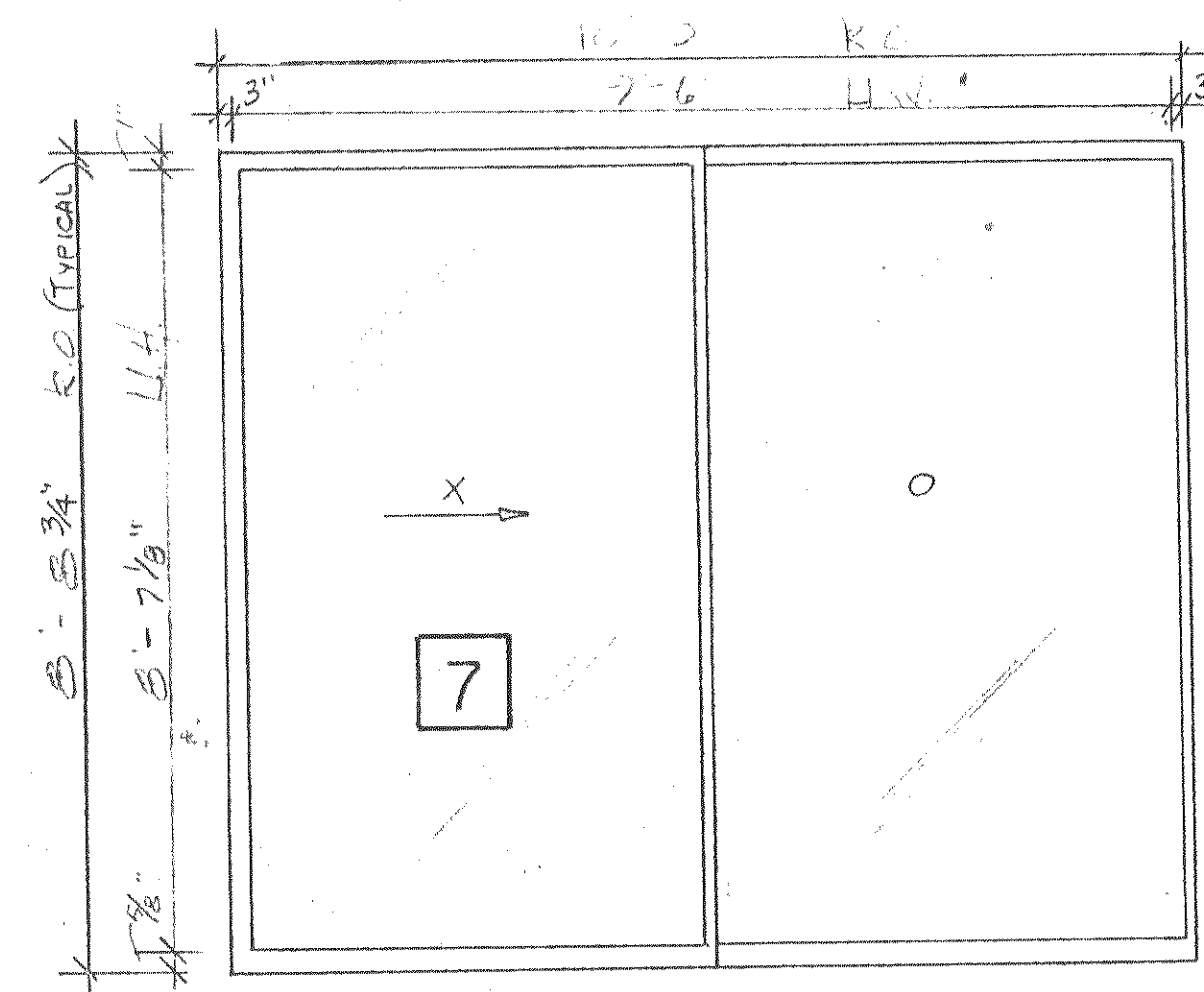


MARK-13 350 SERIES

- 7 13 XO-4
- 7R 13 Rev OX-4

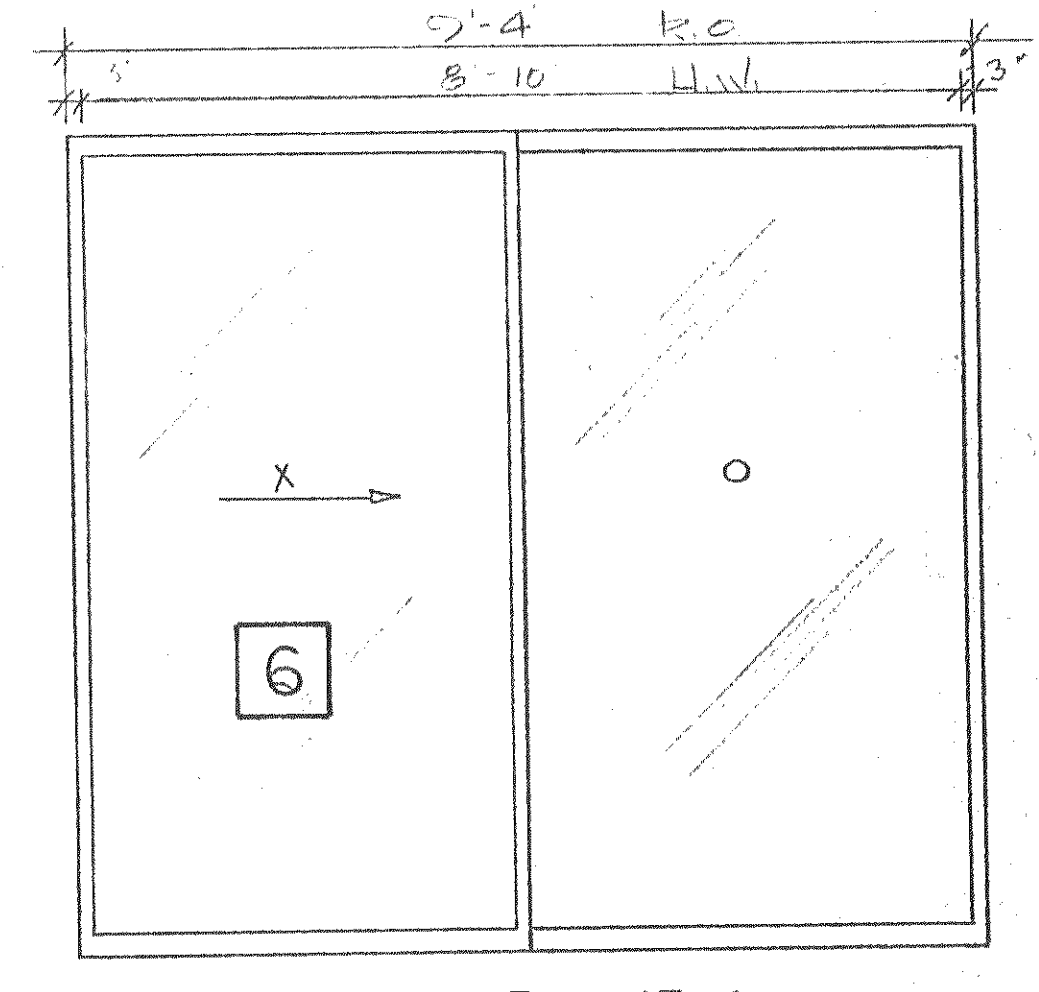


MARK-15 A+ 350 SERIES

- 6 15 A+ XO-2
- 6R 15 A+ Rev OX-1

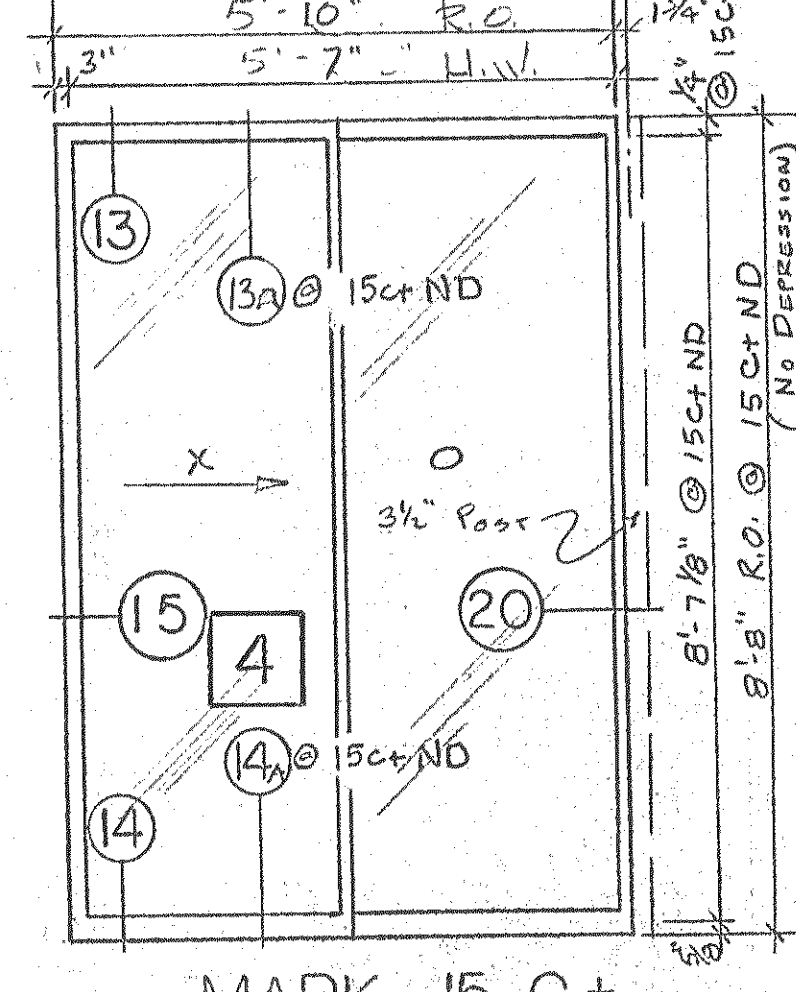


MARK-15 C+ 350 SERIES

- 4 15 C+ XO-1
- 4R 15 C+ Rev OX-1
- 4 15 C+ ND XO-1
- 4R 15 C+ ND Rev OX-1

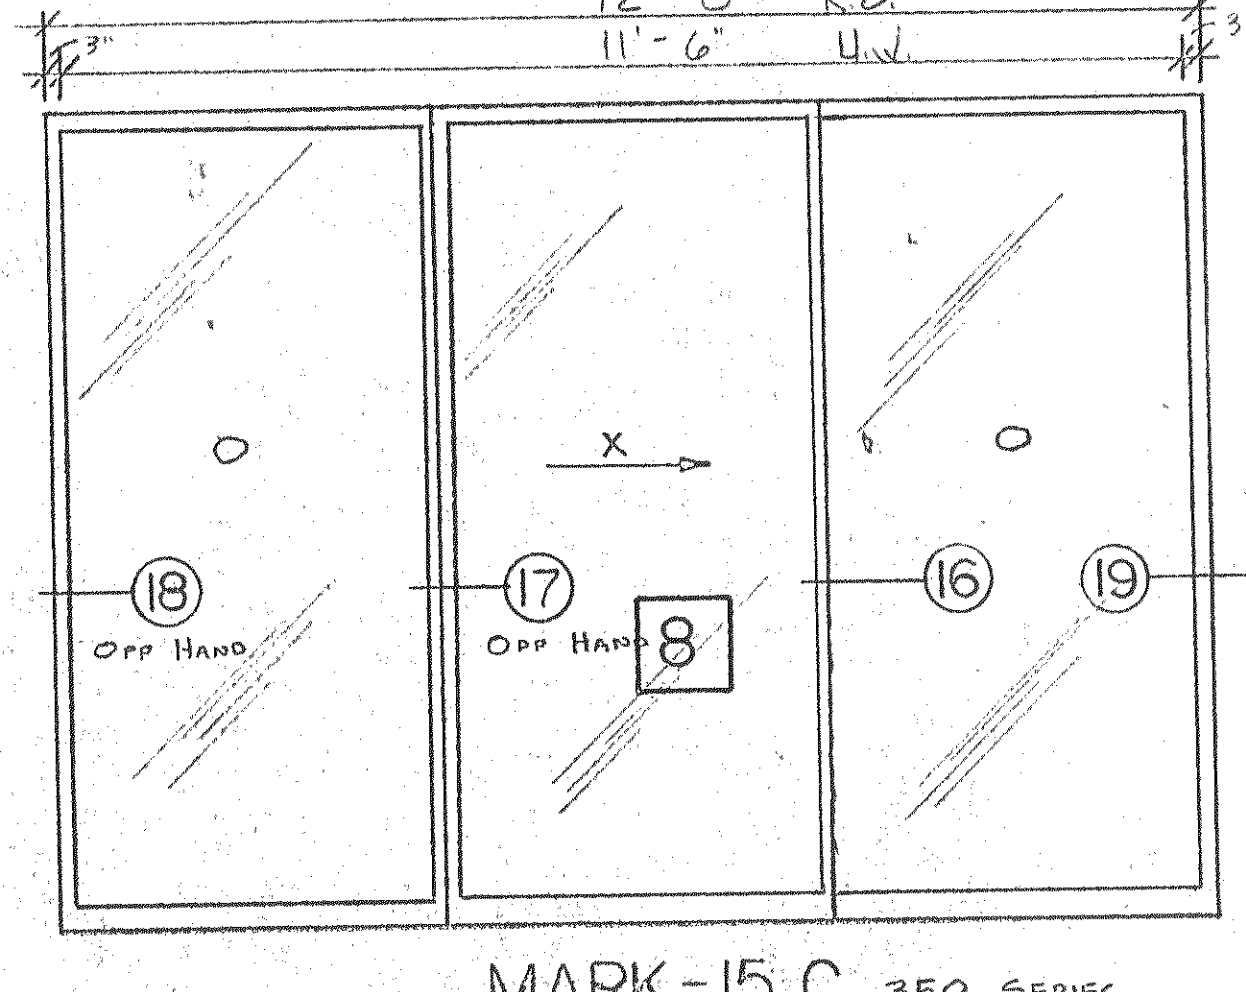


MARK-15 C 350 SERIES

- 8 15 C OXO -> 6
- 8R 15 C Rev OXO -< 6

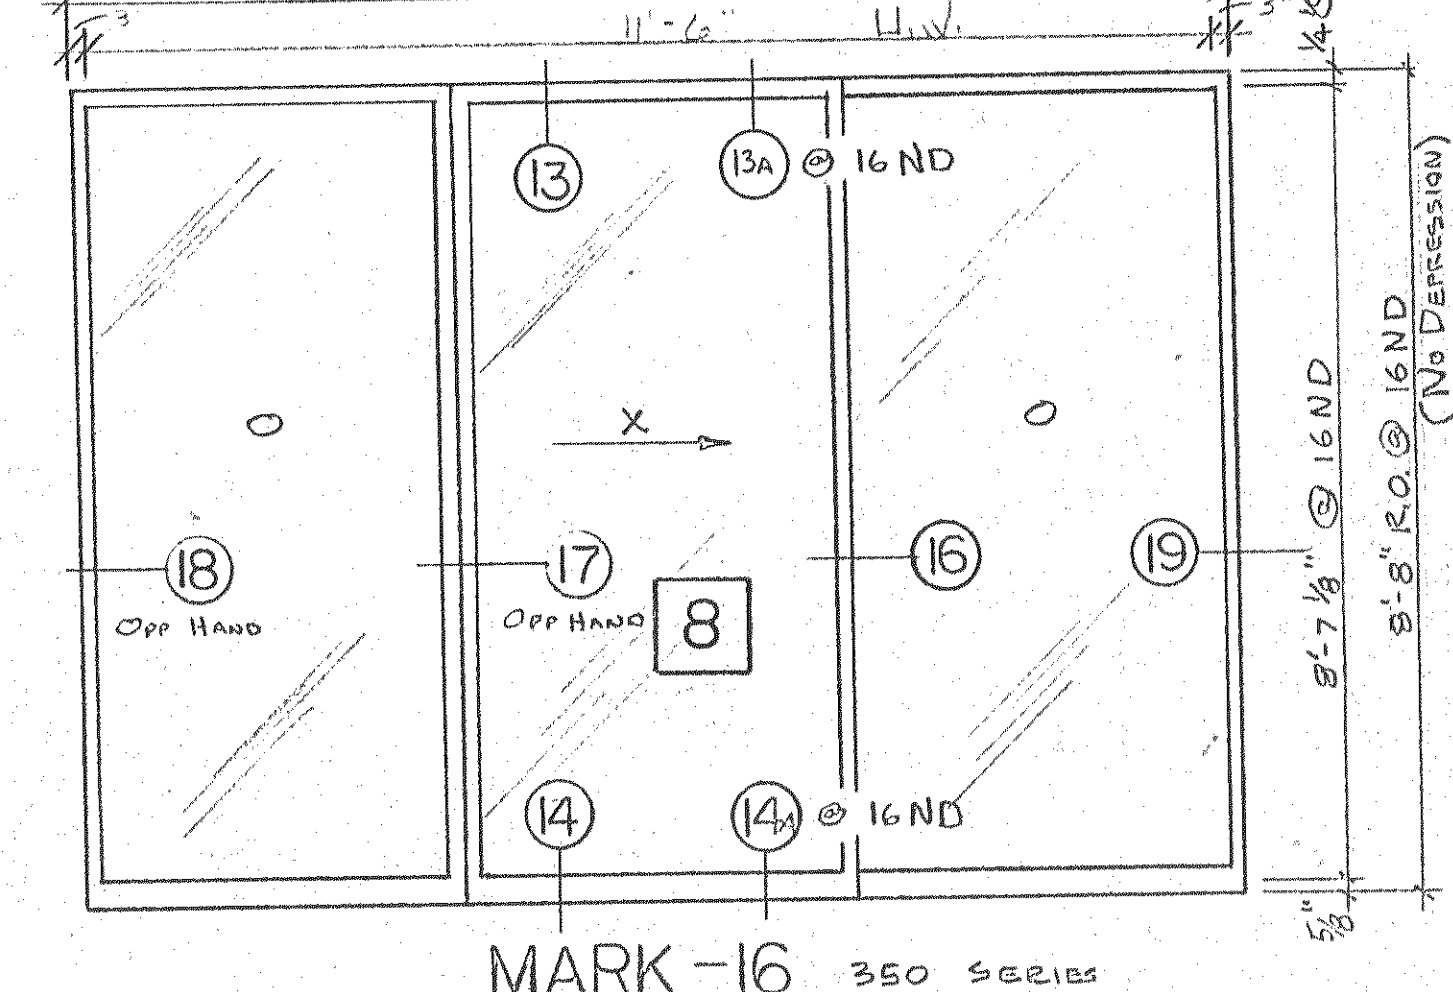


MARK-16 350 SERIES

- 8 16 OXO -> 16
- 8R 16 Rev OXO -< 16
- 8 16 ND OXO -> 1
- 8R 16 ND Rev OXO -< 1

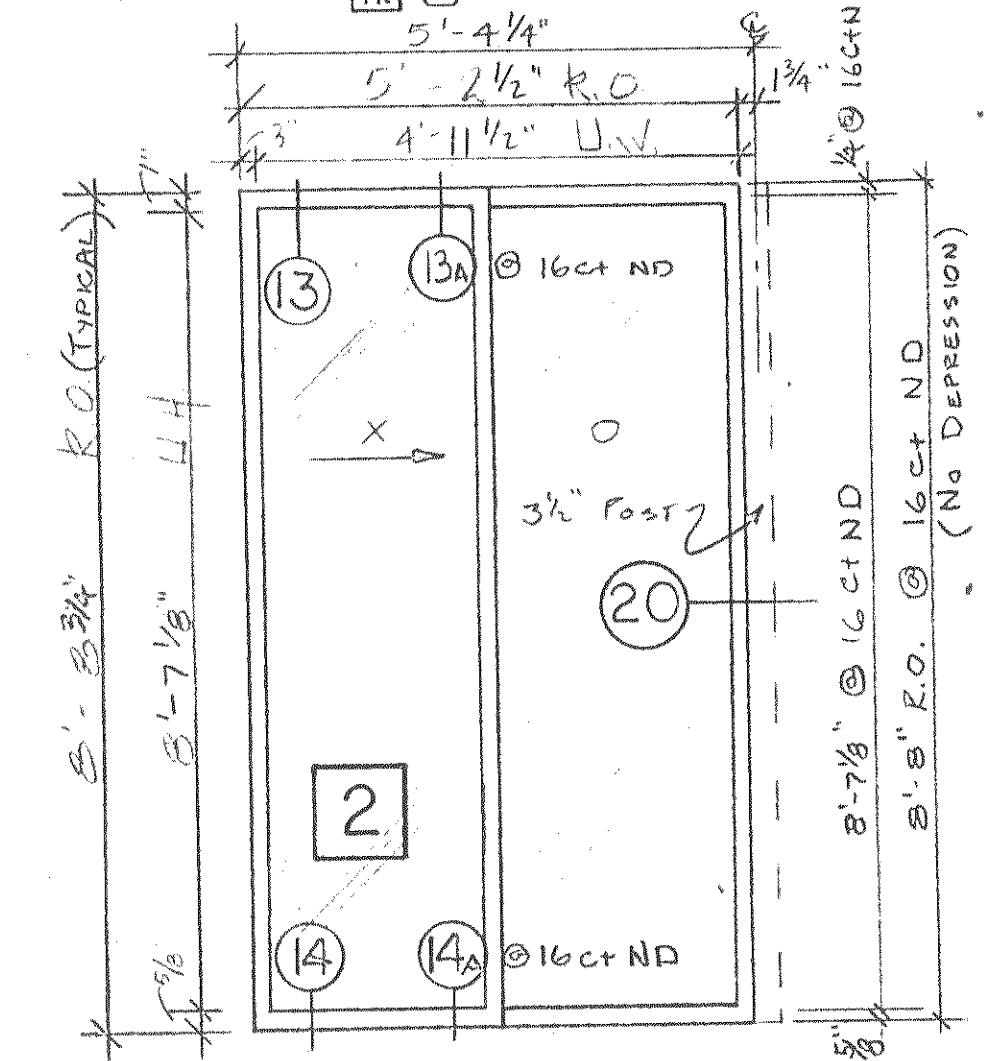


MARK-16 C+ 350 SERIES

- 2 16 C+ XO-1
- 2R 16 C+ Rev OX-3
- 2 16 C+ ND XO-
- 2R 16 C+ ND Rev OX-

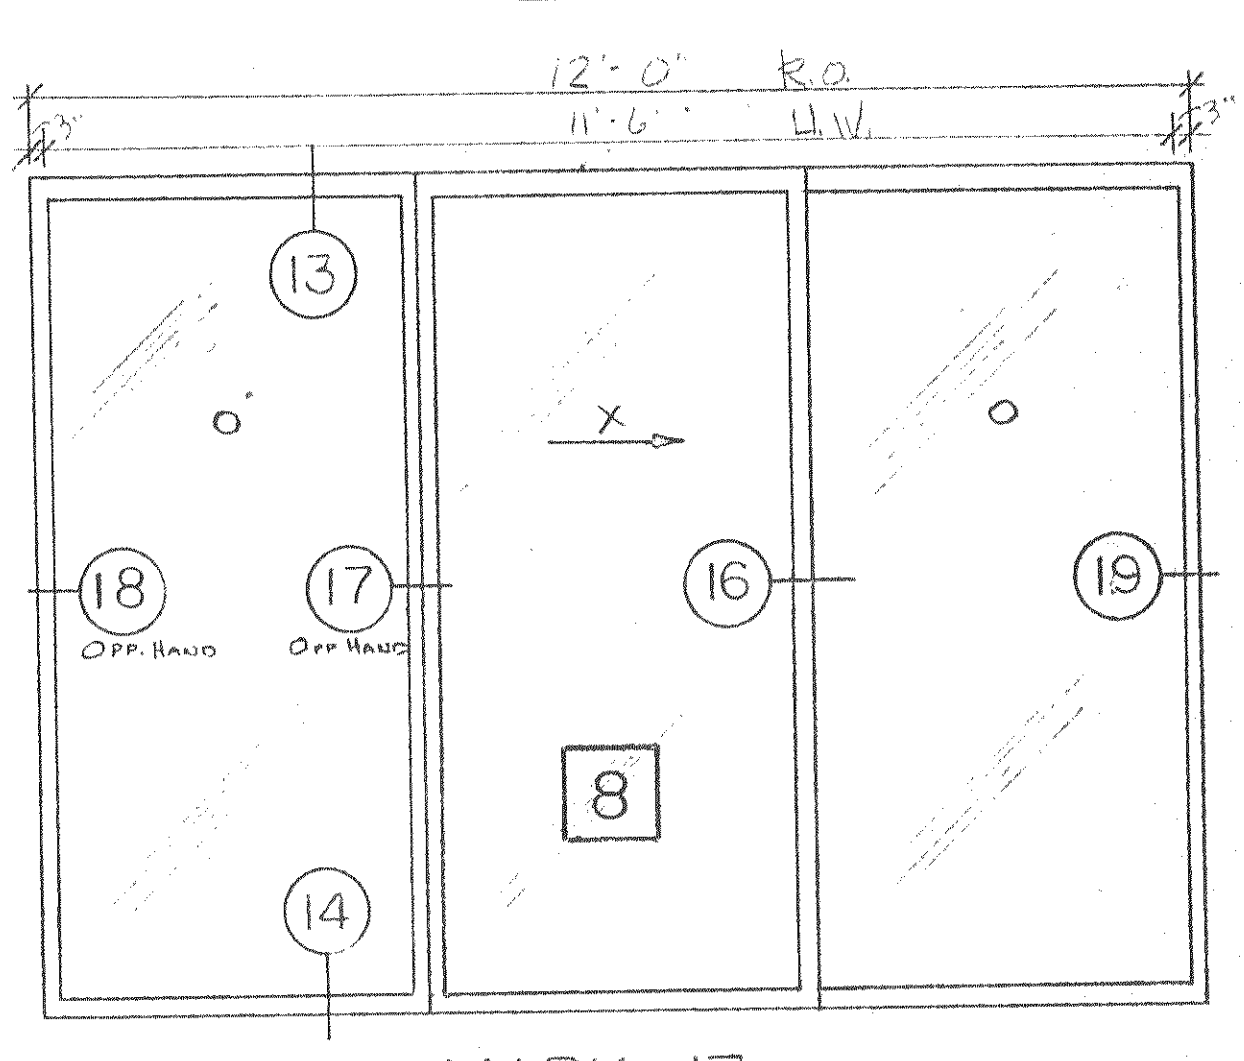


MARK-17 350 SERIES

- 8 17 OXO -> 4
- 8R 17 Rev OXO -< 3

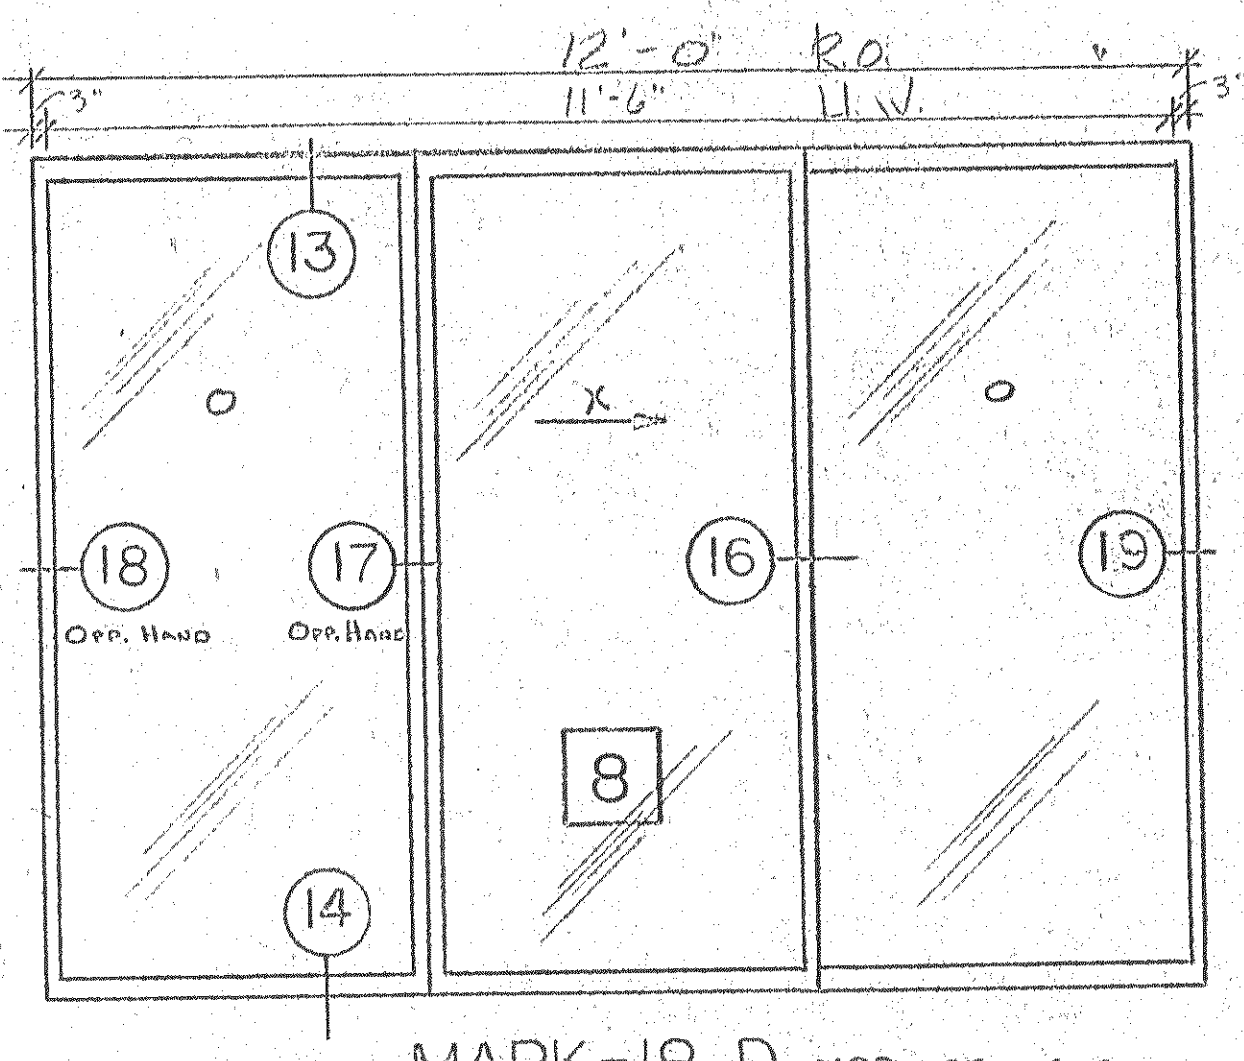


MARK-18 D MOD. 350 SERIES

- 8 18 D Mod OXO -> 1
- 8R 18 D Mod Rev OXO -< 1

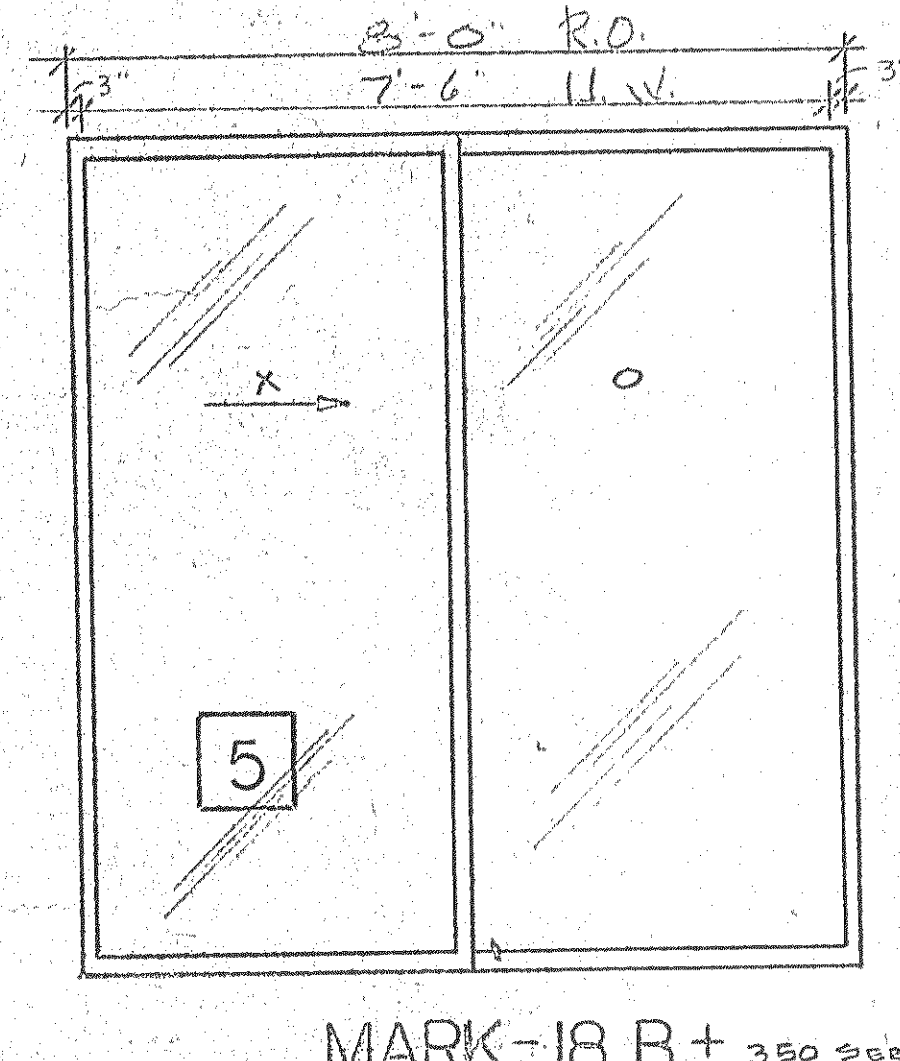


MARK-18 B+ 350 SERIES

- 5 18 B+ XO-2
- 5R 18 B+ Rev OX-2

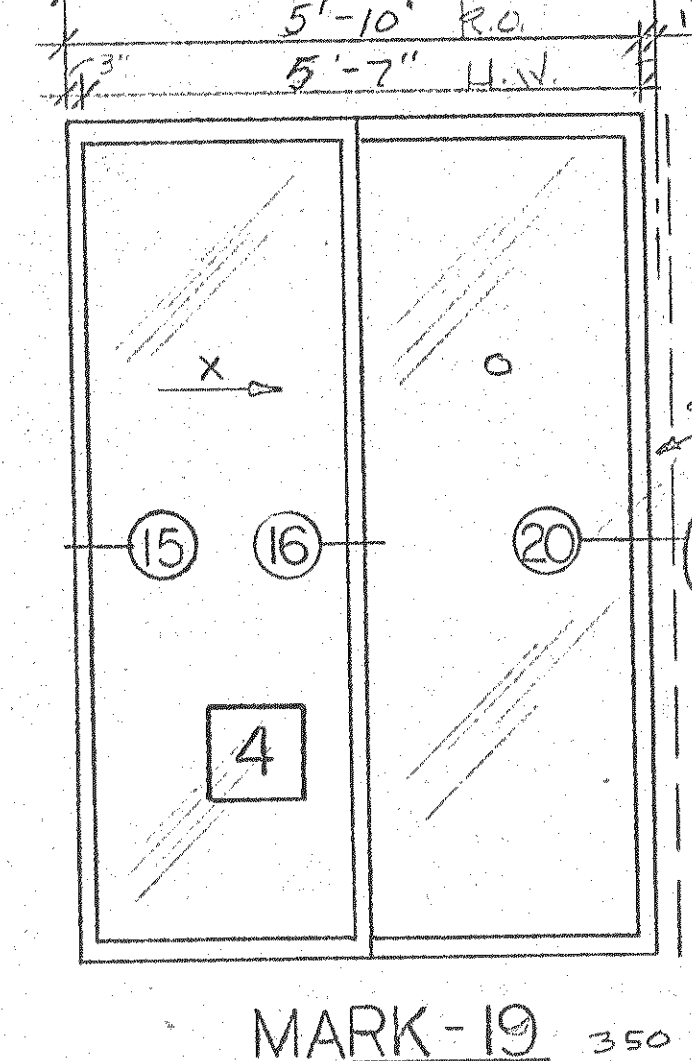

MARK-19 350 SERIES

- 4 19 XO-1
- 4R 19 Rev OX-1

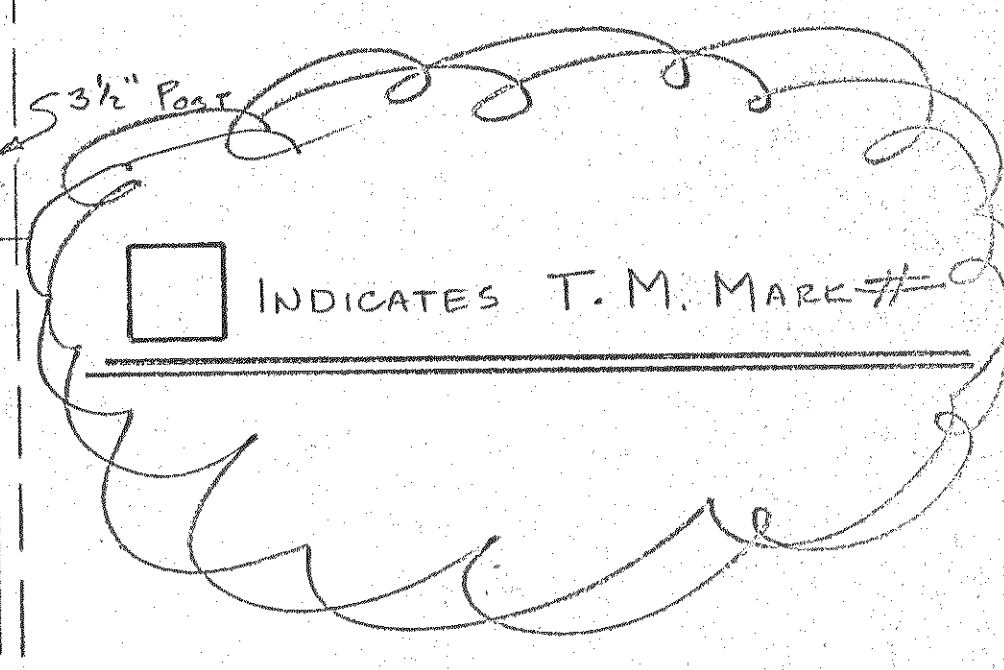

GEN. NOTES

SERIES 350 SLIDING GLASS DOOR
 TYPICAL FINISH - MEDIUM BRONZE
 1/4" TEMPERED SOLAR GREY GLASS
 Screens 10/18 FIBERGLAS

SUBMISSION		REVISION	
No. / Date	Description	No.	Description
1 /	PER ARCHITECT COMMENTS	1	PER ARCHITECT COMMENTS
2 /	PER ARCHITECT COMMENTS	2	PER ARCHITECT COMMENTS
3 /	UP DATE PER ARCH. COMMENTS	3	UP DATE PER ARCH. COMMENTS

T.M. Products Co.
 801 W. 12th AVENUE • POMPANO BEACH, FLORIDA 33060
 POMPANO (305) 781-4430 • DADE (305) 949-3128 • PALM BEACH (305) 737-4456

Project Title: **SUNSET BEACH**
 LONG BOAT KEY, FLORIDA

Contractor: _____ Project No.: _____

Drawing Title: **SG D ELEVATIONS**

Scale: 1/8" = 1'-0" Drawn By: V.B. 11-22-03 Date: 11-22-03 Chkd. By: _____ Date: _____ Sheet No.: 14 OF 15