


"AS BUILT
DRWG"

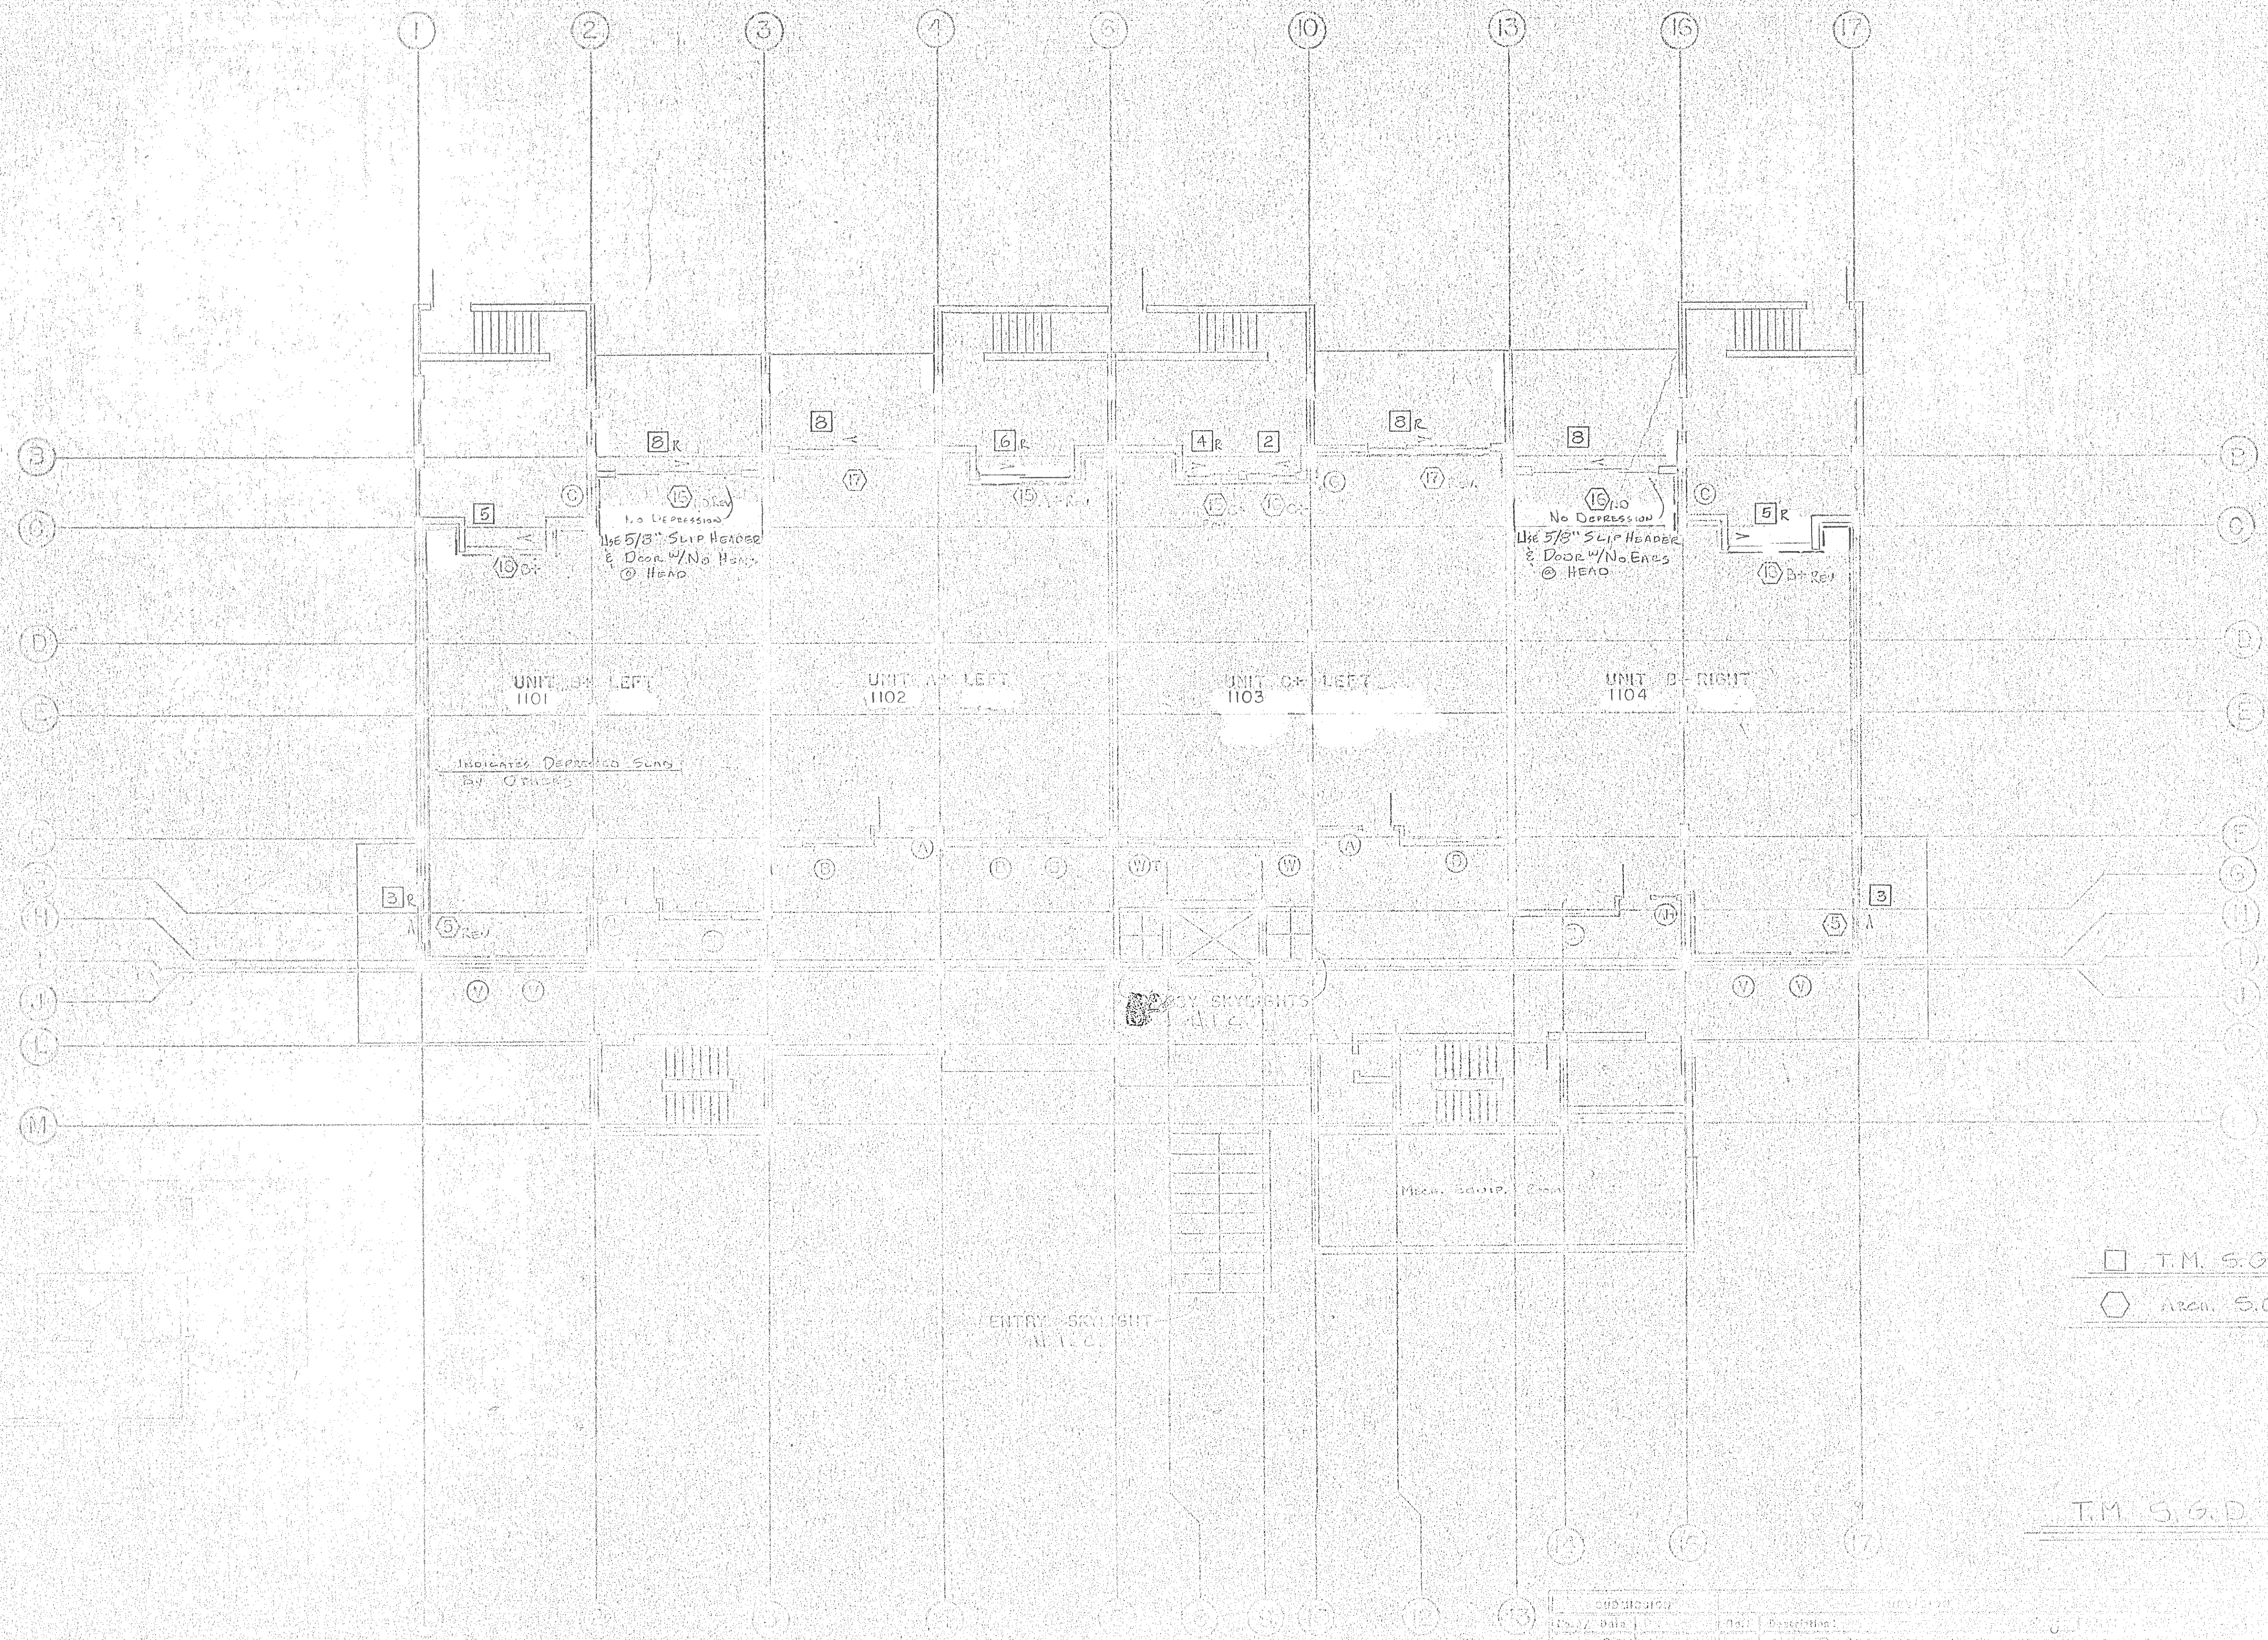

NO DEPRESSION
Use 5/8" SLIP HEADER
& DOOR w/NO HANDS
@ HEAD

NO DEPRESSION
Use 5/8" SLIP HEADER
& DOOR w/NO HANDS
@ HEAD

UNIT 9A LEFT
1101

UNIT 9A LEFT
1102

UNIT 9A LEFT
1103

UNIT 9B RIGHT
1104

INDICATES DEPRESSION
BY OTHERS

ENTRY SKYLIGHT
ALL C.

Mech. Equip. Room

- T.M. S.G.D. MARK # (As Noted)
- ⬡ ARCH. S.G.D. MARK #

T.M. S.G.D. MARK # IN Pencil

BUILDING 1

NO.	DATE	DESCRIPTION
1		
2		
3		
