


"AS BUILT
DRWG."

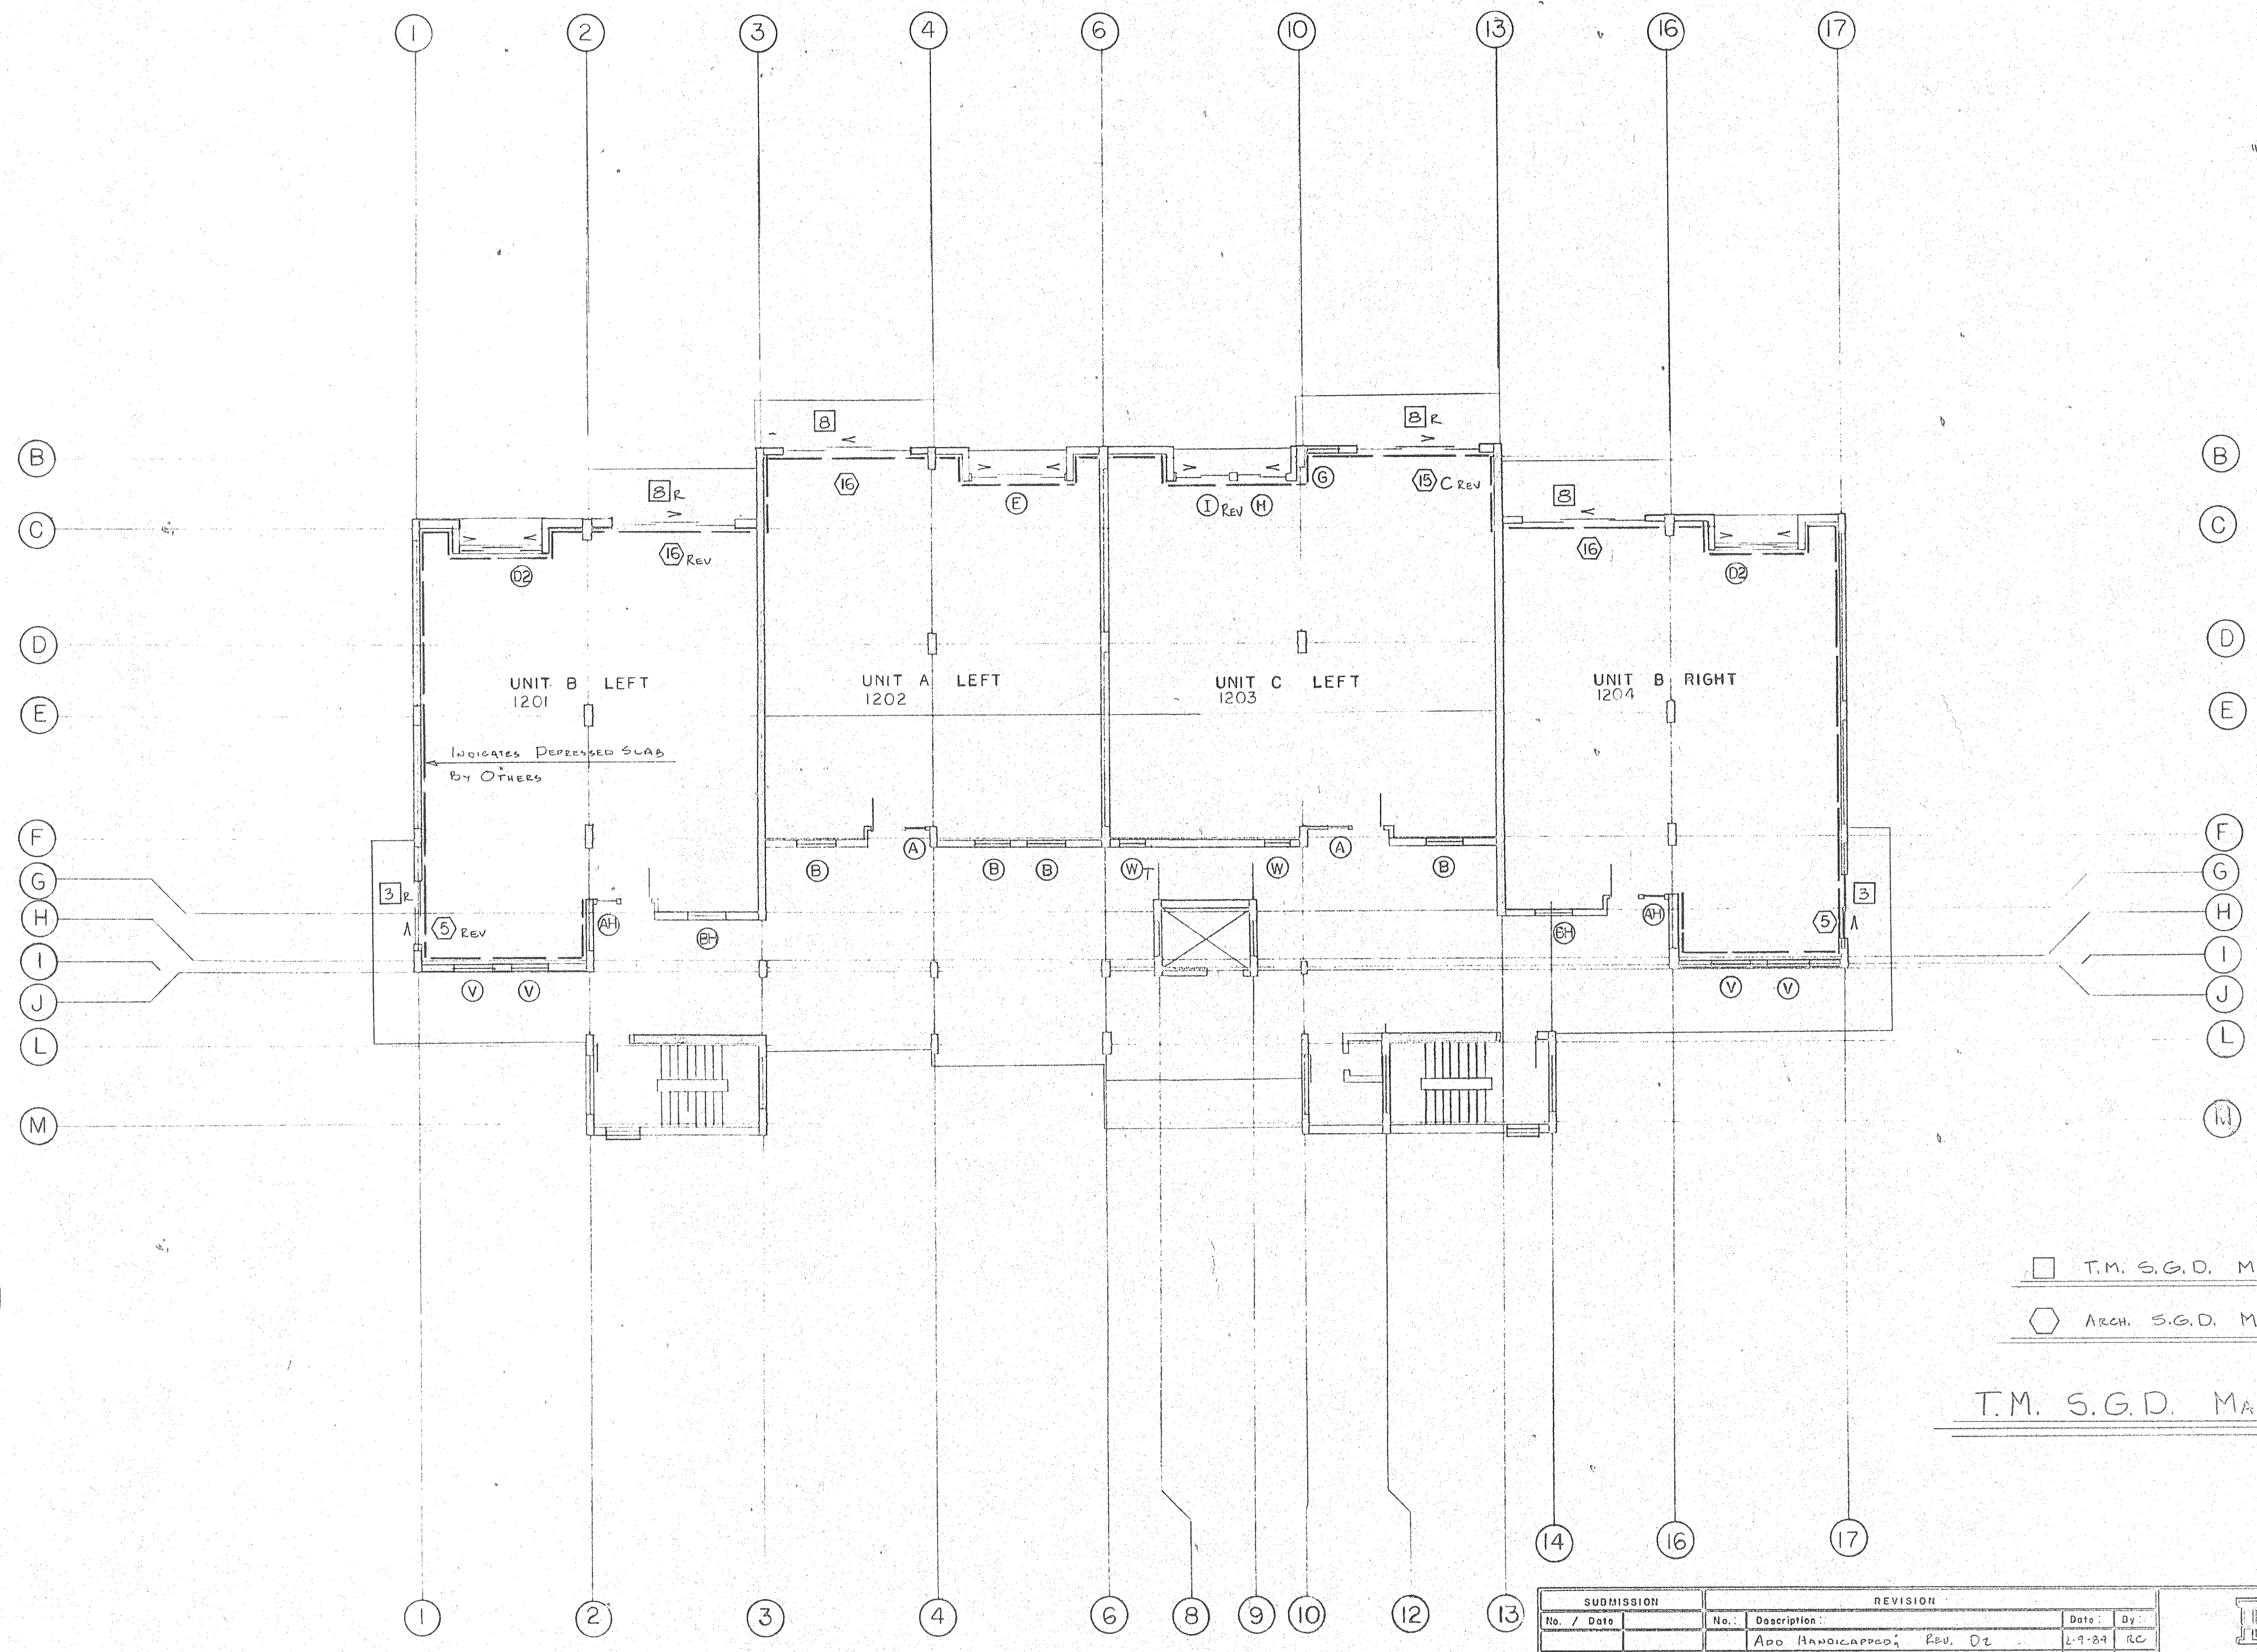

BUILDING 1

□ T.M. S.G.D. MARK # (AS NOTED ON UNITS)
 ⬡ ARCH. S.G.D. MARK #

T.M. S.G.D. MARK PLAN BLDG.#1
 2ND FLOOR

SUBMISSION		REVISION			
No.	Date	No.	Description	Date	By
		1	ADD HANDICAPPED; REV. DL	2-9-89	RC

T.M. Probst Co.
 401 NW 12th Avenue • Pompano Beach, Florida 33062
 Pompano Beach, FL 33062 • Dade County, FL 33062 • Palm Beach, FL 33480

Project Title: **SUNSET BEACH**
 OF LONG BOAT KEY, FLORIDA

Contractor: _____ Project No.: _____

Drawing Title: **FLOOR PLAN BLDG. 1**
SECOND FLOOR

Scale: 1/8" = 1'-0" Drawn By: V.B. 11-6-83 Date: _____ Chkd. By: _____ Date: _____ Sheet No.: 2 OF 15