


"AS BUILT
DRWG."

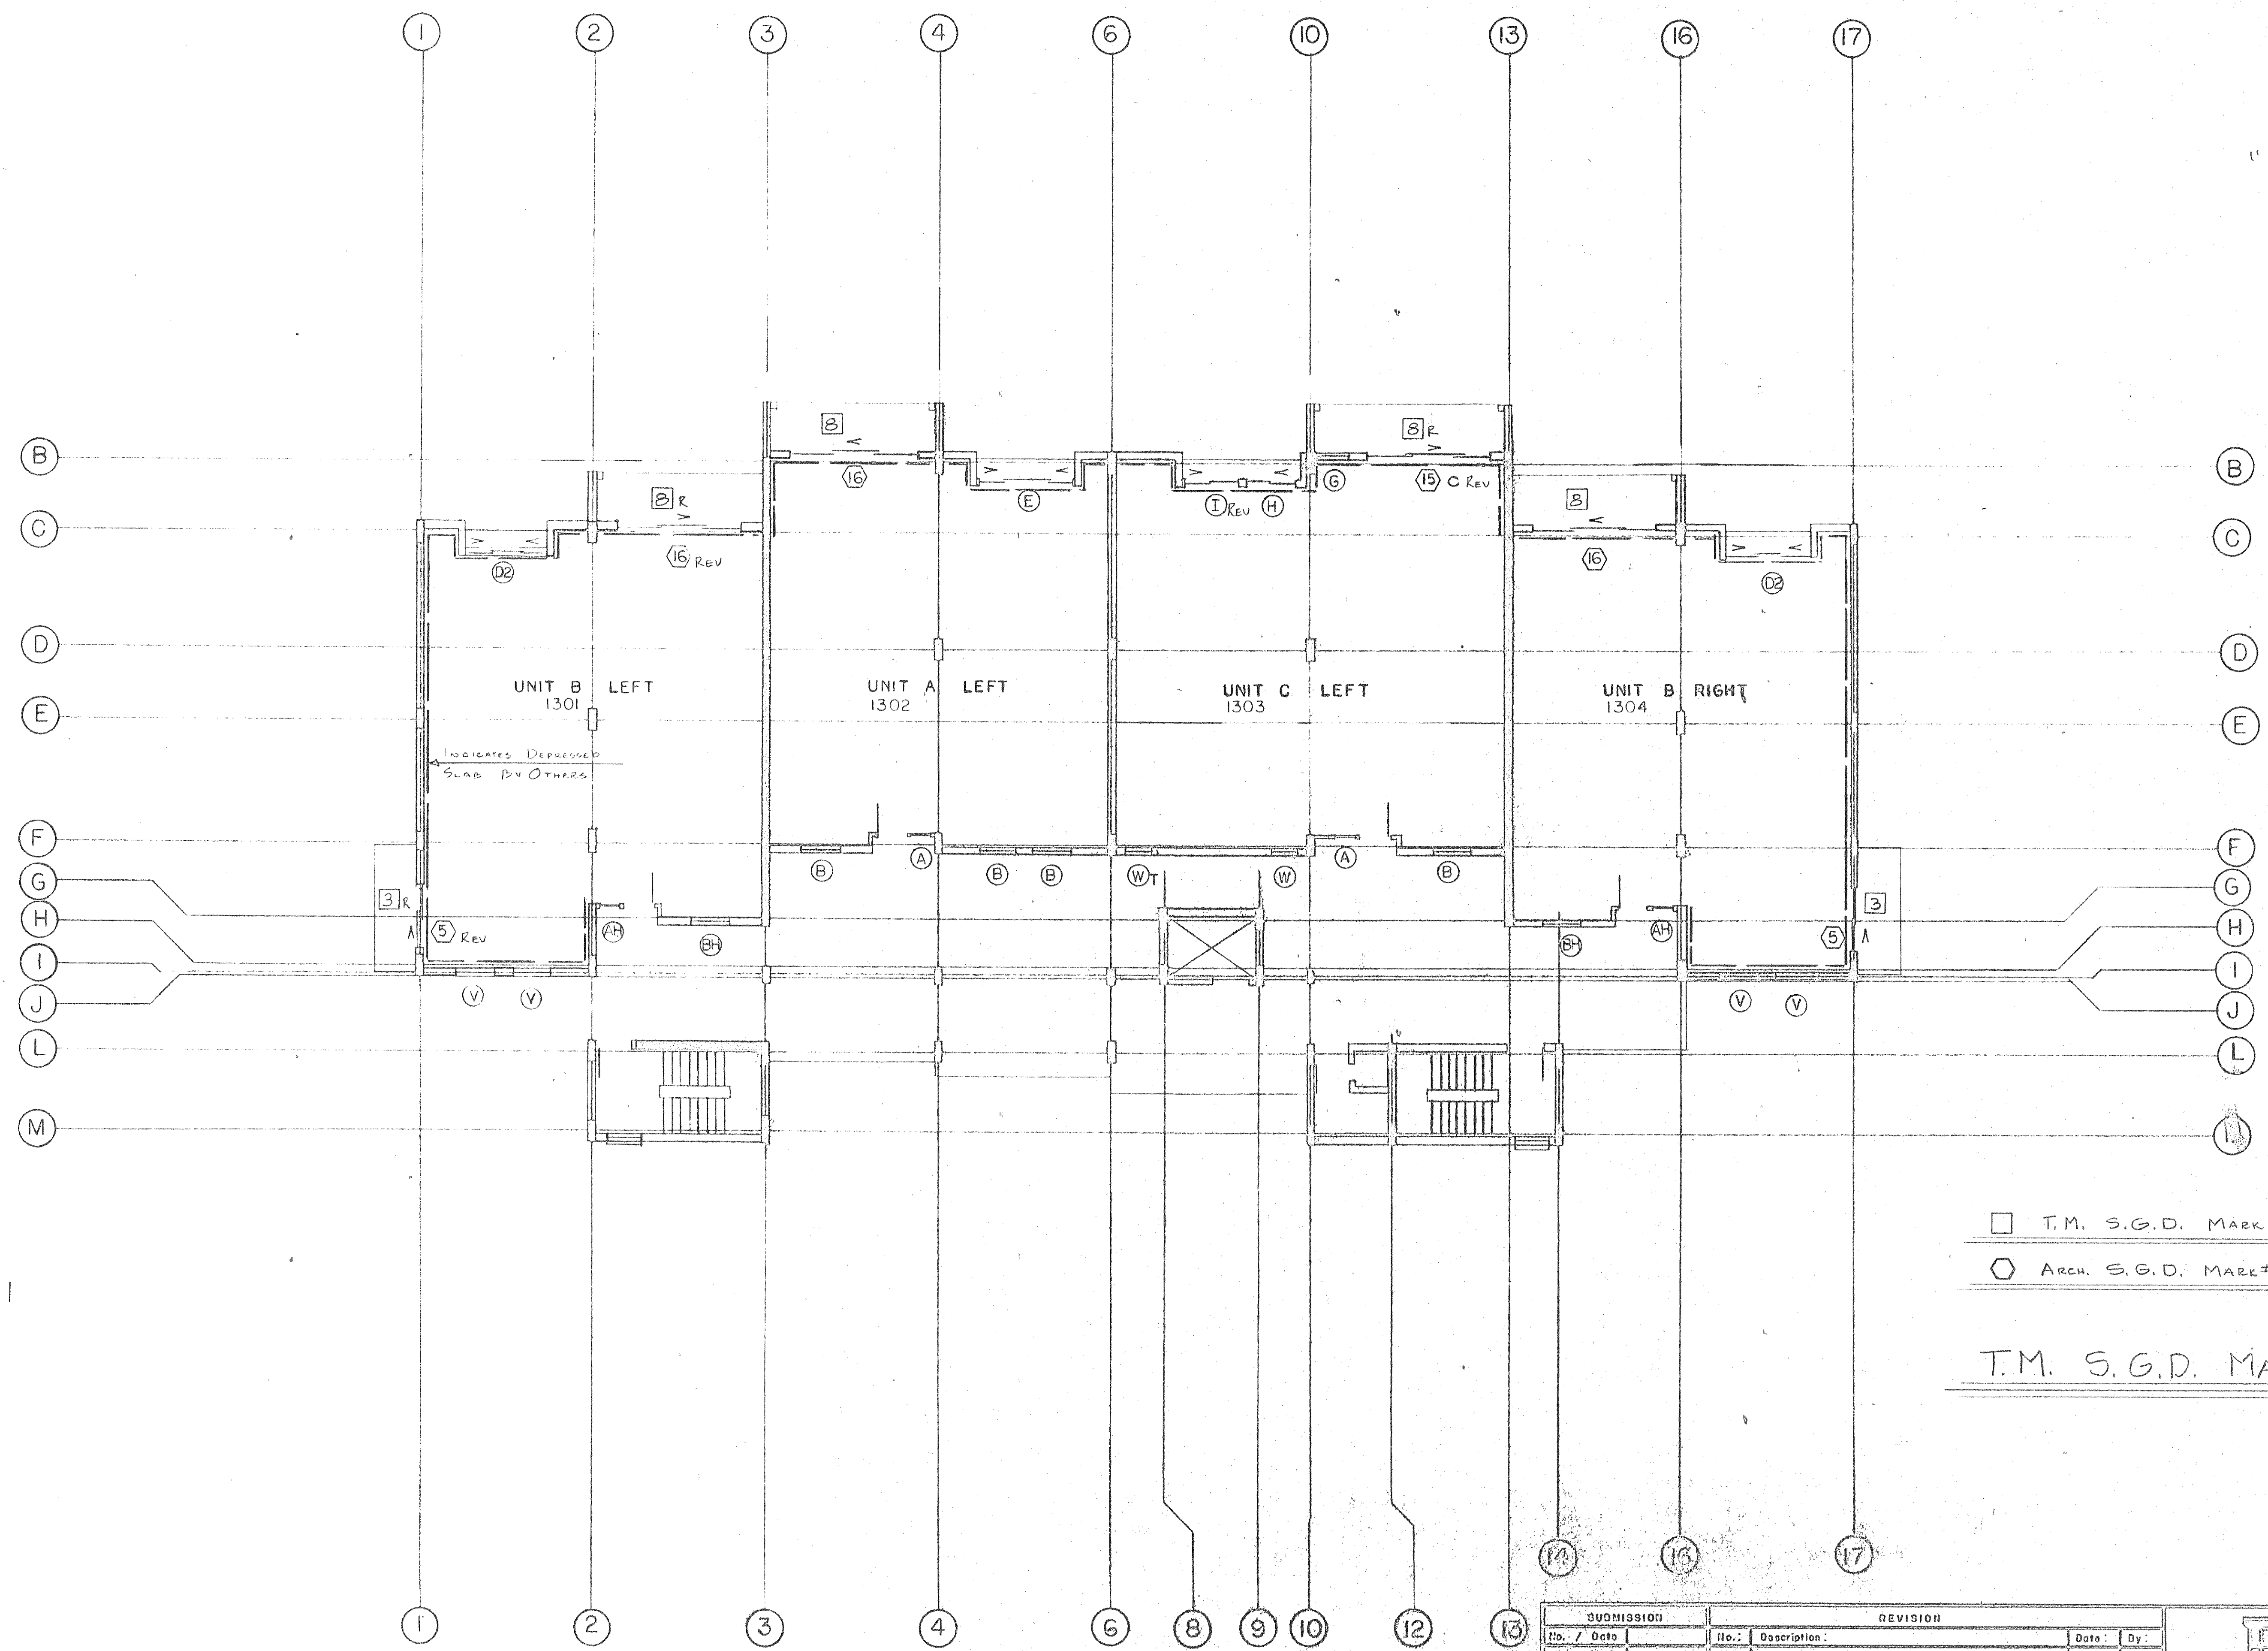

BUILDING I

□ T.M. S.G.D. MARK # (AS NOTED ON UNITS)
 ⬡ ARCH. S.G.D. MARK #

T.M. S.G.D. MARK PLAN BLDG.#1
 3RD FLOOR

SUBMISSION		REVISION		DATE		BY	
No.	Date	No.	Description	Date	By	Date	By
			ADD HANDICAPPED; DEPRESSED SLAB	2-1-84	CC		

T.M. Products Co.
101 NW 12th Avenue • Pompano Beach, Florida 33060
 (305) 935-7814 • FAX (305) 935-3128 • PALM BEACH (305) 737-4455

Project Title: **SUNSET BEACH**
OF LONG BOAT KEY, FLORIDA

Drawn: **THOMAS M. GARDNER**
 Title: **ARCHITECT**

Third Floor Plan
 Building #1