


"AS BUILT  
DRAWG"

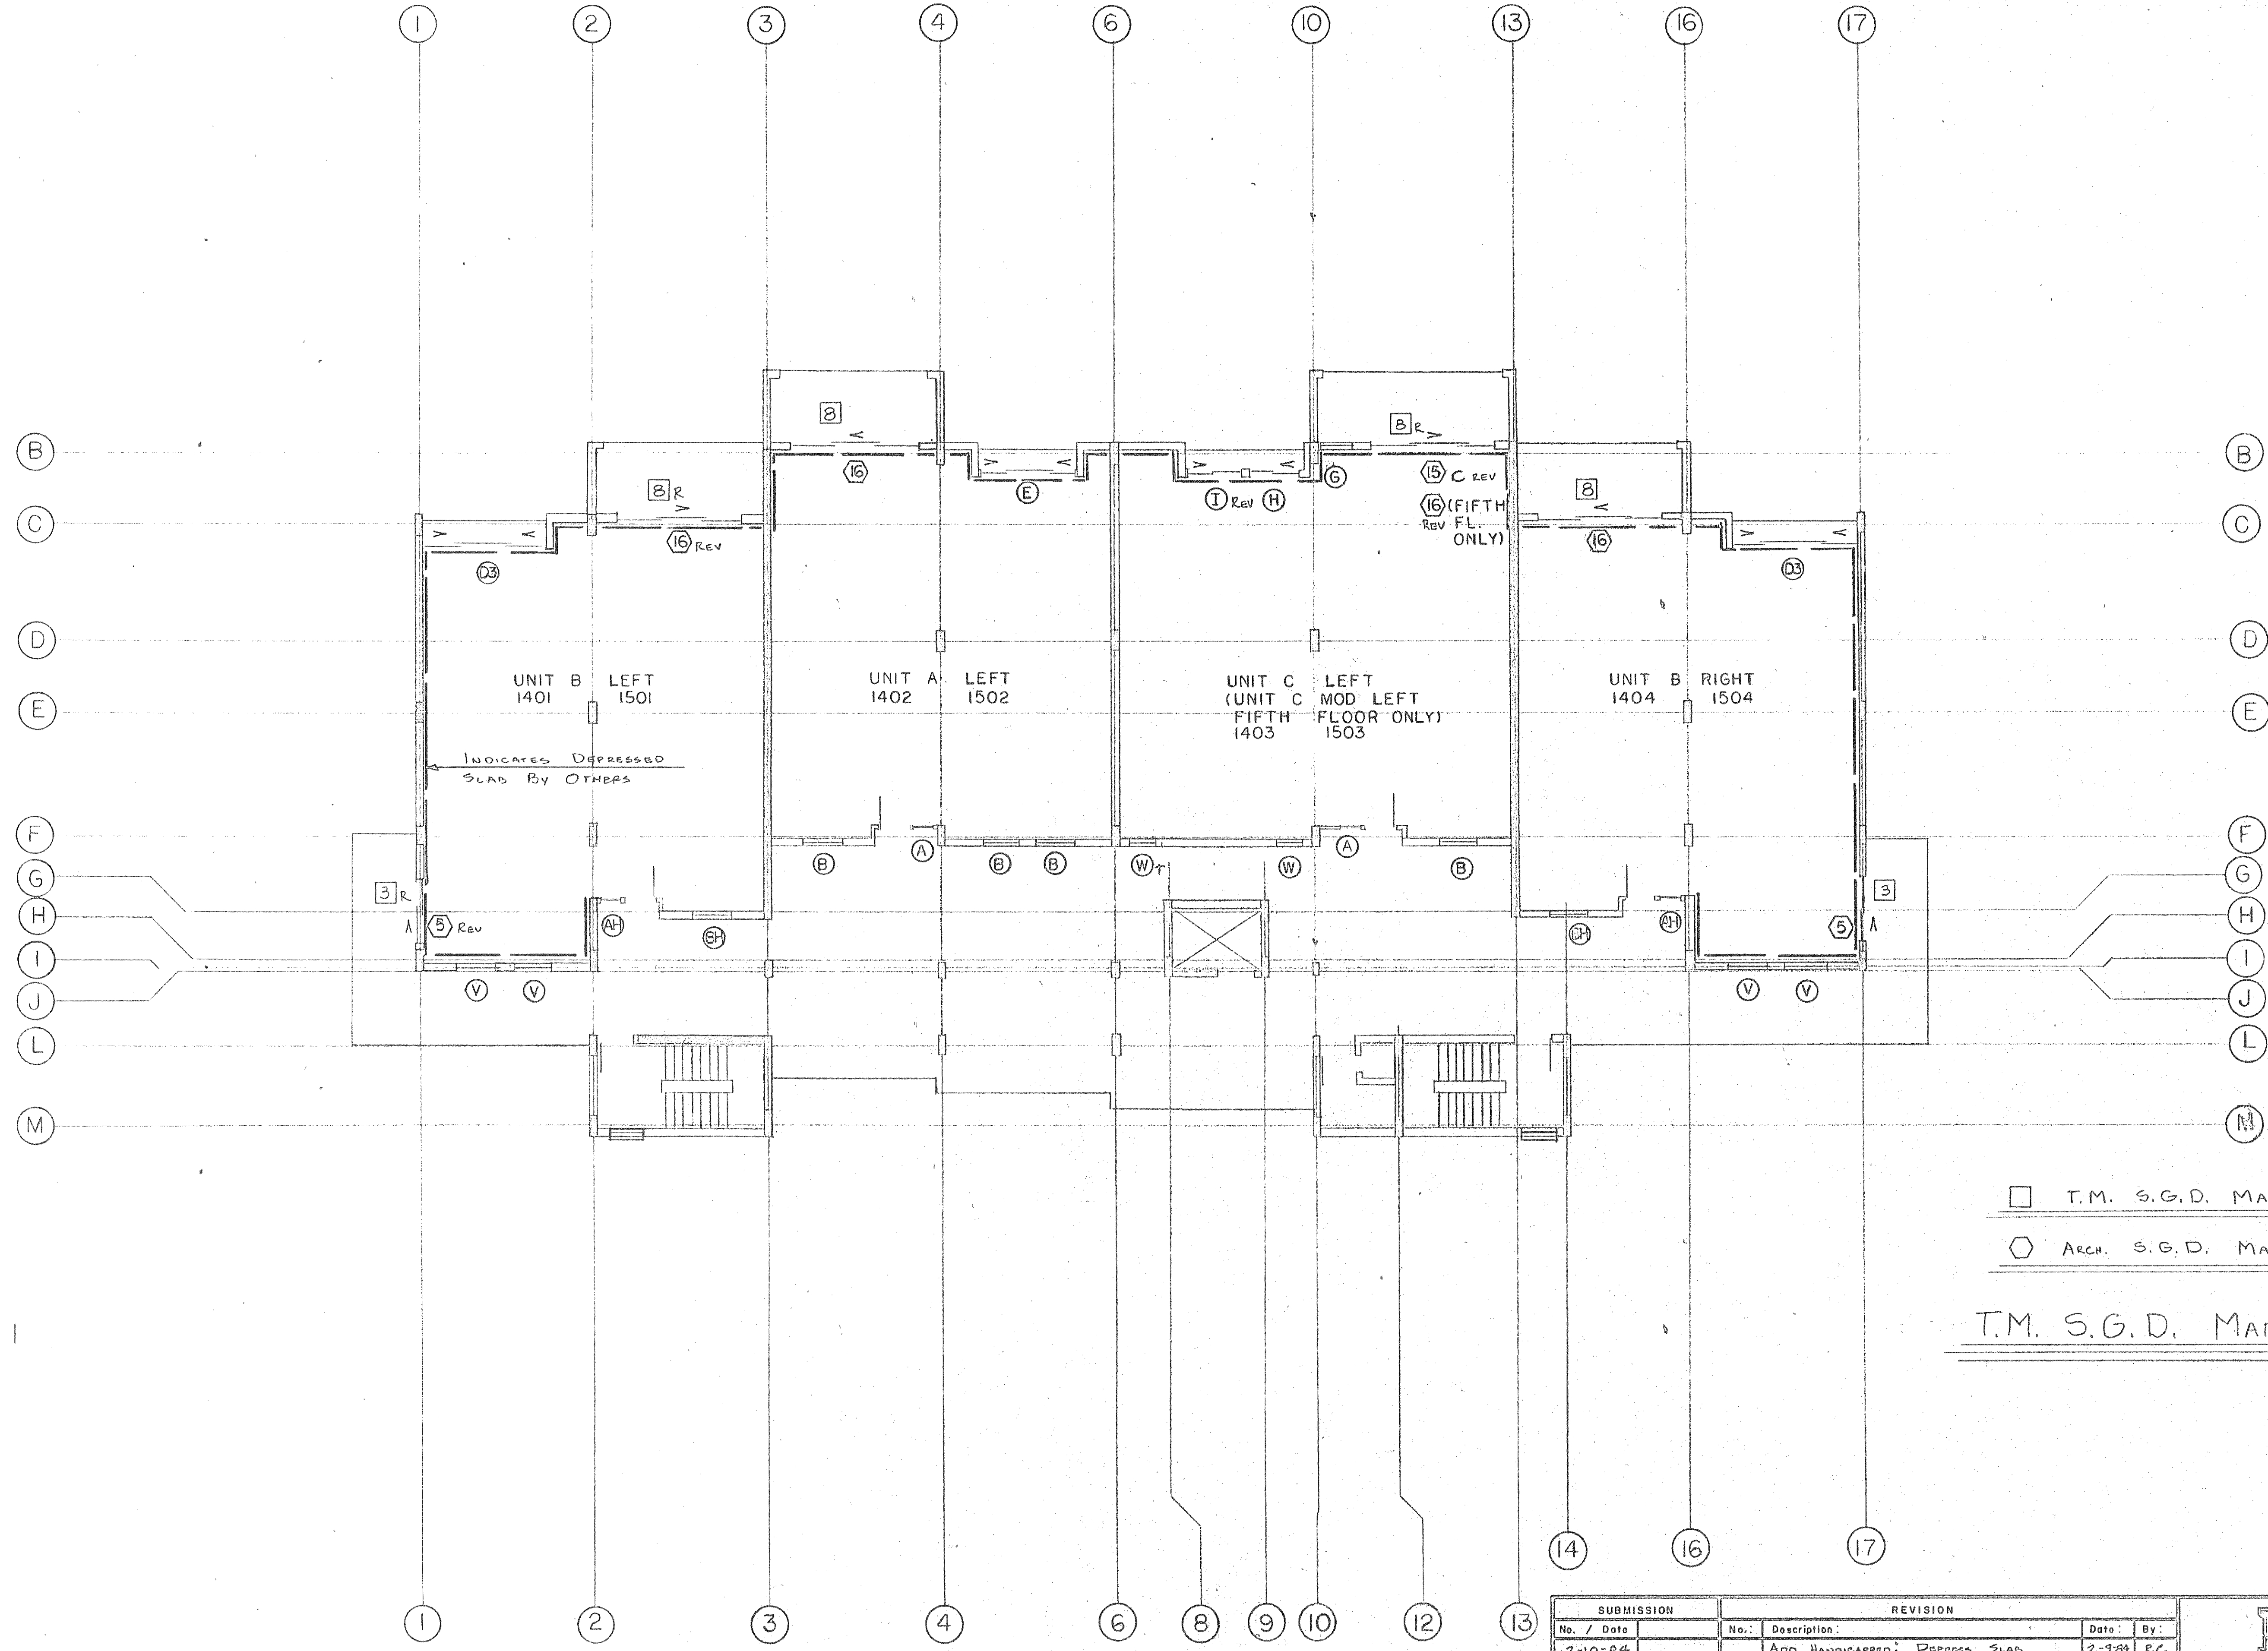

BUILDING I

- T.M. S.G.D. MARK # (As Noted On Unit)
- ARCH. S.G.D. MARK #

T.M. S.G.D. MARK PLAN BLDG #1  
4TH & 5TH FLOOR

SUBMISSION		REVISION			
No.	Date	No.	Description	Date	By
2-10-84			ADD HANDICAPPED; DEPRESS SLAB	2-9-84	R.C.

**T.M. Products Co.**  
601 N.W. 12th Avenue • Pompano Beach, Florida 33060  
POMPAÑO (305) 781-4430 • DADE (205) 949-3128 • PALM BEACH (305) 737-4456

Project Title: **SUNSET BEACH**  
OF LONG BOAT KEY, FLORIDA

Contractor: \_\_\_\_\_ Project No.: \_\_\_\_\_

Drawing Title: **FLOOR PLAN BLDG I**  
FOURTH AND FIFTH

Scale: 1/8" = 1'-0" Drawn By: V.B. Date: 11-9-83 Chkd. By: \_\_\_\_\_ Date: \_\_\_\_\_ Sheet No.: 4 OF 15