


"As Built"
Drawn

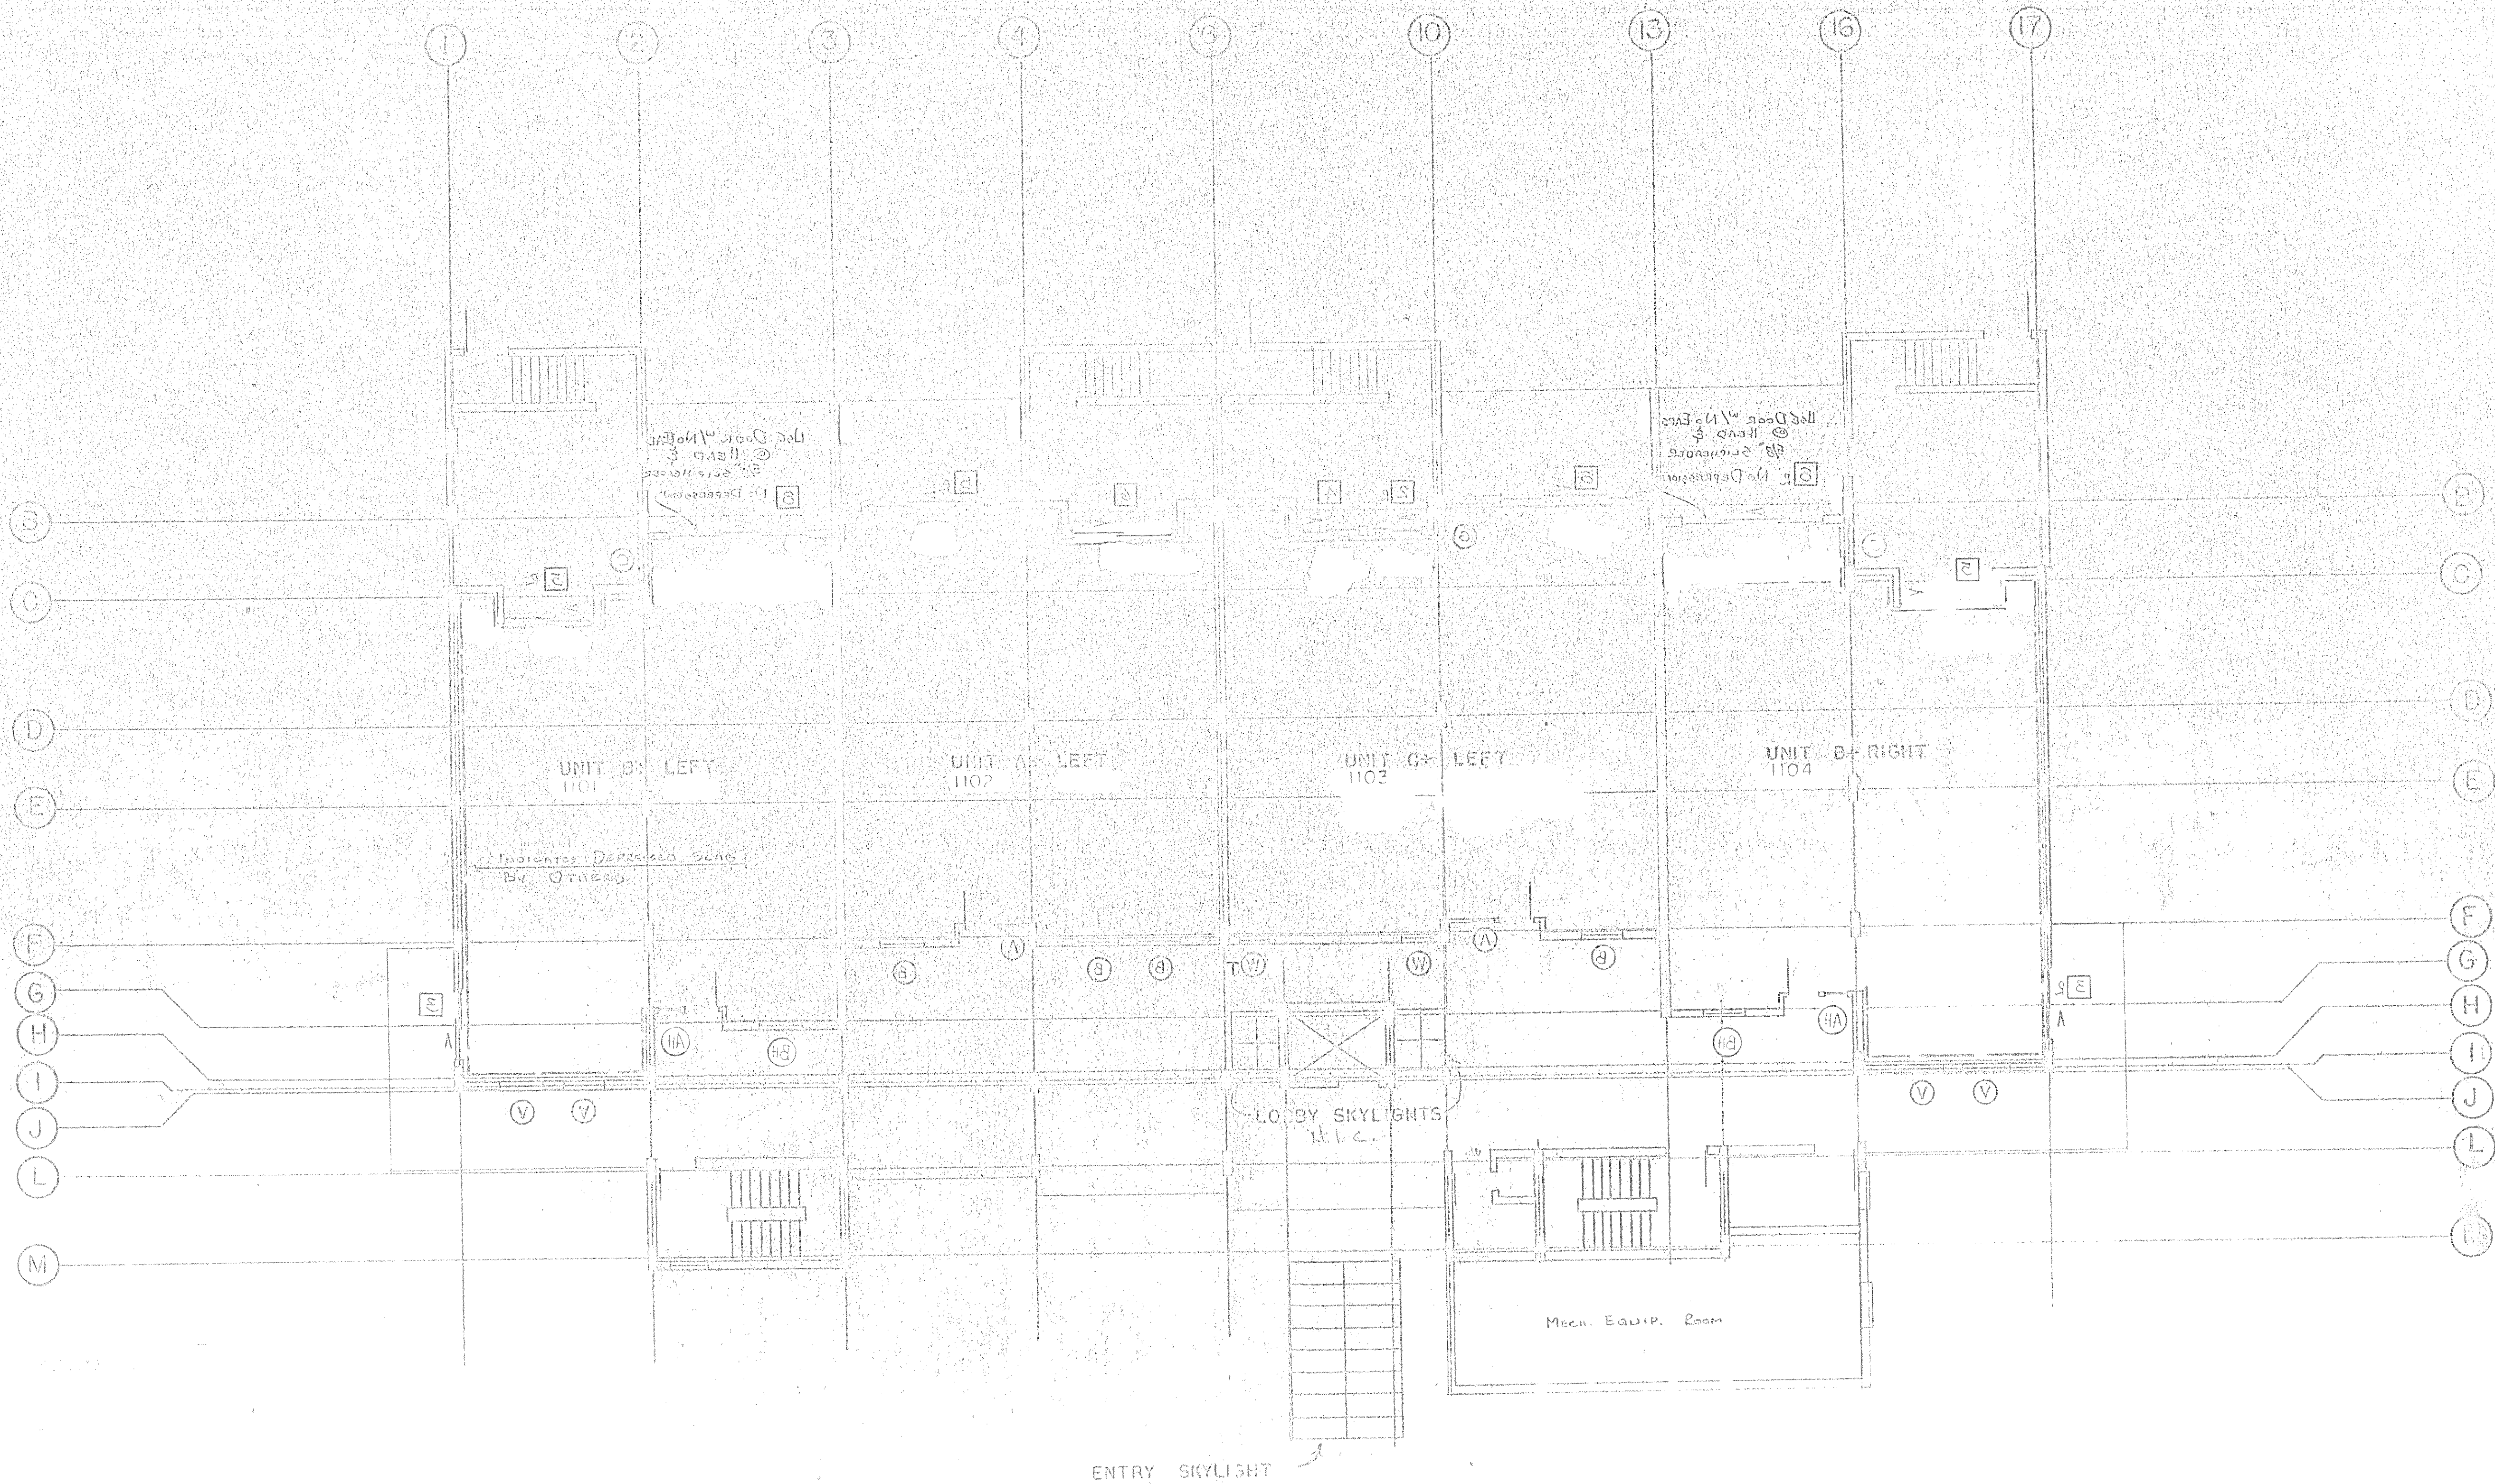

REVISION		SUBMISSION	
No.	Description	No.	Description
1	As Drawn	1	As Drawn
2	As Drawn	2	As Drawn
3	As Drawn	3	As Drawn
4	As Drawn	4	As Drawn
5	As Drawn	5	As Drawn
6	As Drawn	6	As Drawn
7	As Drawn	7	As Drawn
8	As Drawn	8	As Drawn
9	As Drawn	9	As Drawn
10	As Drawn	10	As Drawn
11	As Drawn	11	As Drawn
12	As Drawn	12	As Drawn
13	As Drawn	13	As Drawn
14	As Drawn	14	As Drawn
15	As Drawn	15	As Drawn
16	As Drawn	16	As Drawn
17	As Drawn	17	As Drawn

BUILDING S

5/15