


"As Built"
 "DSMR"

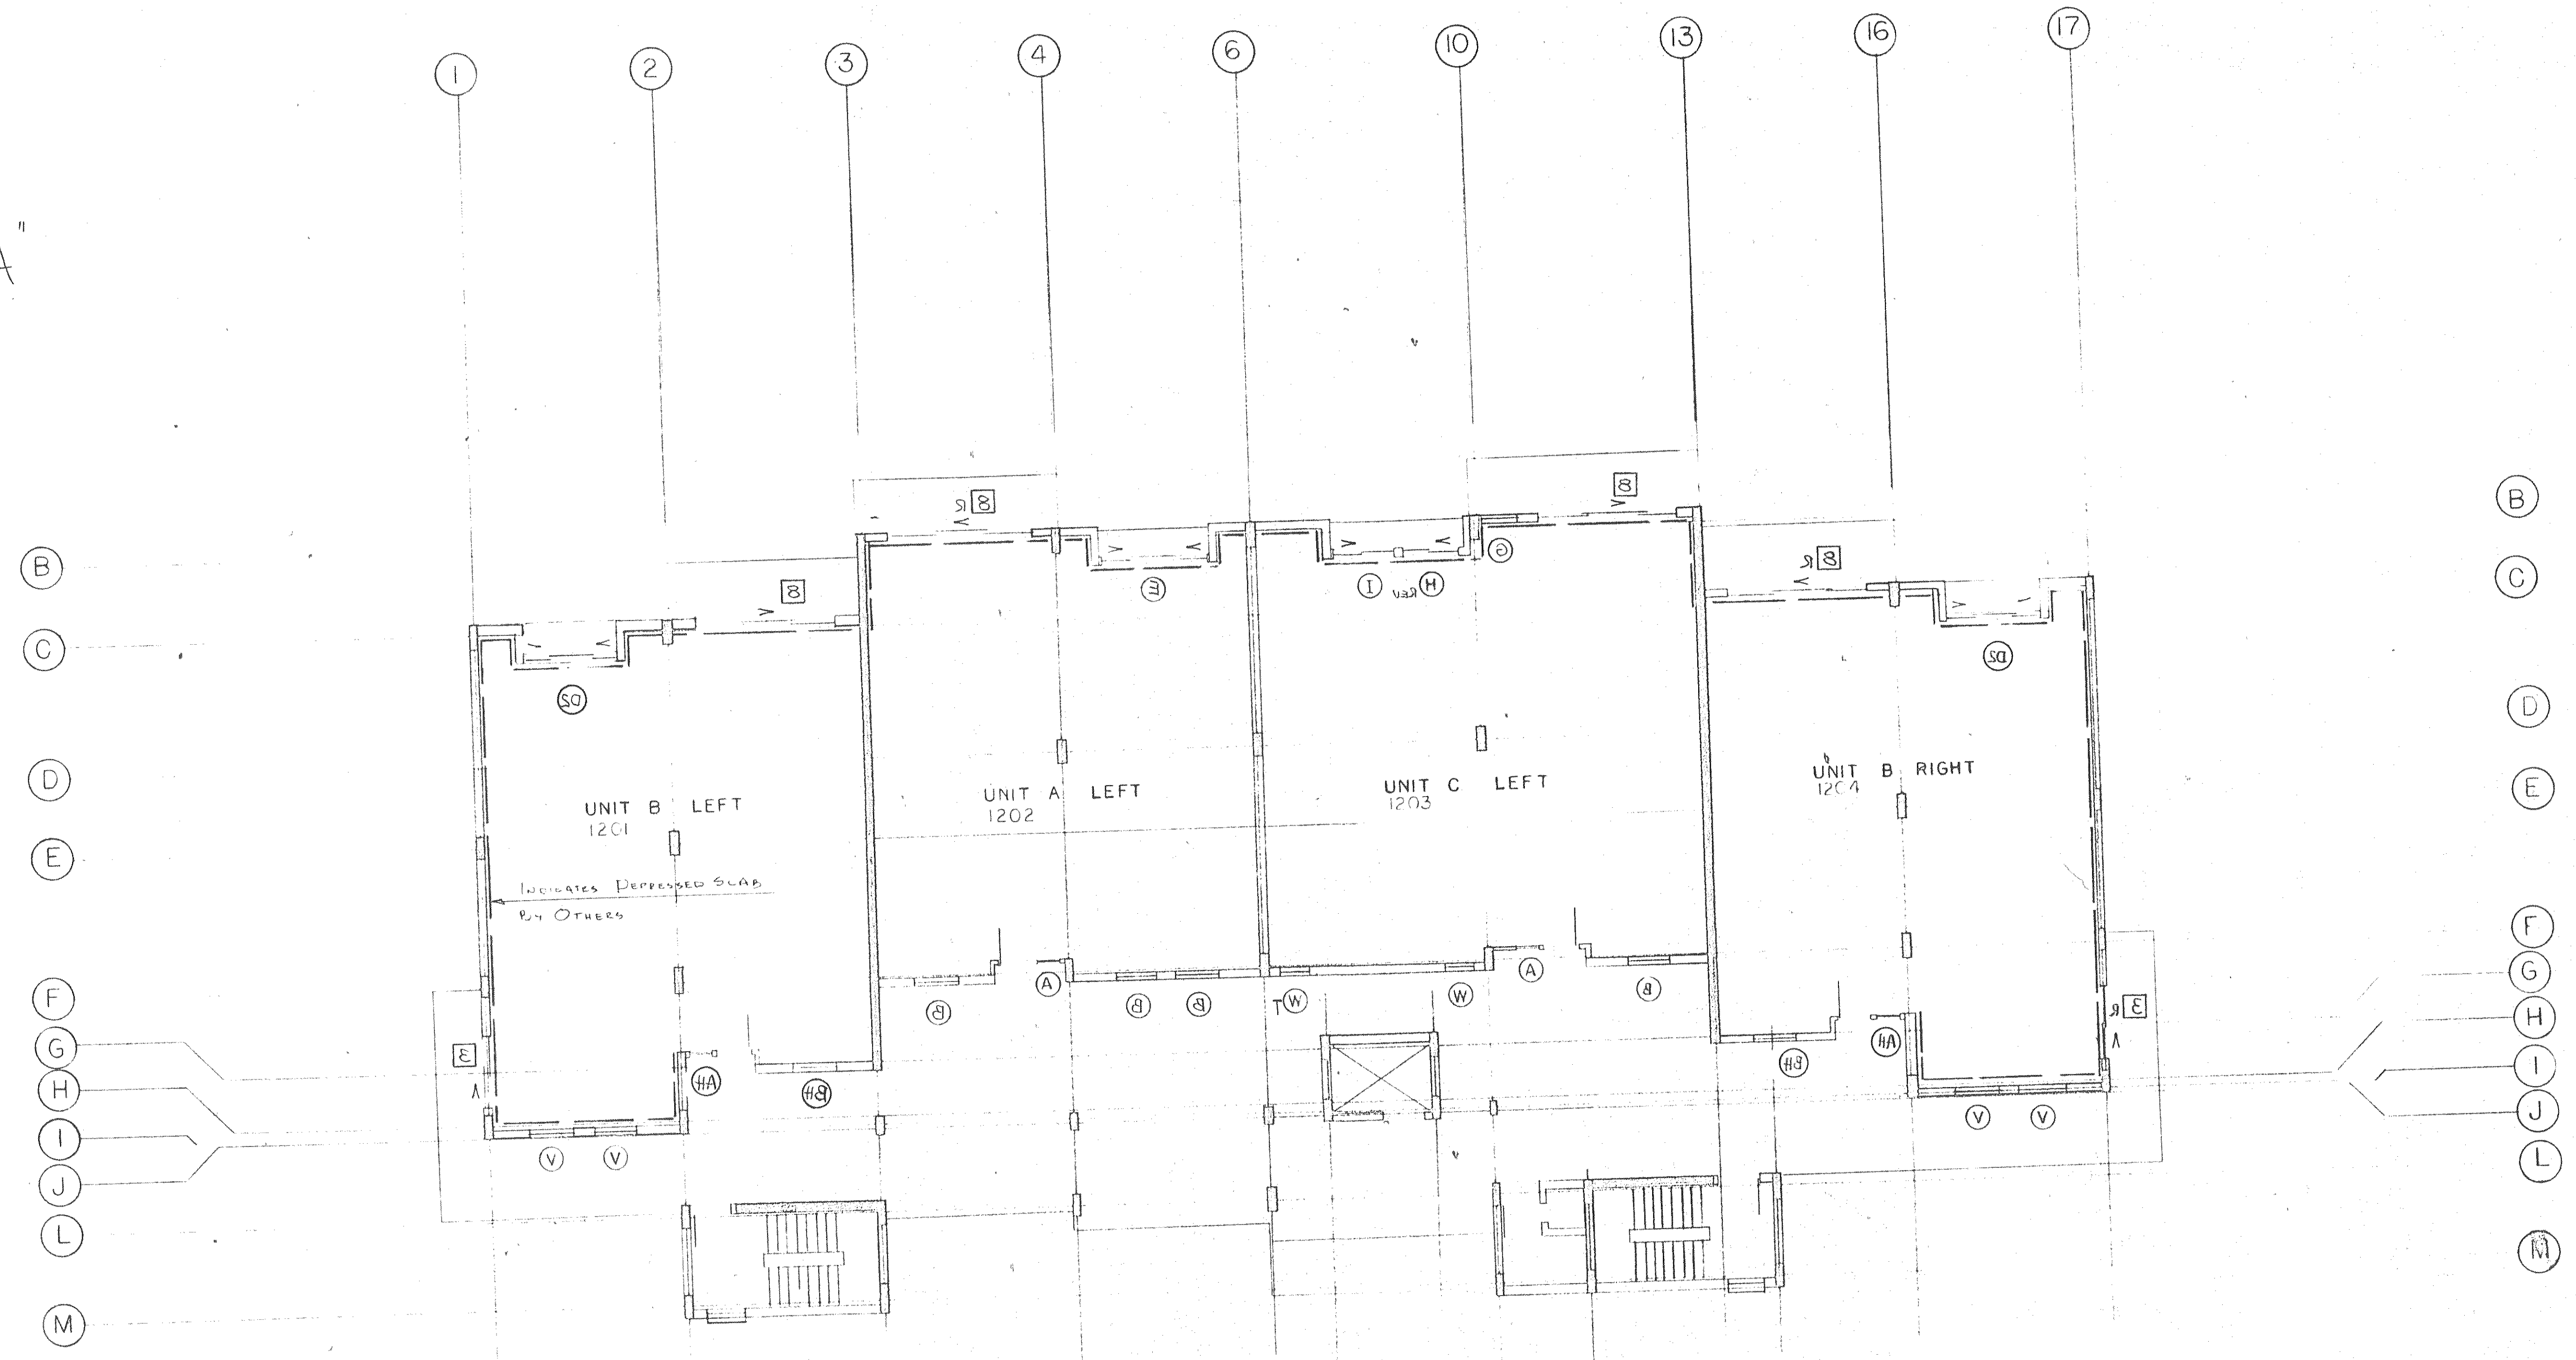

BUILDING S

T.M. MARK PLAN BLDG S (2ND FLOOR)
 T.M. S.G.D. MARKS
 T.M. WINDOW MARKS

SUBMISSION		REVISION	
No.	Date	No.	Date
1	1-1-84	1	1-1-84
2	1-1-84	2	1-1-84

Drawing Title: FLOOR PLAN BLDG S
 Project: OF LONG BOAT KEY FLORIDA
 Contractor: T.M. PRODUCTS CO.
 Project Title: SUNSET BEACH