


"A2 BUILT"  
"DBM"

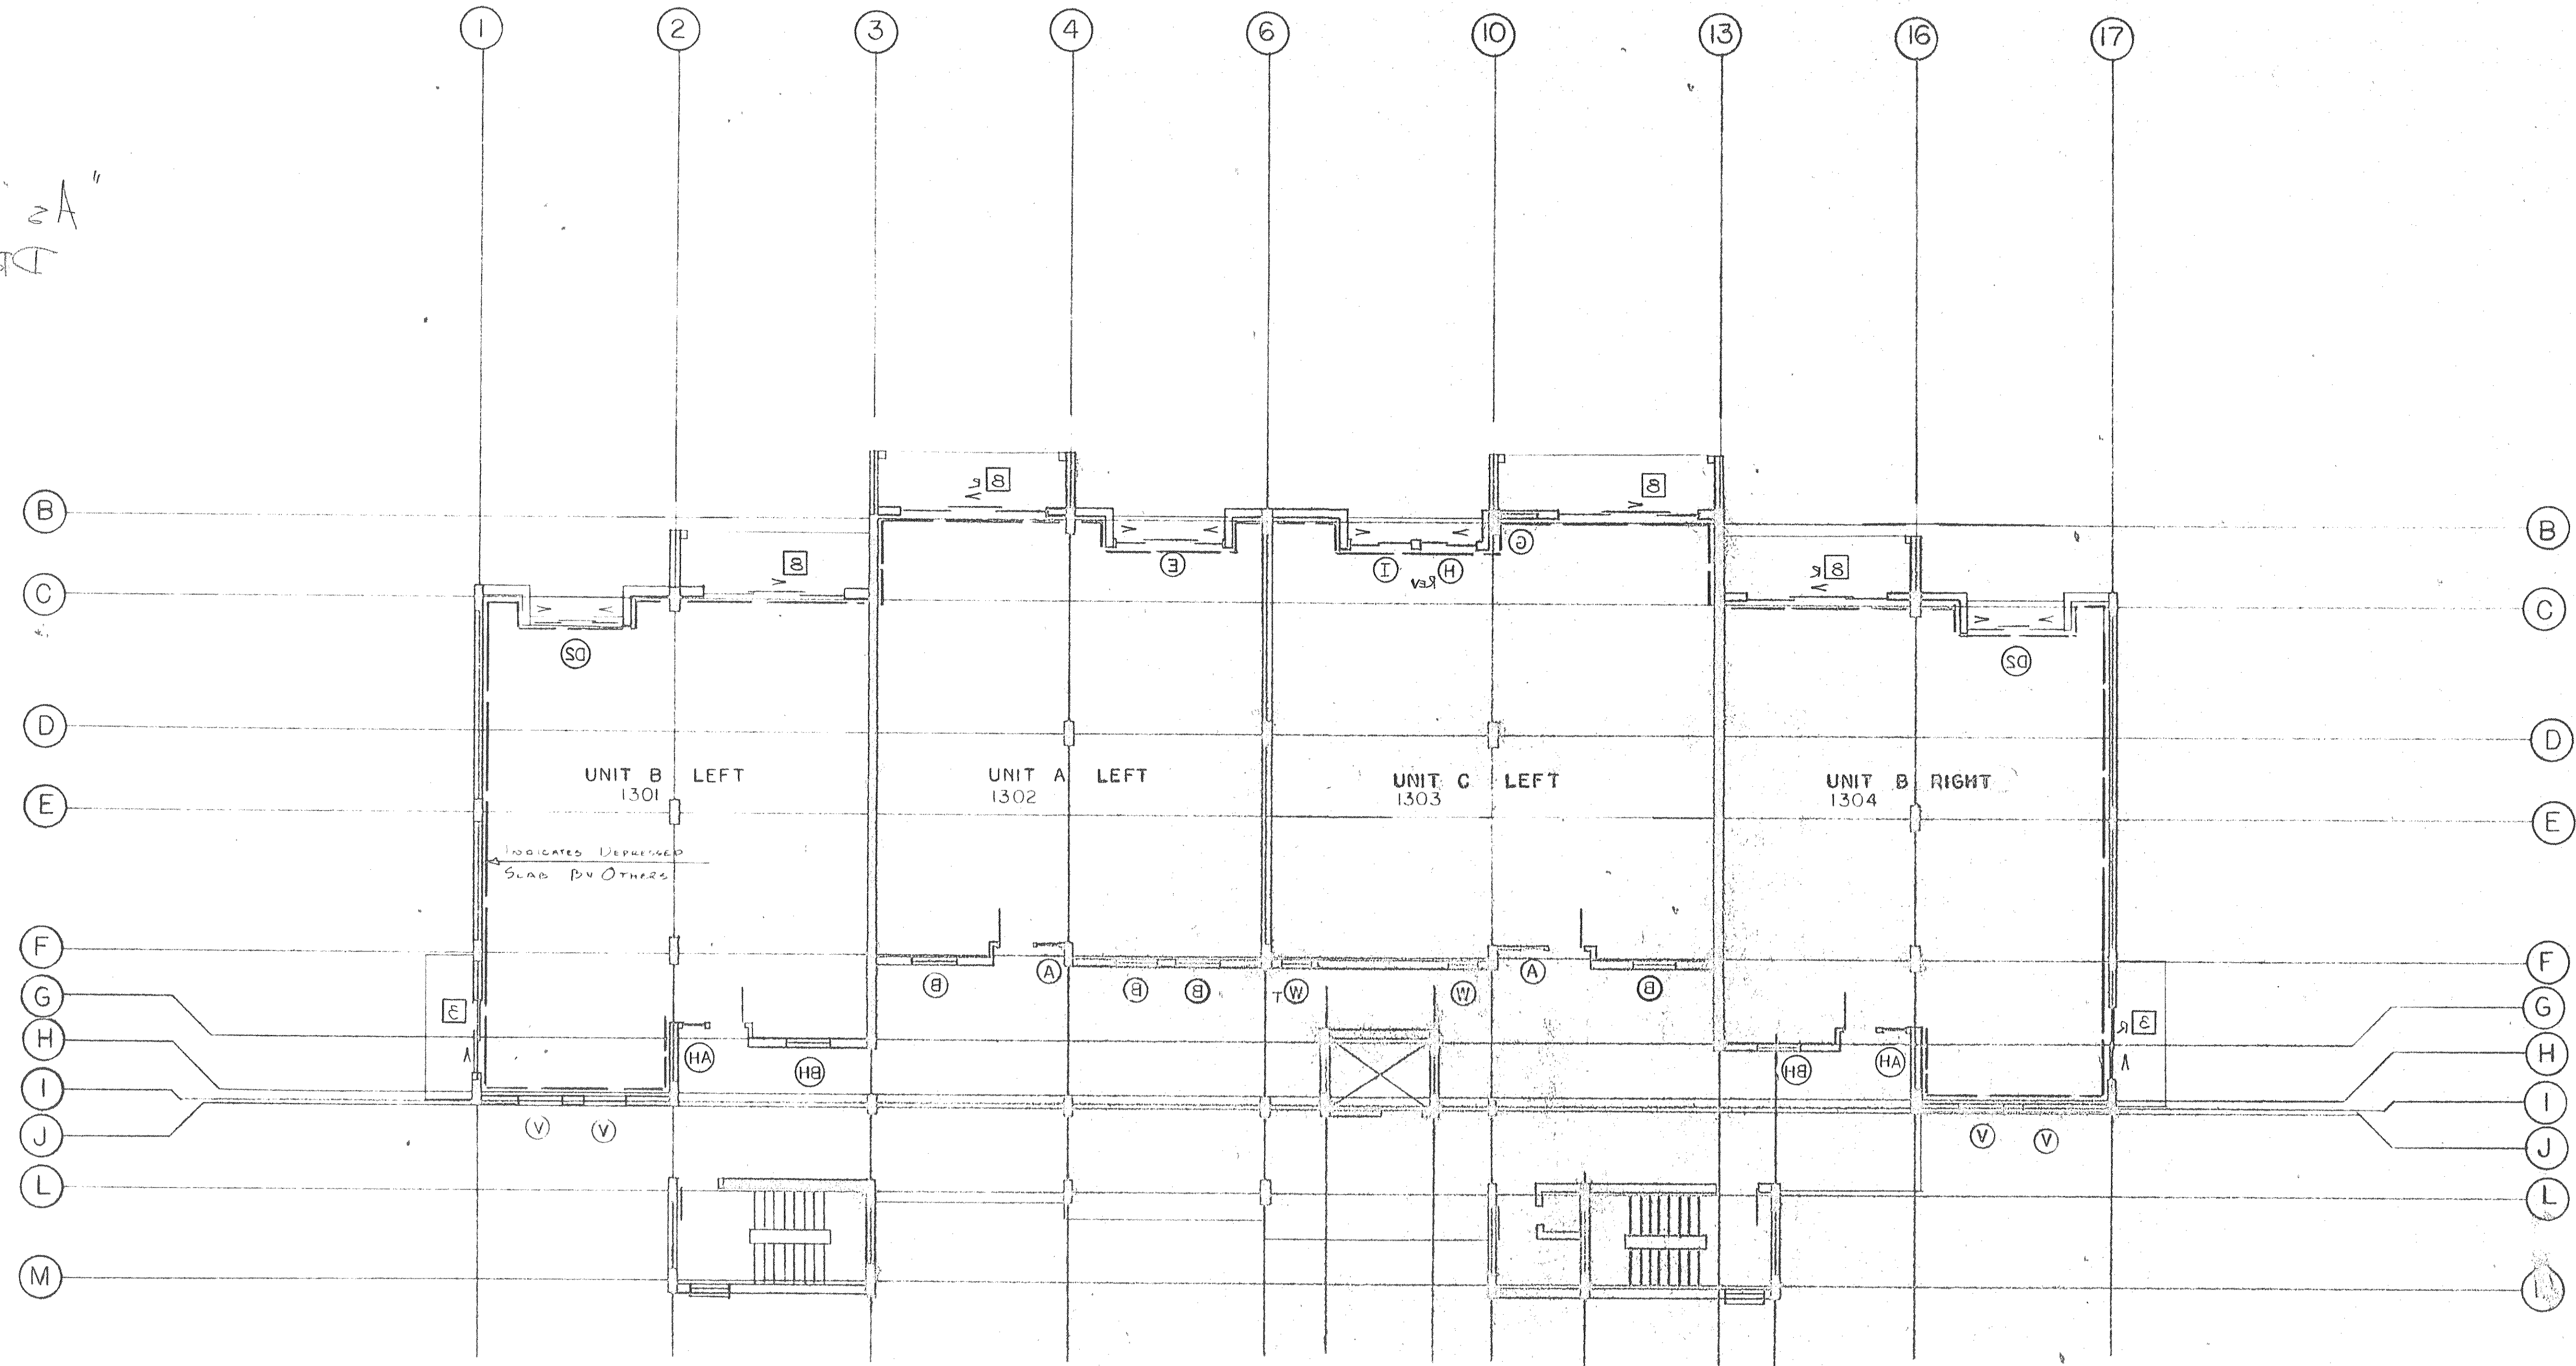


○ T.M. Window MARK  
□ T.M. S.G.D. MARK

T.M. MARK PLAN BLDG. S (3rd Floor)

BUILDING S

NO.	DATE	DESCRIPTION
1	1-2-84	ADD HANDICAPPED ACCESSIBLE

  
**T.M. Freeman Co.**  
 ARCHITECTS  
 1100 N. W. 10th Ave., Suite 1000  
 Fort Lauderdale, Florida 33304  
 Phone: (305) 463-1111  
 Project: SUNSET BEACH  
 OF LONG BEACH, FLORIDA  
 THIRD FLOOR PLAN