


"As Built"
 Drawn

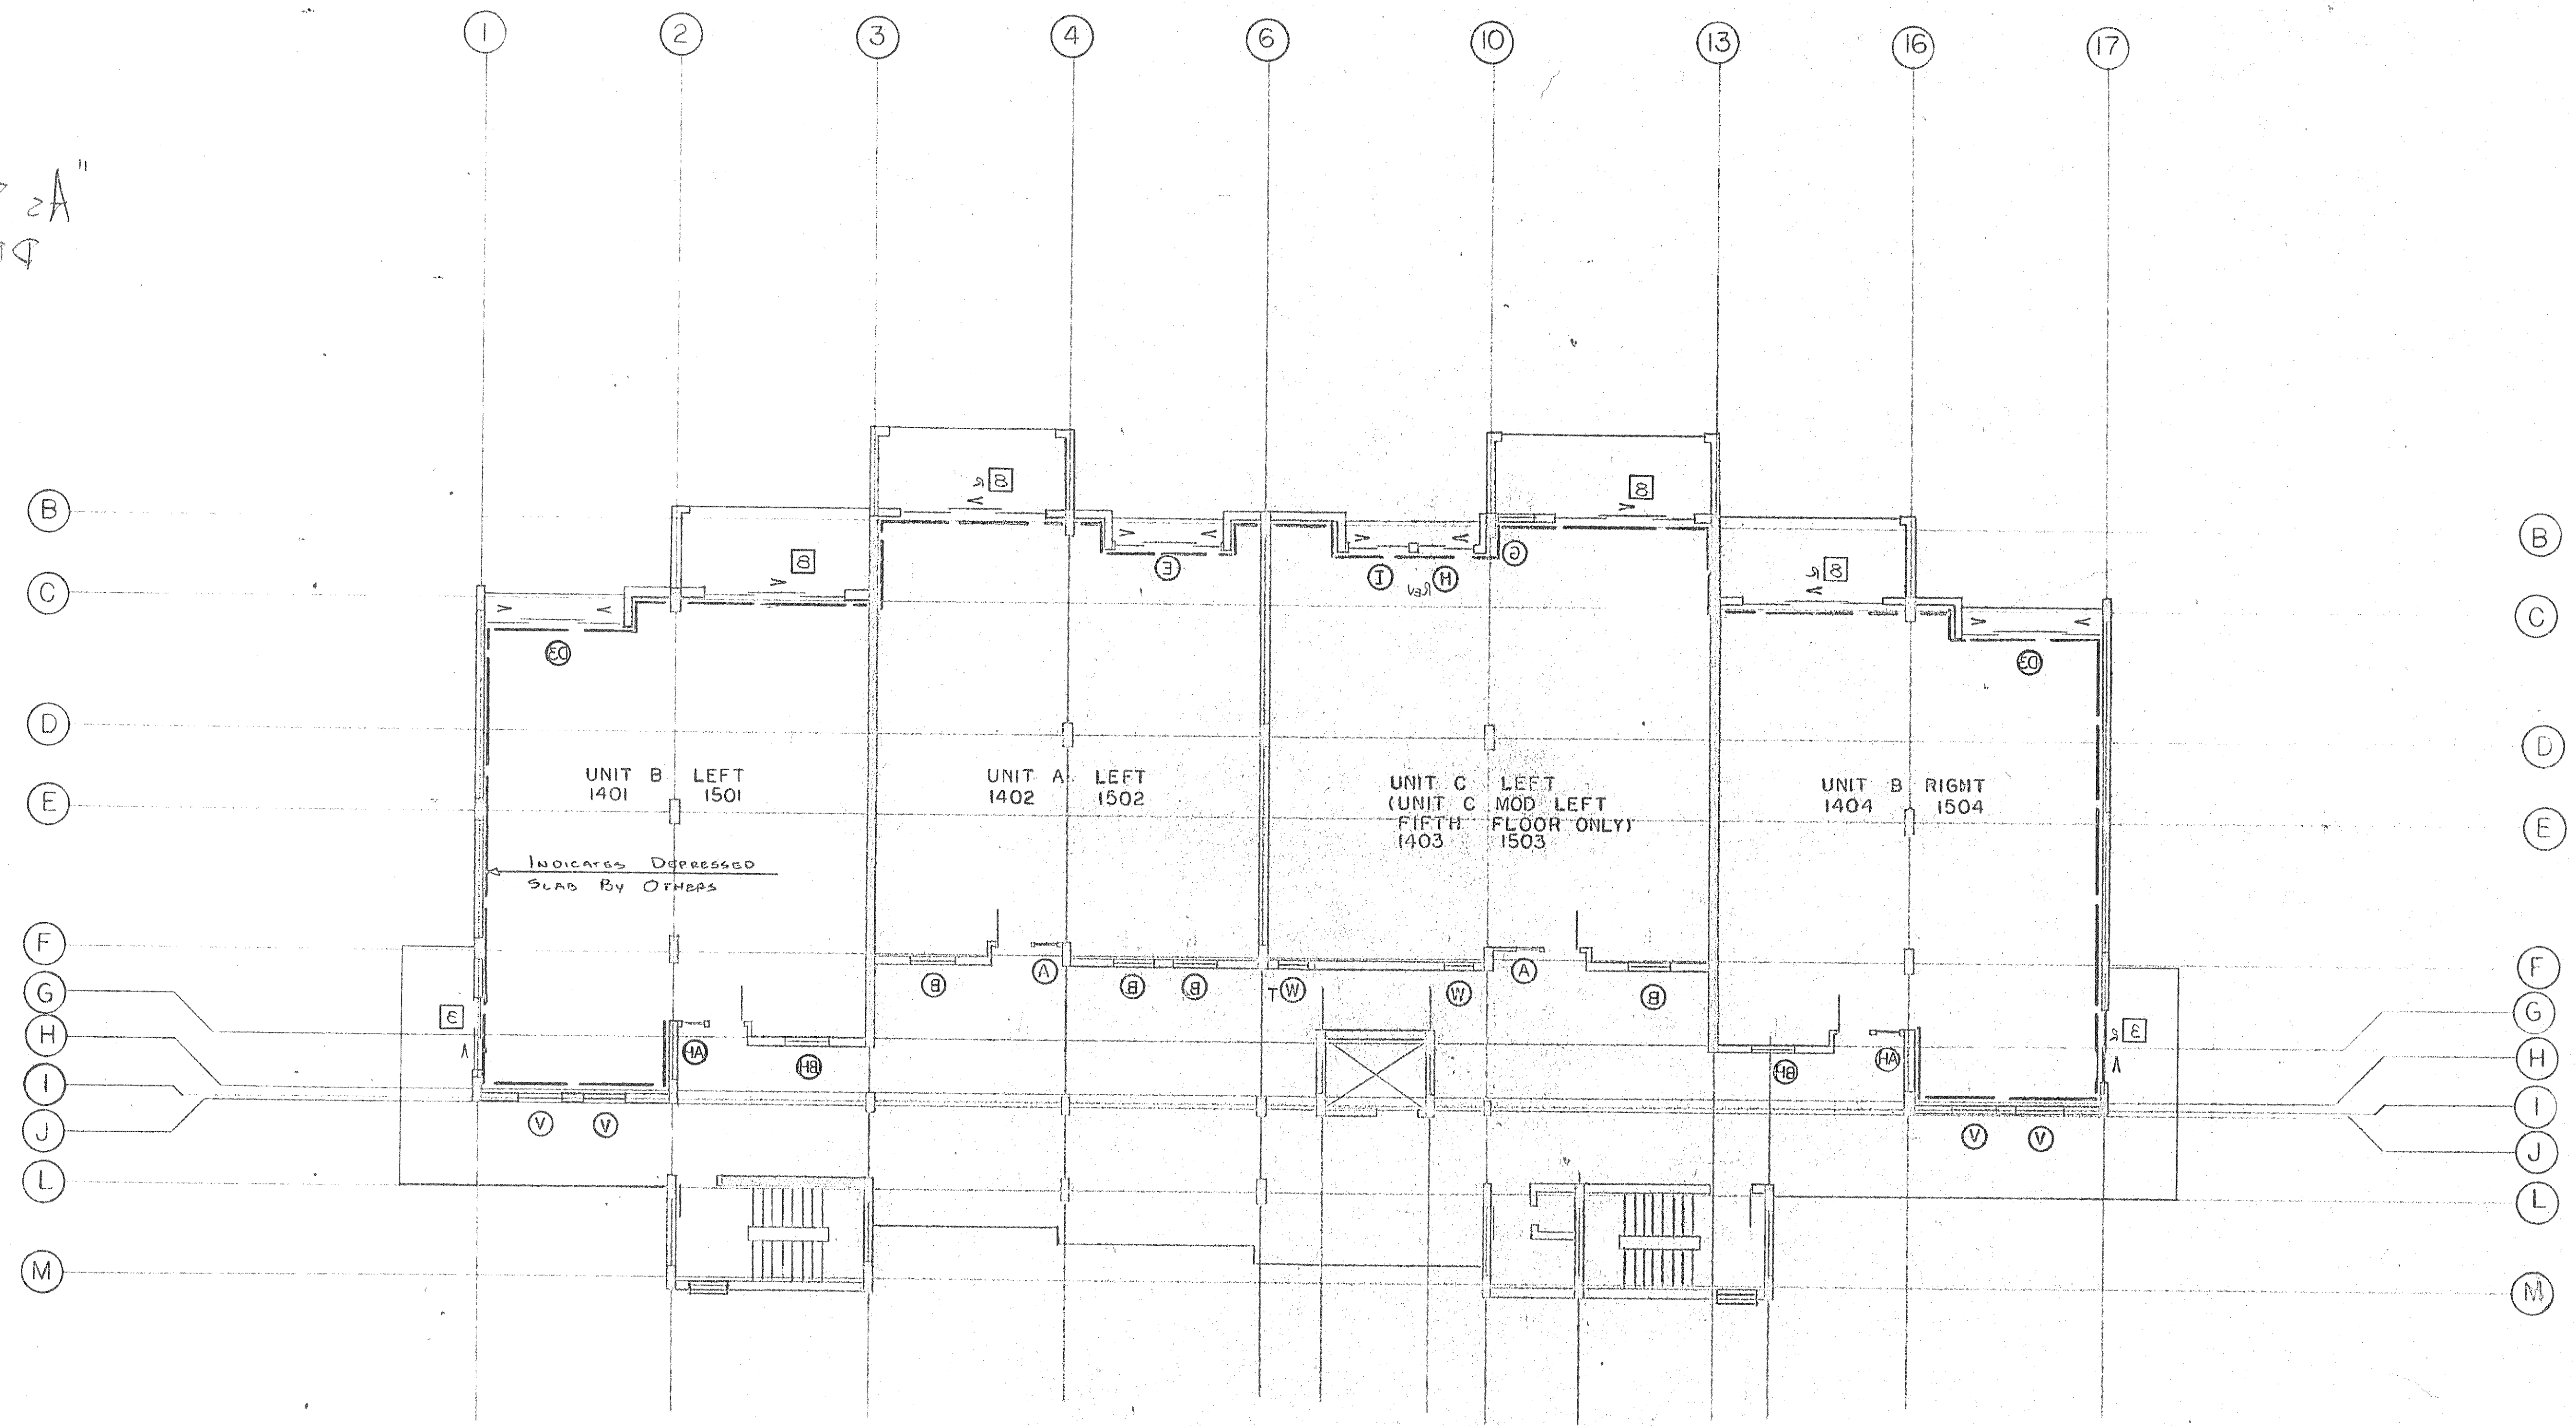

T.M. MARK PLAN BLDG #5 (FIFTH FLOOR)
 T.M. S.C.D. MARK
 T.M. WINDOW MARK

BUILDING S

REVISION		REVISION	
No.	Description	No.	Description
1	ADD HANDICAPPED; DEPRESS SLAB	1	ADD HANDICAPPED; DEPRESS SLAB
2		2	
3		3	
4		4	
5		5	
6		6	
7		7	
8		8	
9		9	
10		10	
11		11	
12		12	
13		13	
14		14	
15		15	
16		16	
17		17	

Project Title:	SUNSET BEACH
Project:	OF LONG BOAT KEY, FLORIDA
Drawing Title:	FLOOR PLAN BLDG #5
Scale:	1/8" = 1'-0"
Date:	11-83
Sheet No.:	12