


"As BUILT
DRWG"

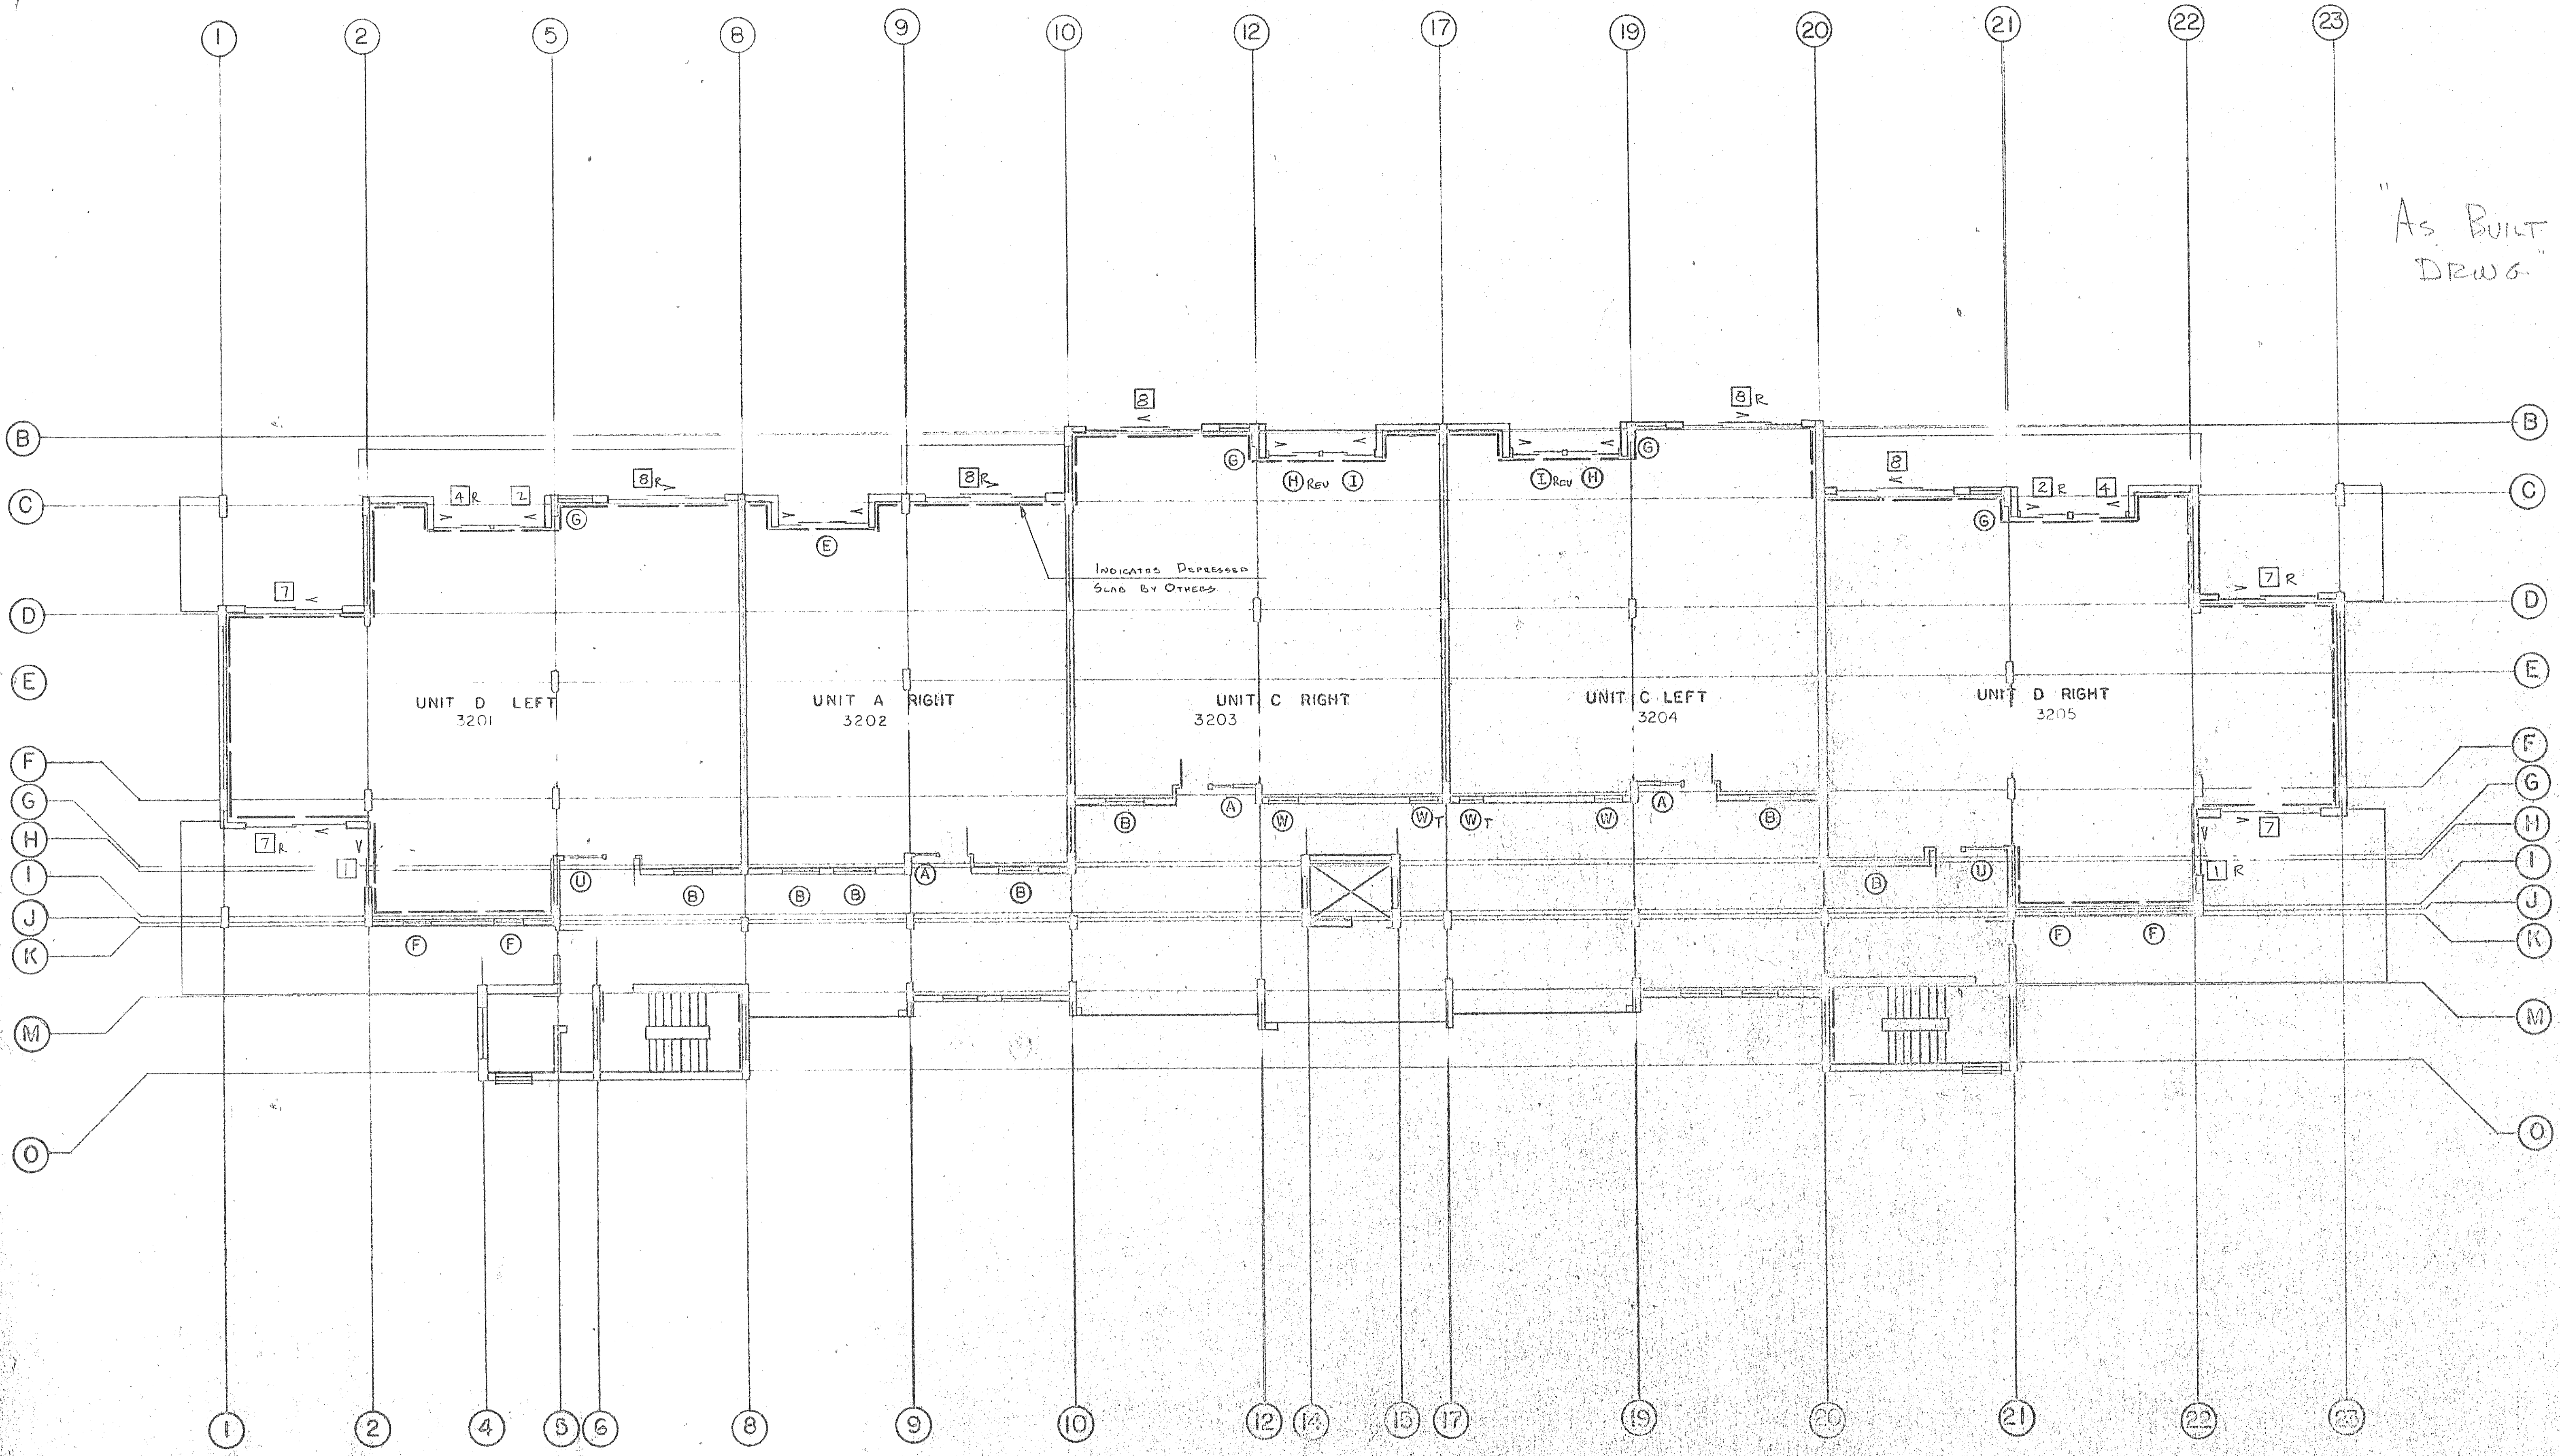

T.M. MARK PLAN BLDG. #3

- T.M. S.G.D. MARK
- T.M. WINDOW MARK

DESCRIPTION		REVISION	
No. / Date	Description	No. / Date	By
	Area Depressed Slab	2-1-04	R.C.