


"AS BUILT
DRWG"

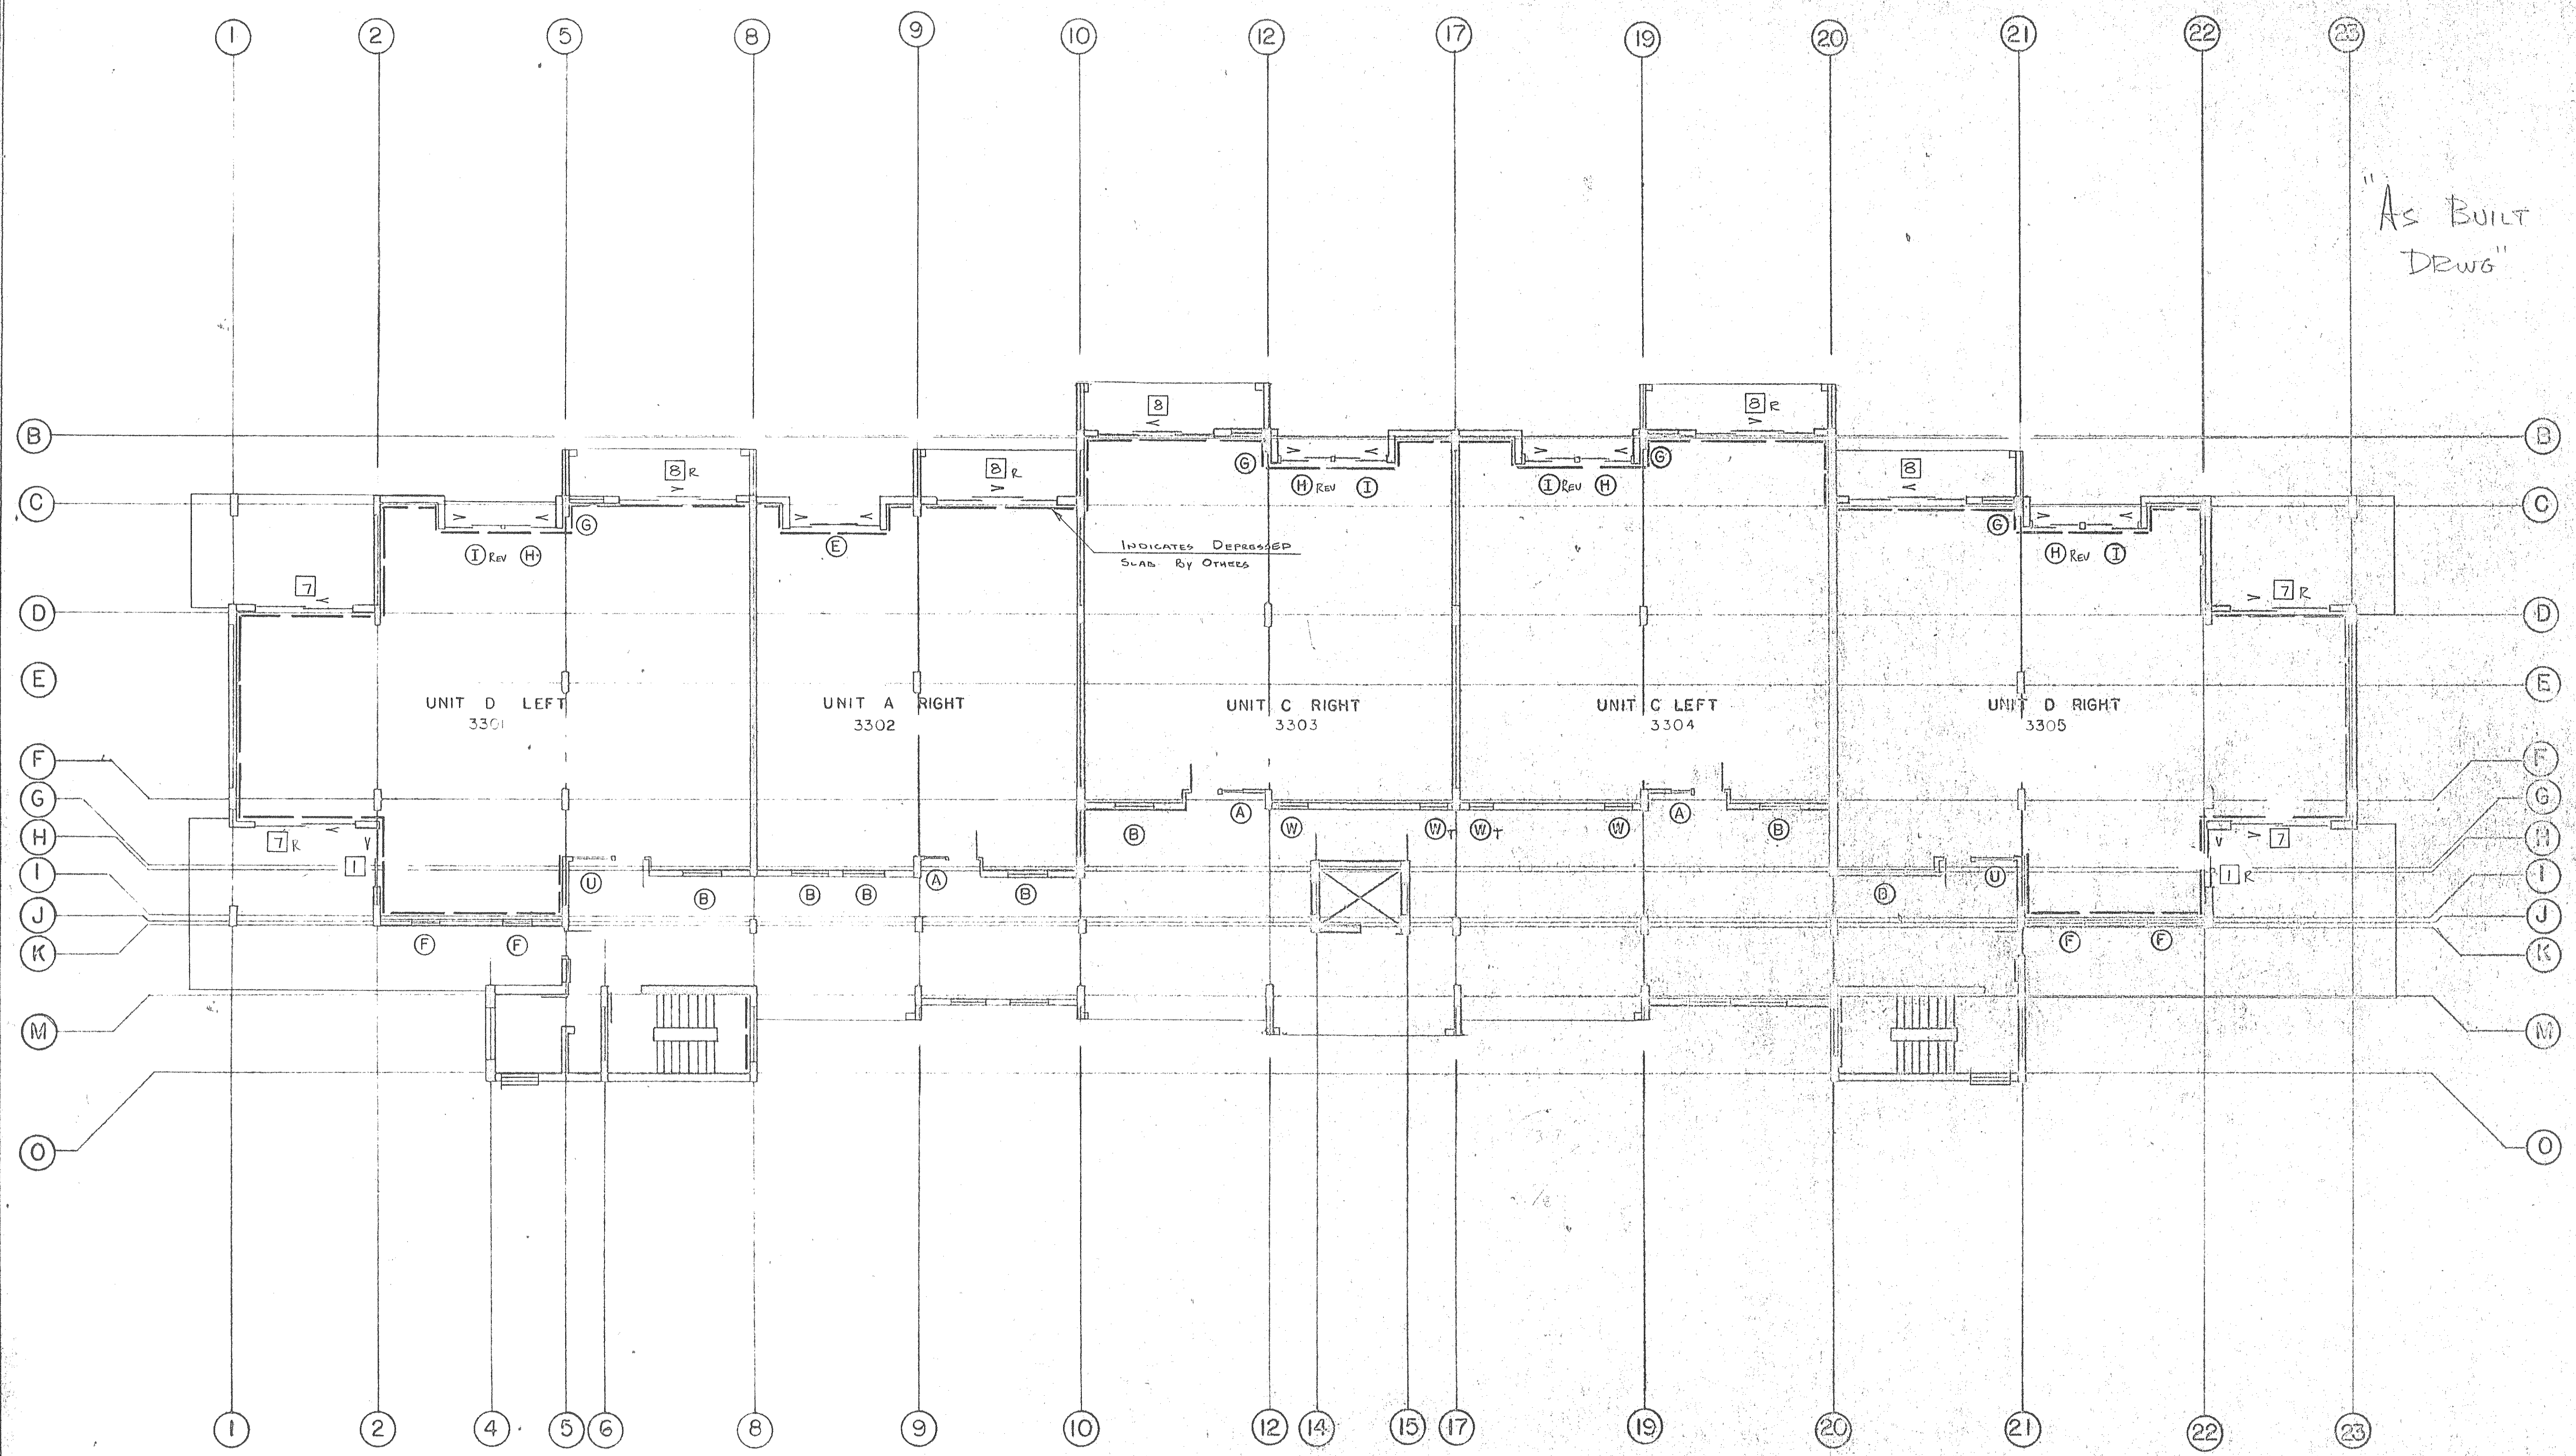

T.M. MARK PLAN
 □ F.M. S.G.D. MARKS
 ○ T.M. WINDOW MARKS

SUBMISSION		REVISION			
No.	Date	No.	Description	Date	By
			ADD DEPOSED SLAB	2-1-81	RC

TRIAL ENGINEERING CO.
 CONSULTING ENGINEERS & ARCHITECTS
 1100 BROADWAY, NEW YORK, N.Y. 10018
 (212) 691-1100

Project: TIANJIN CHINESE RESIDENCE
 DELONG BOAT REPAIR BUILDING
 Contractor: []
 Drawing Title: THIRD FLOOR PLAN BUILDING
 Date: 11-10-80