



"As Built
DRWG."

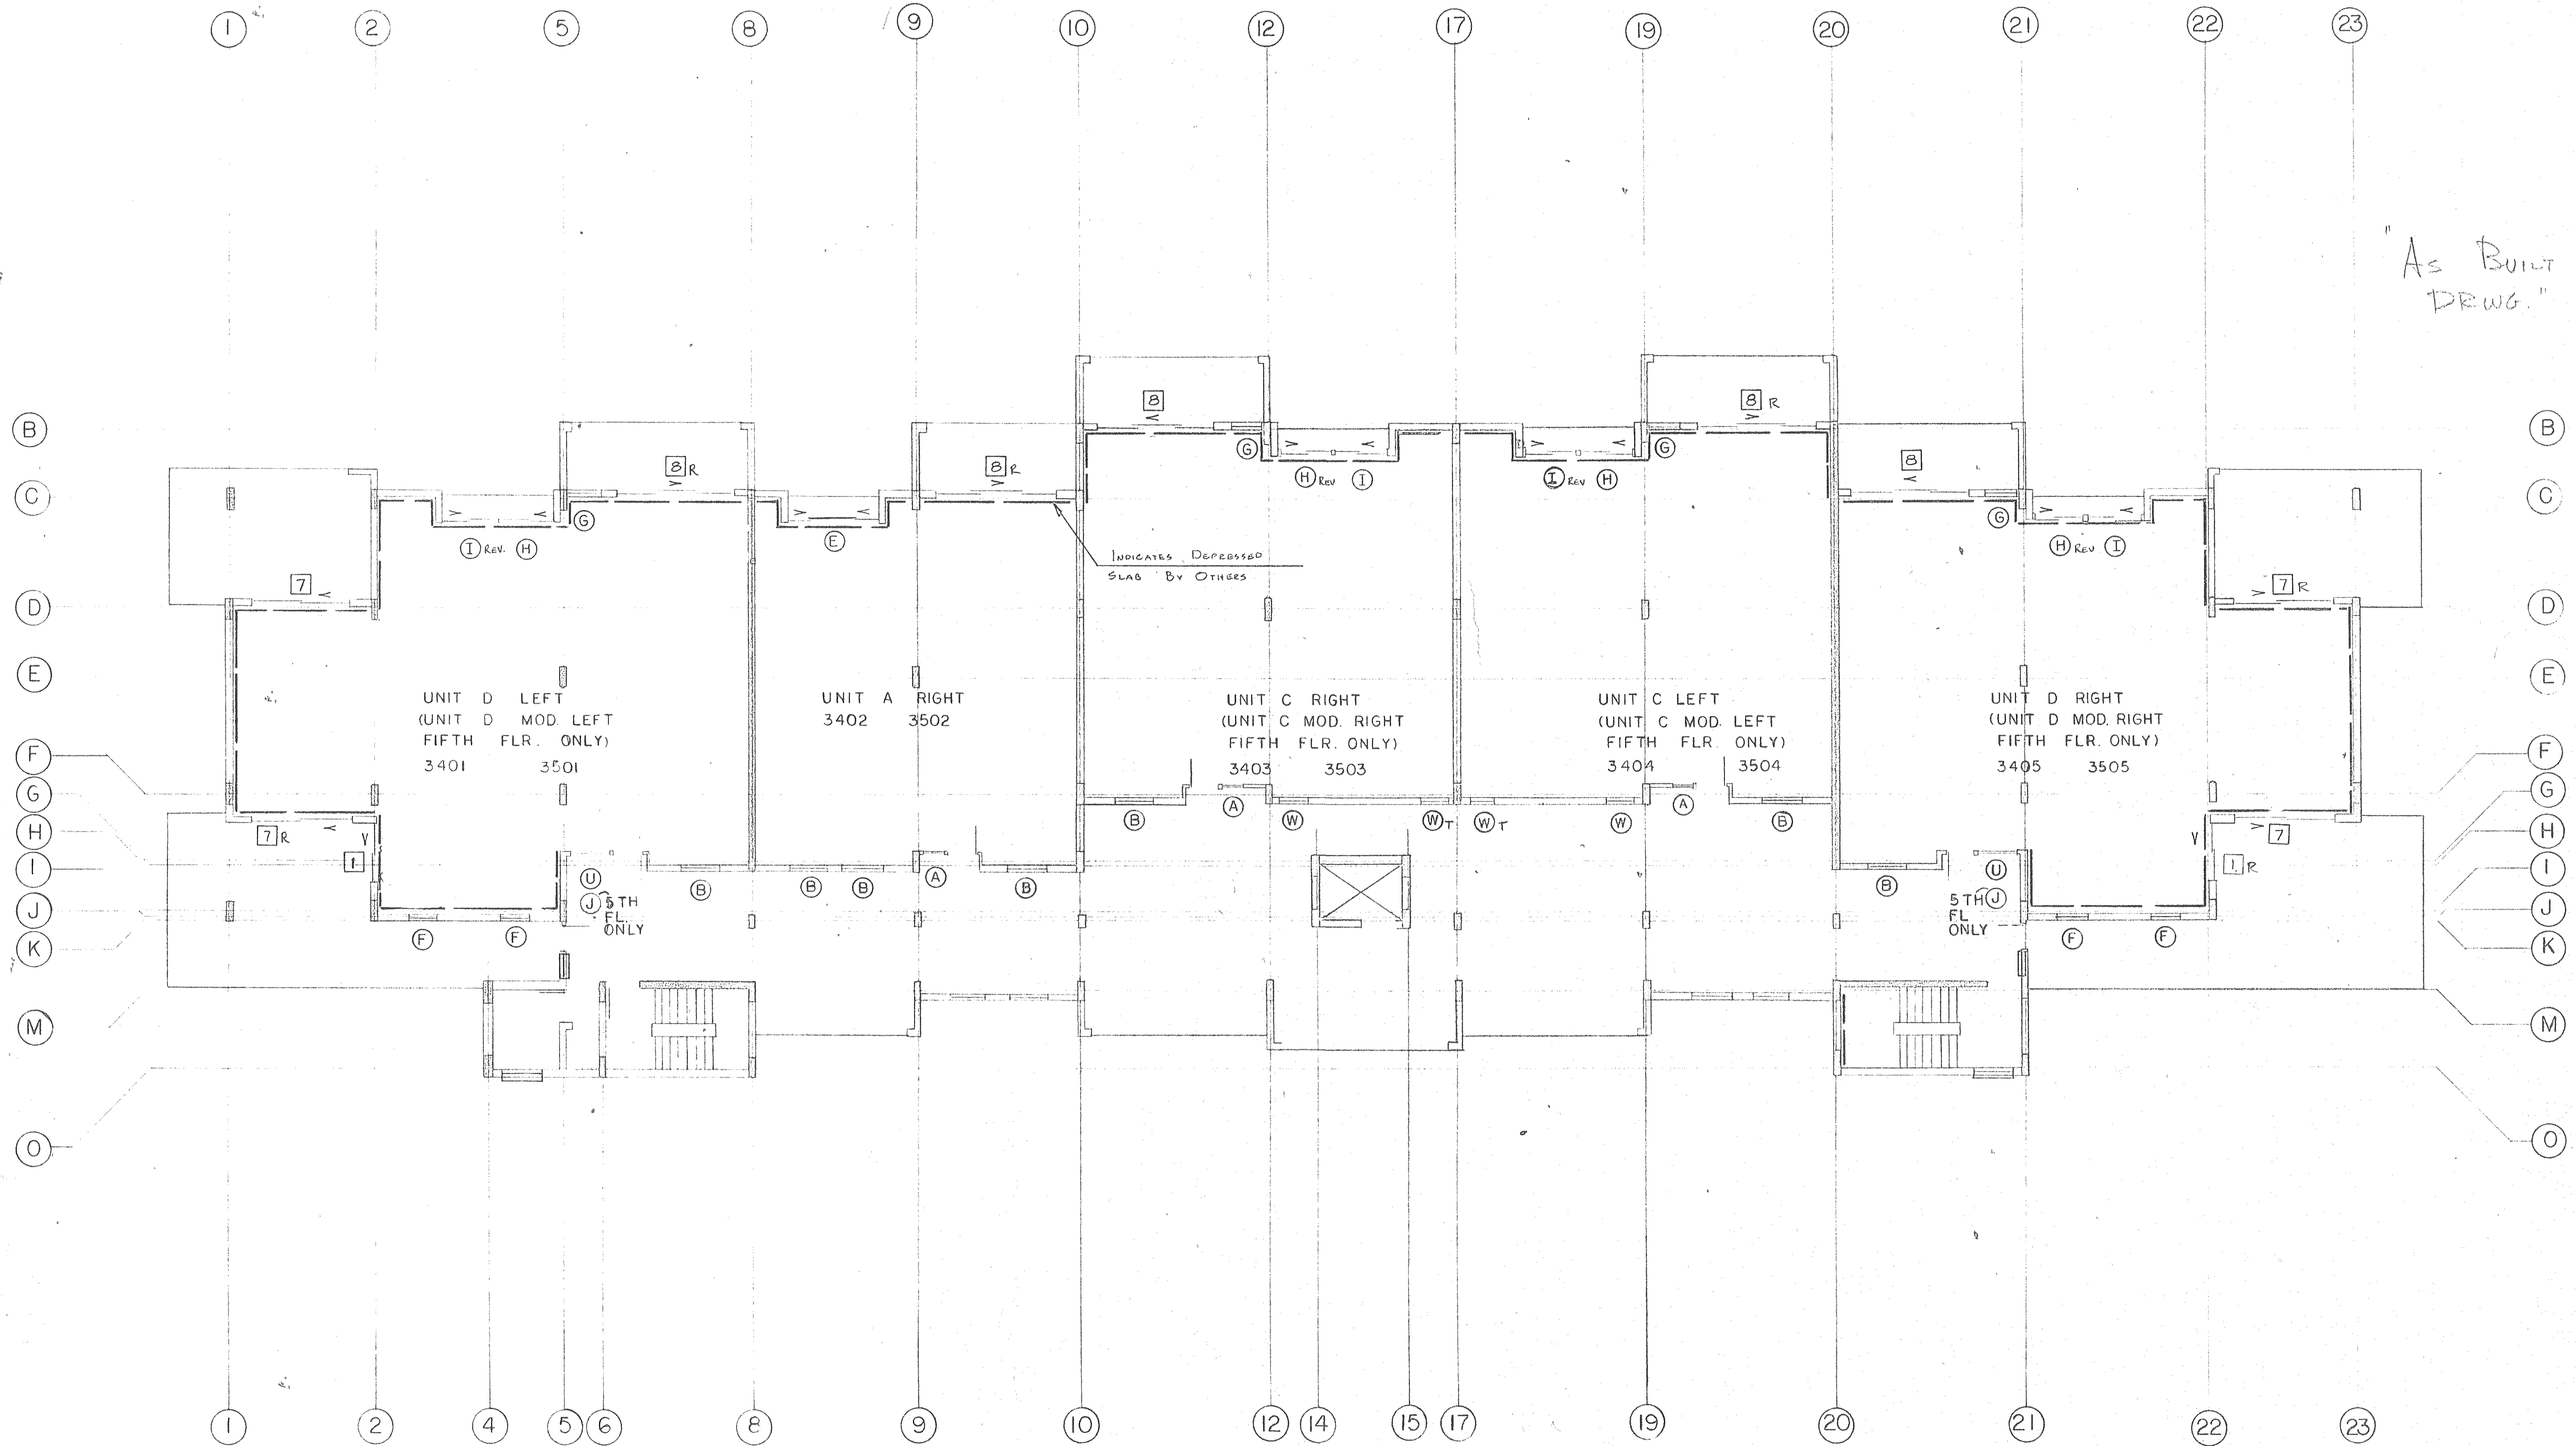

T.M. MARK PLAN BLDG #3

- T.M. S.G.D. MARKS
- T.M. WINDOW MARKS

SUBMISSION		REVISION	
No. / Date	Description	No.	Date: By:
	Add Depressed Slab.		2-9-84 RC



T.M. Products Co.
601 NW 12th Avenue • Pompano Beach, Florida 33060
POMPANO BEACH 181-4400 • DALLAS 1205 943-3128 • PALM BEACH 1203 737-6448

Project Title: **SUNSET BEACH**
OF LONG BOAT KEY, FLORIDA

Contractor: _____ Project No. _____

Drawing Title: **FLOOR PLAN BUILDING 3**
FOURTH AND FIFTH

Scale: 1/8" = 1'-0" Drawn By: V.B. 11-10-83 Date: _____ Chkd. By: _____ Date: _____ Sheet No. 12 OF 15