
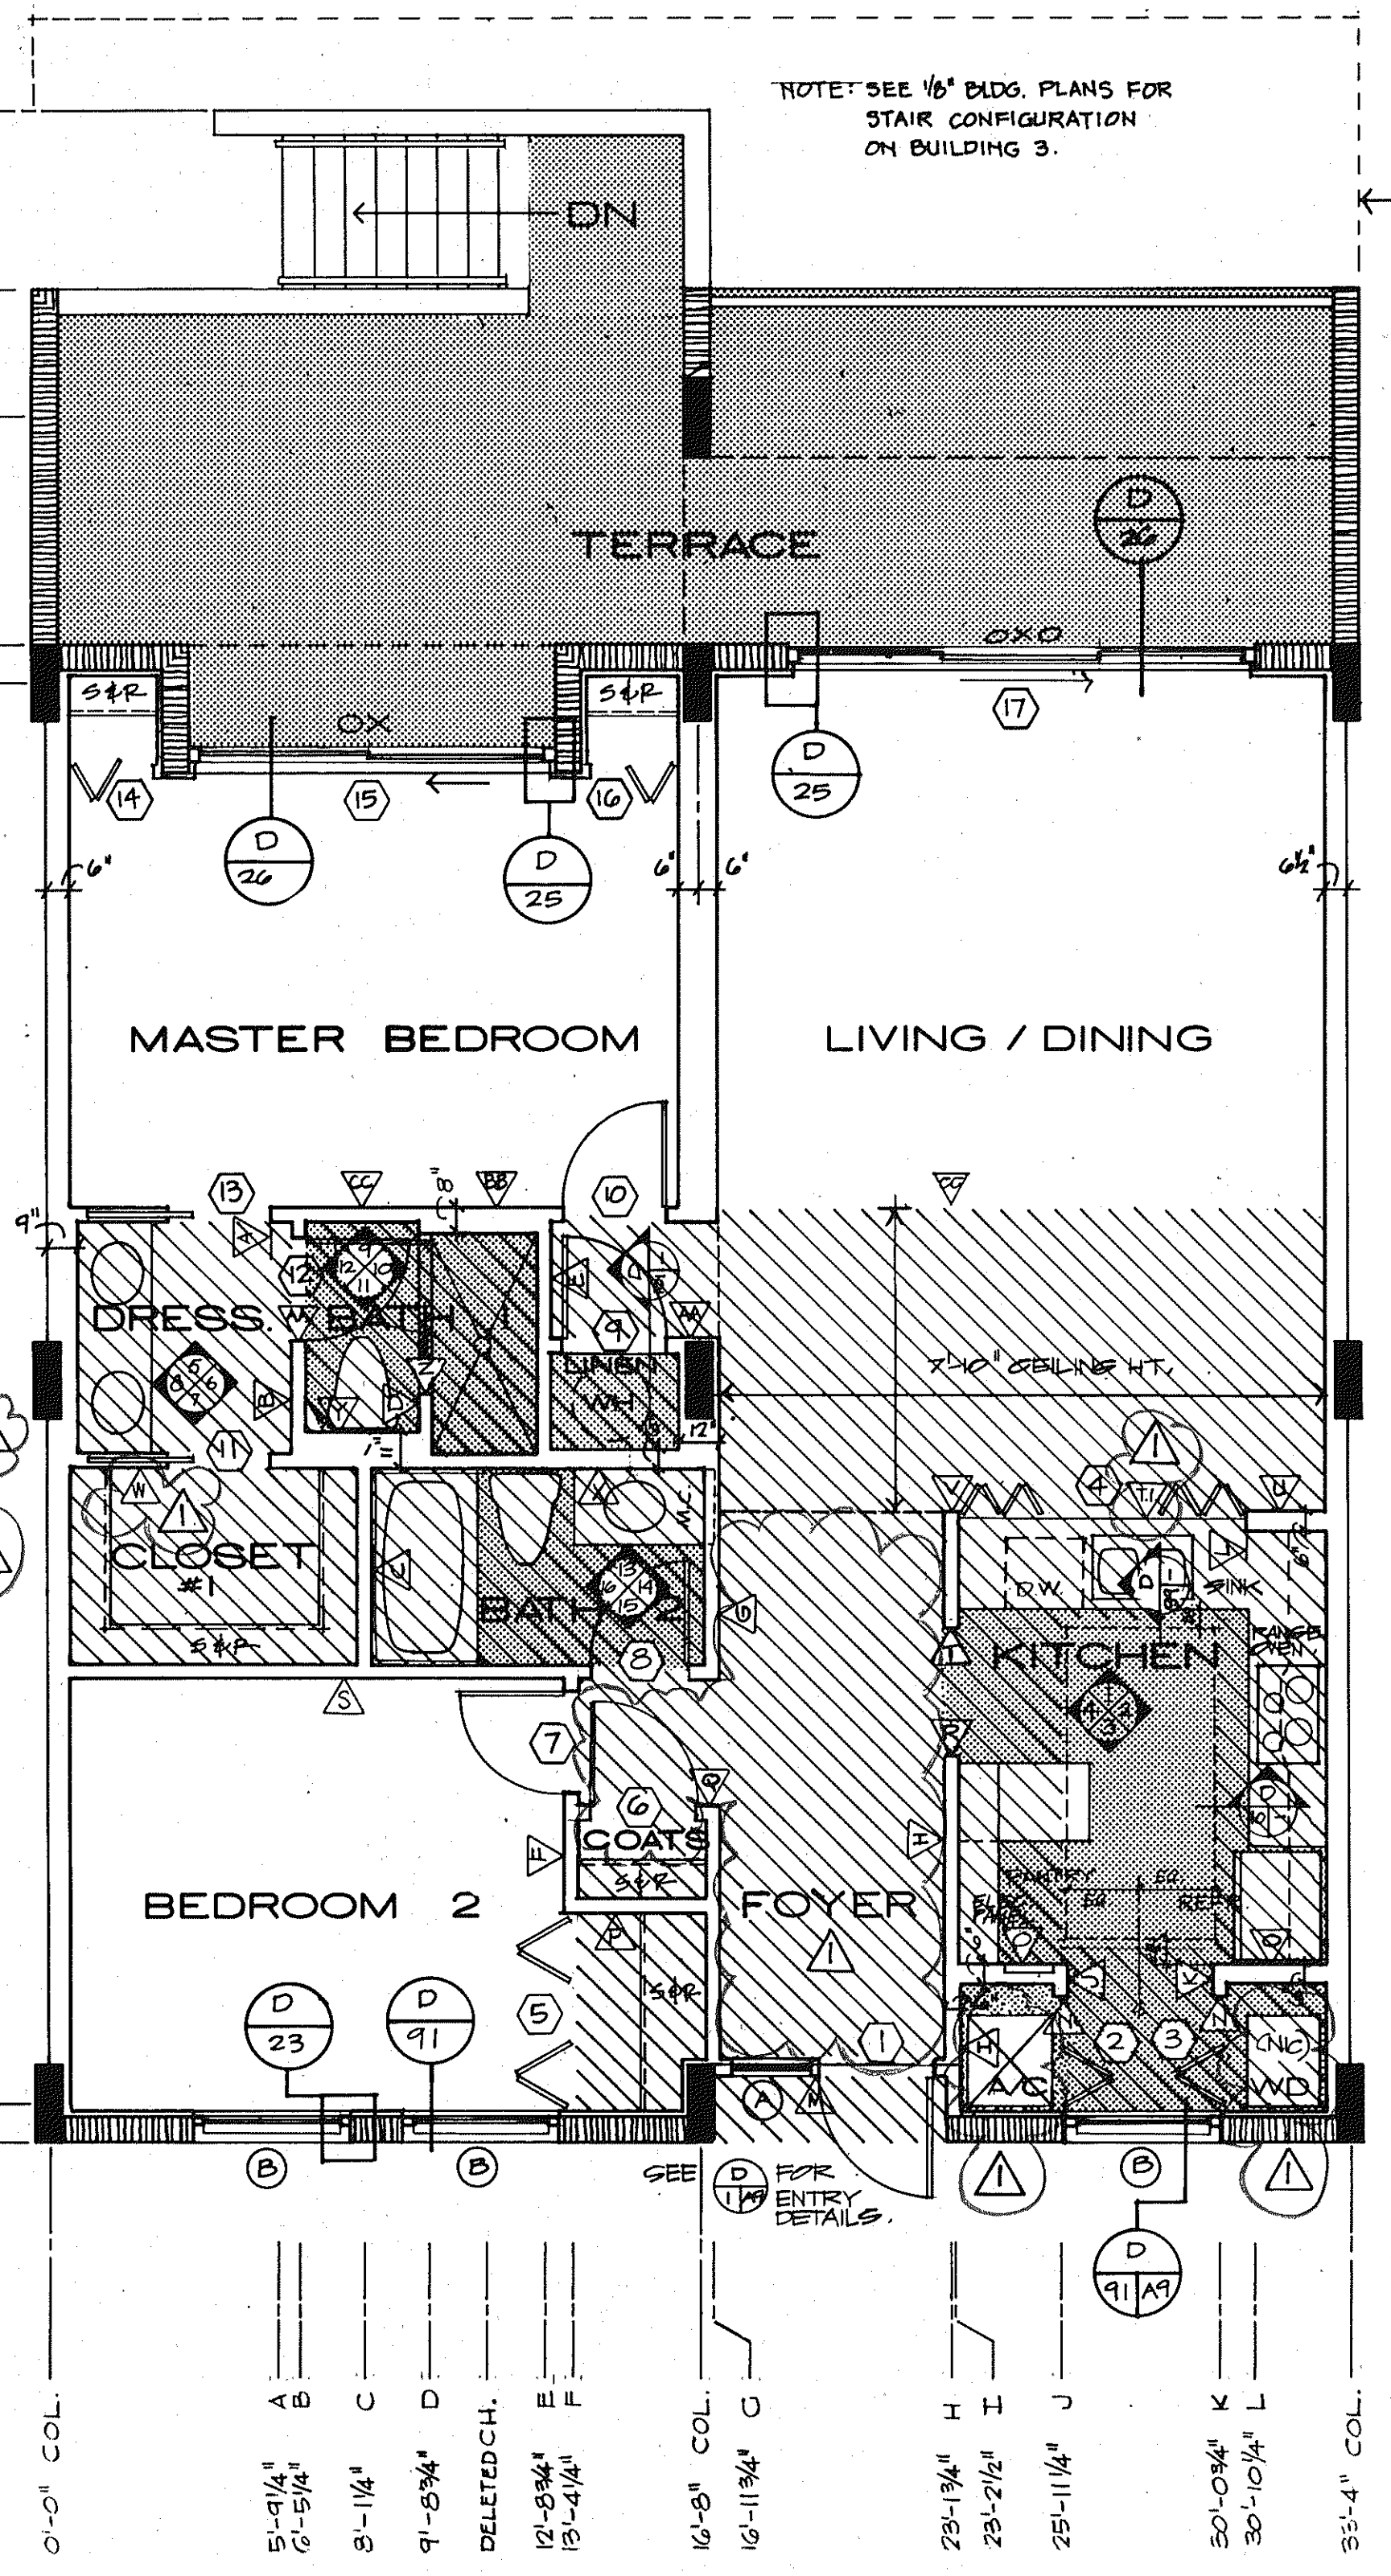
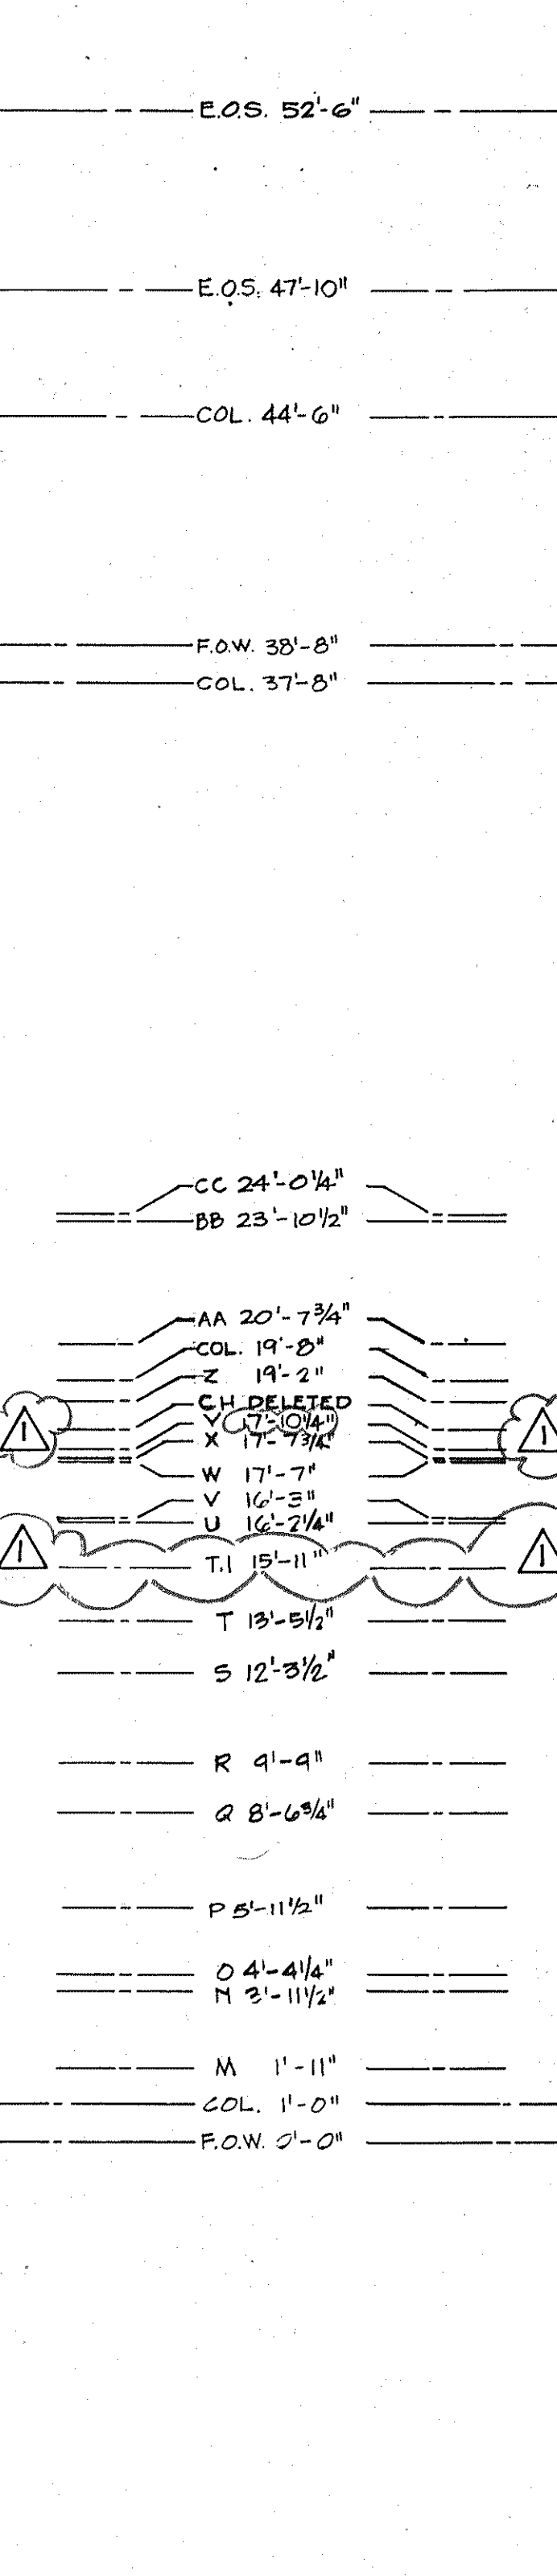


NOTE: SEE 1/8" BLDG. PLANS FOR STAIR CONFIGURATION ON BUILDING 3.

NOTE: SEE 1/8" BLDG. PLANS FOR STAIR CONFIGURATION ON BUILDING 3.

SEE BLDG. 3 1/8" PLANS FOR LOCATION OF UNIT 102.

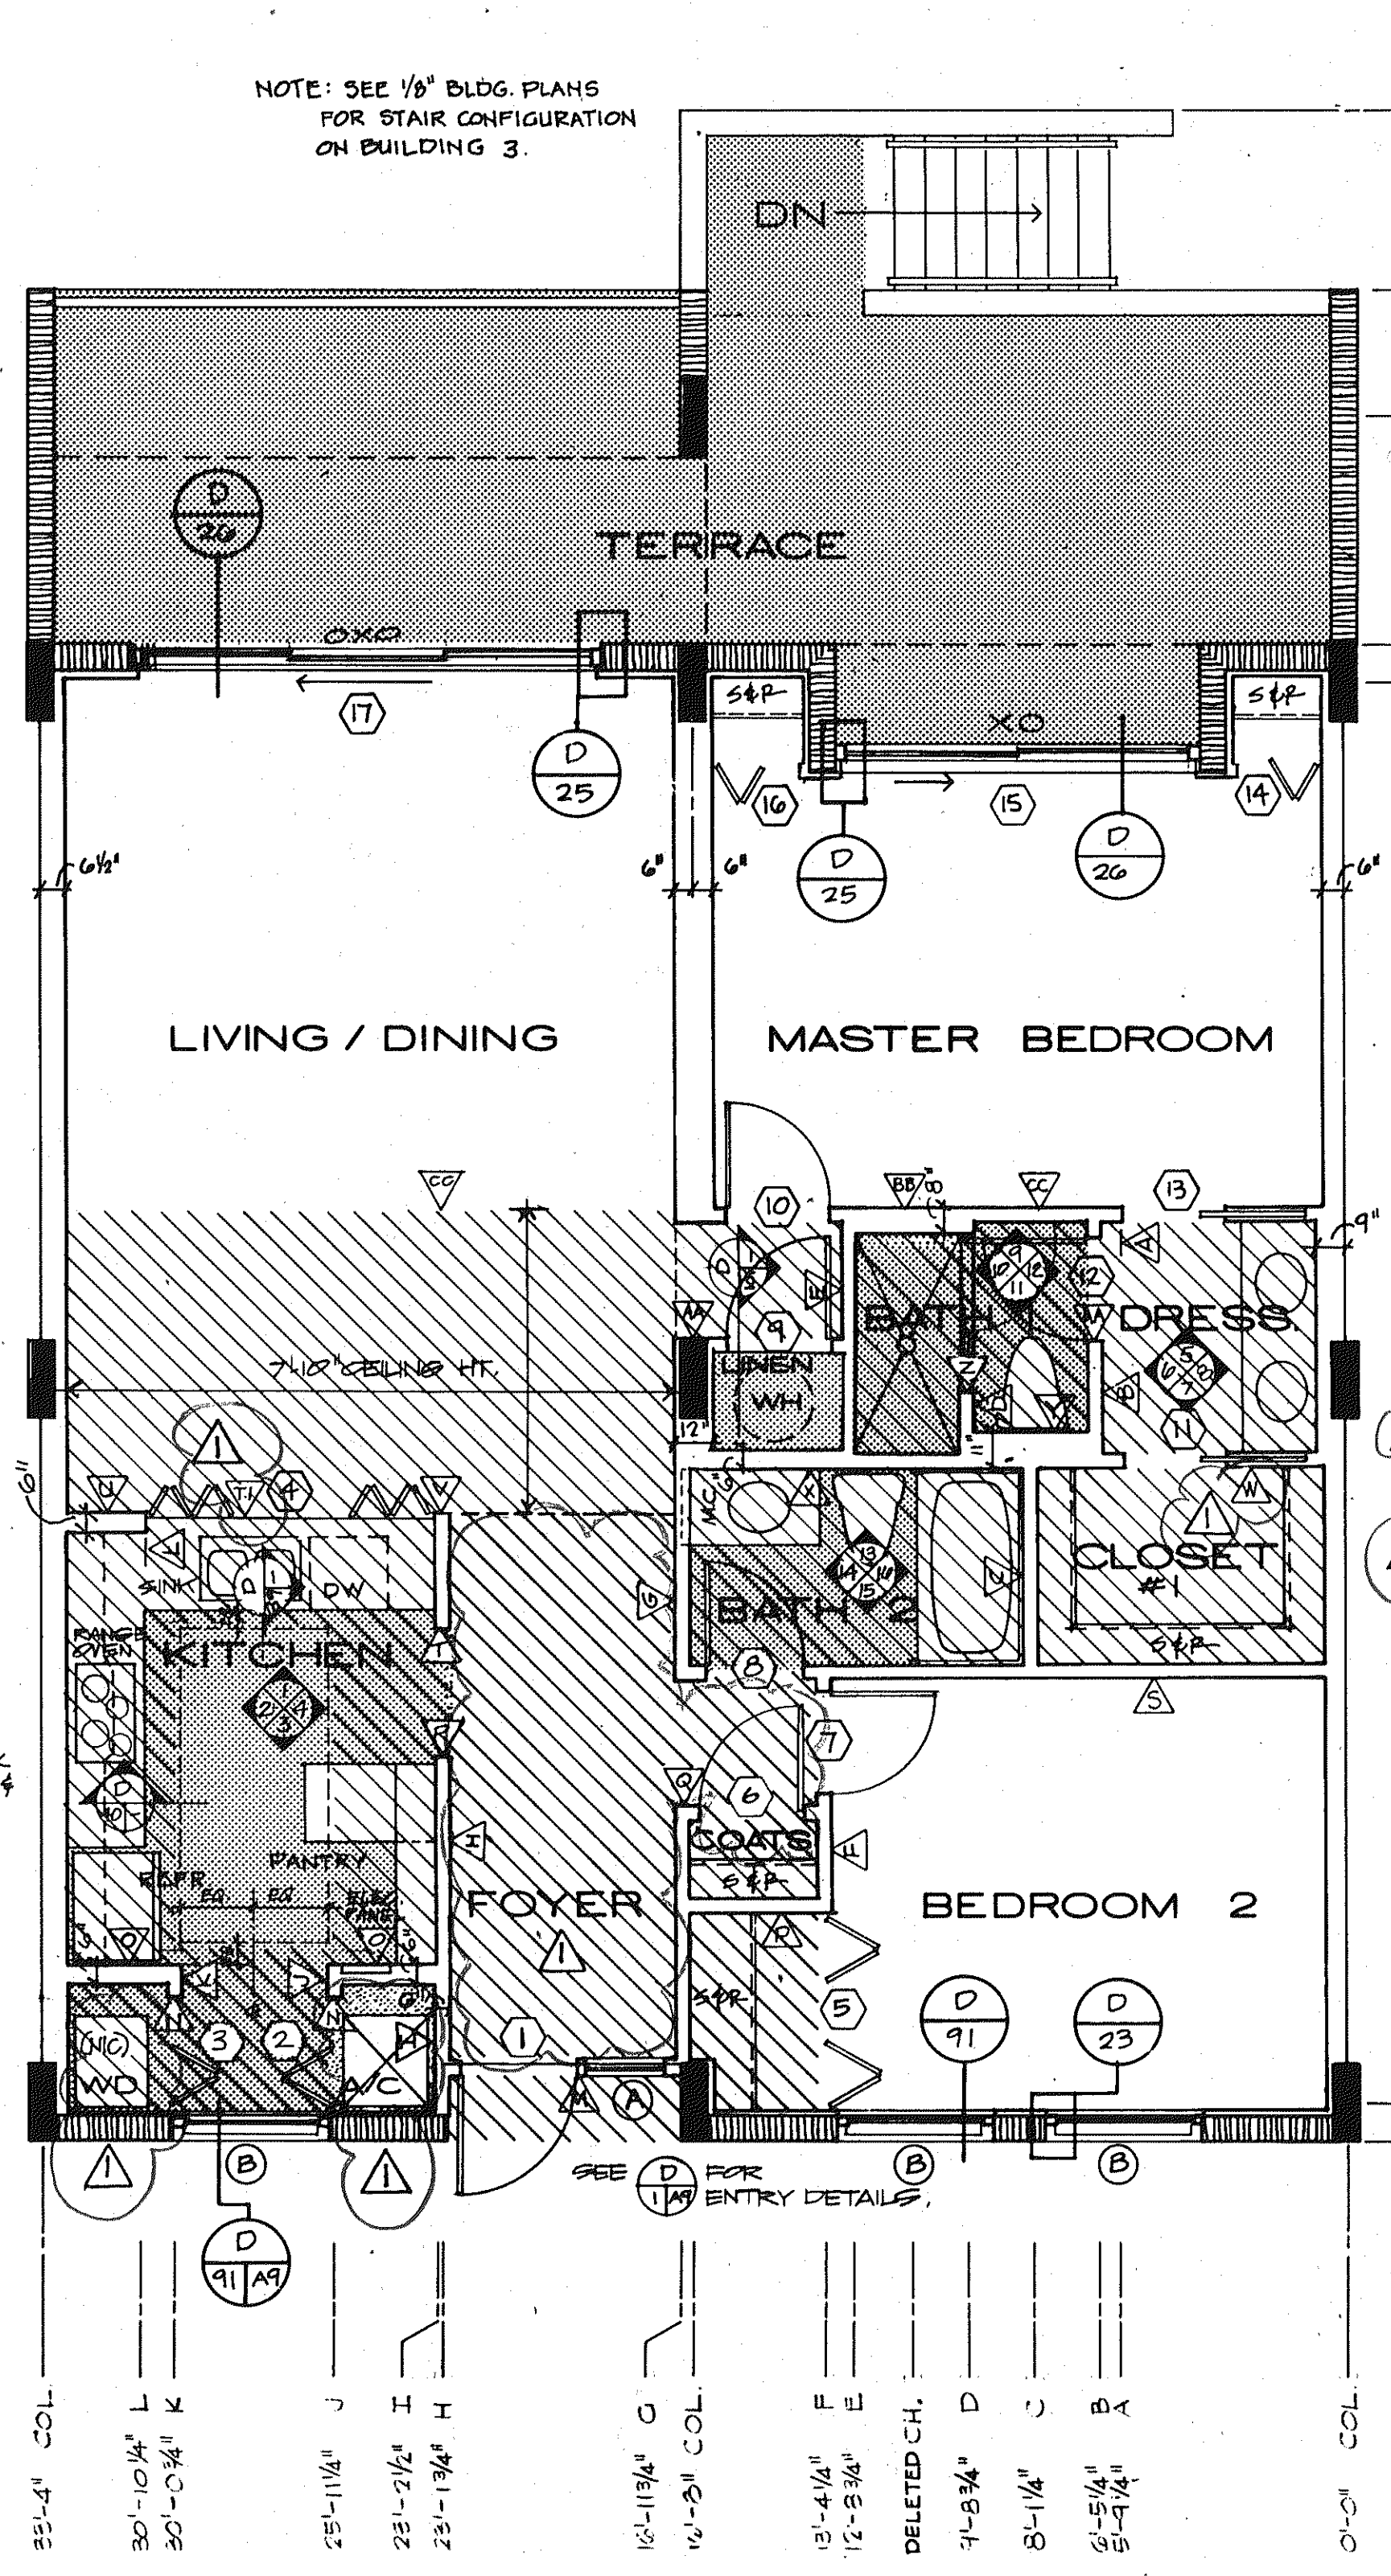


UNIT A+ LEFT

UNIT A+ RIGHT

NOTES

1. SEE 1/8" BLDG. PLANS FOR COL. & SHEAR WALL LOCATIONS.
2. ALL PROPPED CEILING ARE 7'-0" UNLESS OTHERWISE NOTED.
3. ALL DIMENSIONS ARE FROM CENTERLINE OF WALL.
4. SEE DETAIL BOOKLET FOR FLOOR, WINDOW & FINISH SCHEDULES.
5. SCREEN DOT TEXTURE DENOTES PAVERS, CER. TILE, VINYL TILE & VAT. SEE FINISH SCHEDULES FOR EXACT LOCATIONS.
6. VERIFY EXACT LOCATION OF LAVATORIES W/ ARCHITECT.

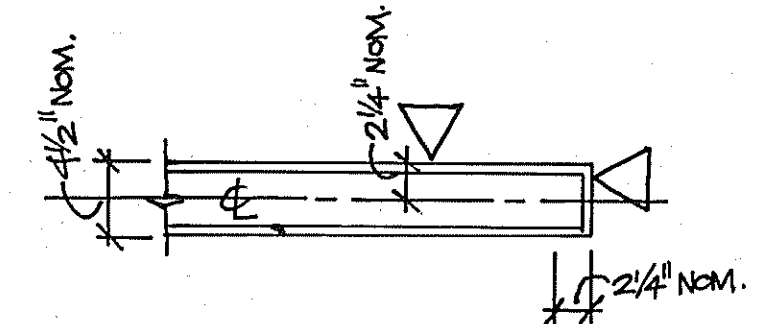

DIMENSIONING KEY