


OVERLAYS
COMPOSITE
6 16
7 17
8 18
1 21
2 22

SEE DETAILS AND MILLWORK SHOP DRINGS FOR SIZE & LOCATION OF KITCHEN CEILING LIGHTING.

D 39

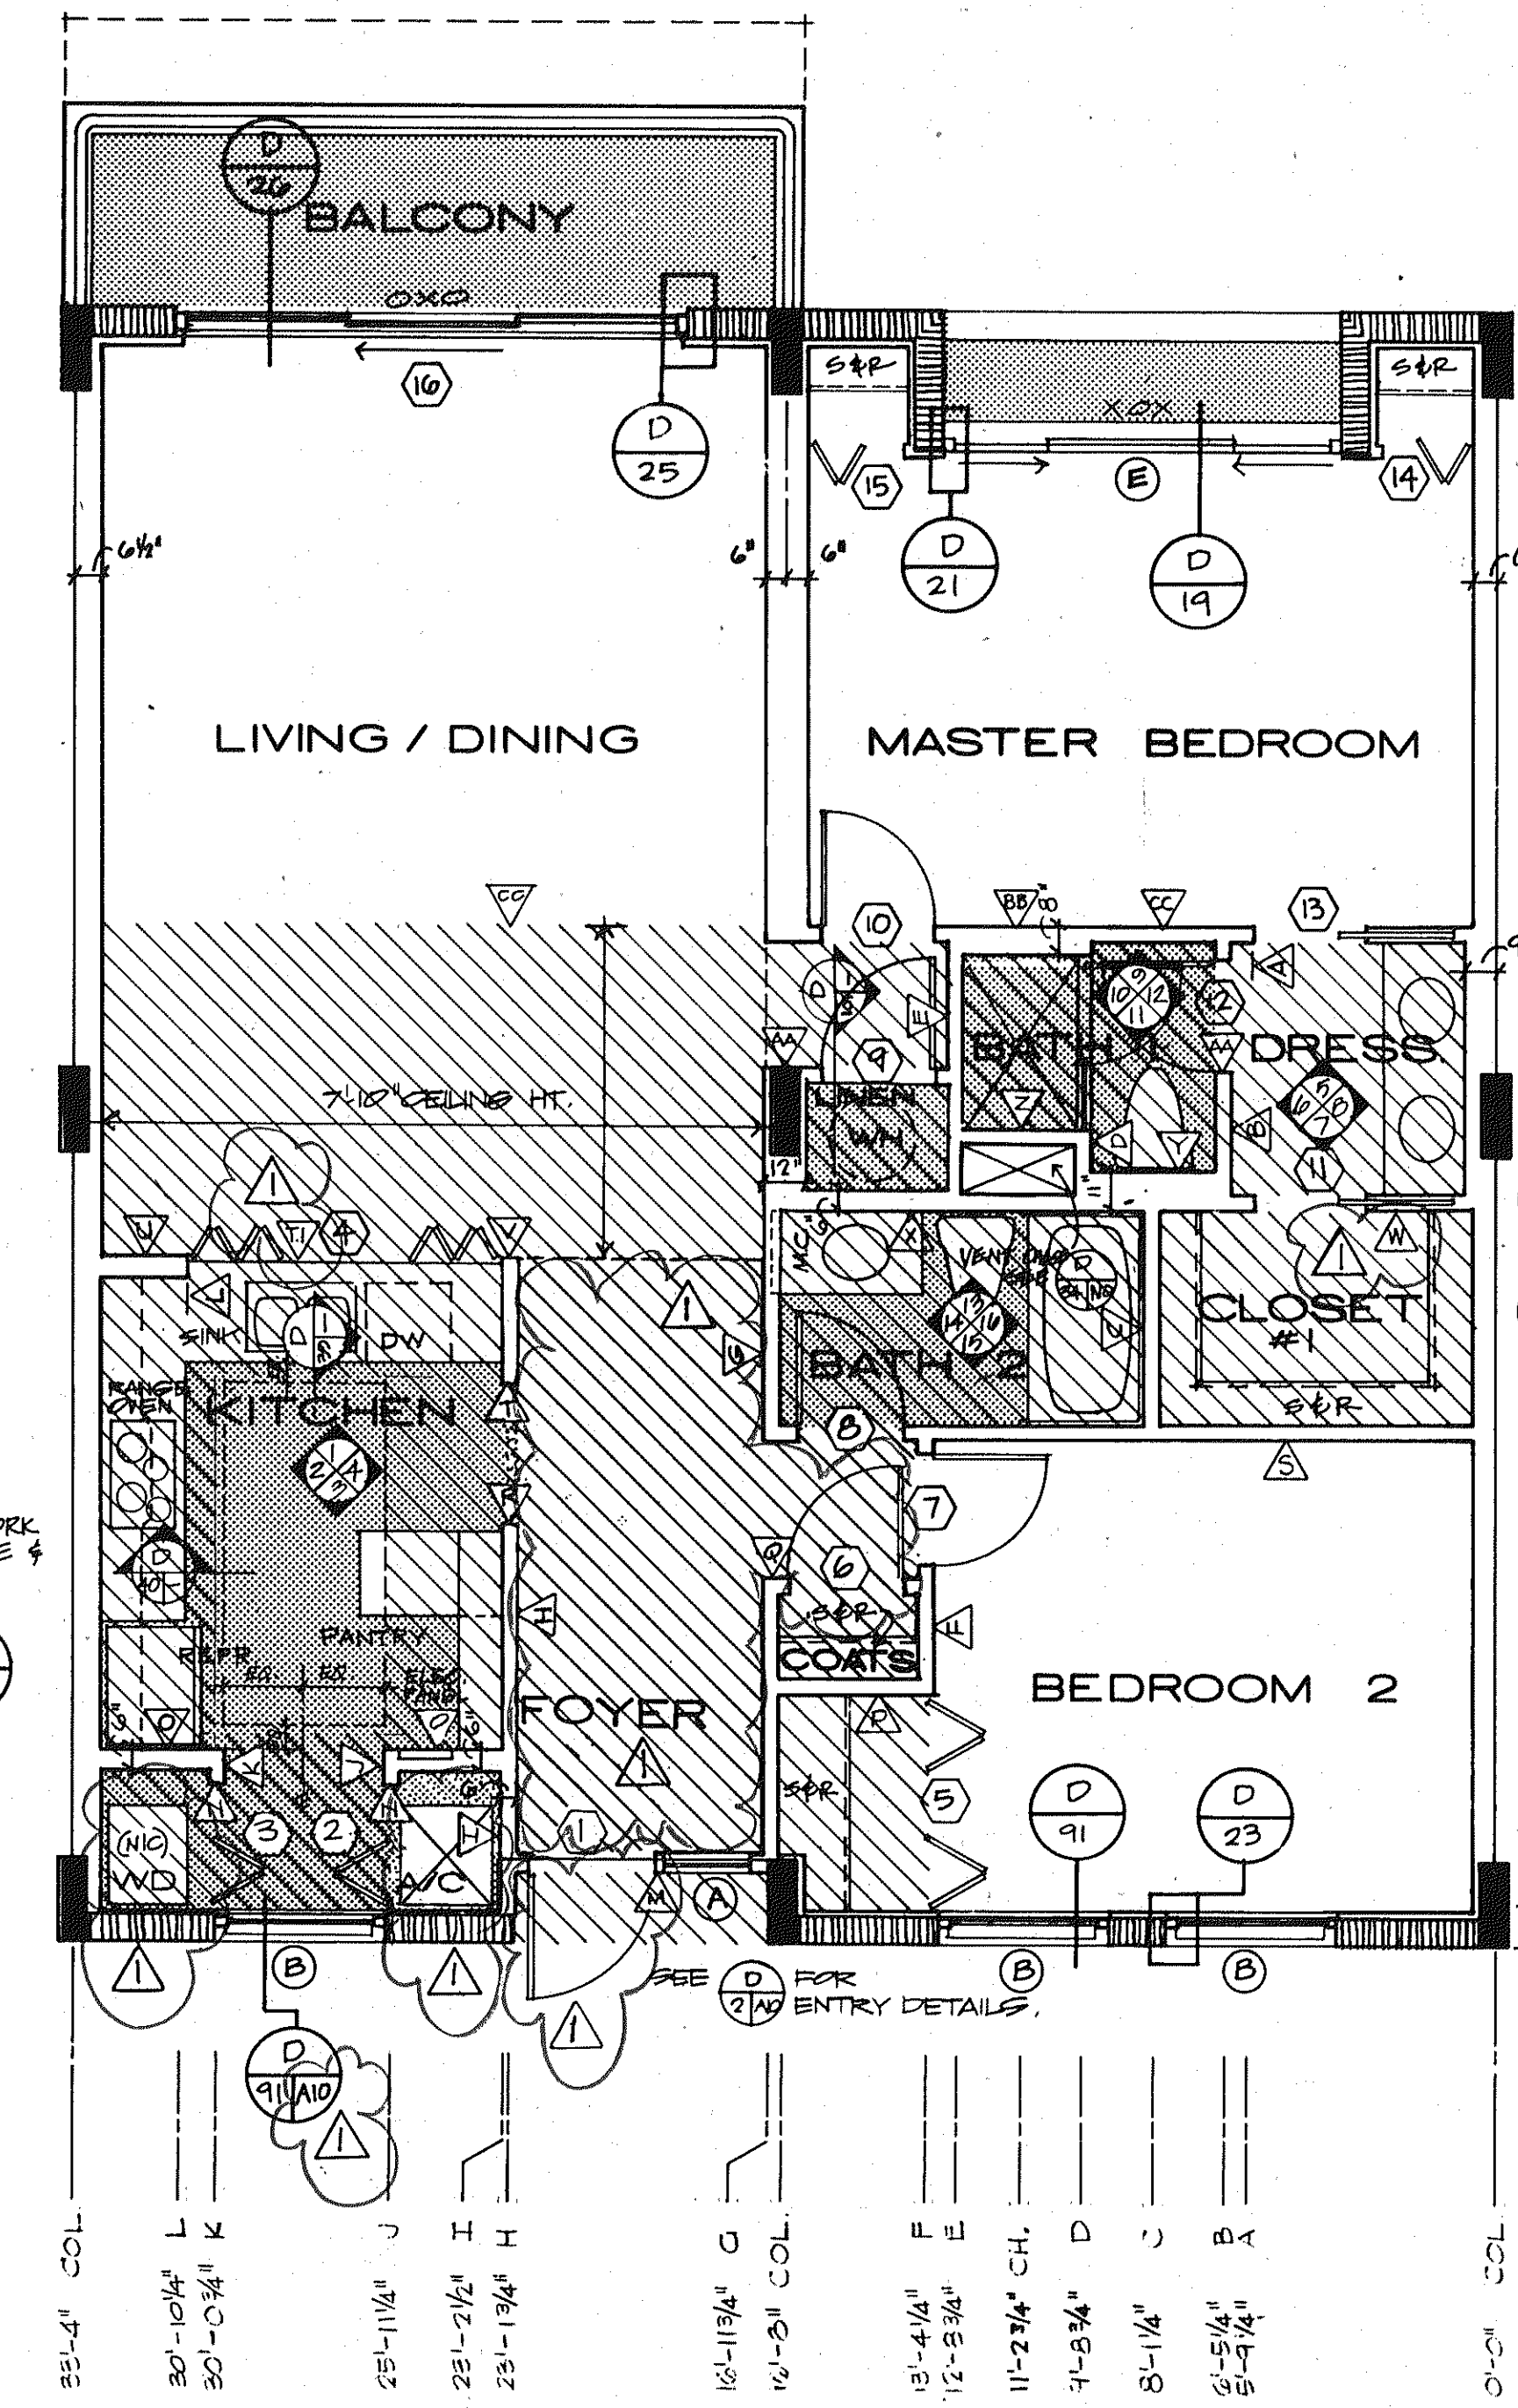

UNIT A LEFT

NOTE:
BALCONY DEPTHS DIFFER FROM THIS DRAWING ON FLOORS 4 & 5. SEE 1/8\"/>



E.O.S. 45'-6" (4TH & 5TH ONLY)
E.O.S. 43'-6" (2ND & 3RD ONLY)

F.O.W. 38'-8"
COL. 37'-8"

CC 24'-0 1/4"
BB 23'-10 1/2"

AA 20'-7 3/4"
COL. 19'-2"
Z 19'-2"
CH 18'-4 1/4"
X 17'-7 3/4"
W 17'-7"
V 16'-3"
U 16'-2 1/4"
T 15'-11"
T 13'-5 1/2"
S 12'-3 1/2"
R 9'-4"
Q 8'-6 3/4"
P 5'-11 1/2"
O 4'-4 1/4"
N 3'-11 1/2"
M 1'-11"
COL. 1'-0"
F.O.W. 0'-0"

35'-4" COL
L 30'-10 1/4"
K 30'-0 3/4"
J 25'-11 1/4"
I 23'-1 1/2"
H 23'-1 3/4"
G 16'-11 3/4"
COL. 16'-2"
F 13'-4 1/8"
E 12'-3 3/4"
CH. 11'-2 3/4"
D 11'-8 3/4"
C 8'-1 1/4"
B 6'-5 1/4"
A 5'-1 1/4"
0'-0" COL

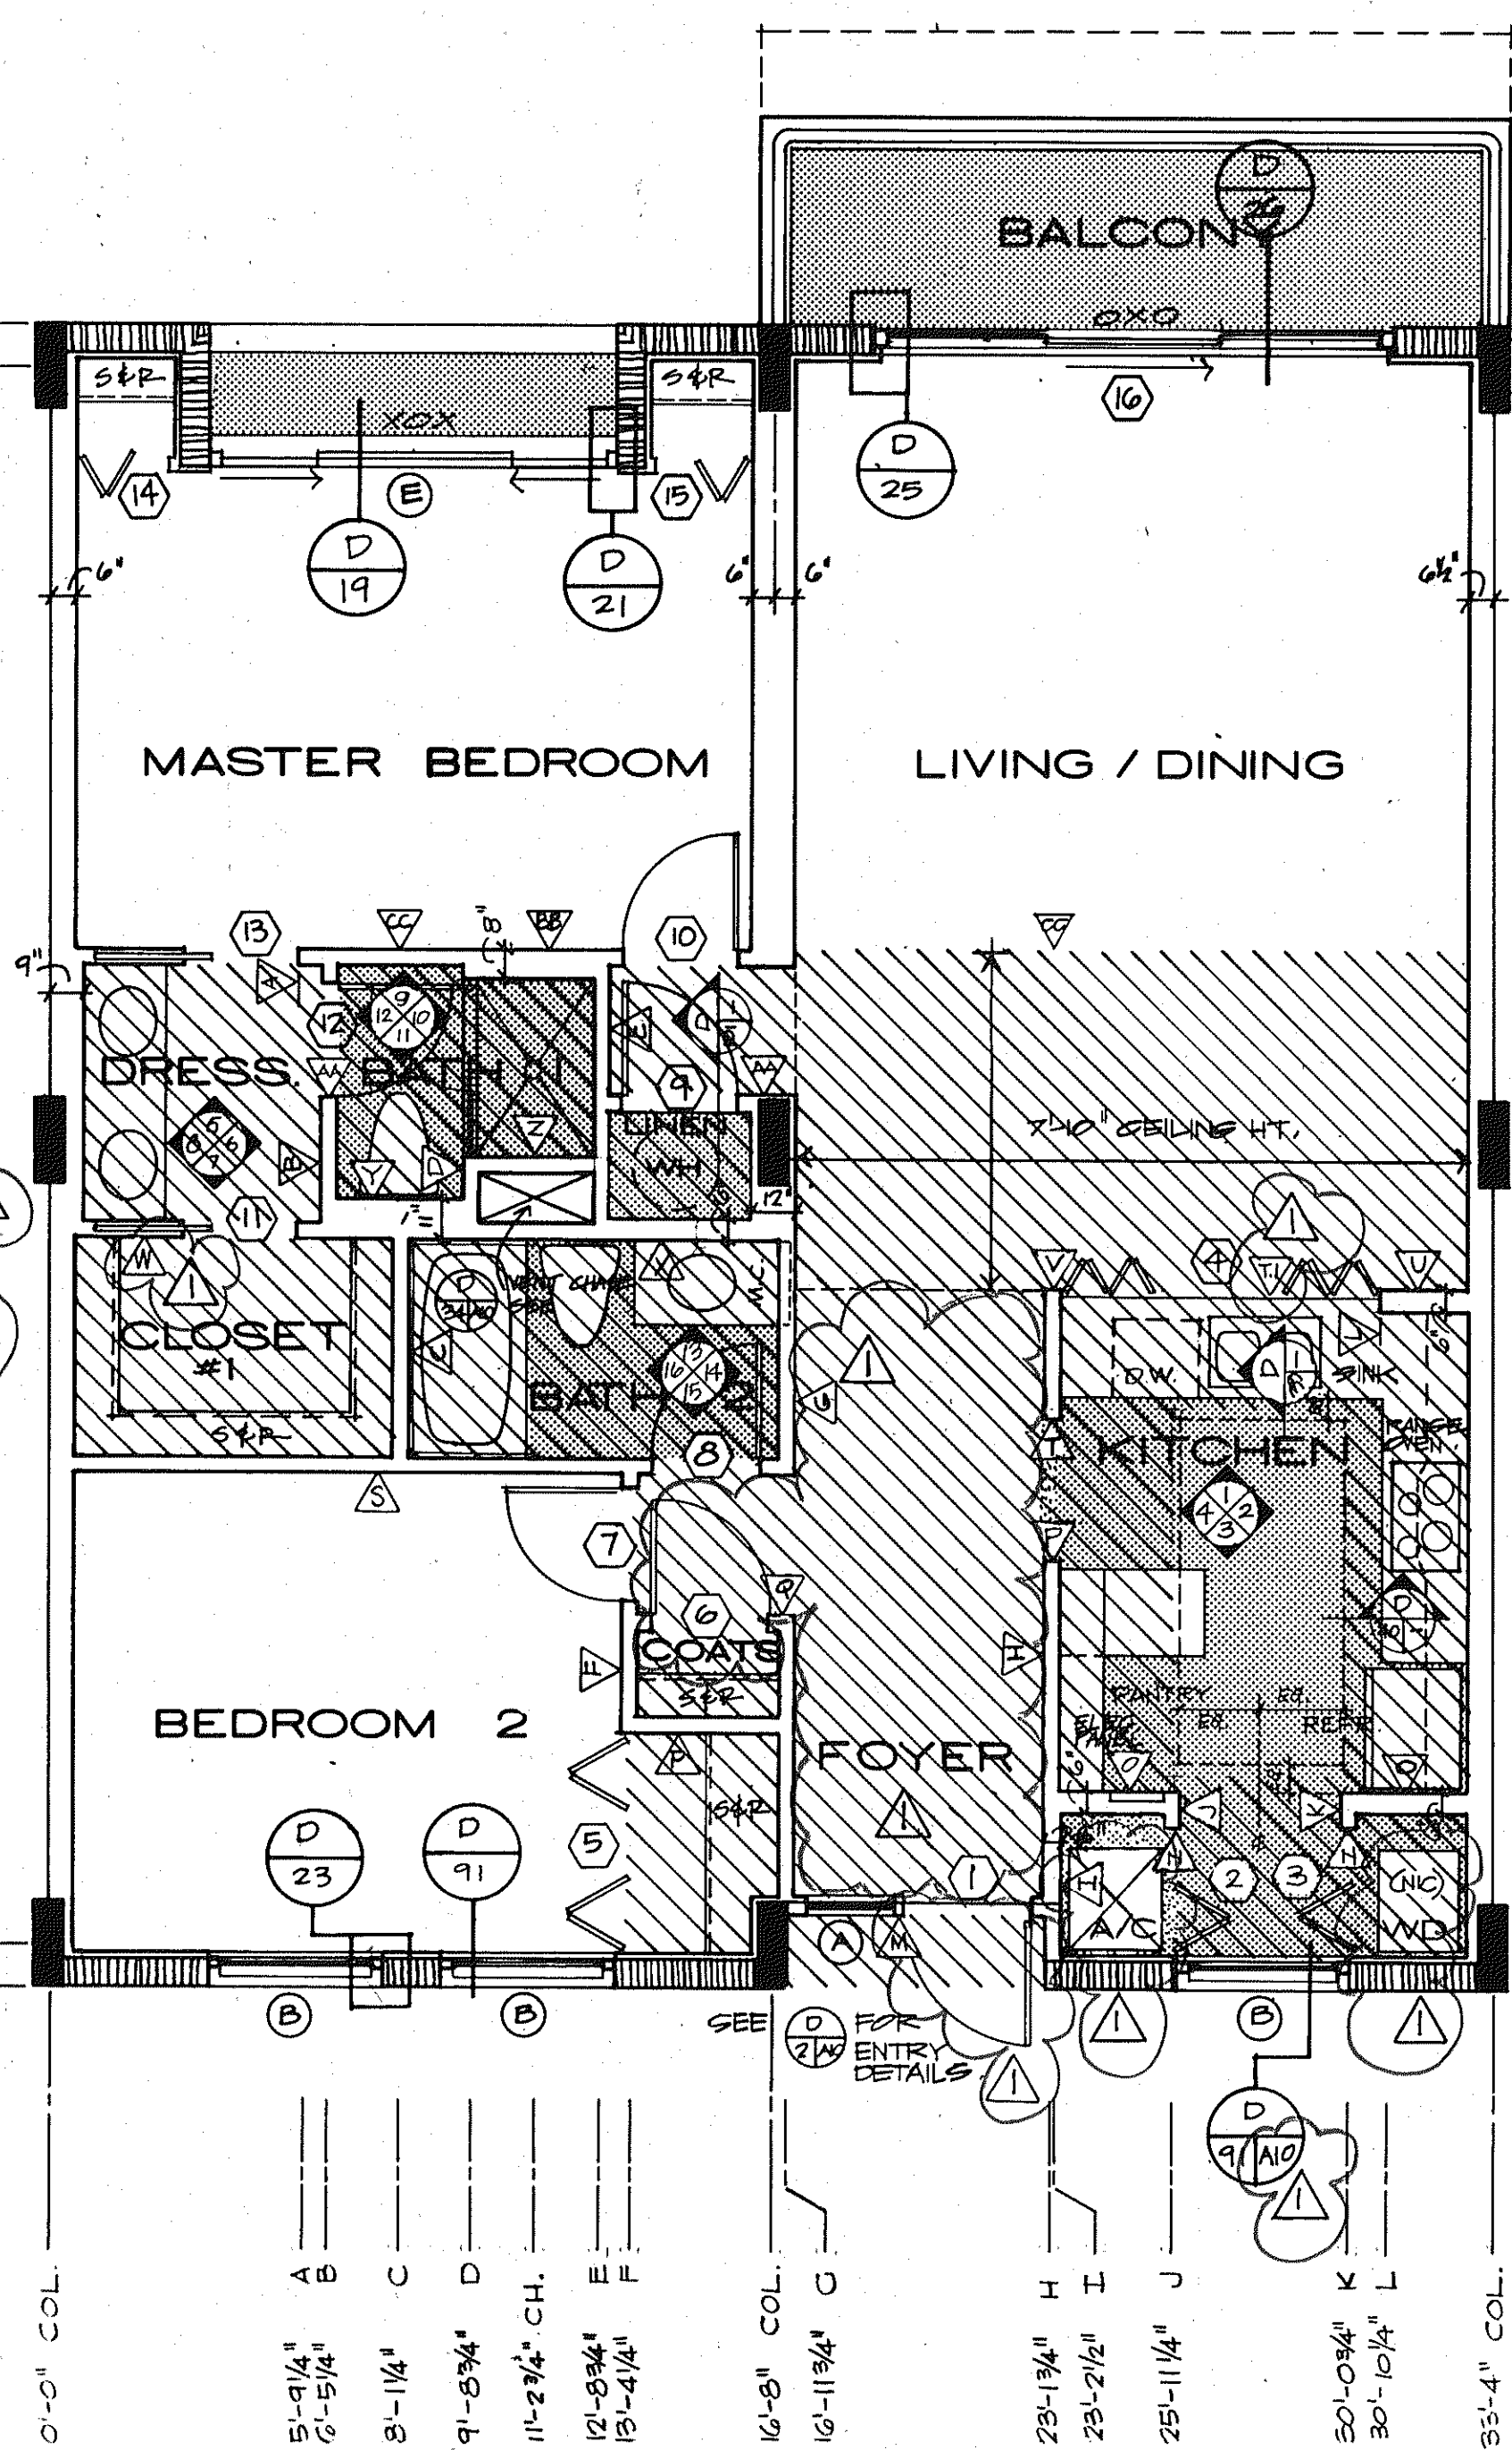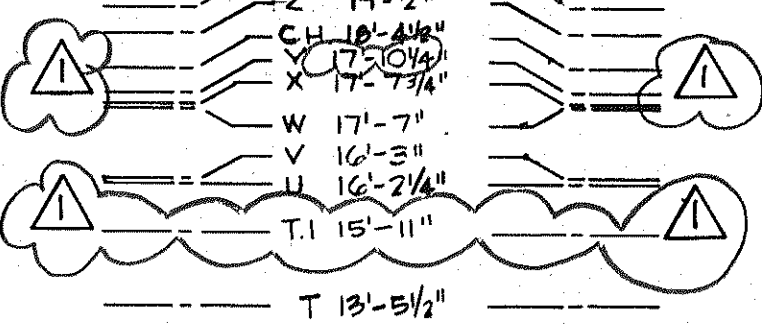

UNIT A RIGHT

SEE DETAILS AND MILLWORK SHOP DRINGS FOR SIZE & LOCATION OF KITCHEN CEILING LIGHTING.

D 38

- NOTES
- SEE 1/8" BLDG. PLANS FOR COL. & SHEAR WALL LOCATIONS.
 - ALL PROPOSED CEILINGS ARE 7'-0" UNLESS OTHERWISE NOTED.
 - ALL DIMENSIONS ARE FROM CENTERLINE OF WALL.
 - SEE DETAIL BOOKLET FOR FLOOR, WINDOW & FINISH SCHEDULES.
 - SCREEN DOT TEXTURE DENOTES PAVERS, CER. TILE, VINYL TILE & VAT. SEE FINISH SCHEDULES FOR EXACT LOCATIONS.
 - VERIFY EXACT LOCATION OF LAVATORIES W/ ARCHITECT.
 - SEE SHEET A-9 FOR PLAN DIMENSIONING KEY.

ISSUED	10 DEC. 82
REVISED	4-1-83
SHEET	A-10
	OF 37

SUNSET BEACH
 SOF LONG BOAT KEY
 UNIT A PLANS 1/4" = 1'-0"
 ARVIDA CORPORATION · EDWARD J. SEIBERT AIA ARCHITECT & PLANNER P.A. · THE SWA GROUP
 BRABHAM KUHN DEBAY CONSULTING ENGINEERS · OLSEN WHITE & ASSOCIATES STRUCTURAL ENGINEERS · BENNETT & BISHOP INC CONSULTING ENGINEERS & SURVEYORS