


NOTE:
BALCONY DEPTHS DIFFER FROM THIS DRAWING ON 4TH FLOOR. SEE 1/8" BLDG PLANS. END WALLS OCCUR ON 4TH FLOOR BALCONY. SEE 1/8" BLDG PLANS.

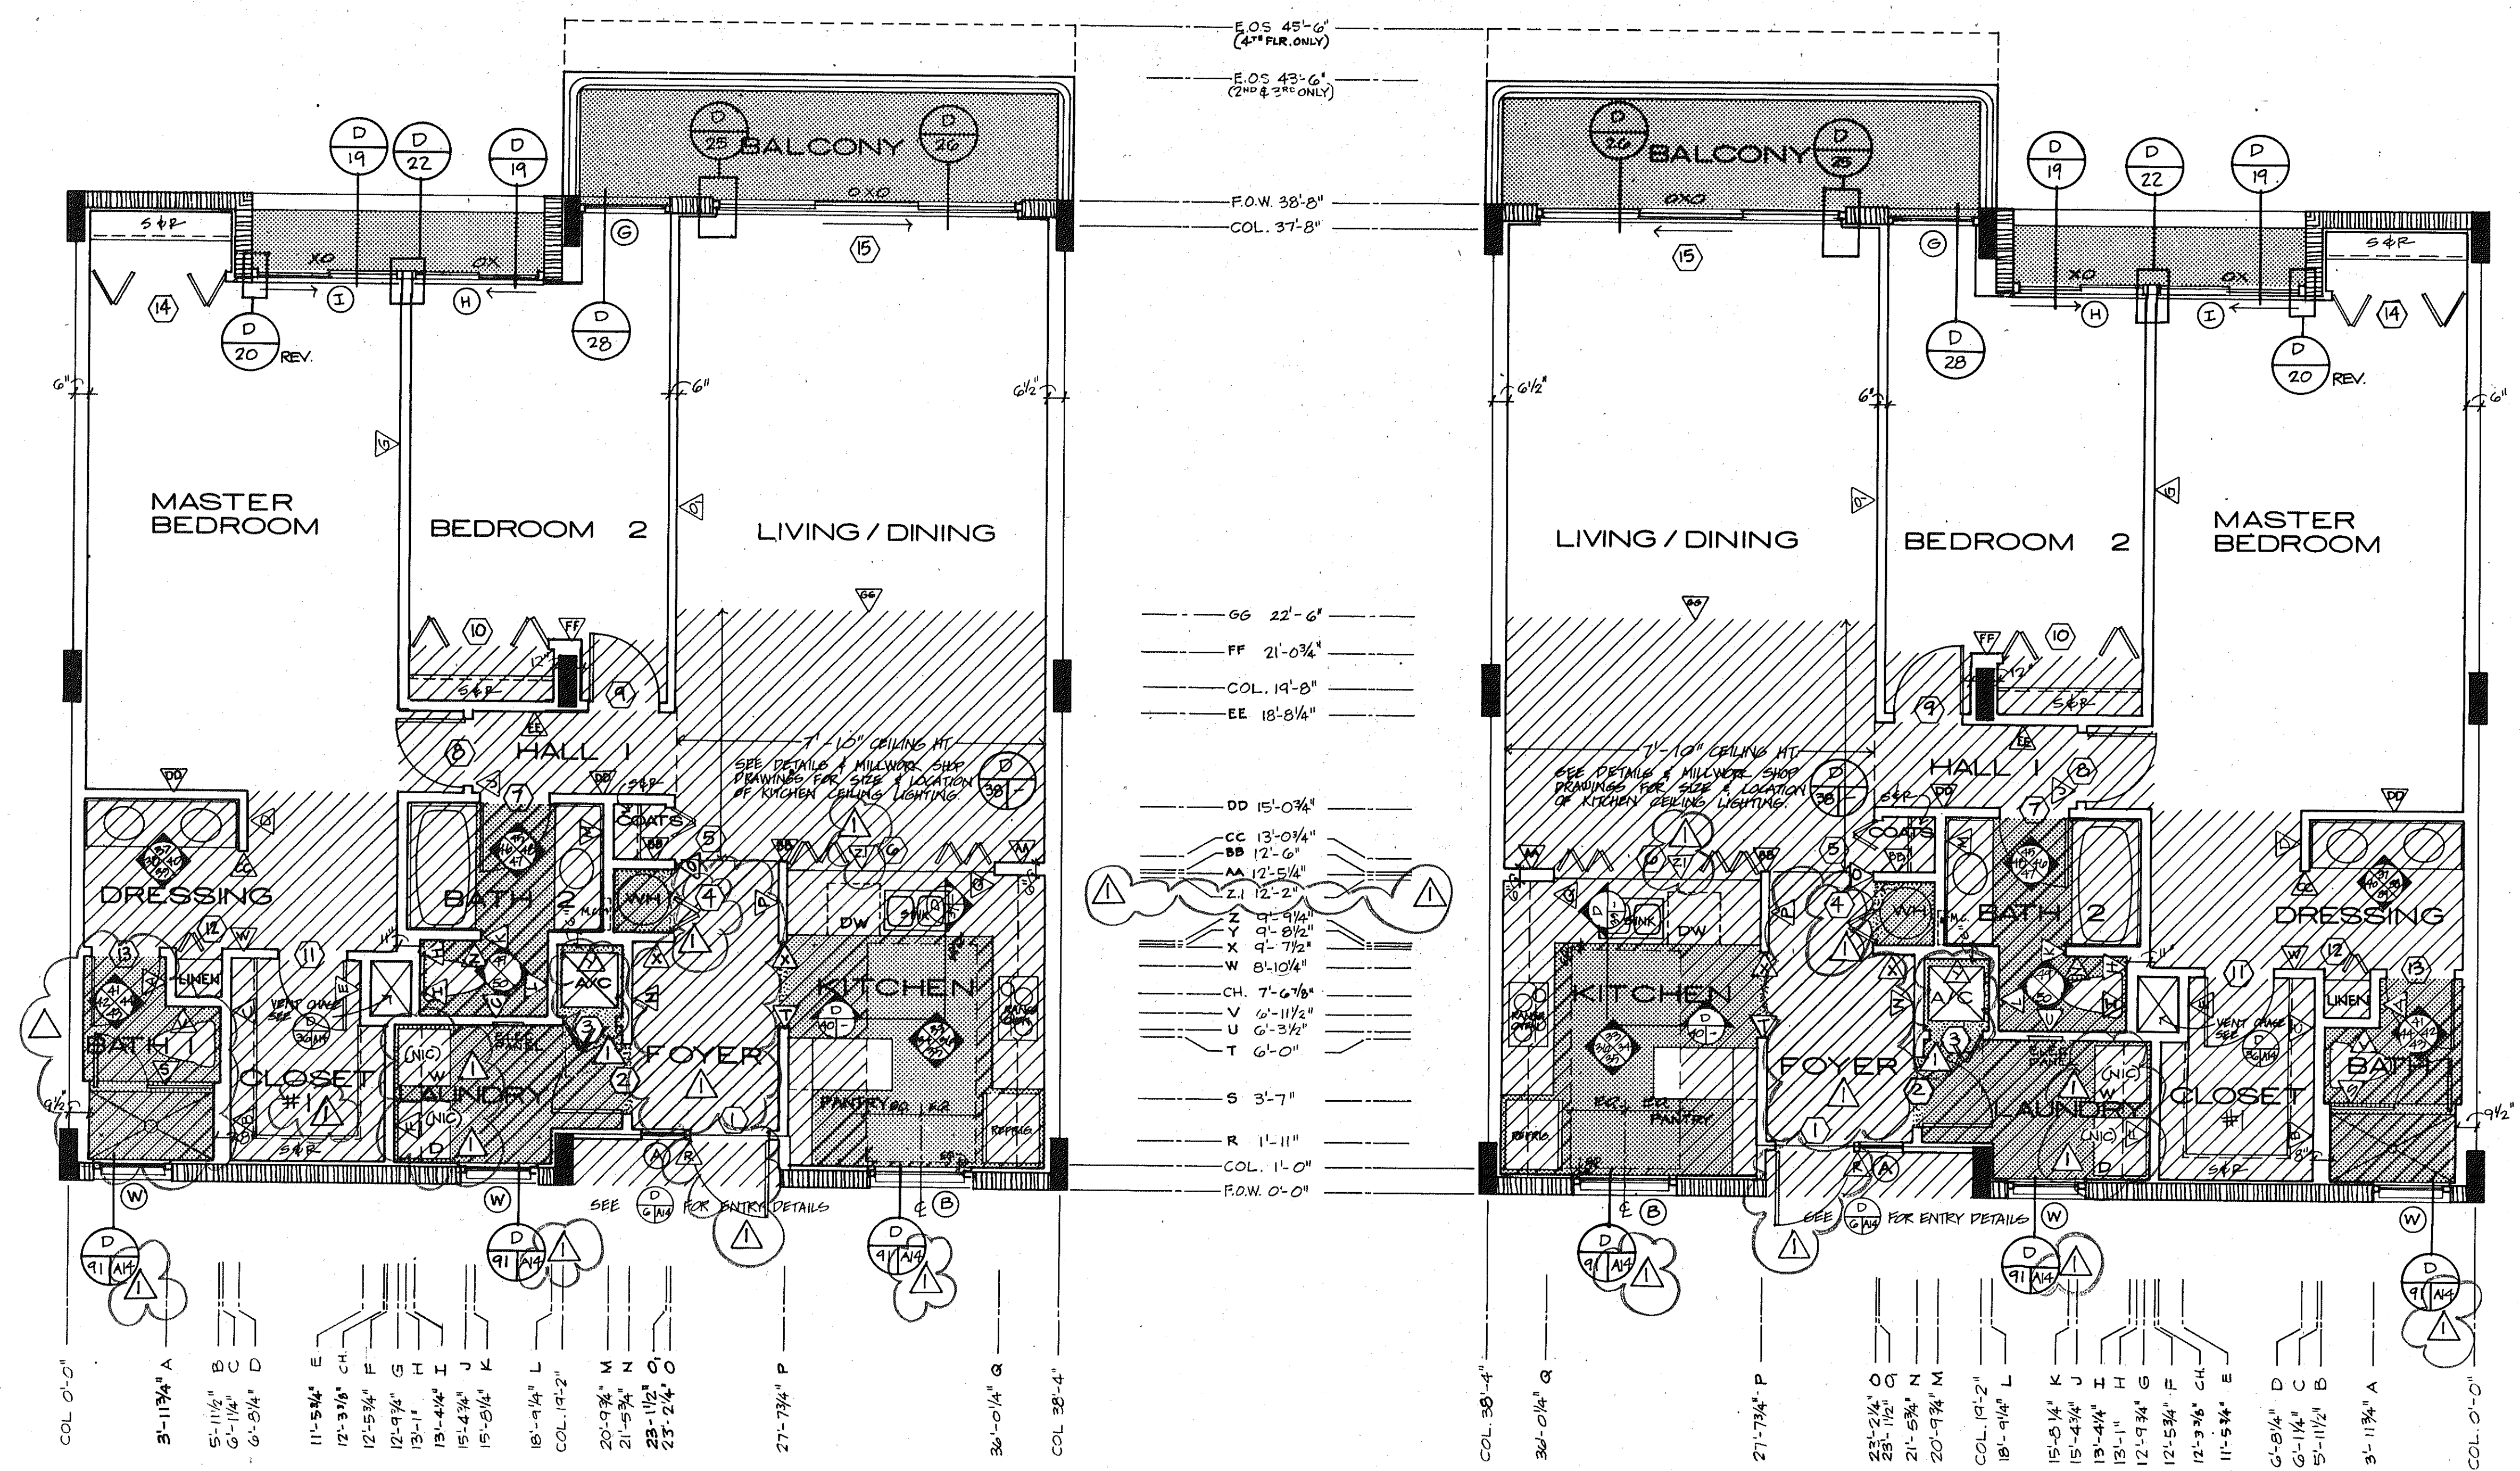

UNIT C LEFT

UNIT C RIGHT

- NOTES:
- SEE 1/8" BLDG PLANS FOR COL. & SHEAR WALL LOCATIONS.
 - ALL DROPPED CEILINGS ARE 7'-0" UNLESS OTHERWISE NOTED.
 - ALL DIMENSIONS ARE FROM CENTERLINE OF WALL.
 - SEE DETAIL BOOKLET FOR DOOR, WINDOW, & FINISH SCHEDULES.
 - SCREEN DOT TEXTURE DENOTES PAVERS, CER. TILE, VINYL TILE OR VAT. SEE FINISH SCHEDULES FOR EXACT LOCATIONS.
 - VERIFY EXACT LOCATION OF LAVS. W/ ARCHITECT.
 - DASHED LINE ABOVE THE WASHER/DRYER IS A CONTINUOUS UPPER CABINET W/ DOORS. CONSTRUCTION IS TO BE PER KITCHEN UPPER CABINETS EXCEPT DELETE ALL WOOD TRIM. PULLS TO BE RECESSED OAK.
 - SEE SHEET A-1 FOR PLAN DIMENSIONING KEY.