


UNIT 'A' LEFT AIR CONDITIONING

DATE 1/20/87

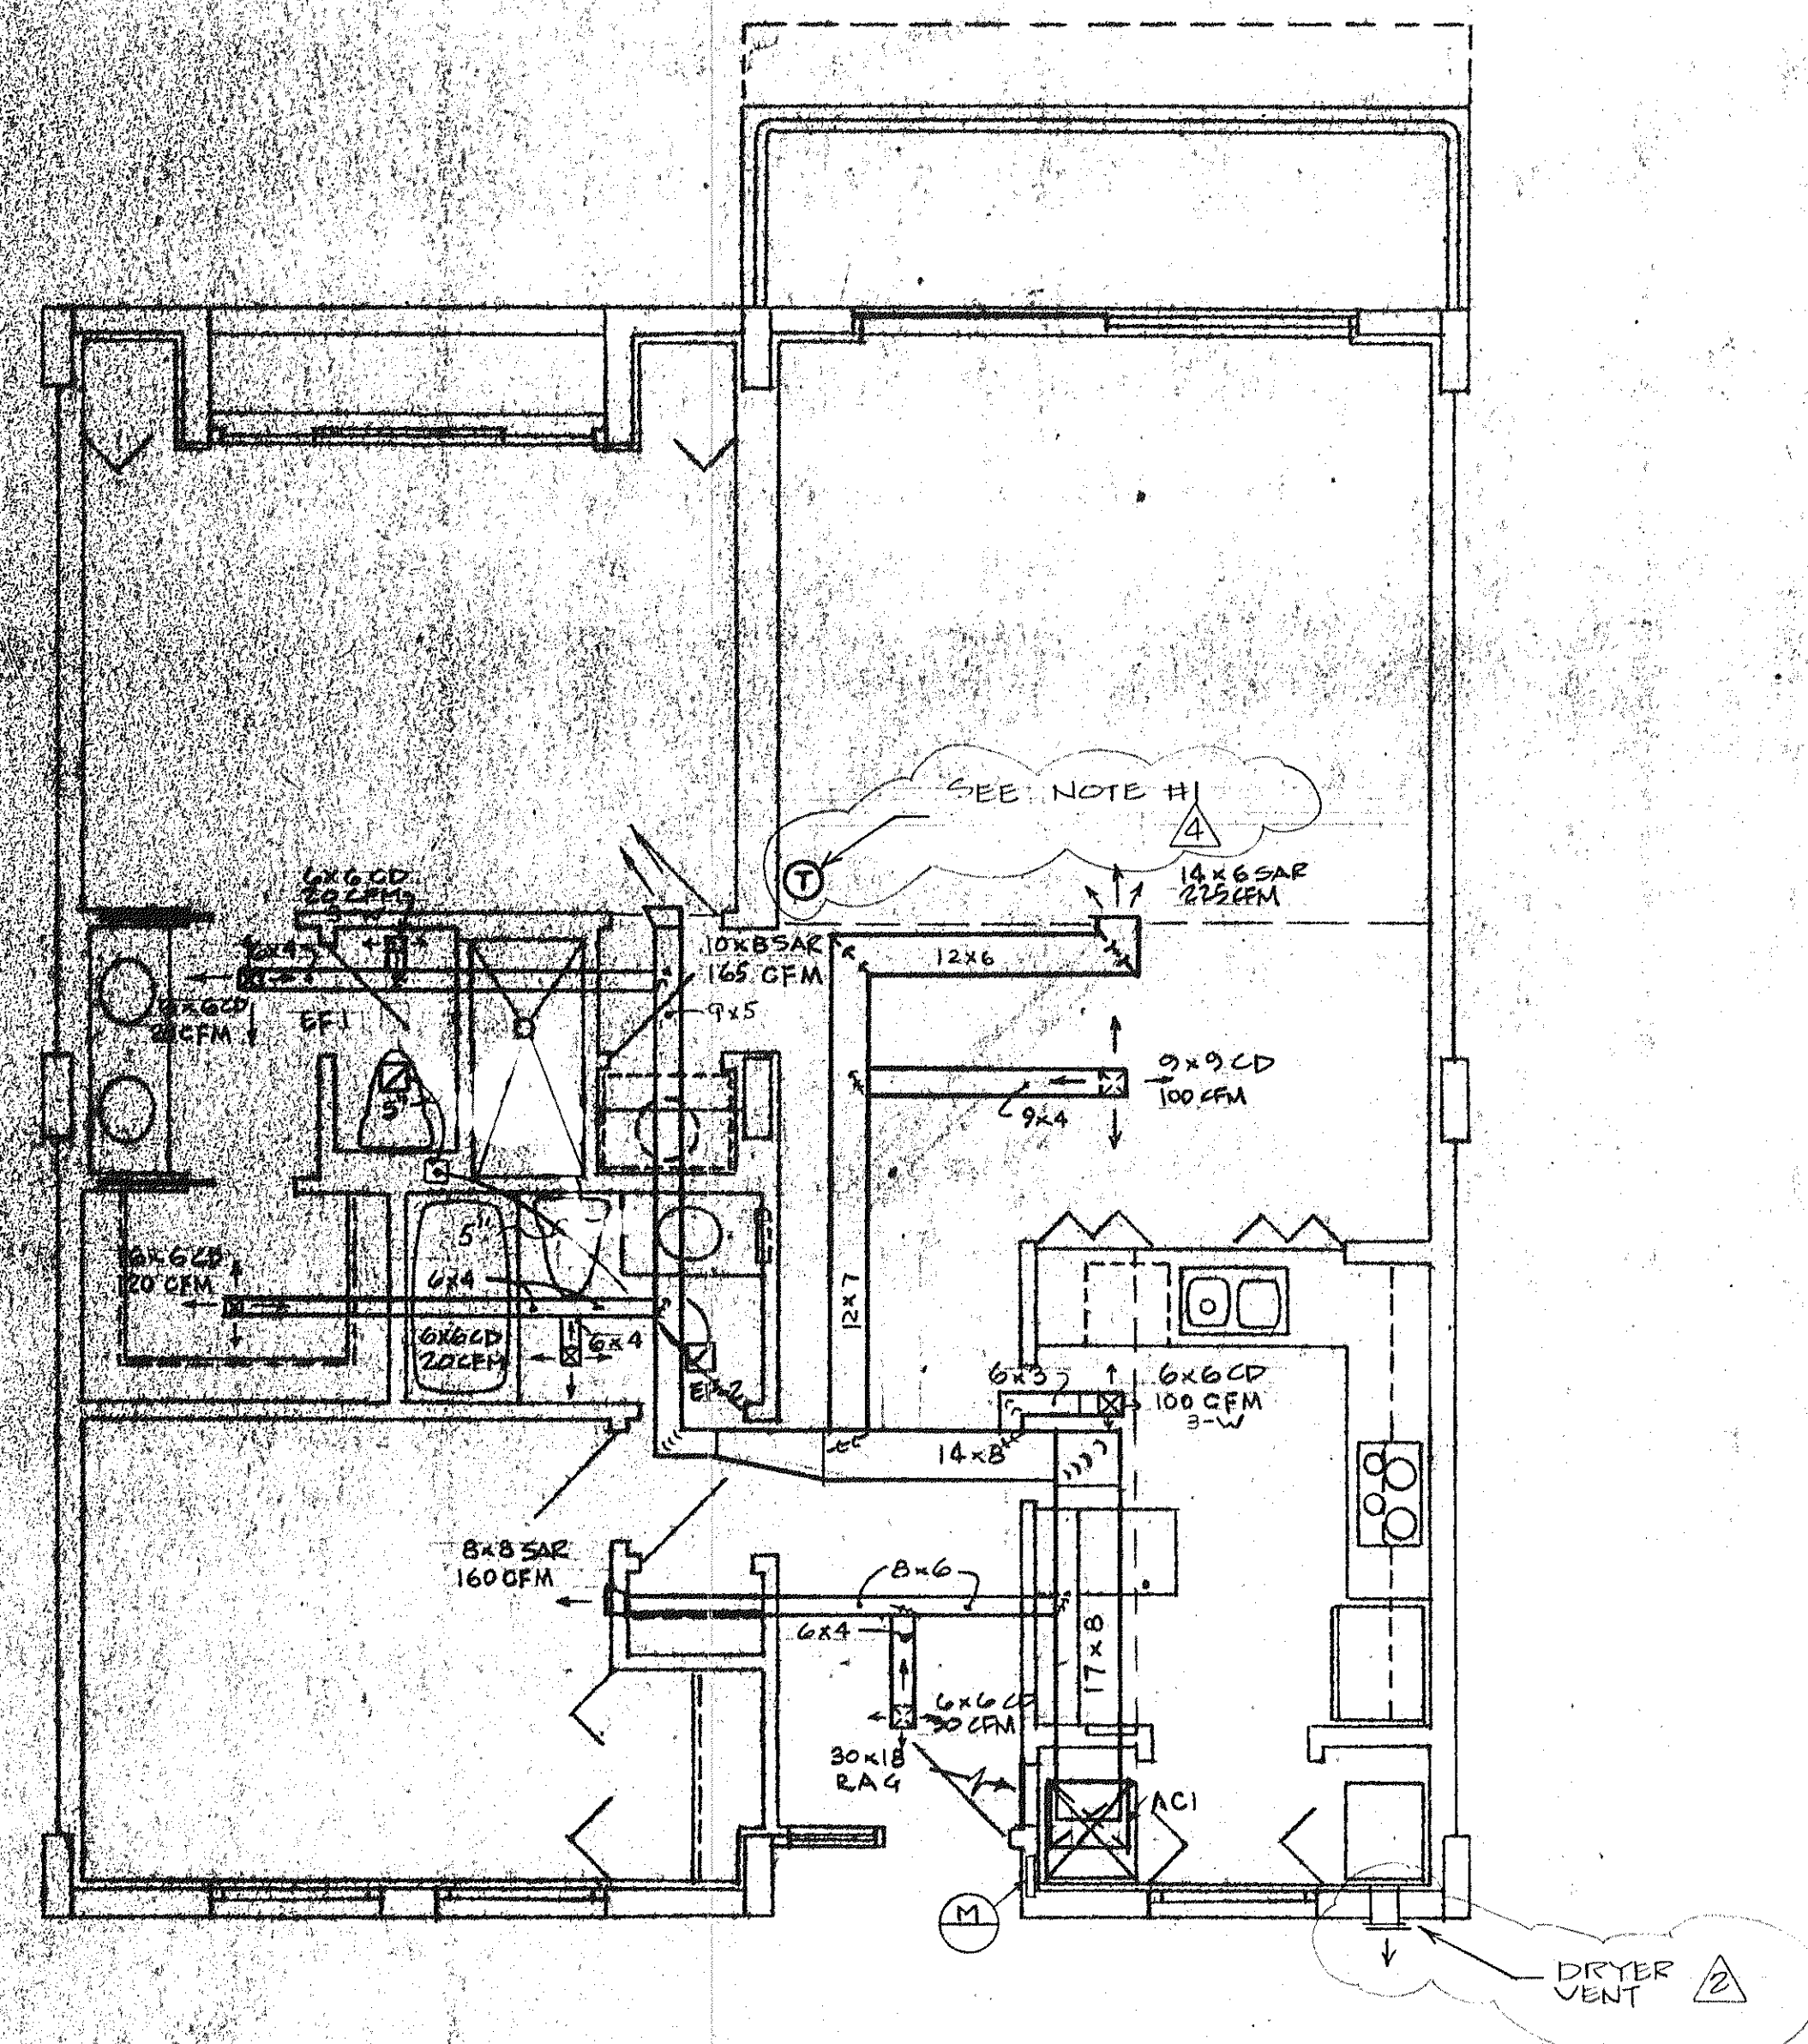

NOTE #1: ALL THERMOSTATS ARE TO BE MOUNTED 48" ABOVE FIN FLOOR

UNIT 'A' RIGHT AIR CONDITIONING

ISSUED
REVISED
DRYER VENT
7-20-85
4/22/87
EDS 115