


**UNIT 'D' LEFT - AIR CONDITIONING**

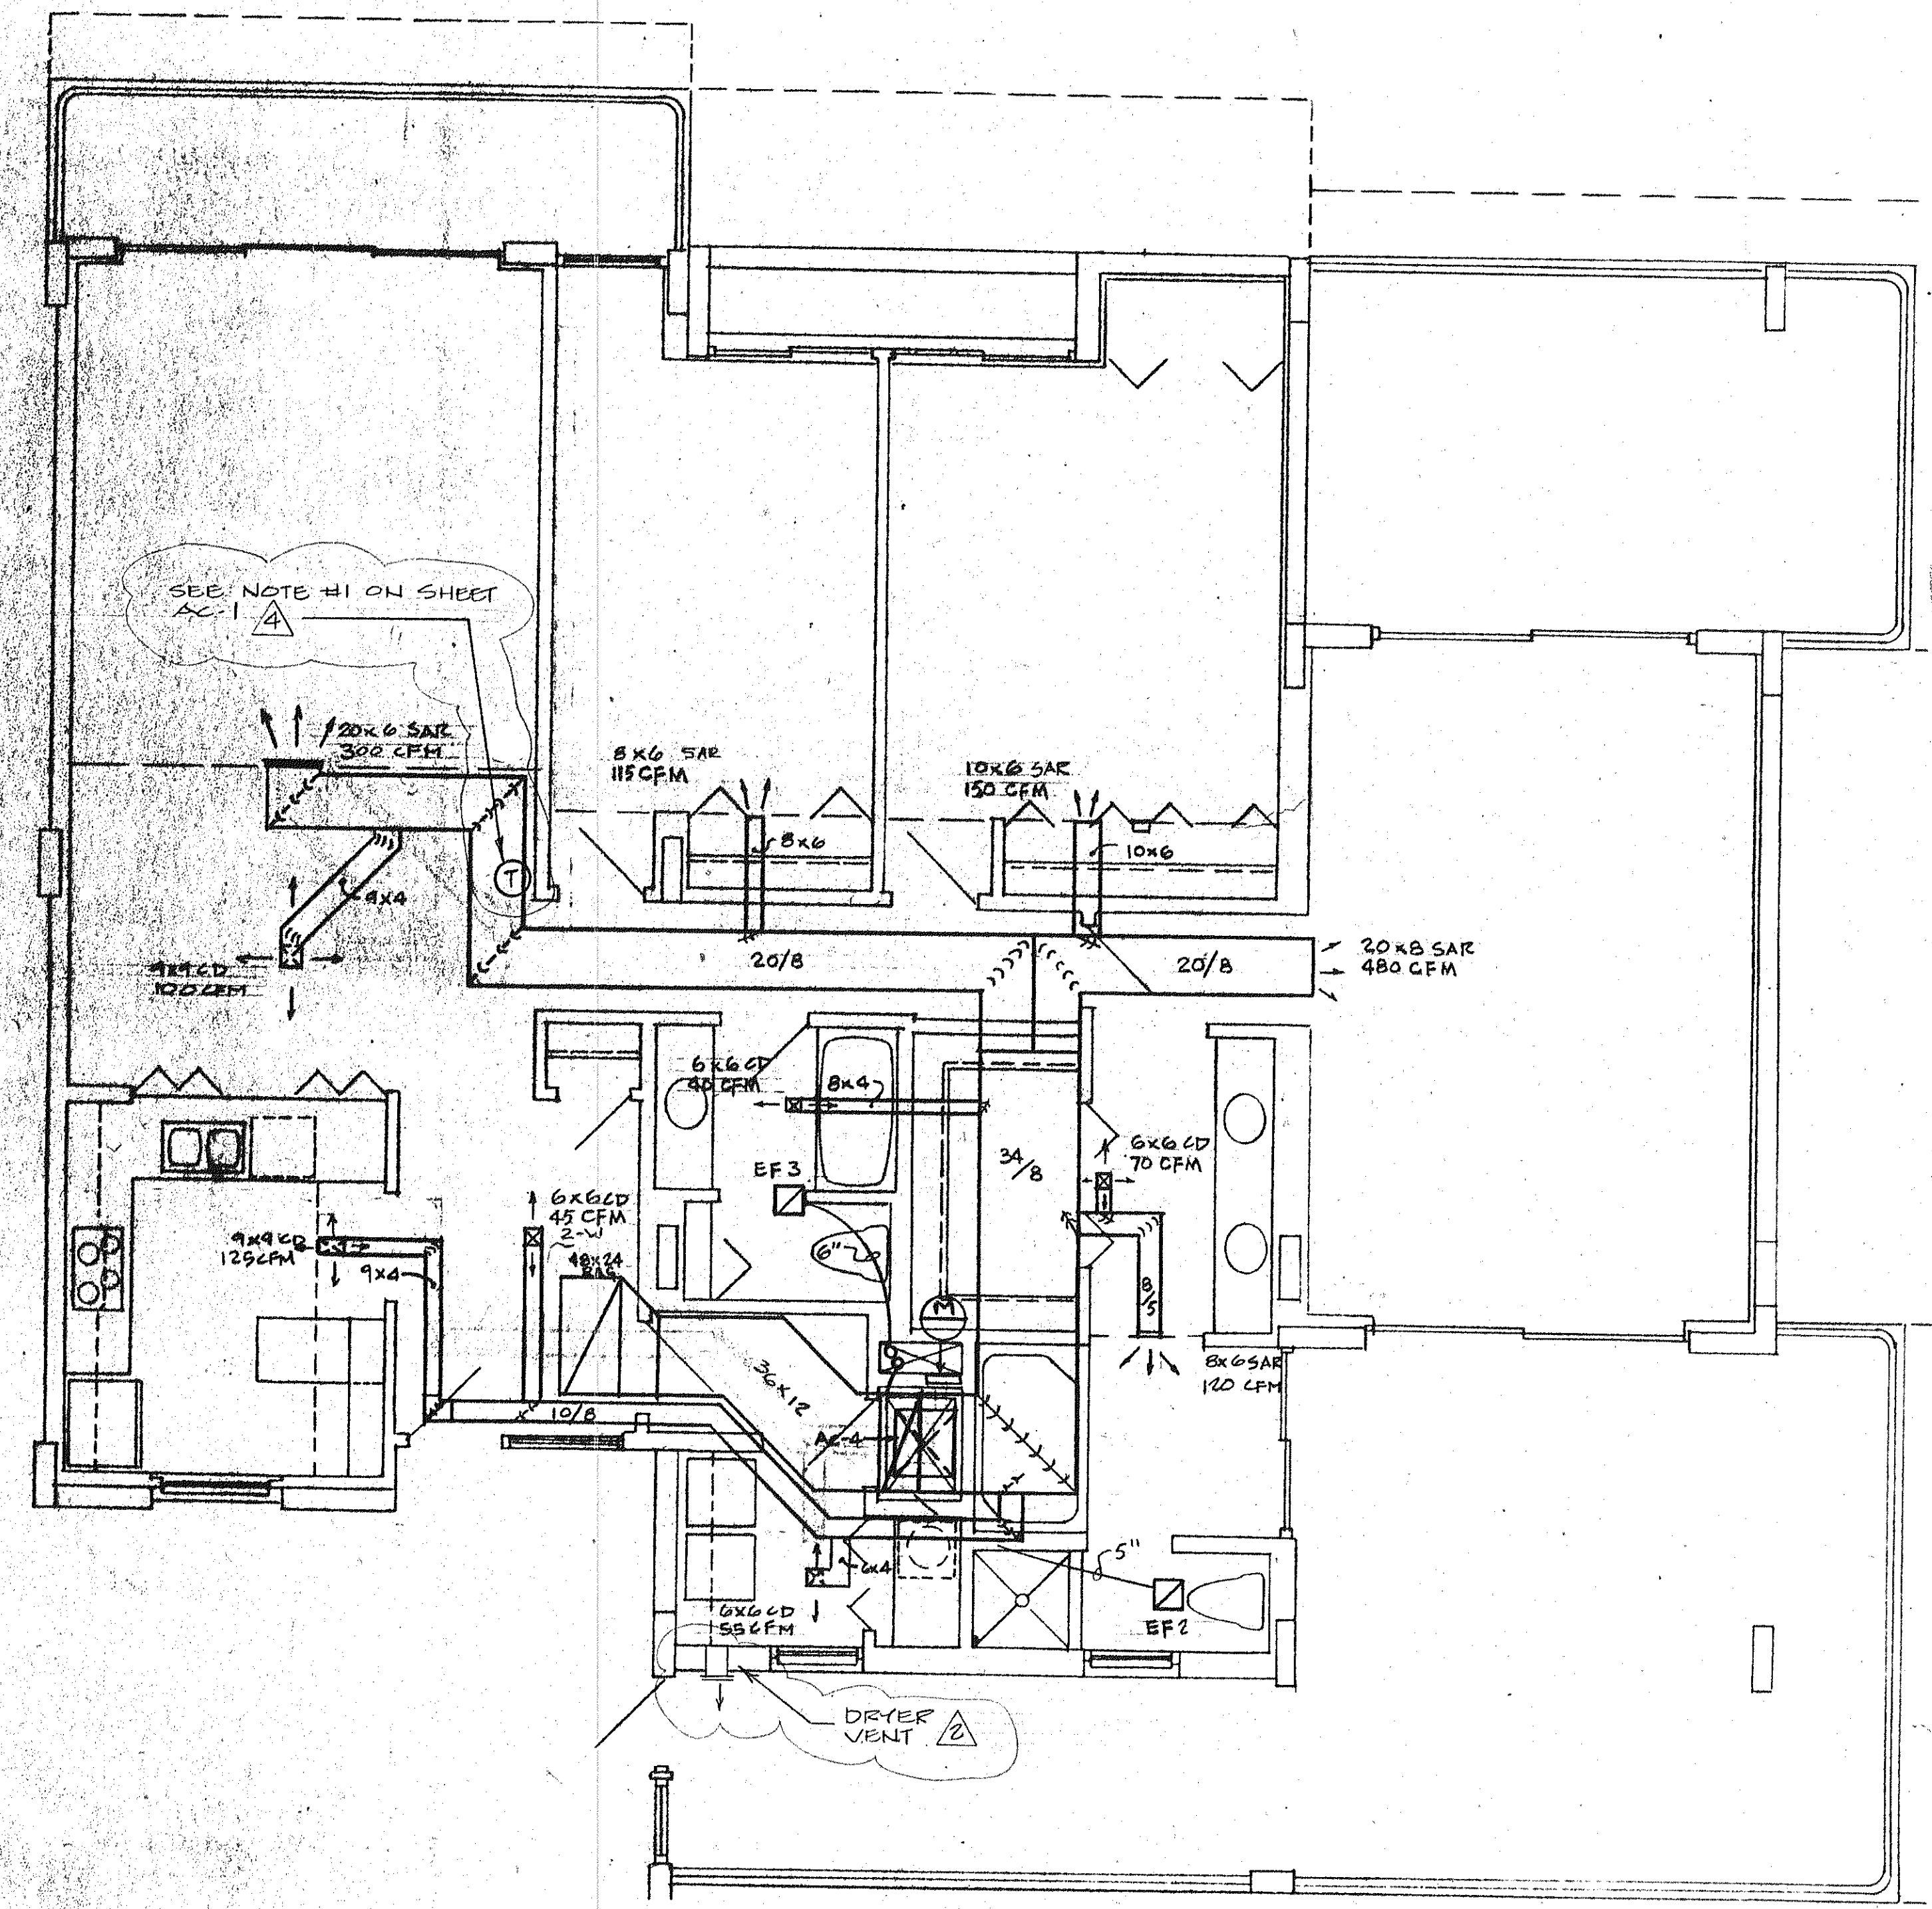

**UNIT 'D' RIGHT - AIR CONDITIONING**

ISSUED	4-1-83
REVISED	2-15-83 (REVANT)
	7-20-73
	4-25-81 (REV)
	8-15-72 (REV)
SHEET	
<b>AC-6</b>	
BLDG. 3	