


**UNIT 'A' - LEFT - AIR CONDITIONING**  
 scale 1/8" = 1'-0"

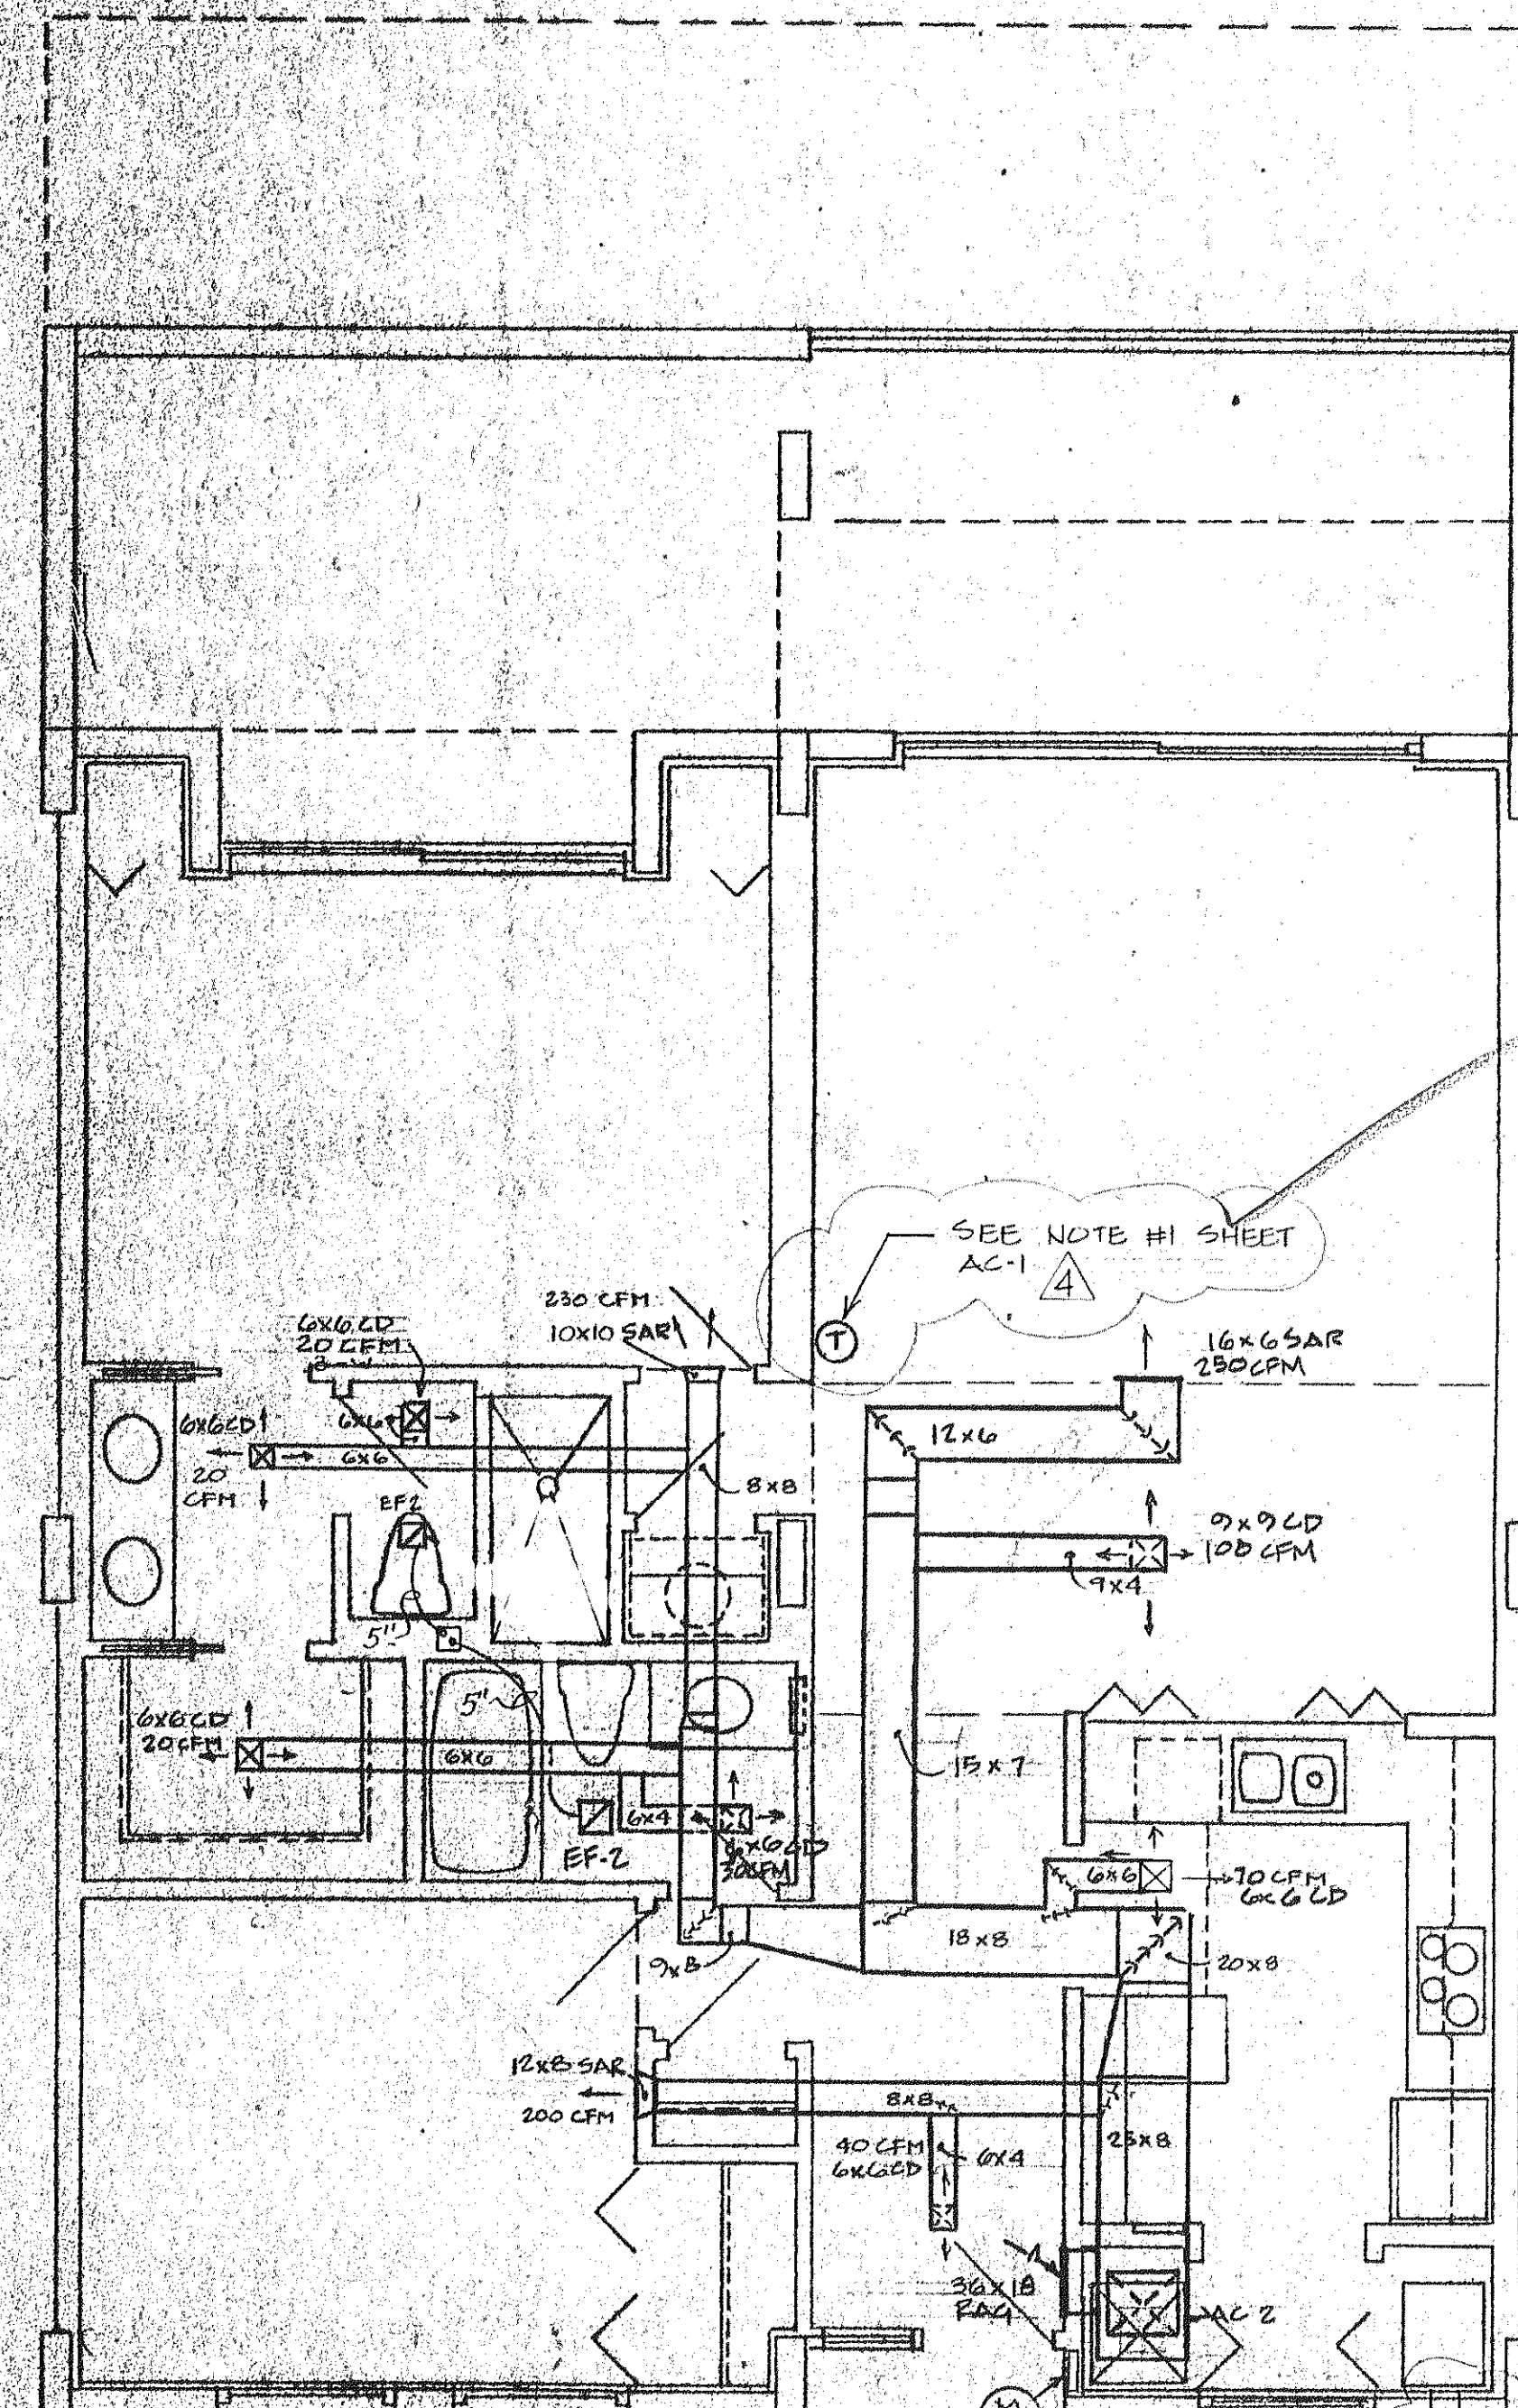

**UNIT 'A' - RIGHT - AIR CONDITIONING**

ISSUED	2-1-83
REVISION	DRYER VENT
DATE	7-20-83
DESIGNED BY	RTW
CHECKED BY	
APPROVED BY	
SHEET	
<b>AC-2</b>	
BLDG. 3	