


VERTICAL COMPOUND

23
24
25
26
27


FOR WALL OFFSET DIMENSION SEE FIRST FLOOR PLAN, 1/8" BLDG. PLANS & DETAIL

PIPE RAIL

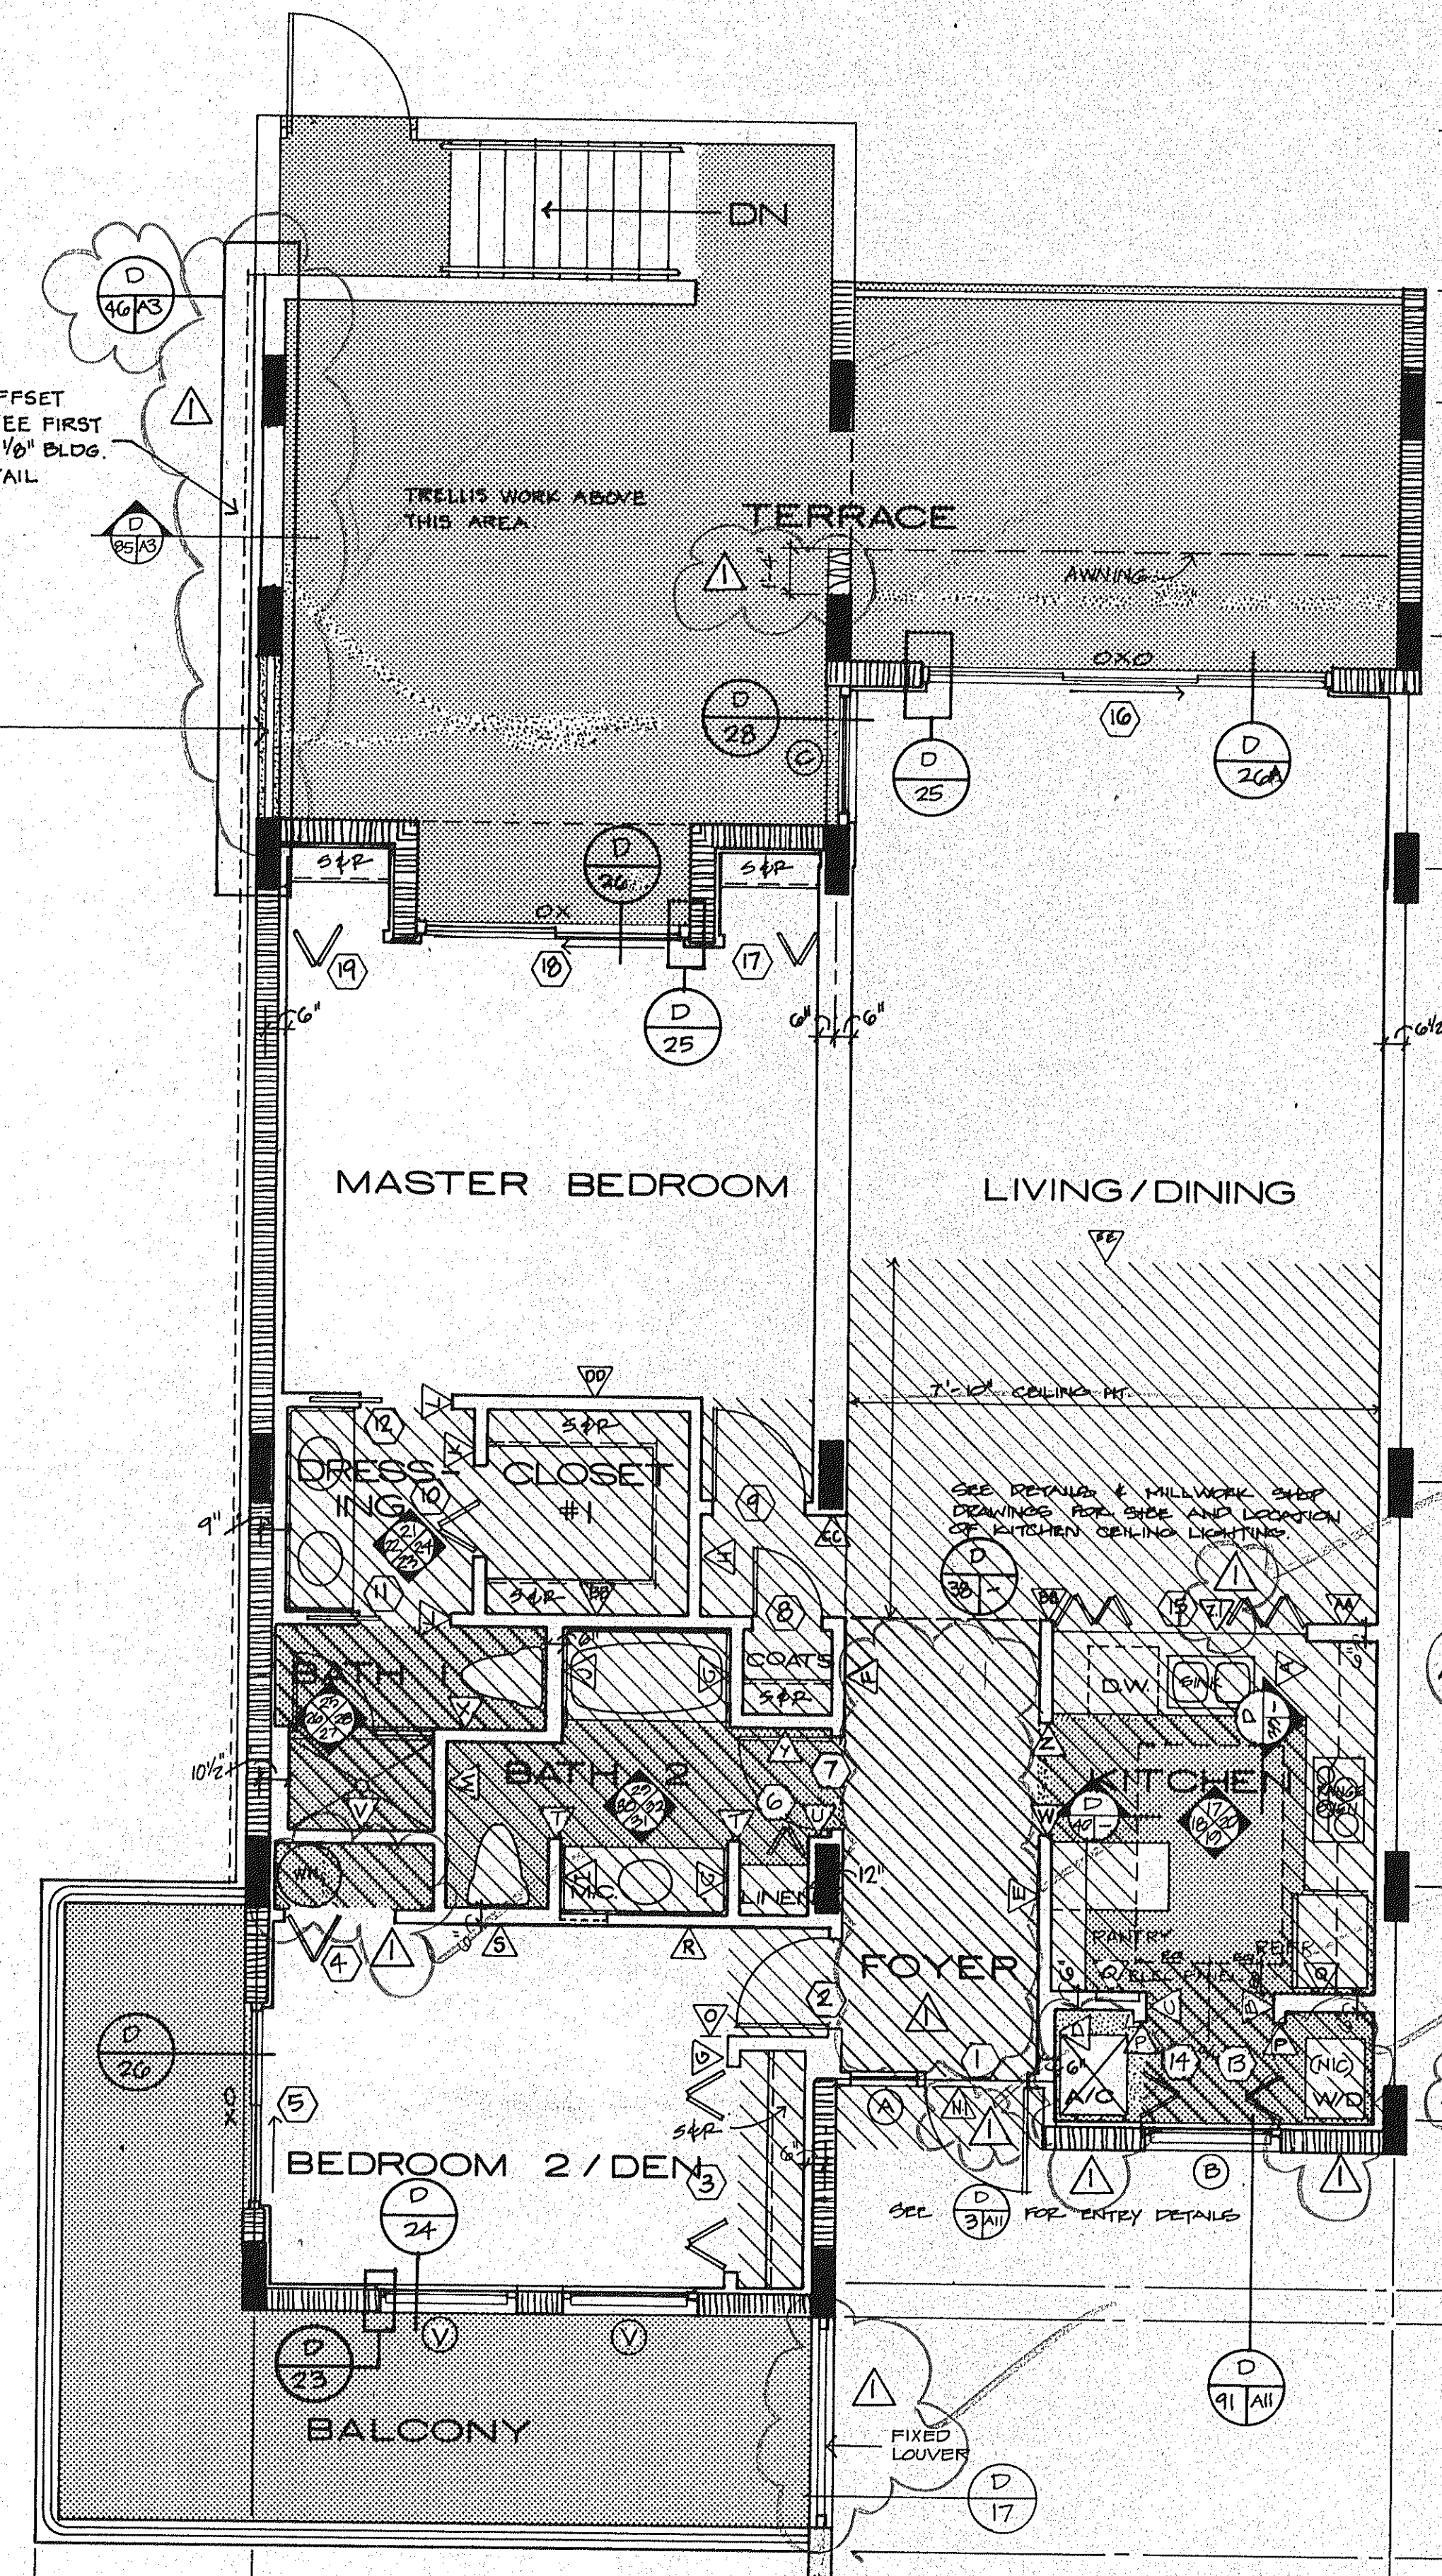


- 39'-5" E.O.S. 4" x 8" FLOOR ONLY
- 33'-4" COL.
- DELETE N
- DELETE CH
- 28'-1 1/2" M
- 27'-6 3/4" L
- 20'-6 3/4" X
- 24'-8 1/2" J
- 24'-7 3/4" I
- 20'-7 1/2" H
- 19'-4 1/4" G
- 16'-8" COL.
- 16'-4 1/4" F
- 10'-2 1/4" E
- 10'-1 1/2" D
- 7'-4 3/4" C
- 2'-5 3/4" B
- 2'-5 3/4" A
- 0'-0" COL.

UNIT B+ LEFT

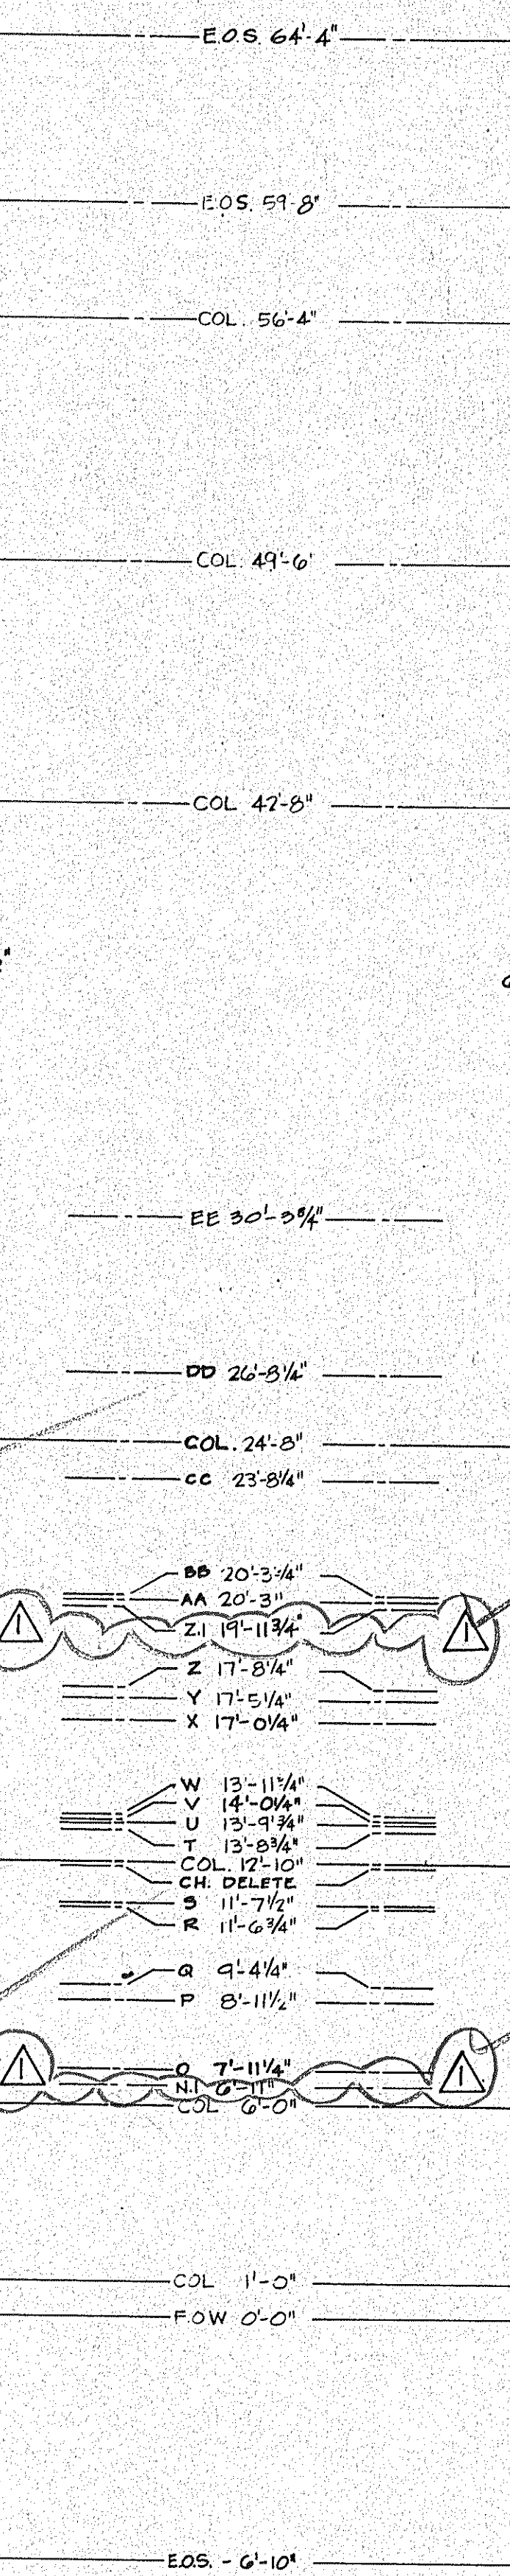

- 0'-0" COL.
- 2'-5 3/4" A
- 2'-5 3/4" B
- 7'-4 3/4" C
- 10'-1 1/2" D
- 10'-2 1/4" E
- 16'-4 1/4" F
- 16'-8" COL.
- 19'-4 1/4" G
- 20'-7 1/4" H
- 24'-7 3/4" I
- 24'-8 1/2" J
- 26'-6 3/4" K
- 27'-6 3/4" L
- 23'-11 1/2" M
- DELETE CH
- DELETE N
- 33'-4" COL.

UNIT B+ RIGHT

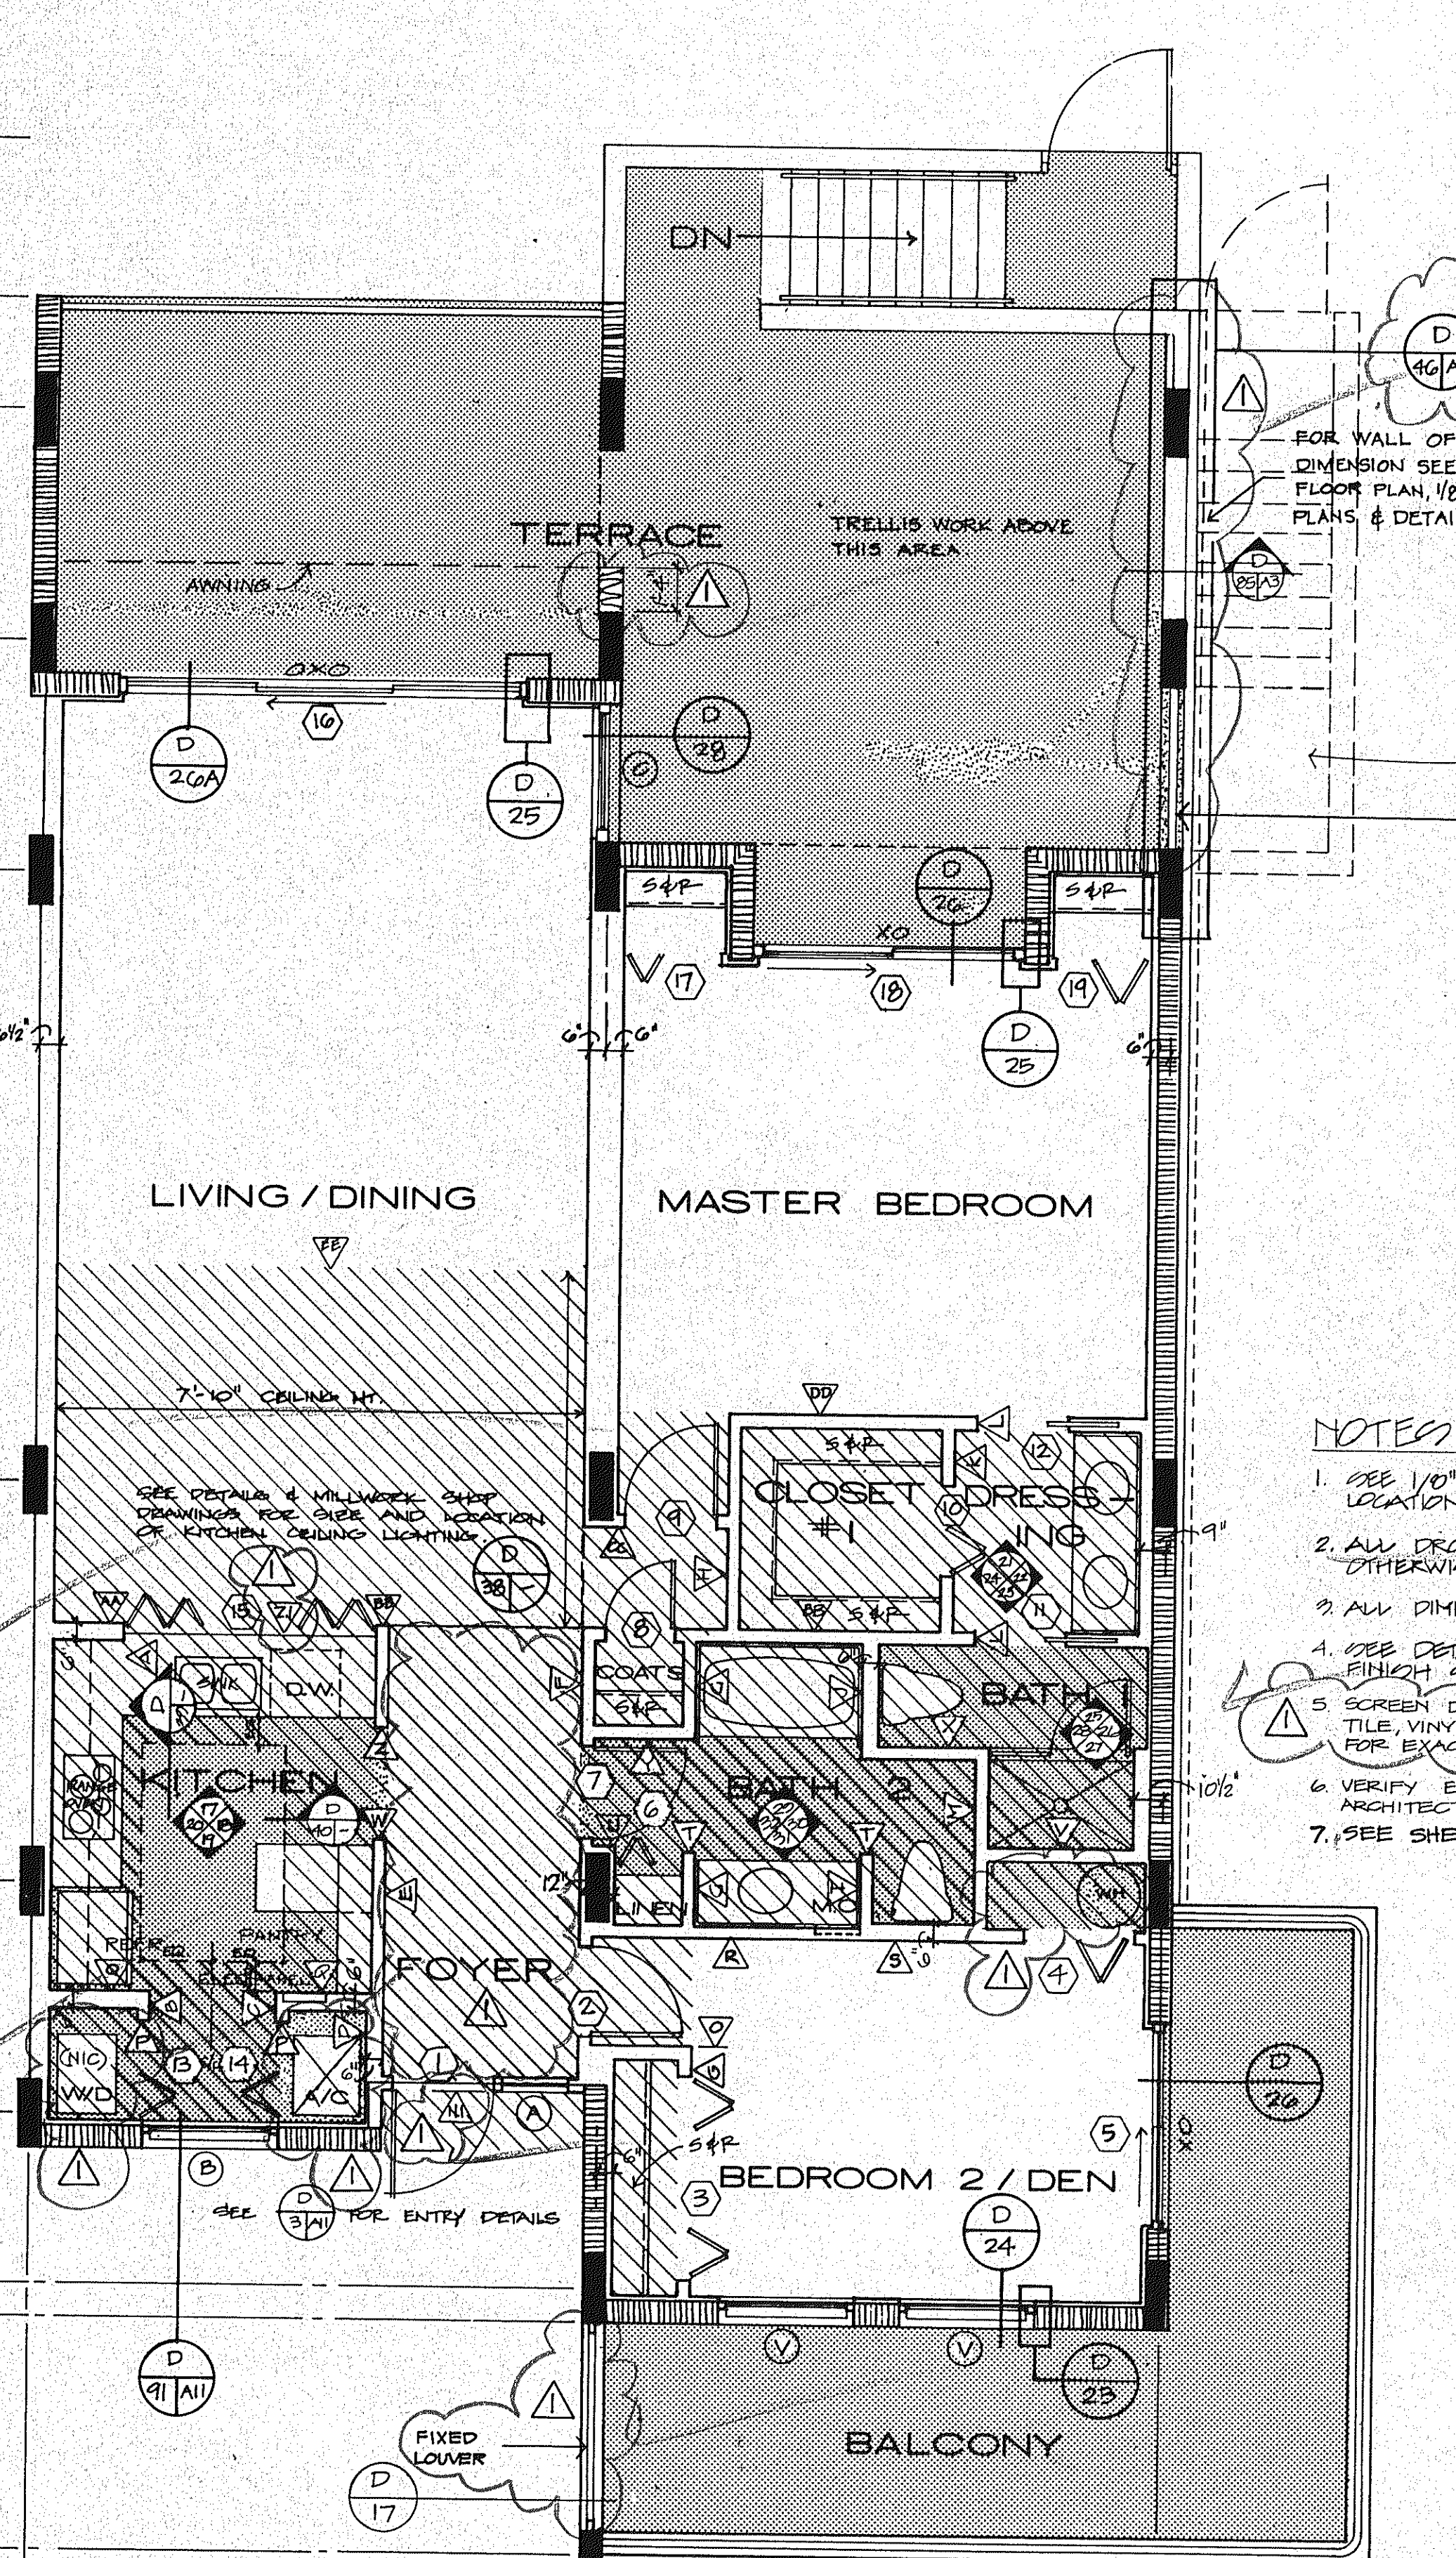

- 39'-5" E.O.S. 4" x 8" FLOOR ONLY
- 33'-4" COL.
- DELETE N
- DELETE CH
- 28'-1 1/2" M
- 27'-6 3/4" L
- 20'-6 3/4" X
- 24'-8 1/2" J
- 24'-7 3/4" I
- 20'-7 1/2" H
- 19'-4 1/4" G
- 16'-8" COL.
- 16'-4 1/4" F
- 10'-2 1/4" E
- 10'-1 1/2" D
- 7'-4 3/4" C
- 2'-5 3/4" B
- 2'-5 3/4" A
- 0'-0" COL.

NOTES

1. SEE 1/8" BLDG. PLANS FOR COL. & SHEAR WALL LOCATIONS.
2. ALL DROPPED CEILING ARE 7'-0" UNLESS OTHERWISE NOTED.
3. ALL DIMENSIONS ARE FROM CENTERLINE OF WALL.
4. SEE DETAIL BOULET FOR DOOR, WINDOW & FINISH SCHEDULES.
5. SCREEN DOT TEXTURE DENOTES PAVERS, CER TILE, VINYL TILE & VAT. SEE FINISH SCHEDULES FOR EXACT LOCATION.
6. VERIFY EXACT LOCATION OF LAVATORIES W/ ARCHITECT.
7. SEE SHEET A-7 FOR PLAN DIMENSIONING KEY.

39'-5" E.O.S. 4" x 8" FLOOR ONLY