



OVERLAYS  
COMPOSITE

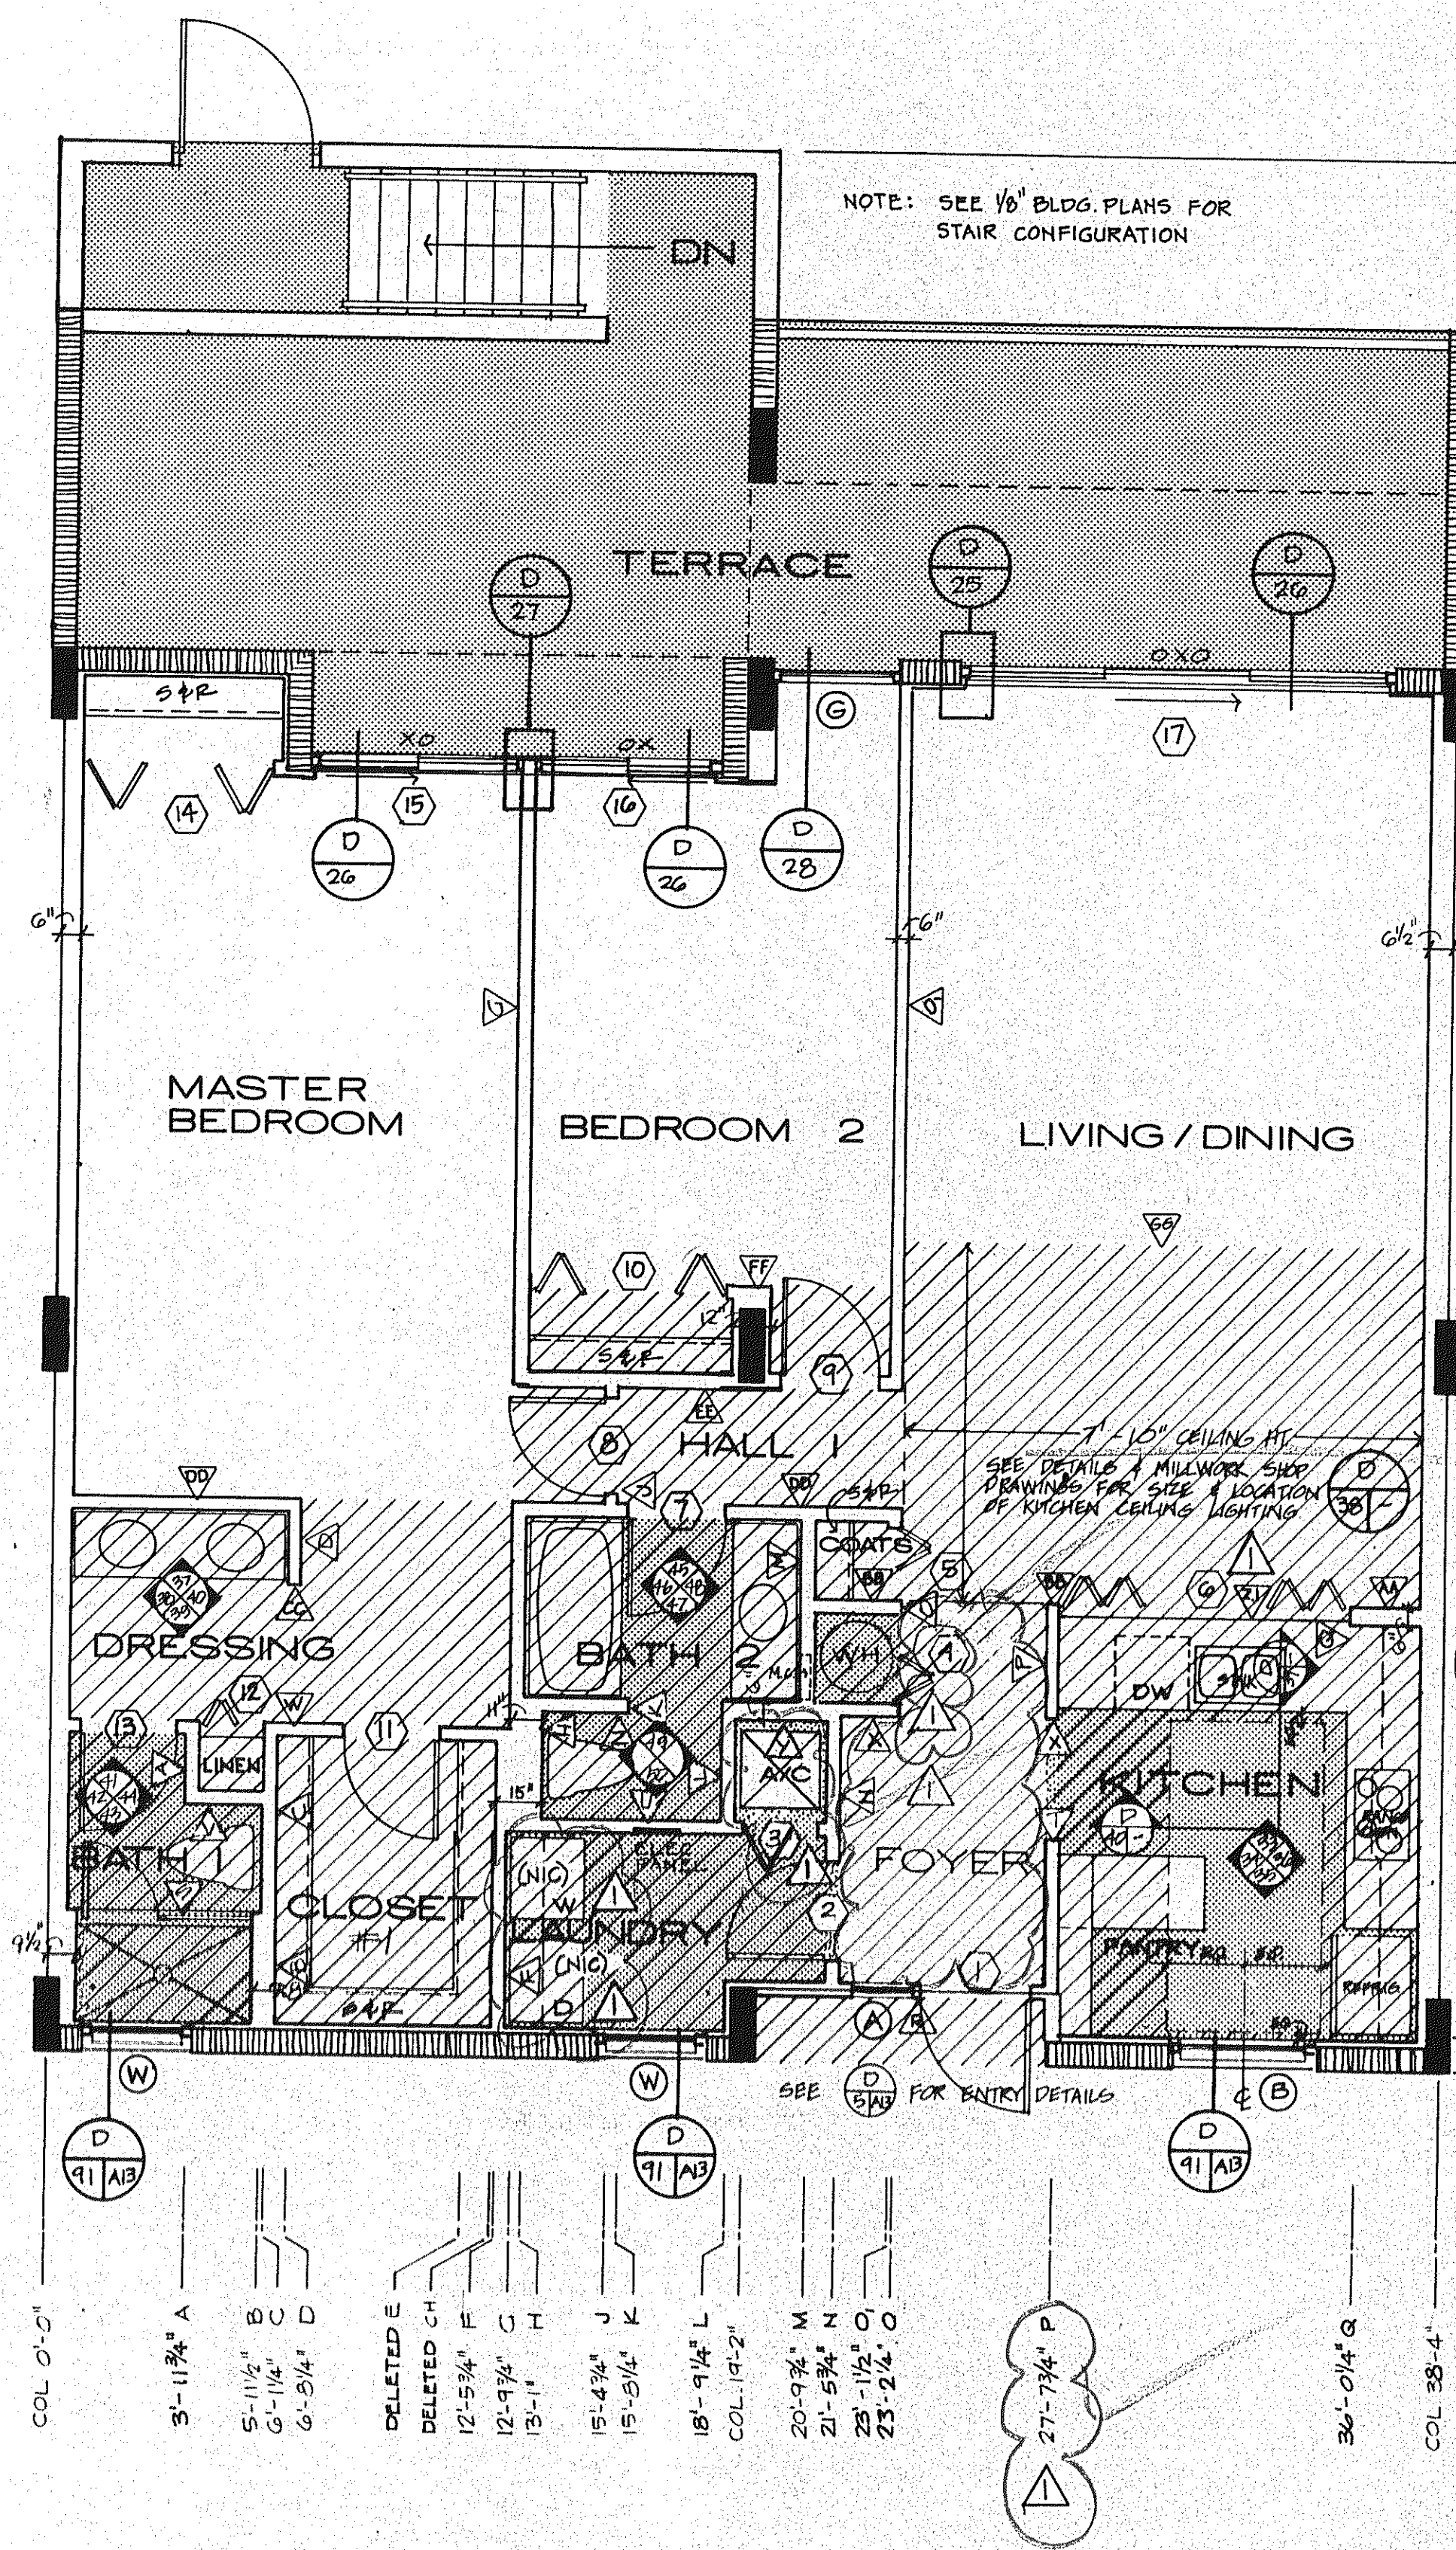

UNIT C+ LEFT

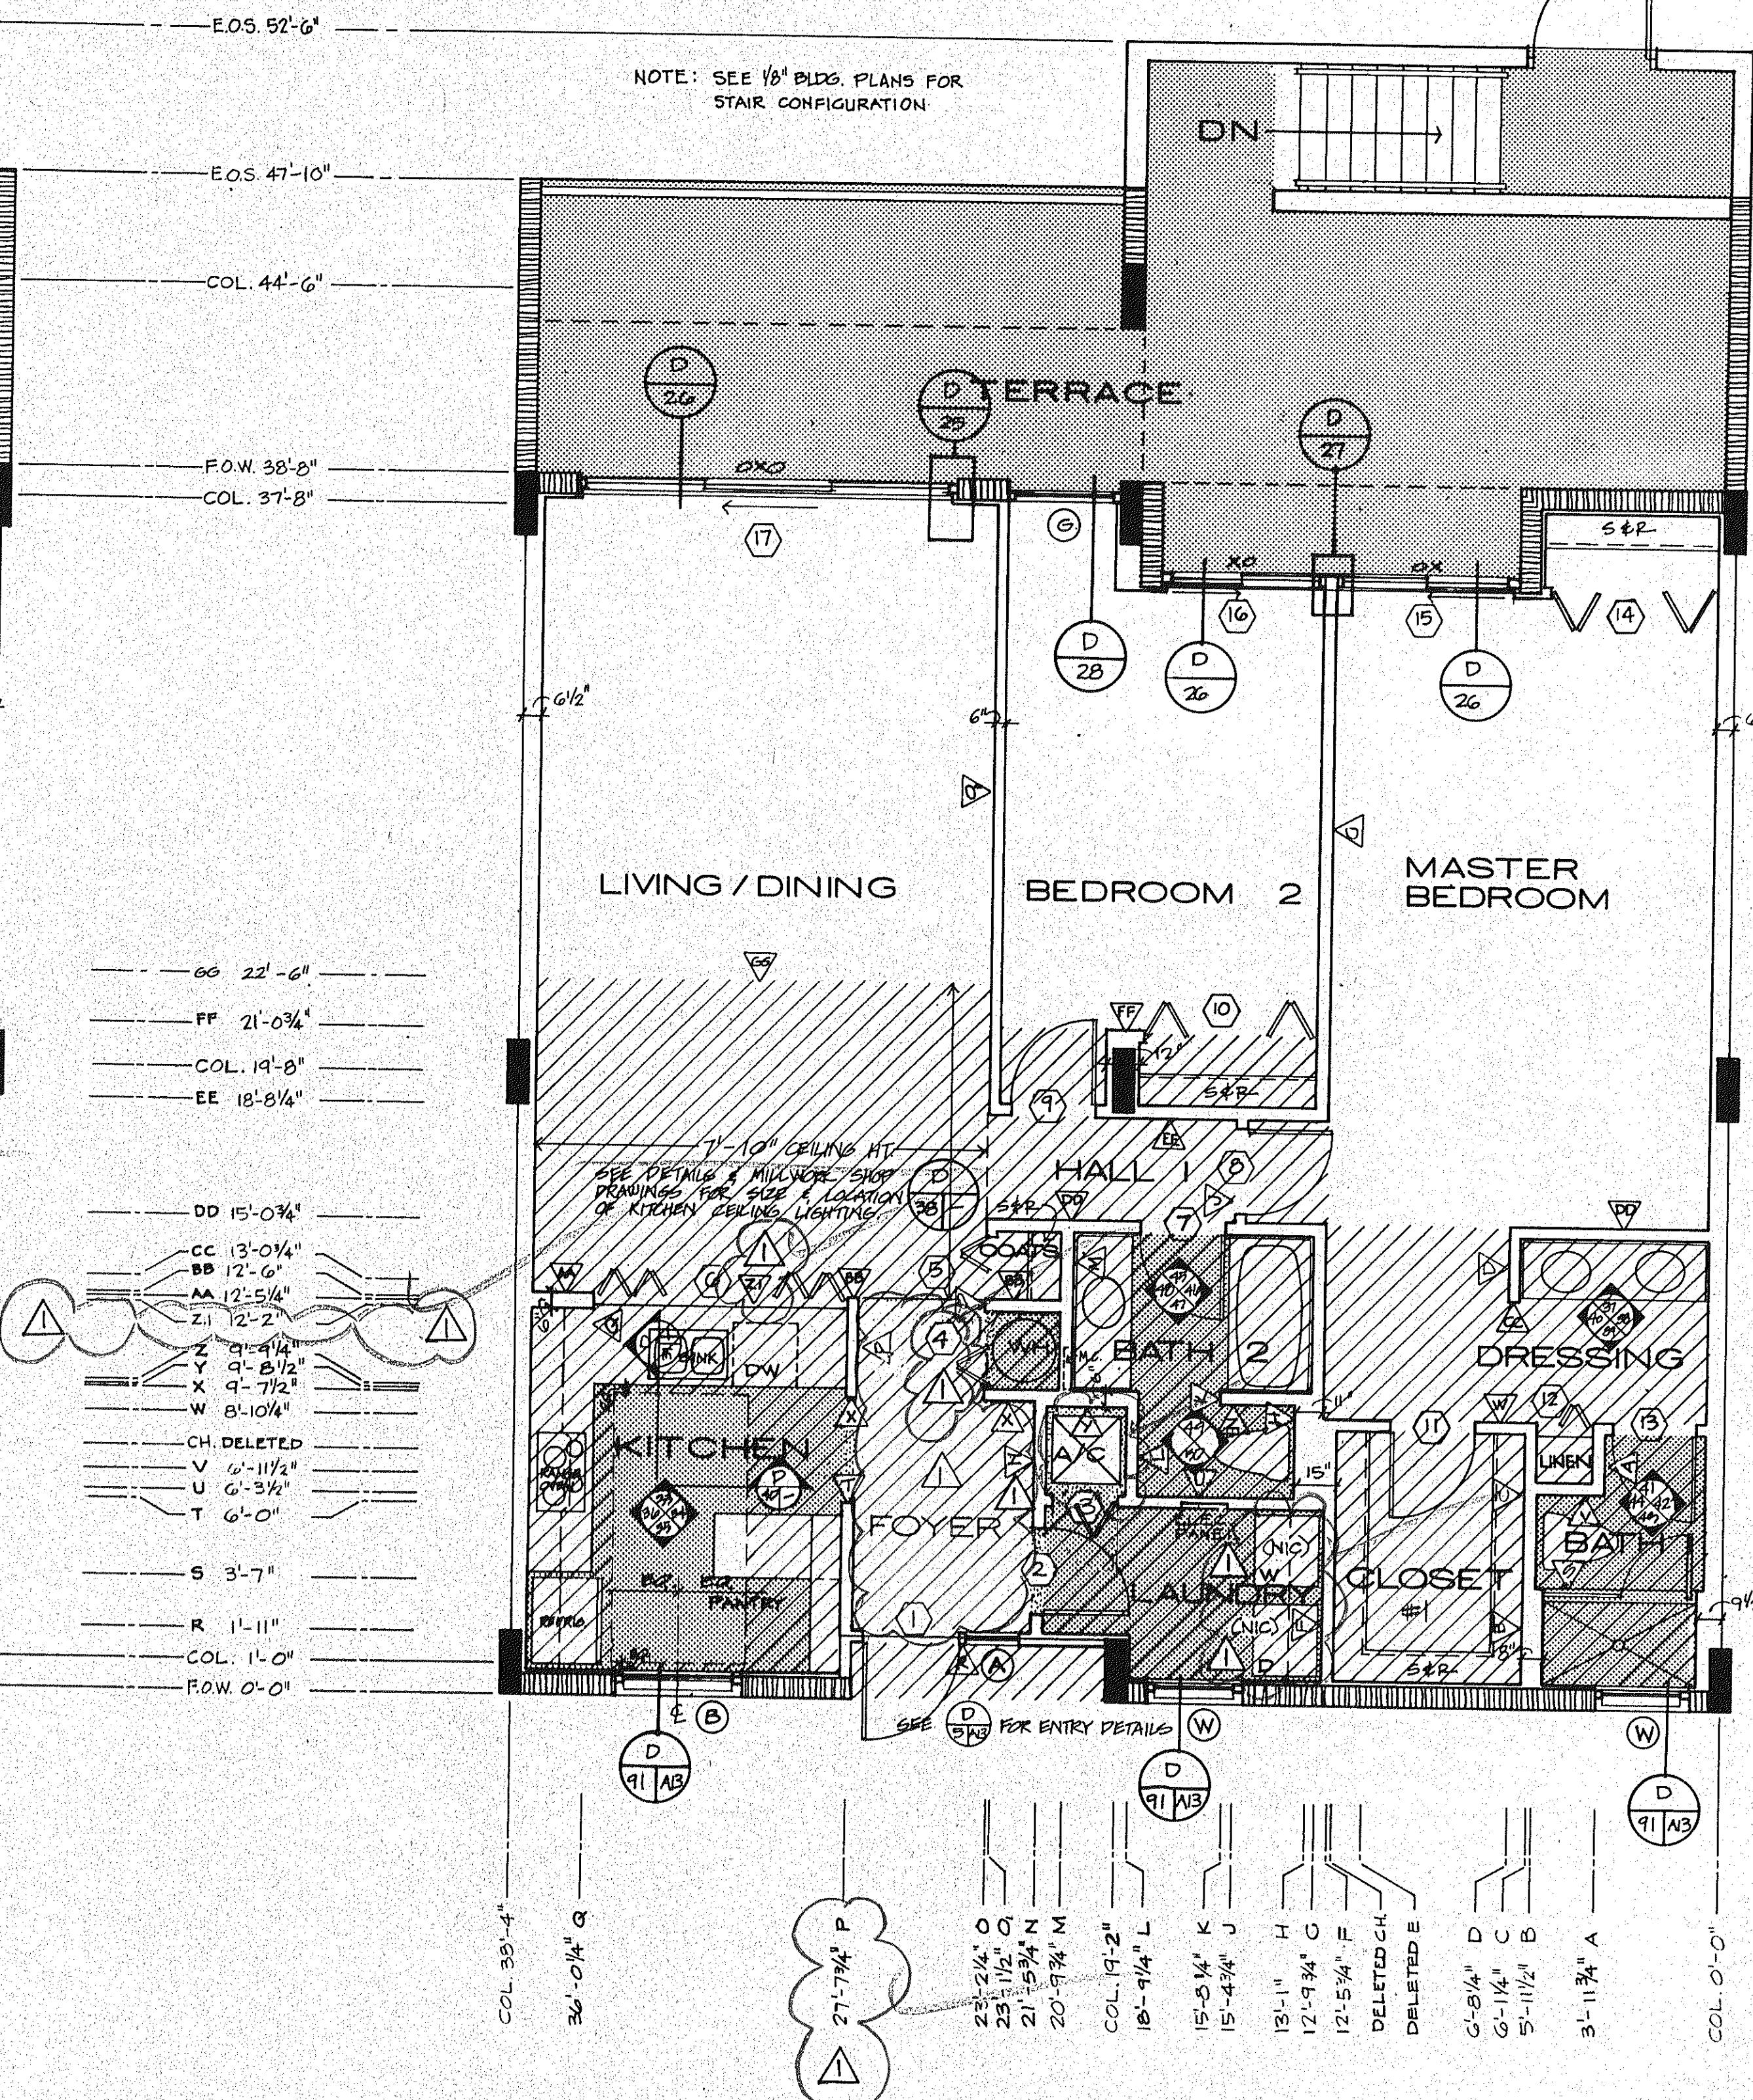

UNIT C+ RIGHT

60	22'-6"
FF	21'-0 3/4"
COL.	19'-8"
EE	18'-8 1/4"
DD	15'-0 3/4"
CC	13'-0 1/4"
BB	12'-6"
AA	12'-5 1/4"
Z1	12'-2"
Z	9'-4 1/4"
Y	9'-8 1/2"
X	9'-7 1/2"
W	8'-10 1/4"
CH	DELETED
V	6'-11 1/2"
U	6'-2 1/2"
T	6'-0"
S	3'-7"
R	1'-11"
COL.	1'-0"
F.O.W.	0'-0"

COL	0'-0"
3'-11 3/4"	A
5'-11 1/2"	B
6'-1 1/4"	C
6'-5 1/4"	D
DELETED	E
DELETED	G
12'-5 3/4"	F
12'-9 3/4"	G
13'-1"	H
15'-4 3/4"	J
15'-5 1/4"	K
18'-9 1/4"	L
COL	19'-2"
20'-9 3/4"	M
21'-5 3/4"	N
23'-1 1/2"	O
23'-2 1/4"	P
27'-7 3/4"	P
36'-0 1/4"	Q
COL	38'-4"

COL	39'-4"
36'-0 1/4"	Q
27'-7 3/4"	P
23'-2 1/4"	O
23'-1 1/2"	N
21'-5 3/4"	M
20'-9 3/4"	L
COL	19'-2"
18'-9 1/4"	L
15'-5 3/4"	K
15'-4 3/4"	J
13'-1"	H
12'-9 3/4"	G
12'-5 1/4"	F
DELETED	CH
DELETED	E
6'-8 1/4"	D
6'-1 1/4"	C
5'-11 1/2"	B
3'-11 3/4"	A
COL	0'-0"

- NOTES:
1. SEE 1/8" BLDG PLANS FOR COL. & SHEAR WALL LOCATIONS.
  2. ALL DROPPED CEILINGS ARE 7'-0" UNLESS OTHERWISE NOTED.
  3. ALL DIMENSIONS ARE FROM CENTERLINE OF WALL.
  4. SEE DETAIL BOOKLET FOR DOOR, WINDOW & FINISH SCHEDULES.
  5. SCREEN DOT TEXTURE DENOTES PAVERS, CER TILE, VINYL TILE, OR VAT. SEE FINISH SCHEDULES FOR EXACT LOCATIONS.
  6. VERIFY EXACT LOCATION OF LAVS. W/ ARCHITECT.
  7. DASHED LINE ABOVE THE WASHER/DRYER IS A CONTINUOUS UPPER CABINET W/ DOORS. CONSTRUCTION IS TO BE PER KITCHEN UPPER CABINETS EXCEPT DELETE ALL WOOD TRIM. FULLS TO BE RECESSED OAK.
  8. SEE SHEET A-9 FOR PLAN DIMENSIONING KEY.

SUNSET BEACH  
 SOF LONG BOAT KEY  
 ARVADA CORPORATION · EDWARD J SEIBERT AIA ARCHITECT & PLANNER PA THE SWA  
 BRABHAM KUHN DEBAY CONSULTING ENGINEERS · OLSEN WHITE & ASSOCIATES  
 J.P. RAL ENGINEERS · BENNETT & BISHOP INC CONSULTING ENGINEERS & SURVEYORS  
 UNIT C+ PLANS 1/4" = 1'-0"  
 ISSUED 10 DEC 82  
 REVISED 4-1-83  
 SHEET A 13 OF 37