


UNIT C MOD. LEFT

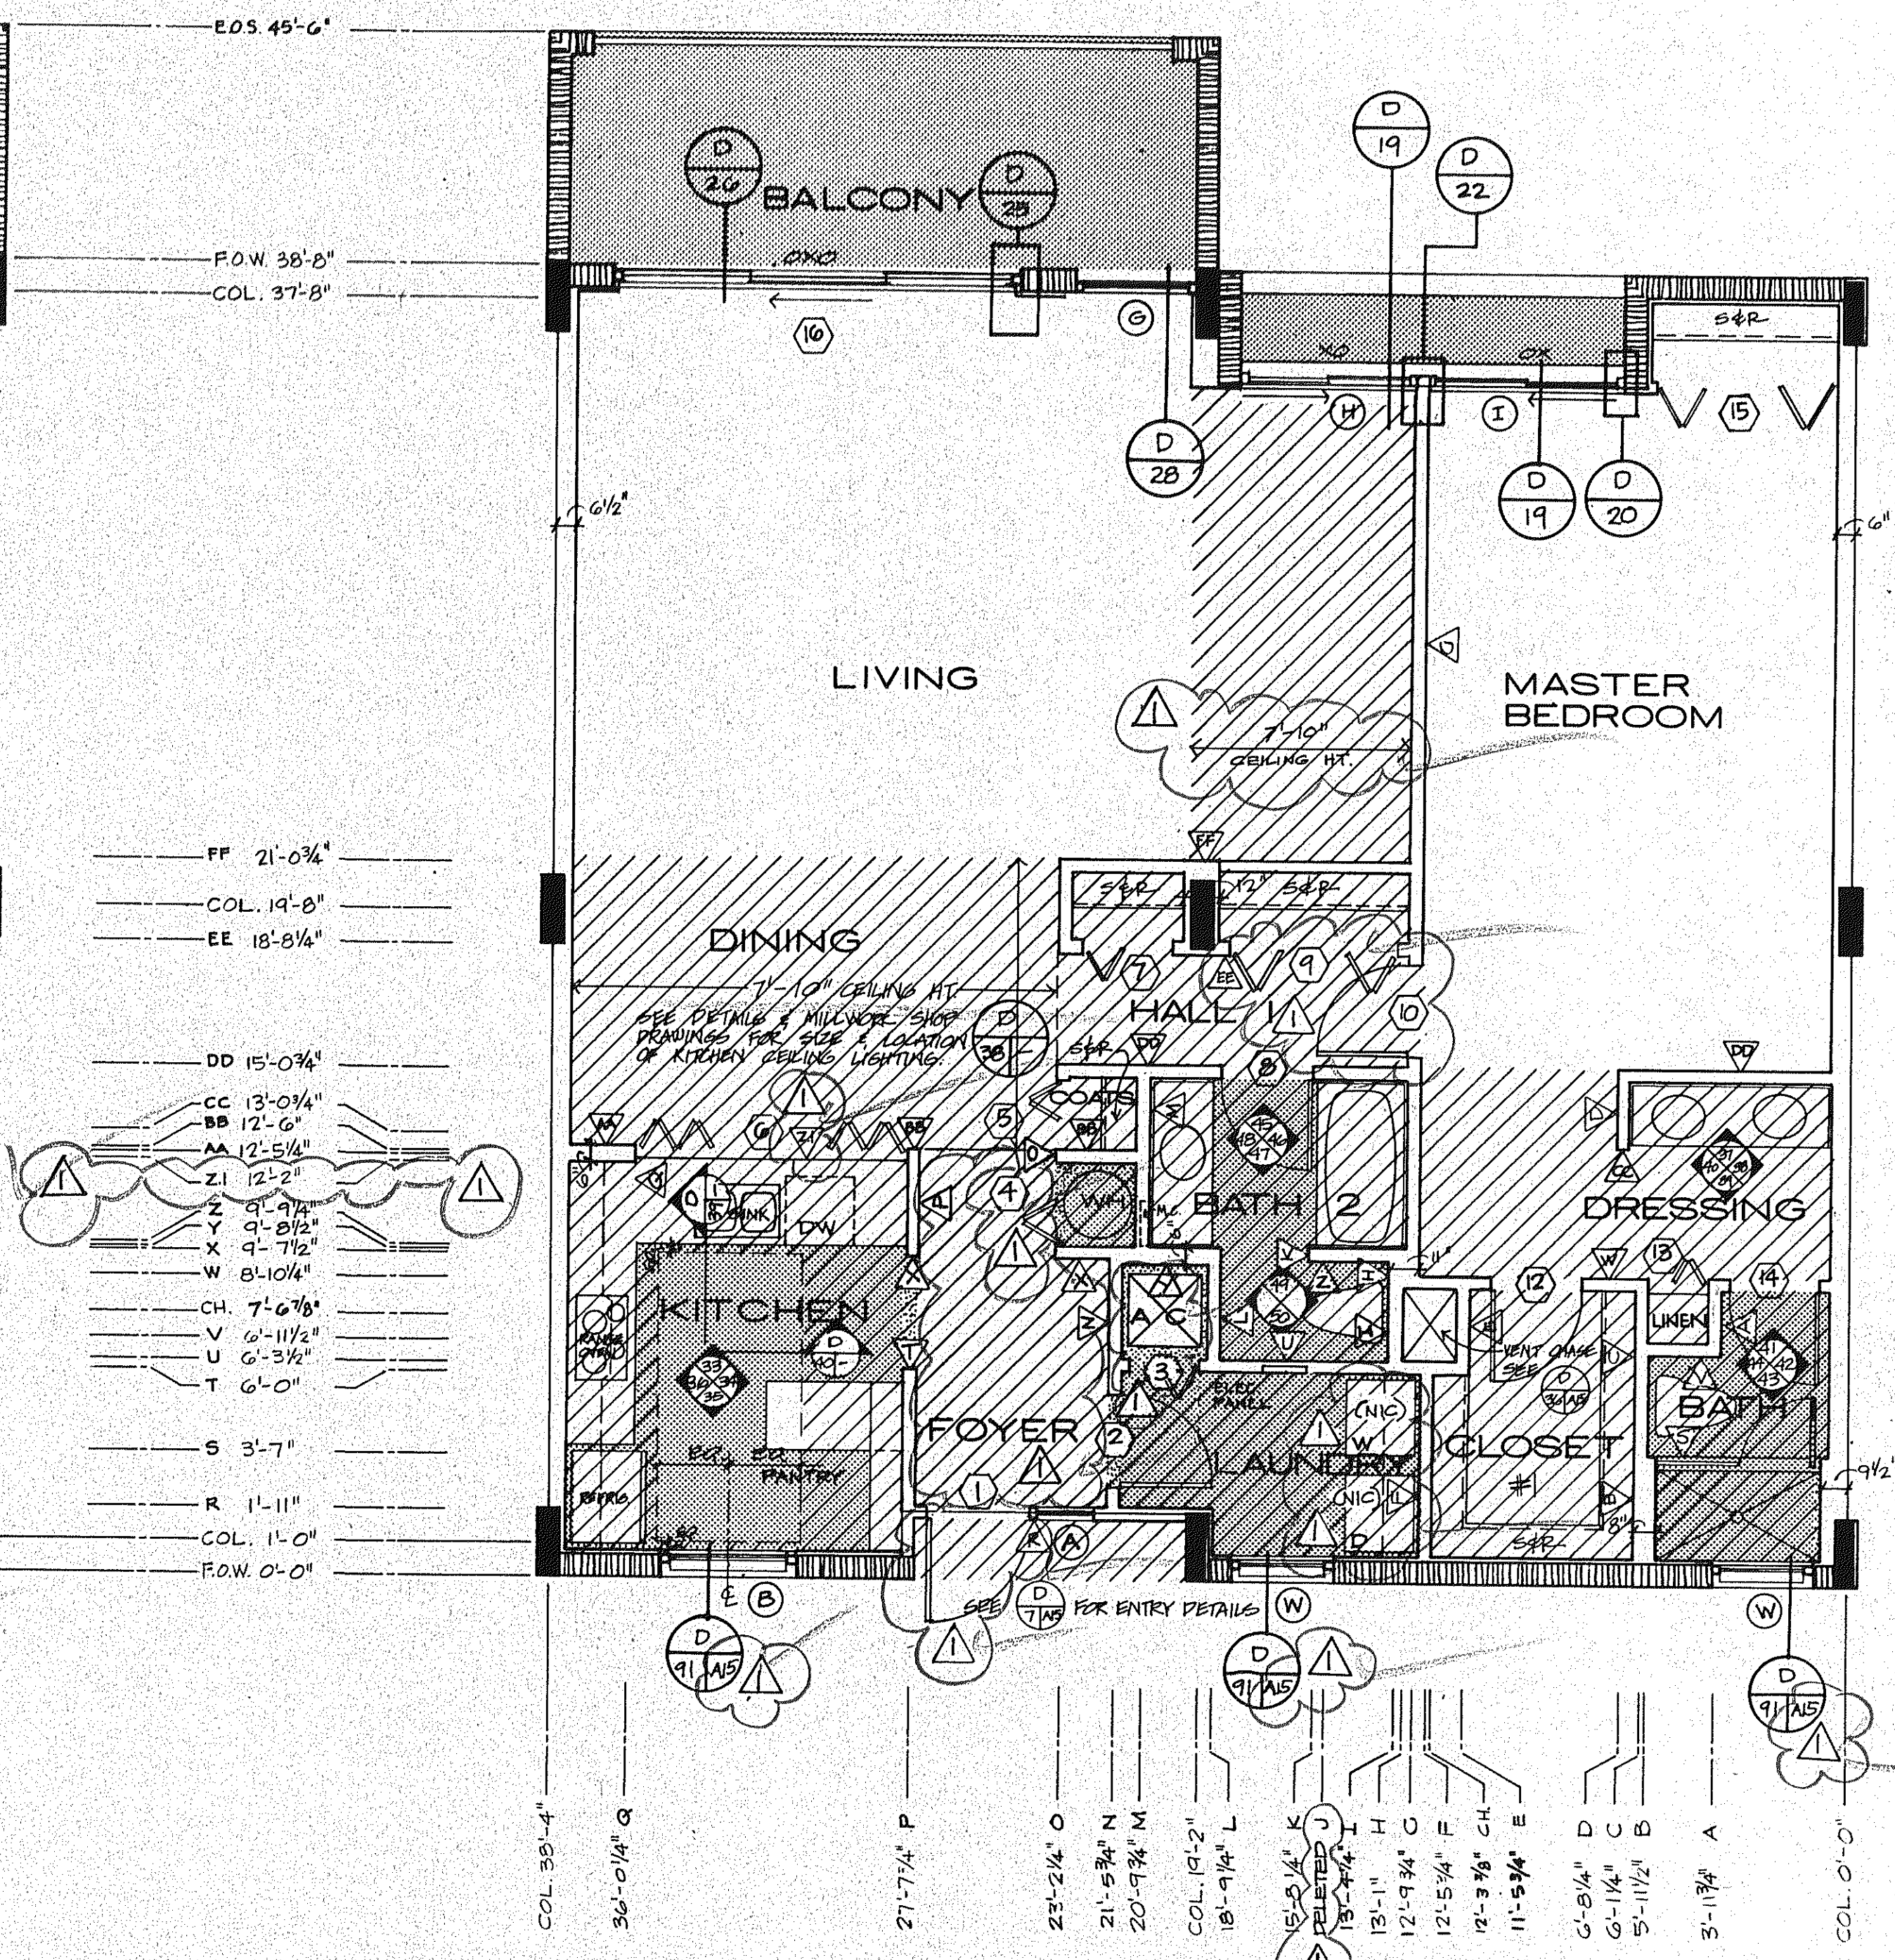

UNIT C MOD. RIGHT

FF	21'-0 3/4"
COL.	19'-8"
EE	18'-8 1/4"
DD	15'-0 3/4"
CC	13'-0 3/4"
BB	12'-6"
AA	12'-5 1/4"
Z1	12'-2"
Z	9'-9 1/2"
Y	9'-8 1/2"
X	9'-7 1/2"
W	8'-10 1/4"
CH.	7'-6 7/8"
V	6'-11 1/2"
U	6'-3 1/2"
T	6'-0"
S	3'-7"
R	1'-11"
COL.	1'-0"
F.O.W.	0'-0"

COL.	0'-0"
A	3'-11 3/4"
B	5'-11 1/2"
C	6'-1 1/4"
D	6'-5 1/4"
E	11'-5 3/4"
CH	12'-3 3/8"
F	12'-5 3/4"
G	12'-9 1/4"
H	13'-1"
I	13'-4 1/4"
J	15'-5 1/4"
K	15'-5 1/4"
L	18'-9 1/4"
COL.	19'-2"
M	20'-9 3/4"
N	21'-5 3/4"
O	23'-9 1/4"
P	27'-7 1/4"
Q	30'-0 1/4"
COL.	35'-4"

COL.	35'-4"
Q	30'-0 1/4"
P	27'-7 1/4"
O	23'-2 1/4"
N	21'-5 3/4"
M	20'-9 3/4"
L	18'-9 1/4"
K	15'-5 1/4"
J	15'-5 1/4"
I	13'-4 1/4"
H	13'-1"
G	12'-9 1/4"
F	12'-5 3/4"
E	11'-5 3/4"
D	6'-5 1/4"
C	6'-1 1/4"
B	5'-11 1/2"
A	3'-11 3/4"
COL.	0'-0"

- NOTES:
1. SEE 1/8" BLDG PLNG FOR COL. & SHEAR WALL LOCATIONS.
 2. ALL DROPPED CEILINGS ARE 7'-0" UNLESS OTHERWISE NOTED.
 3. ALL DIMENSIONS ARE FROM CENTERLINE OF WALL.
 4. SEE DETAIL BOOKLET FOR DOOR, WINDOW & FINISH SCHEDULES.
 5. SCREEN DOT TEXTURE DENOTES PAVERS, CER. TILE, VINYL TILE OR VAT. SEE FINISH SCHEDULE FOR EXACT LOCATIONS.
 6. VERIFY EXACT LOCATION OF LANS. W/ ARCHITECT.
 7. DASHED LINE ABOVE THE WASHER/DRYER IS A CONTINUOUS UPPER CABINET W/ DOORS. CONSTRUCTION IS TO BE PER THE KITCHEN UPPER CABINETS EXCEPT DELETE ALL WOOD TRIM. PULLS TO BE RECESSED OAK.
 8. SEE SHEET A-4 FOR PLAN DIMENSIONING KEY.