
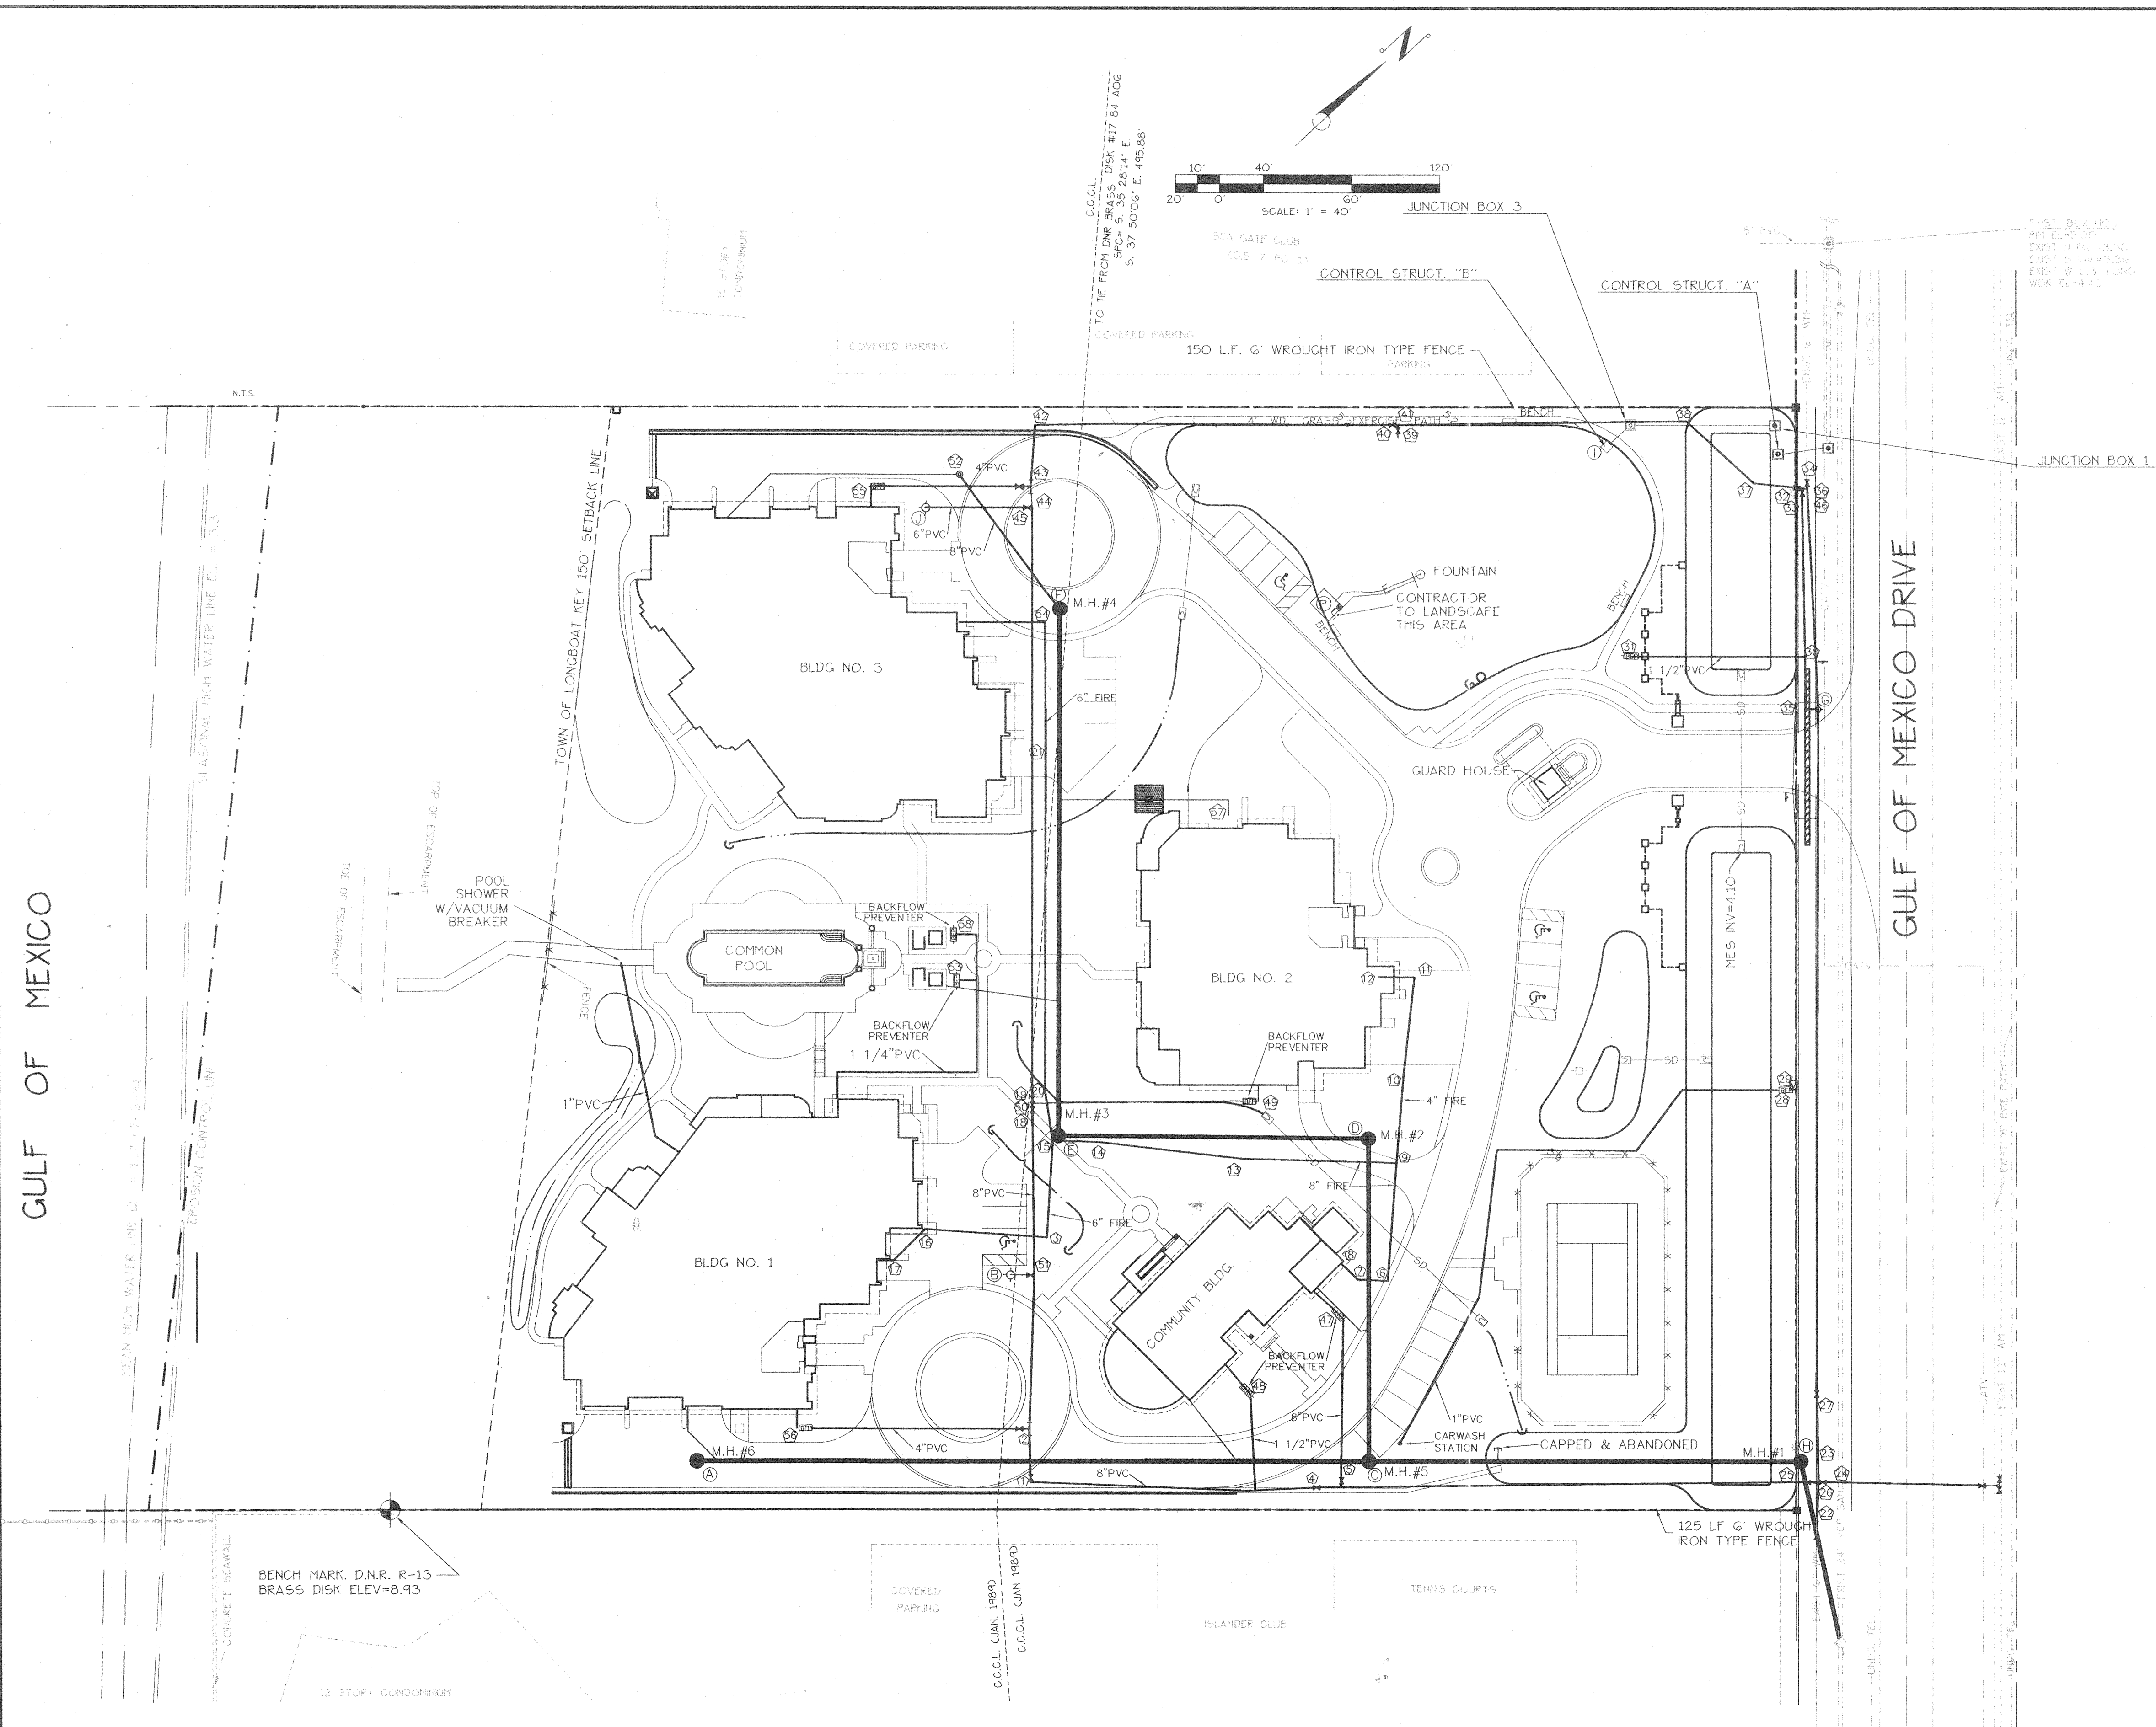


GULF OF MEXICO

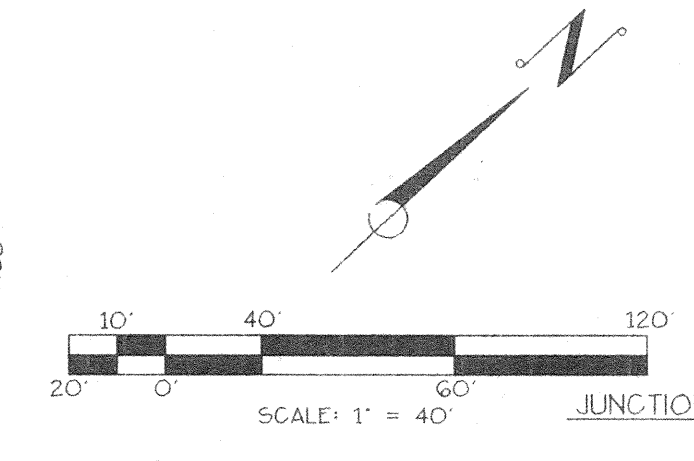

AS-BUILT TABLE

	A	B	C	D	E	F	G	H	I	J
	M.H.	FIRE	M.H.	M.H.	M.H.	M.H.	FIRE	M.H.	CONTROL	FIRE
	1	HYD.	5	2	3	4	HYD.	1	STRUCT.	HYD.
									B	
1	8" GATE VALVE	151.1'	92.1'							
2	8"X 4" TEE/VALVE	151.1'	92.1'							
3	6" 90° BEND		23.9'		46.6'					
4	8" GATE VALVE			25.9'	159.5'					
5	8" GATE VALVE			15.2'	155.7'					
6	8" 90° BEND			82.0'	65.6'					
7	8" 45° BEND			82.3'	64.6'					
8	8" END			90.3'	58.5'					
9	8"X 8" TEE W/4" RED.			135.8'	17.9'					
10	4" PIPE			33.8'	159.4'					
11	4" 90° BEND			220.6'	76.1'					
12	4" END			219.9'	73.4'					
13	8" PIPE			57.8'	84.3'					
14	8" PIPE				121.8'	19.1'				
15	8"X 6"X 6" TEE			64.2'	3.4'					
16	45° BEND			44.1'	74.2'					
17	45° BEND			53.3'	94.0'					
18	8" GATE VALVE			76.3'	16.9'					
19	8" GATE VALVE			80.8'	20.4'					
20	8" PIPE			84.4'	20.3'					
21	8" PIPE				174.3'	65.4'				
22	6" GATE VALVE			204.7'				26.9'		
23	6" GATE VALVE			203.1'				7.9'		
24	10" GATE VALVE			208.6'				15.9'		
25	8" GATE VALVE W/10X 8" RED.			198.6'				10.1'		
26	10"X 6" CROSS			203.3'				12.1'		
27	6" GATE VALVE			205.7'				31.5'		
28	1" BACKFLOW PREVENTER							173.0'	169.2'	
29	WATER METER							172.3'	169.8'	
30	1 1/2" SADDLE							24.3'	130.2'	
31	1" BACKFLOW PREVENTER							260.3'	87.7'	
32	8" GATE VALVE							100.1'	87.9'	
33	6" GATE VALVE							98.1'	90.3'	
34	6" GATE VALVE							102.0'	91.8'	
35	6" 90° BEND							5.5'	148.6'	
36	6" TEE							99.3'	92.5'	
37	45° BEND							105.6'	68.3'	
38	45° BEND							142.9'	37.6'	
39	8" GATE VALVE							173.1'	95.5'	
40	8" GATE VALVE							172.2'	98.1'	
41	8" TEE							174.3'	95.8'	
42	8" 90° BEND							83.4'		62.2'
43	8"X 4" TEE/VALVE							56.2'		48.5'
44	8"X 6" TEE							47.1'		48.3'
45	6" GATE VALVE							47.7'		46.1'
46	6" TEE							99.3'	92.5'	
47	6" BACKFLOW PREVENTER			67.8'					220.1'	
48	2" BACKFLOW PREVENTER			55.1'					252.8'	
49	3" BACKFLOW PREVENTER				52.7'	92.1'				
50	8"X 8" TEE			79.6'		19.4'				
51	8"X 6" TEE			10.2'		63.7'				
52	CLEANOUT						75.5'			21.3
53	1" BACKFLOW PREVENTER			137.7'		85.5'				
54	6" 90° BEND						9.3'			75.5'
55	3" BACKFLOW PREVENTER						101.7'			25.6'
56	3" BACKFLOW PREVENTER			51.2'	116.0'					
57	CLEANOUT						121.3'			196'
58	1" BACKFLOW PREVENTER			156.7'			102.8'			

NOTE: SEE PLAN AND PROFILES FOR SEWER RIM AND INVERT ELEVATIONS.

NOTE: THE PROJECT HAS BEEN CONSTRUCTED IN COMPLIANCE WITH THE APPROVED PLANS.

RECORD DRAWING

WATER AND SEWER SYSTEM

VIZCAYA at LONGBOAT KEY
ECOVENTURE LBK, LTD.

WATER AND SEWER PLAN

PROJECT NO. ECG-01
SHEET NO. 4

BISHOP & ASSOCIATES
Engineers · Surveyors · Planners
AN EMPLOYEE OWNED COMPANY
78 SARASOTA CENTER BOULEVARD SARASOTA, FLORIDA 34240
PHONE (941)-371-6362 • FAX (941)-378-3215

BY	DATE	O.C.	DATE	DESCRIPTION
D.B.	4-20-98			ADD AS-BUILT INFO.

TASK	INITIALS	DATE
DESIGN	M.M.H.	9/30/94
DRAWN	D.B.	4-13-98
CHECKED		
QUALITY CHK		
HORIZ. SCALE	1" = 40'	
VERT. SCALE		

SEAL ENGINEER OR SURVEYOR OF RECORD DATE

C:\DPK\ECG-01\ECG104AB Thu May 14 10:16:59 1998 DERK BISHOP