


REUSE OF DOCUMENTS  
 THESE DOCUMENTS ARE INSTRUMENTS OF SERVICE IN RESPECT OF THE PROJECT TO WHICH THEY APPLY AND ANY REUSE WITHOUT WRITTEN VERIFICATION OR ADAPTATION BY BISHOP AND ASSOCIATES (B&A) FOR THE SPECIFIC PURPOSES INTENDED WILL BE AT USER'S SOLE RISK AND WITHOUT LIABILITY OR LEGAL EXPOSURE TO B&A, AND USER SHALL INDEMNIFY AND HOLD HARMLESS B&A FROM ALL CLAIMS, DAMAGES, LOSSES AND EXPENSES INCLUDING ATTORNEY'S FEES ARISING OUT OF OR RESULTING THEREFROM. ANY SUCH VERIFICATION OR ADAPTATION WILL ENTITLE B&A TO FURTHER COMPENSATION AT RATES TO BE AGREED UPON BY USER AND B&A.

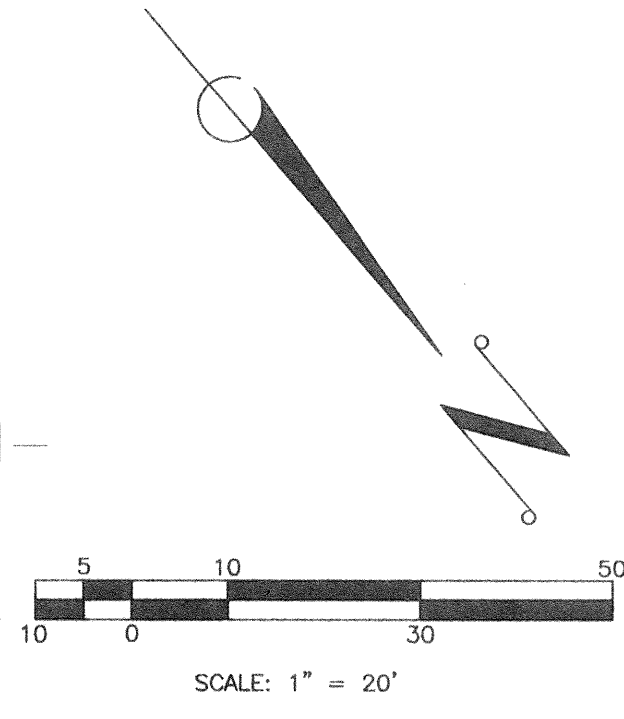

**INVESTIGATE BEFORE YOU EXCAVATE**  
**"CALL CANDY"**  
 1-800-282-8881  
 TOLL FREE  
 FL. STATUTE 553.851 (1979) REQUIRES MIN. OF 2 DAYS AND MAX. OF 5 DAYS NOTICE BEFORE YOU EXCAVATE.

**ALSO NOTIFY:**  
 FP&L 953-7265  
 TOWN OF LONGBOAT KEY 383-3721


**LEGEND**

EXISTING UTILITIES	
---	SANITARY SEWER
---	FORCE MAIN
---	STORM DRAIN
---	WATER MAIN
---	GAS MAIN
---	BURIED CABLE TV
---	BURIED ELECTRIC
---	BURIED TELEPHONE
PROPOSED UTILITIES	
---	SANITARY SEWER
---	STORM DRAIN
---	WATER MAIN
---	FIRE MAIN
---	PROP. STORM SEWER STRUCTURE
---	PROP. SANITARY SEWER MANHOLE

NOTE:  
 ALL UTILITY SLEEVES ARE TO BE CONSTRUCTED 5' BEHIND THE PROP. CURB UNLESS NOTED OTHERWISE.

FOR CONTINUATION

SEE SHEET NO. 5

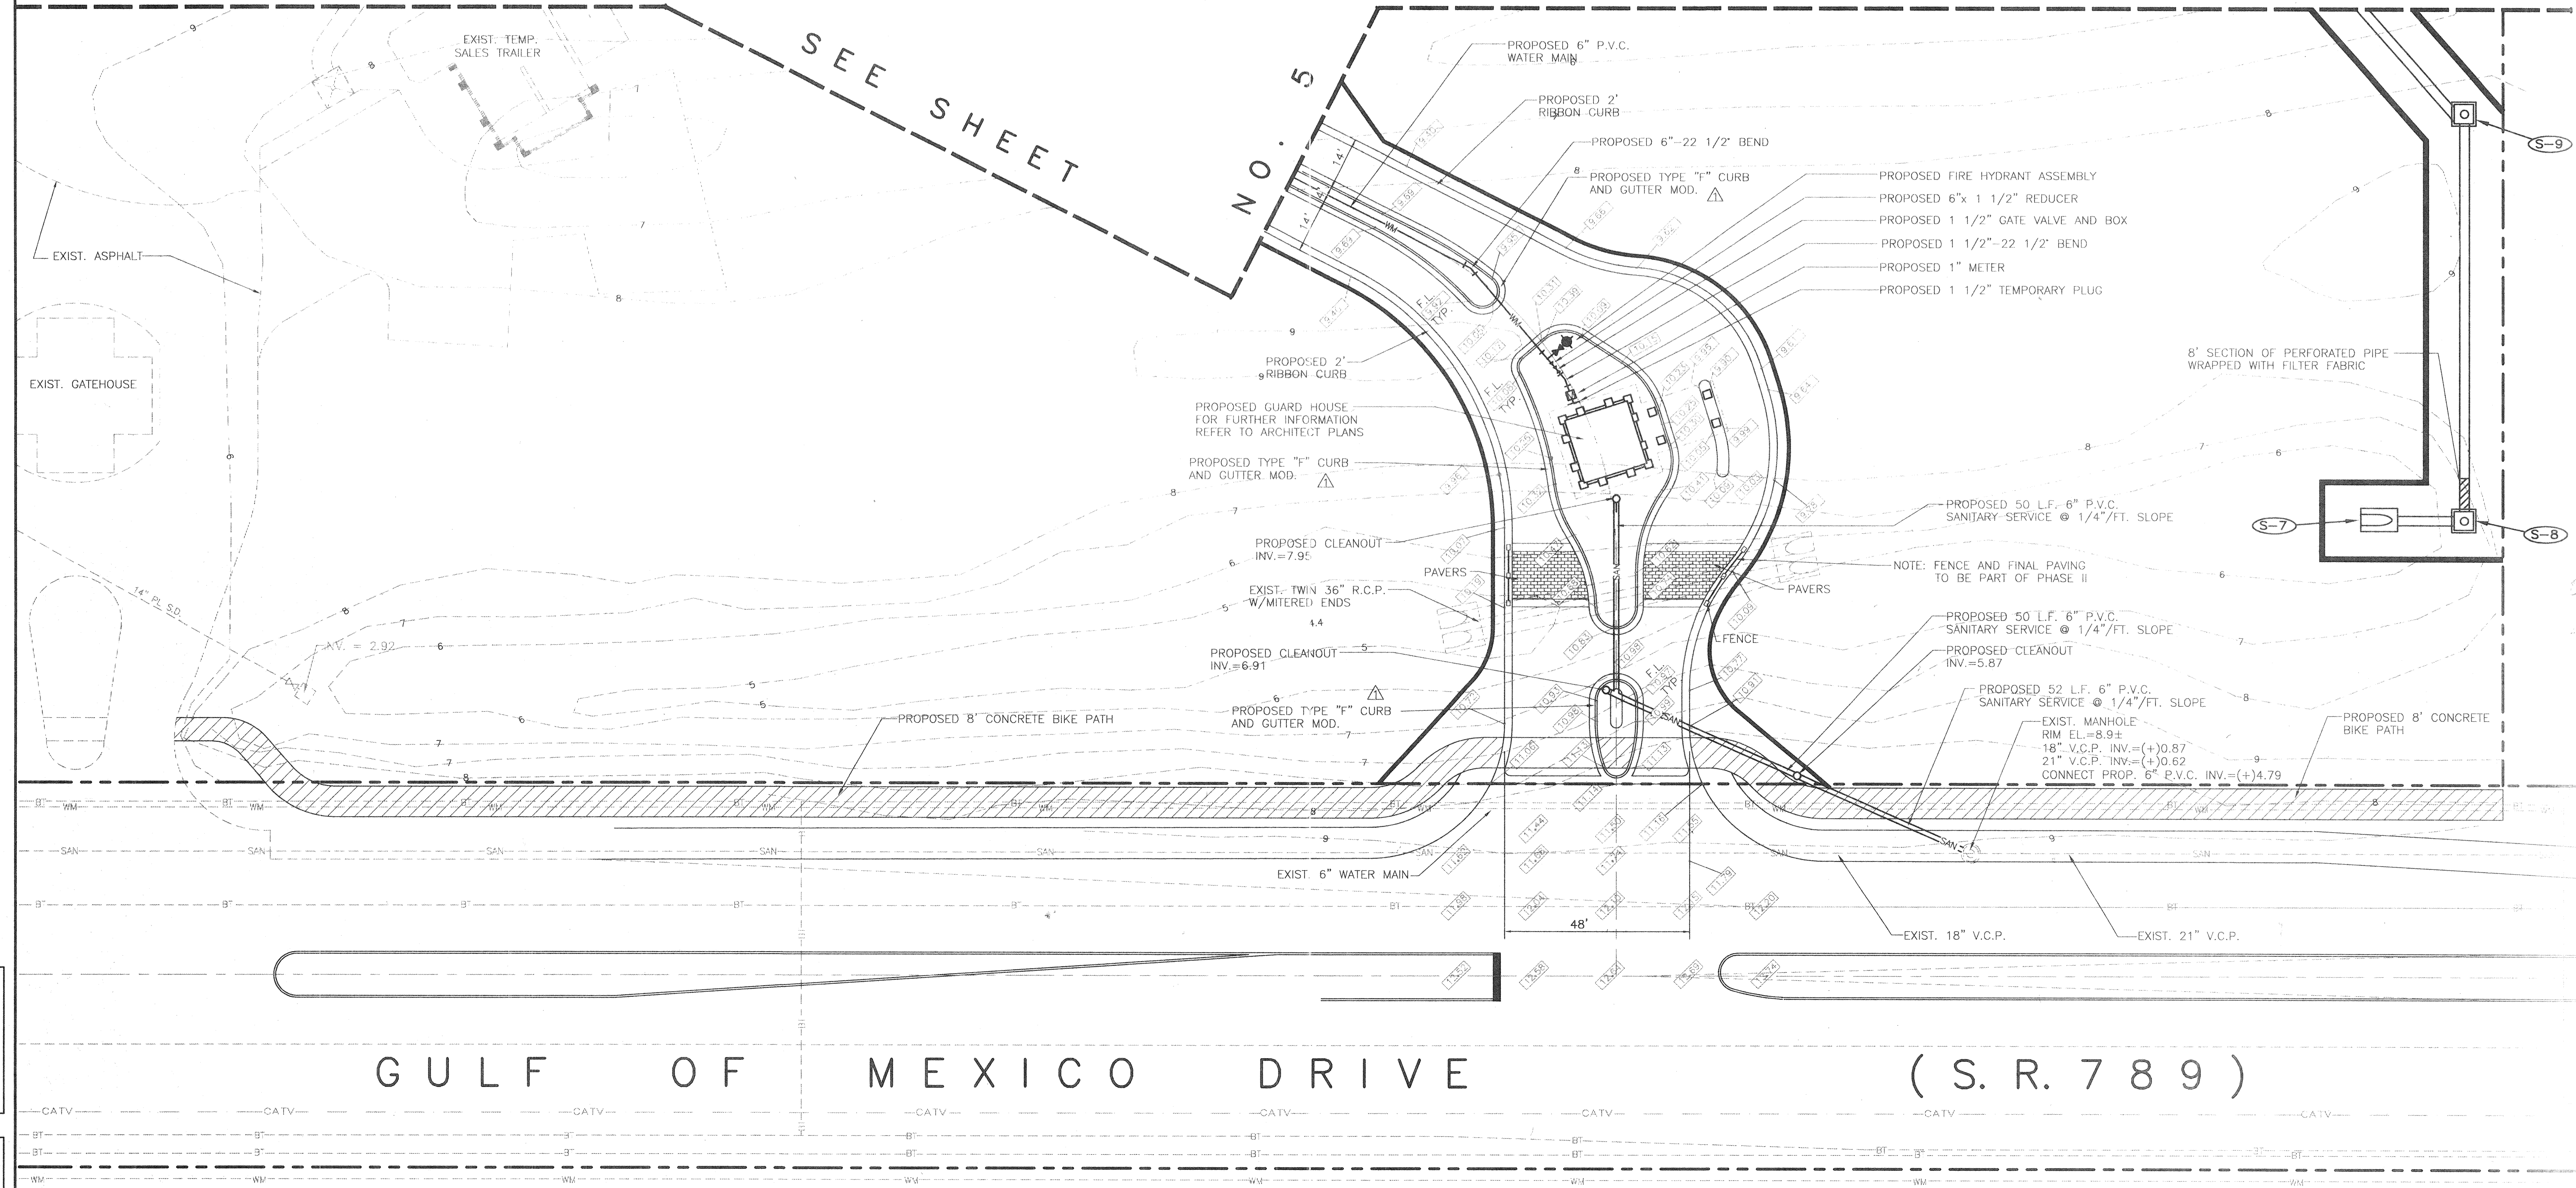

GULF OF MEXICO DRIVE (S.R. 789)

FIELD BOOK NO. \_\_\_\_\_  
 PLOT DATE: ANS50005  
 CUD FILE: \_\_\_\_\_  
 P.O. #: \_\_\_\_\_

**BISHOP & ASSOCIATES**  
 Consulting Engineers • Surveyors  
 AN EMPLOYEE OWNED COMPANY  
 78 SARASOTA CENTER BLVD. SARASOTA, FLORIDA 34240  
 813/371-6362 • Fax 813/378-3215

REVISED	BY	DATE	Q.C.	DATE	DESCRIPTION
	PSN	10/8/93	PCP	10/8/93	REV. CURB TYPE FROM RIBBON TO "F" MOD.
	SWS	1/5/94	TJD	1/5/94	REV. PROJECT NO., NAME & OWNER
	SWS	1/28/94	TJD	1/28/94	ADDED PERFORATED PIPE AT S-8 PER DER COMMENT
	P.L.	11-2-95			ADD PAVERS & WALLS TO ENTRANCE
	D.N.S.I4	15-97			REV. TITLE BLOCK

REVISED	BY	DATE	Q.C.	DATE	DESCRIPTION
	PJ	6-14-98			RECORD DRAWING

TASK	INITIALS	DATE
DESIGN	P.C.P.	4-19-93
DRAWN	P.S.N.	4-28-93
CHECKED	W.F.B.	
QUALITY CHK		
VERT. SCALE:		

SEAL: *Mark G. Call* 6/14/99  
 ENGINEER OR SURVEYOR OF RECORD DATE

**RECORD DRAWING**  
 CLIENT/TITLE: **THE WATER CLUB II AT LONGBOAT KEY**  
**THE WATER CLUB II DEVELOPMENT, INC.**  
**DETAIL DRAINAGE AND UTILITY PLAN**

PROJECT NO. ANS-50  
 SHEET NO. RD-6