

# THE WATER CLUB II AT LONGBOAT KEY RECORD DRAWINGS

## THE WATER CLUB II DEVELOPMENT, INC.

**GENERAL NOTES**

CALL CANDY 1-800-282-8881 48 HOURS BEFORE YOU DIG  
RESPONSIBILITY REGARDING EXISTING UTILITIES & STRUCTURES

THE EXISTENCE AND LOCATION OF EXISTING UNDERGROUND UTILITIES ARE NOT GUARANTEED AND SHALL BE INVESTIGATED AND VERIFIED IN THE FIELD BY THE CONTRACTOR BEFORE STARTING WORK. EXCAVATION IN THE VICINITY OF EXISTING STRUCTURES AND UTILITIES SHALL BE CAREFULLY DONE, BY HAND IF NECESSARY. THE CONTRACTOR SHALL BE HELD RESPONSIBLE FOR ANY DAMAGE TO AND FOR MAINTENANCE AND PROTECTION OF EXISTING UTILITIES AND STRUCTURES.

THE CONTRACTOR SHALL BE RESPONSIBLE FOR VERIFYING THE POINT OF CONNECTION OF ALL BUILDING SERVICE LINES AT THE BUILDING PRIOR TO INSTALLATION.

EROSION CONTROL DURING CONSTRUCTION

THE CONTRACTOR SHALL TAKE ALL NECESSARY MEASURES TO PREVENT THE RUNOFF OF ERODED SOIL MATERIAL FROM LEAVING THE CONSTRUCTION SITE AND BEING DEPOSITED ON THE PROPERTY OF OTHERS OR ON PORTIONS OF THE SITE OUTSIDE THE CONSTRUCTION LIMITS.

THE CONTRACTOR SHALL INSURE THAT ALL NECESSARY PERMITS ARE OBTAINED PRIOR TO COMMENCING ANY CONSTRUCTION ACTIVITY.

LAWS TO BE OBSERVED

THE CONTRACTOR IS ASSUMED TO BE FAMILIAR WITH AND AT ALL TIMES SHALL OBSERVE AND COMPLY WITH ALL FEDERAL, STATE AND LOCAL LAWS, BYLAWS, SAFETY LAWS, BUILDING AND CONSTRUCTION CODES, AND ORDINANCES AND REGULATIONS IN ANY MANNER AFFECTING THE CONDUCT OF THE WORK.



B

**BISHOP & ASSOCIATES**  
Consulting Engineers • Surveyors

78 SARASOTA CENTER BLVD. SARASOTA, FLORIDA 34240  
813/371-6362 • Fax 813/378-3215

**INDEX**  
PROJECT NO. ANS-50

DWG. NO.	DESCRIPTION
RD-1	COVER SHEET
2	TOPOGRAPHIC AND BOUNDARY MAP
3	TREE LOCATION AND PRESERVATION PLAN (NOT INCLUDED)
RD-4	GENERAL DRAINAGE AND UTILITY PLAN
RD-5	DETAIL DRAINAGE AND UTILITY PLAN
RD-6	DETAIL DRAINAGE AND UTILITY PLAN
RD-7	DETAIL DRAINAGE AND UTILITY PLAN
RD-8	SANITARY AND STORM SEWER PROFILES
RD-9	PAVING, GRADING, AND DRAINAGE DETAILS
RD-10	PAVING, GRADING, AND DRAINAGE DETAILS
RD-11	WATER SYSTEM DETAILS
RD-12	SANITARY SEWER DETAILS

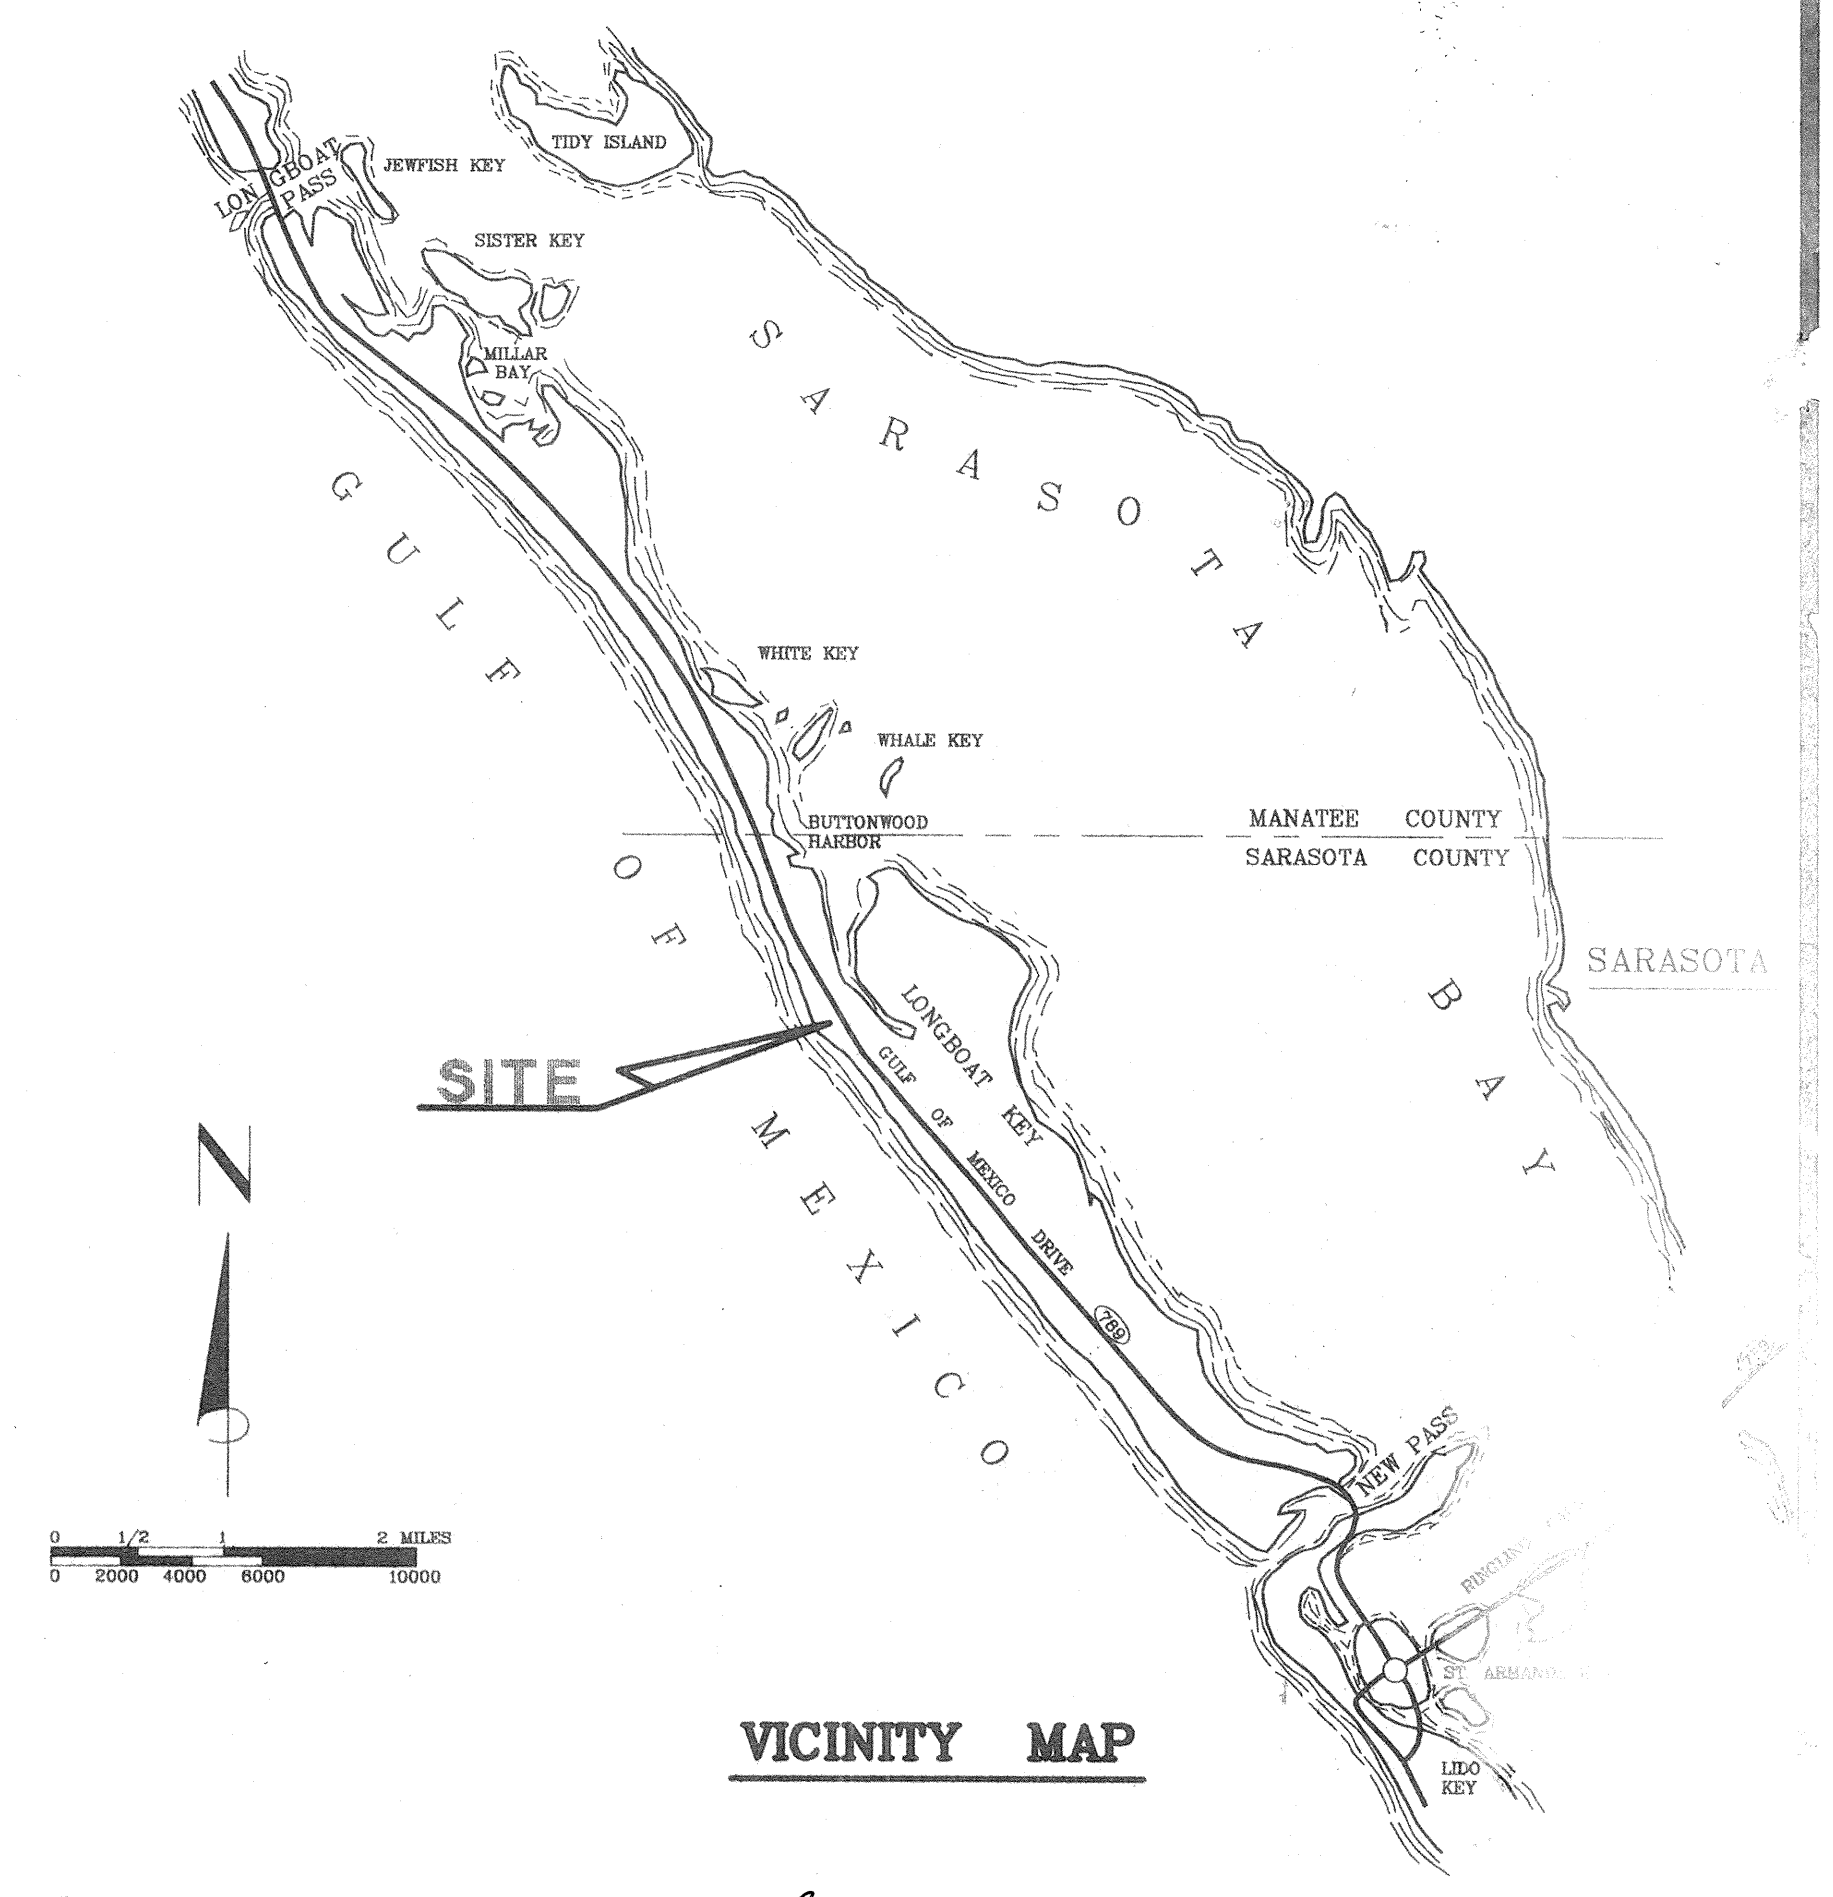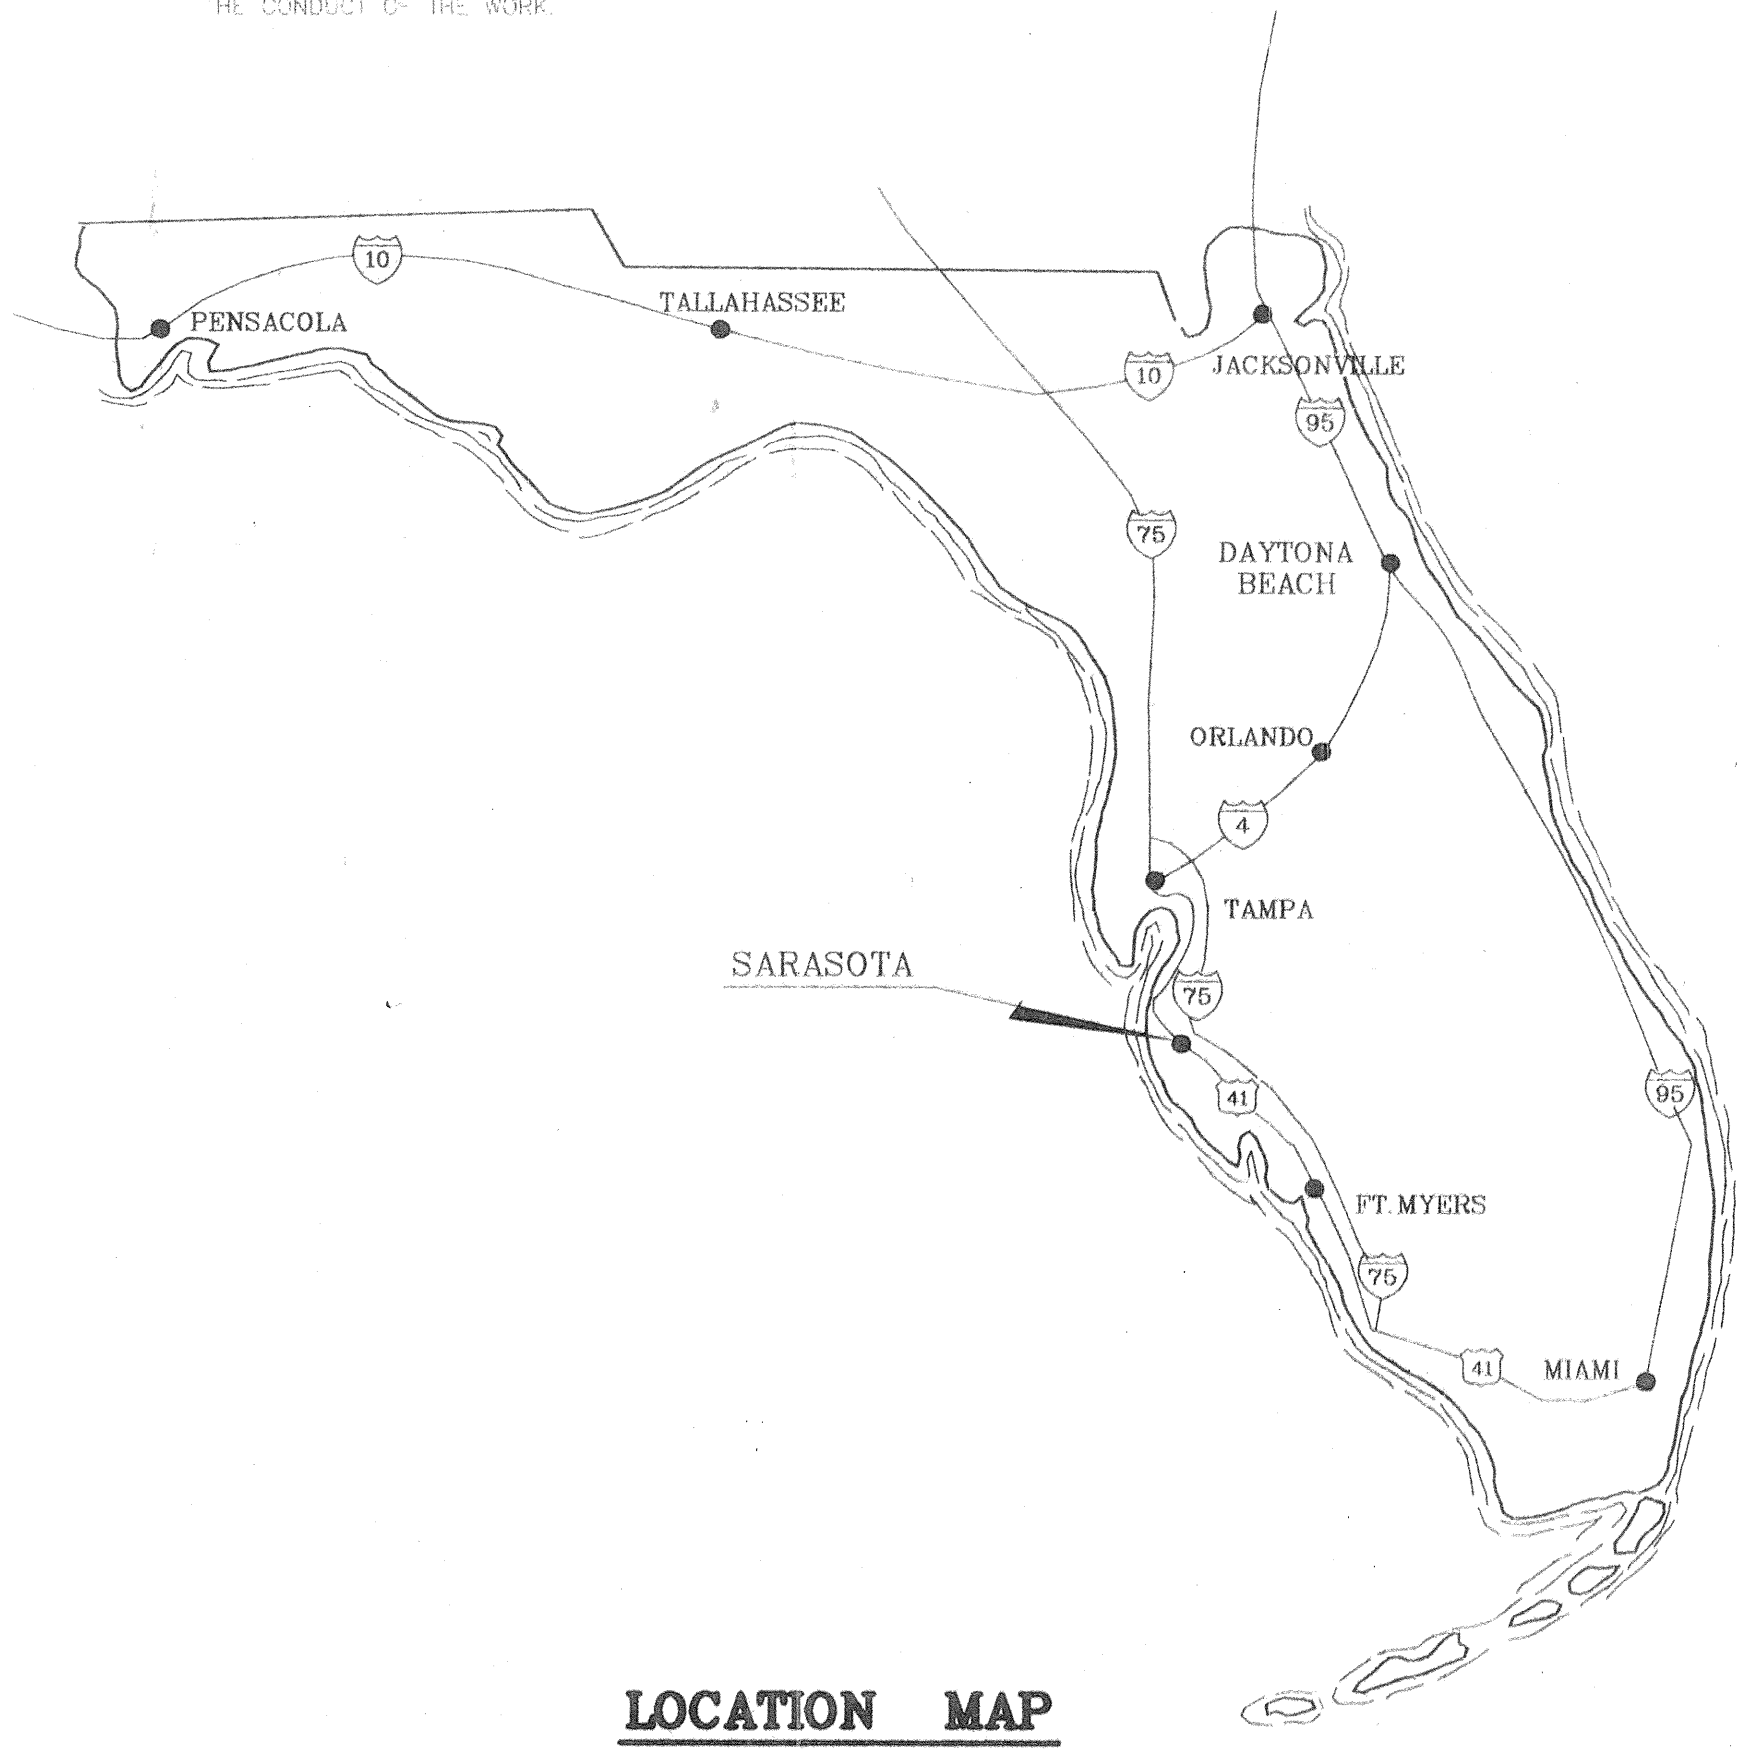

APPROVED \_\_\_\_\_  
*Max A. Bishop*  
6/14/99

RECORD DRAWING

T:\ANS\ANS50\ANS5001.dwg WED JUN 14 10:40:00 1999 PJ 010000