


SARASOTA BAY

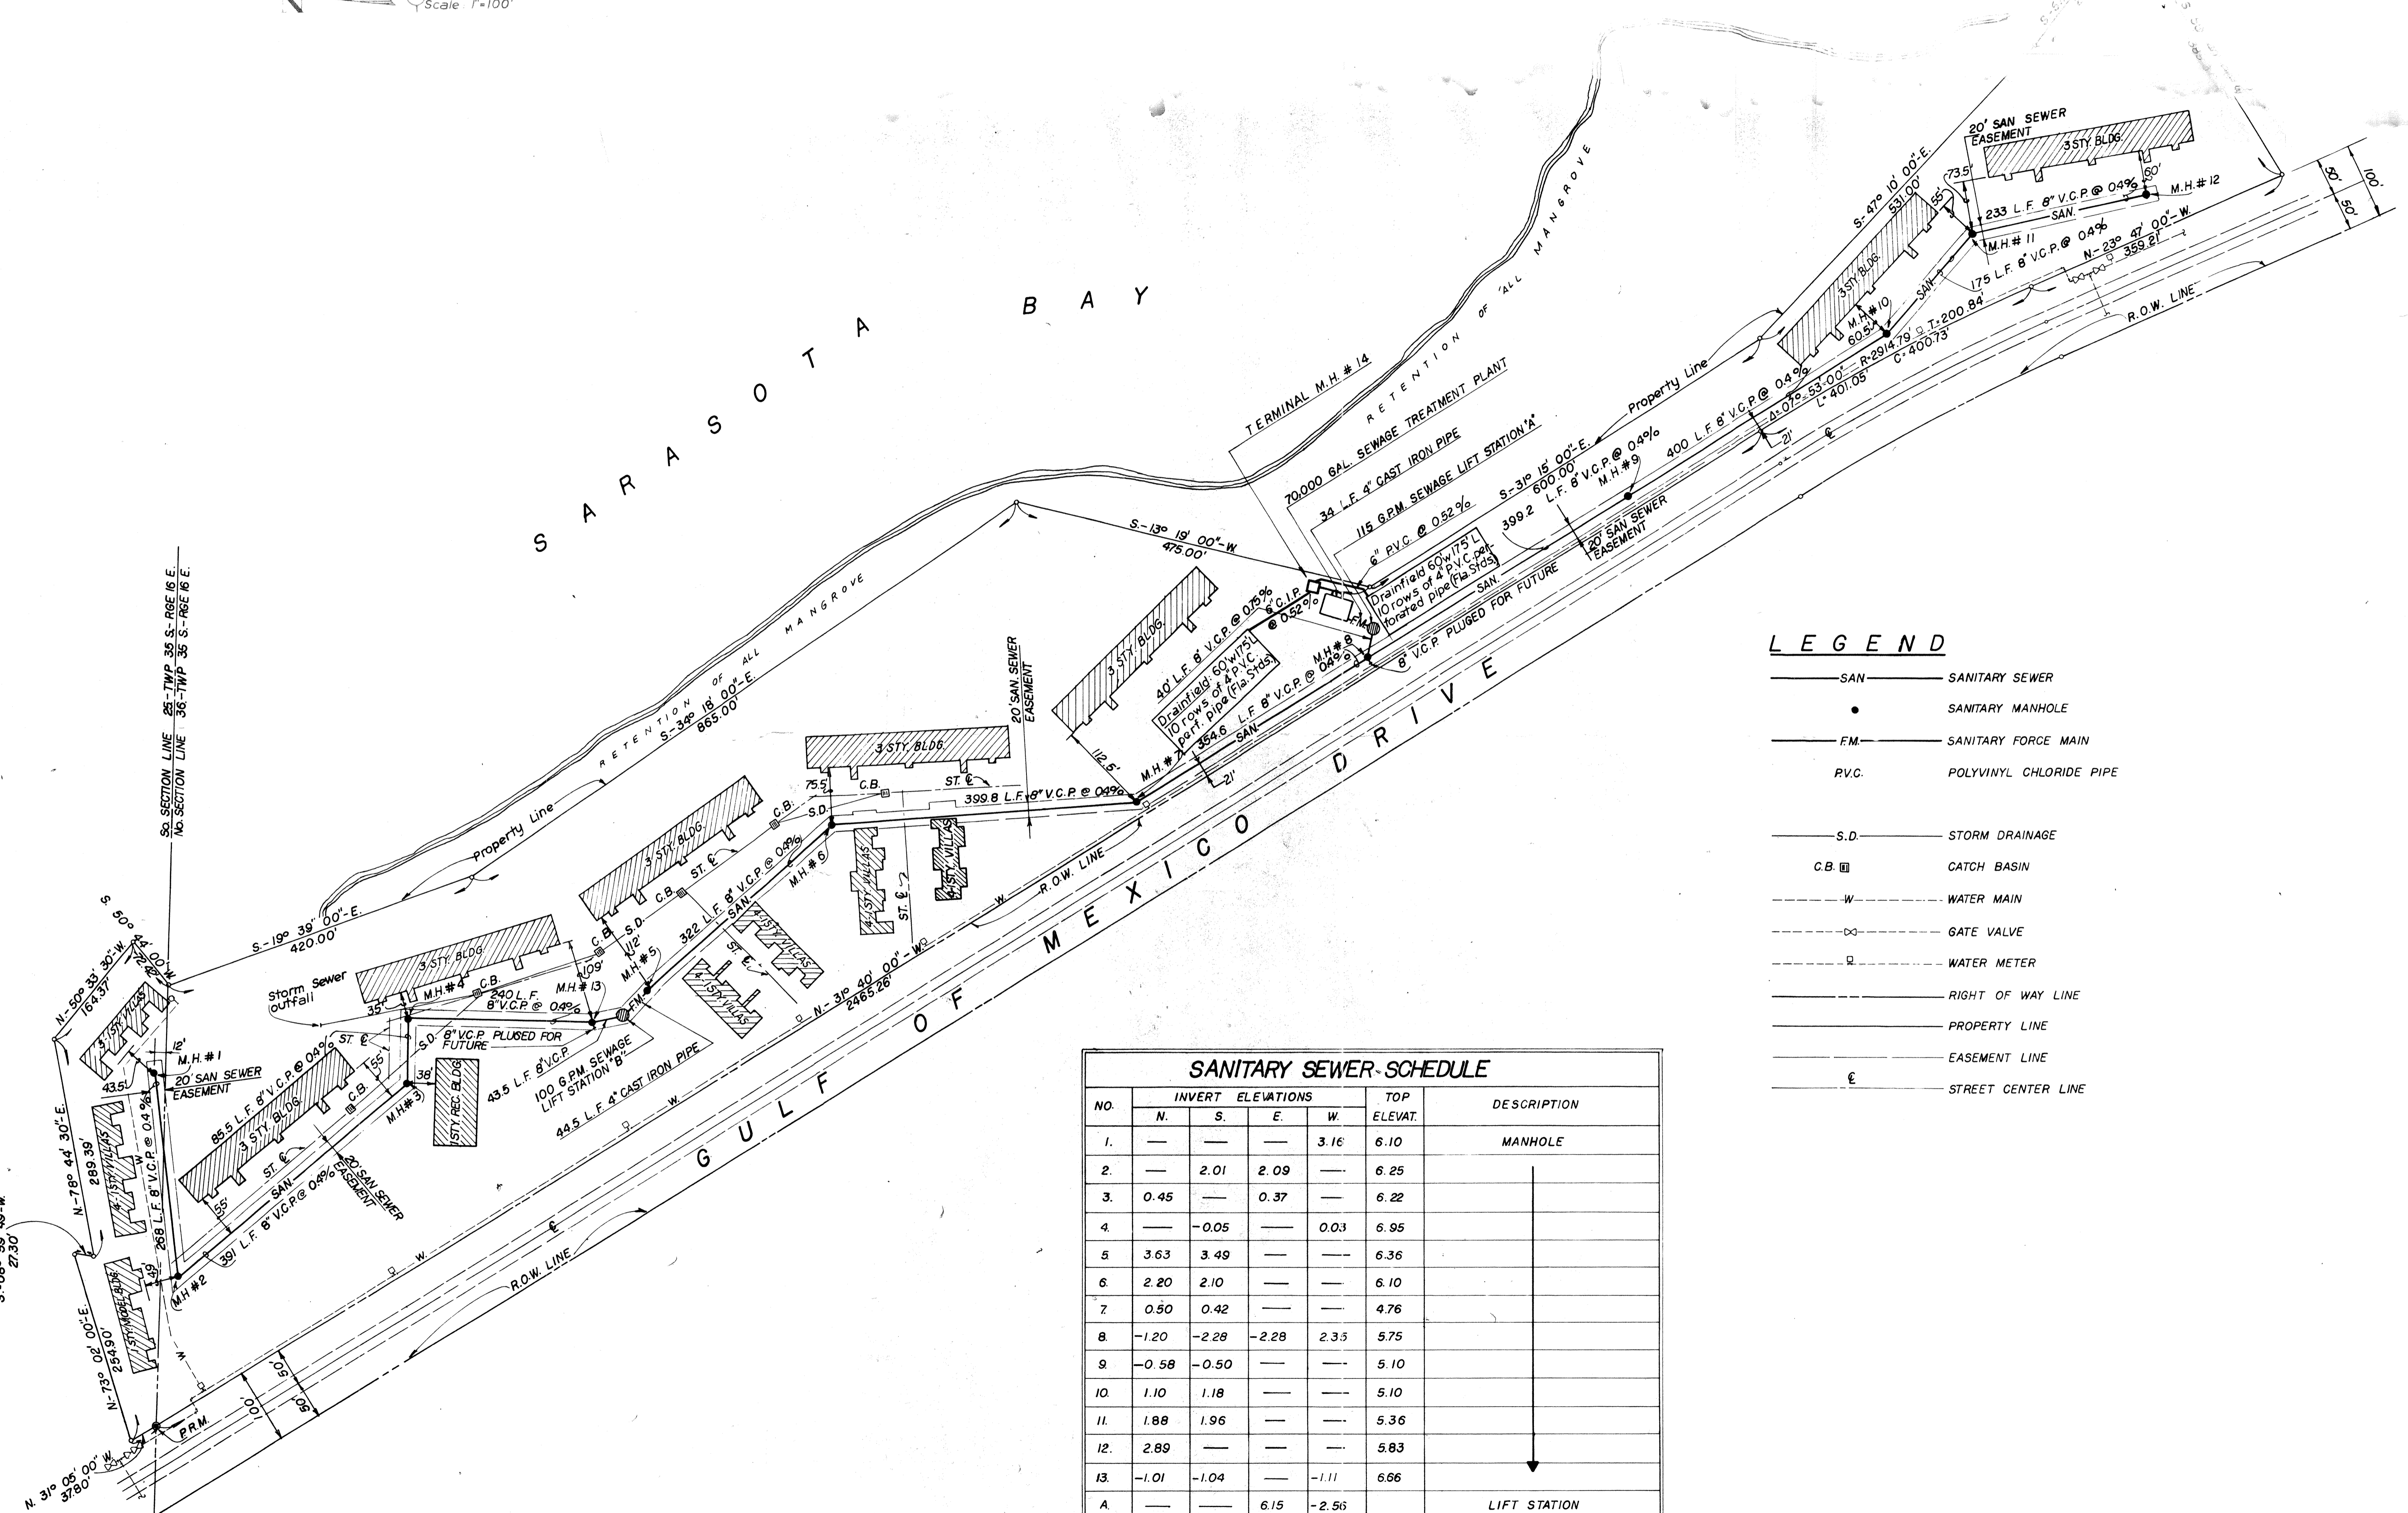

LEGEND

- SAN — SANITARY SEWER
- — SANITARY MANHOLE
- FM — SANITARY FORCE MAIN
- P.V.C. — POLYVINYL CHLORIDE PIPE
- S.D. — STORM DRAINAGE
- C.B. — CATCH BASIN
- W — WATER MAIN
- GATE VALVE
- WATER METER
- RIGHT OF WAY LINE
- PROPERTY LINE
- EASEMENT LINE
- STREET CENTER LINE

SANITARY SEWER SCHEDULE

NO.	INVERT ELEVATIONS				TOP ELEVAT.	DESCRIPTION
	N.	S.	E.	W.		
1.	—	—	—	3.16	6.10	MANHOLE
2.	—	2.01	2.09	—	6.25	
3.	0.45	—	0.37	—	6.22	
4.	—	-0.05	—	0.03	6.95	
5.	3.63	3.49	—	—	6.36	
6.	2.20	2.10	—	—	6.10	
7.	0.50	0.42	—	—	4.76	
8.	-1.20	-2.28	-2.28	2.35	5.75	
9.	-0.58	-0.50	—	—	5.10	
10.	1.10	1.18	—	—	5.10	
11.	1.88	1.96	—	—	5.36	
12.	2.89	—	—	—	5.83	
13.	-1.01	-1.04	—	-1.11	6.66	
A.	—	—	6.15	-2.56	—	LIFT STATION
B.	-1.64	4.22	—	—	7.76	LIFT STATION
14.	3.78	3.77	—	3.80	—	TERMINAL MANHOLE

DATE:	DEC. 28, 73	CHECKED BY:	G.V.M.	DRAWN BY:	R.A. & F.A.
SCALE:	1" = 100'	BY:		REVISION:	
TOWN OF LONGBOAT KEY, FLORIDA LONGBOAT HARBOR NORTH SEWERS J. J. CLARET 400 HARDING CIRCLE SARASOTA, FLORIDA					
SHEET NUMBER					
12-A					
REVISION					
T.L.K. FILE NO. G-1217-367					