


NOTE: Sanitary Lateral Stations are from nearest down stream manhole (0+00)

- LEGEND
- General Telephone
 - Storor Television
 - Fla. Power & Light Co.
 - Arvida Corporation

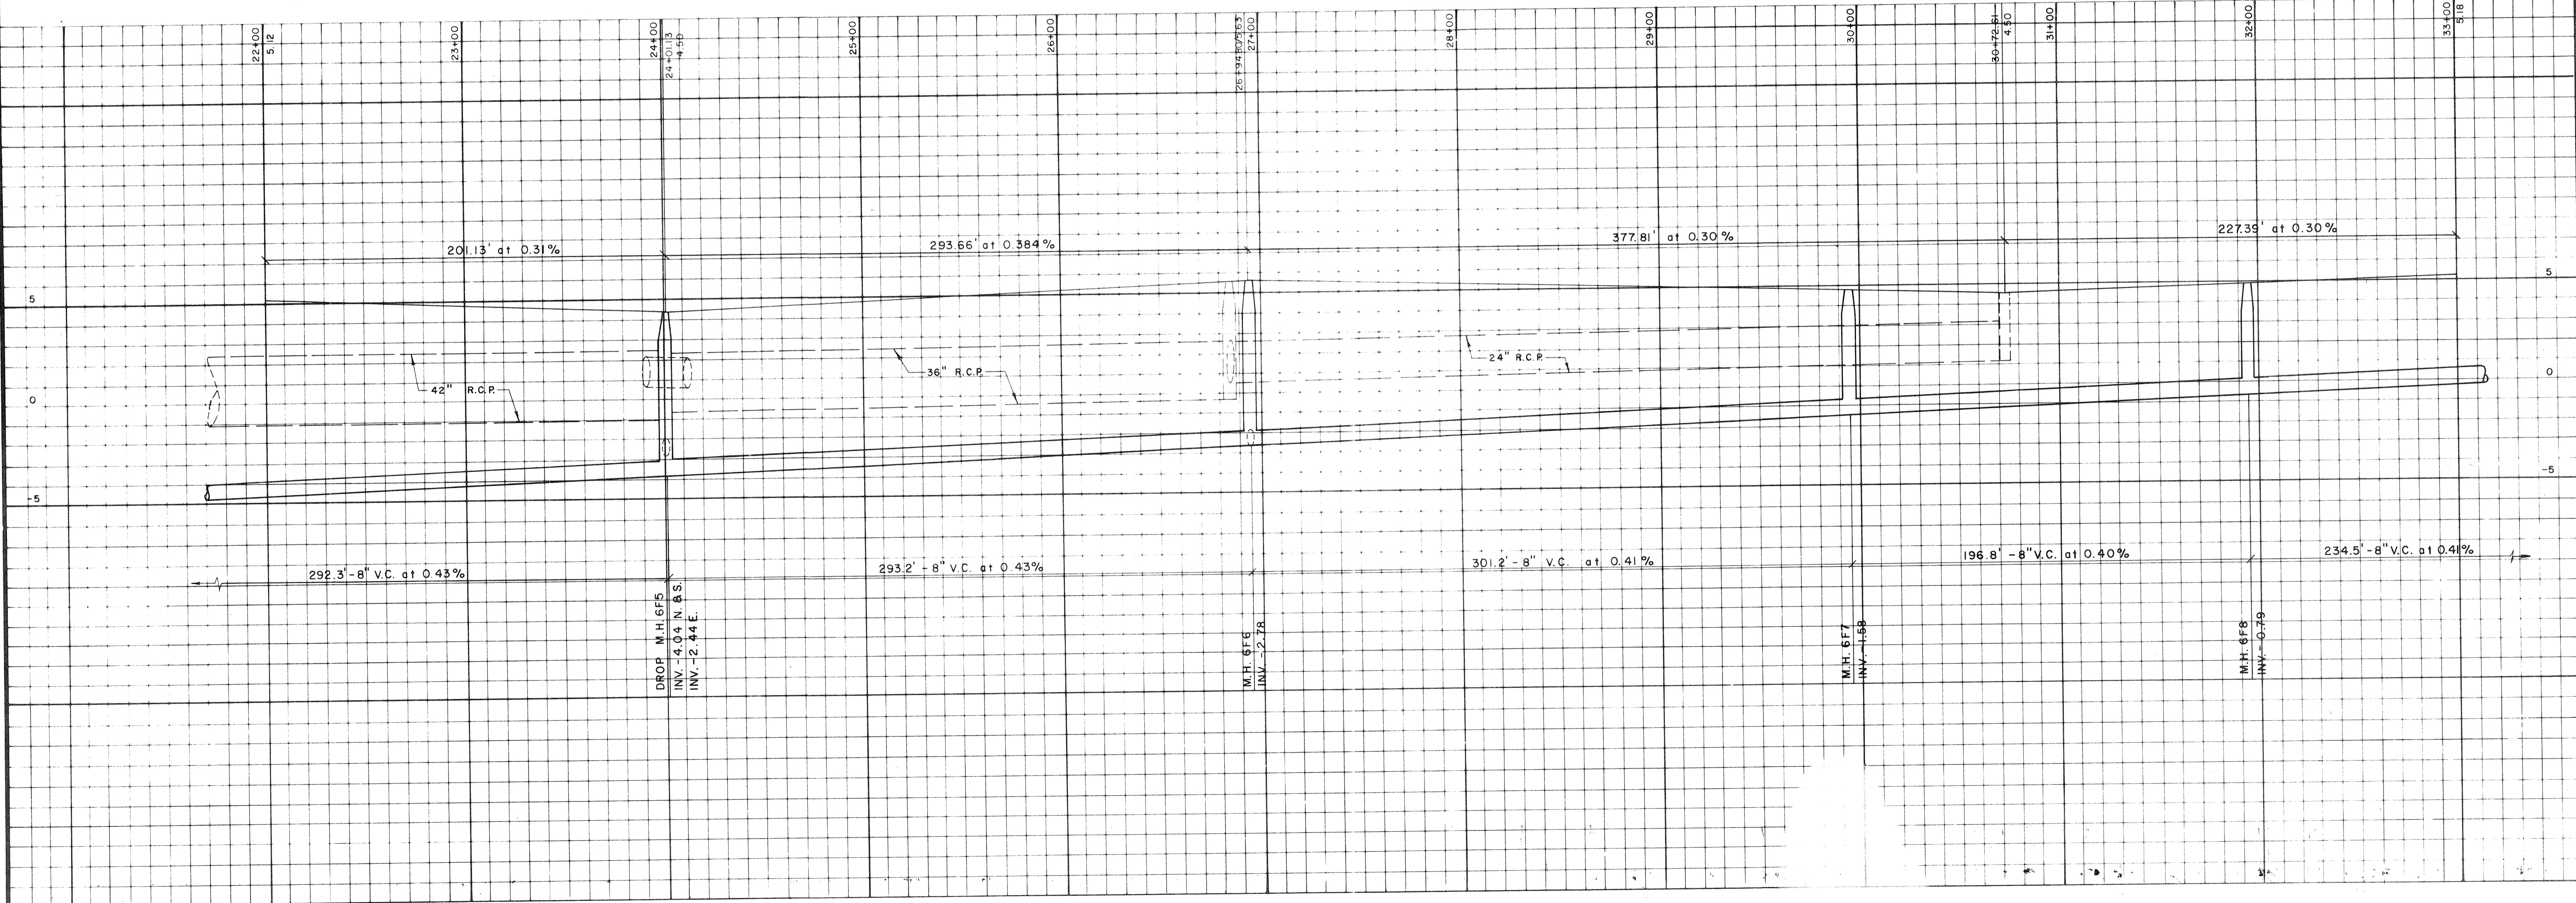

TOWN OF LONGBOAT KEY, FLORIDA
 WATER DIVISION
 PROJECT NO. 191-139 AB
 SHEET NO. 191-139 AB
 REVISION:

DATE	DESIGNED BY	PROJECT ENGINEER
11-14-40	BY	CHECKED BY PROJECT NO.
11-14-40	BY	CHECKED BY PROJECT NO.

L.T.R. DATE
 REVISION
 SCALE: HOR. 1"=40' VER. 1"=4'
 DRAWN BY