





NOTE: ALL STATIONING FOR SANITARY MANHOLE'S; STORM CATCH BASIN'S & INLETS ETC. ARE GIVEN RELATIVE TO THE CENTERLINE STATIONING FOR THE PROPOSED ROADWAY.

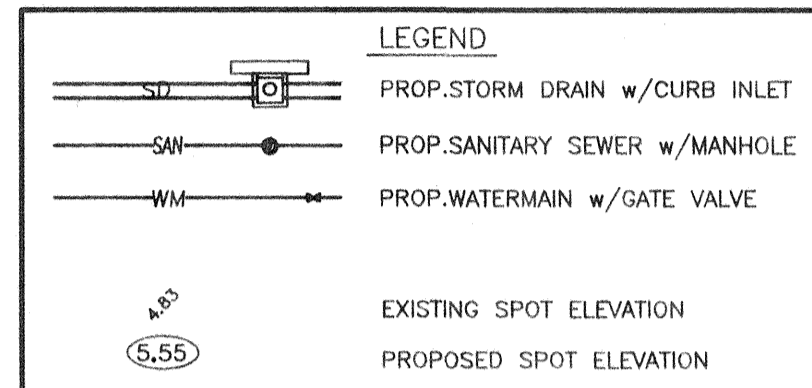

NOTE: ALL CURB IS TYPE "K" CURB UNLESS OTHERWISE NOTED

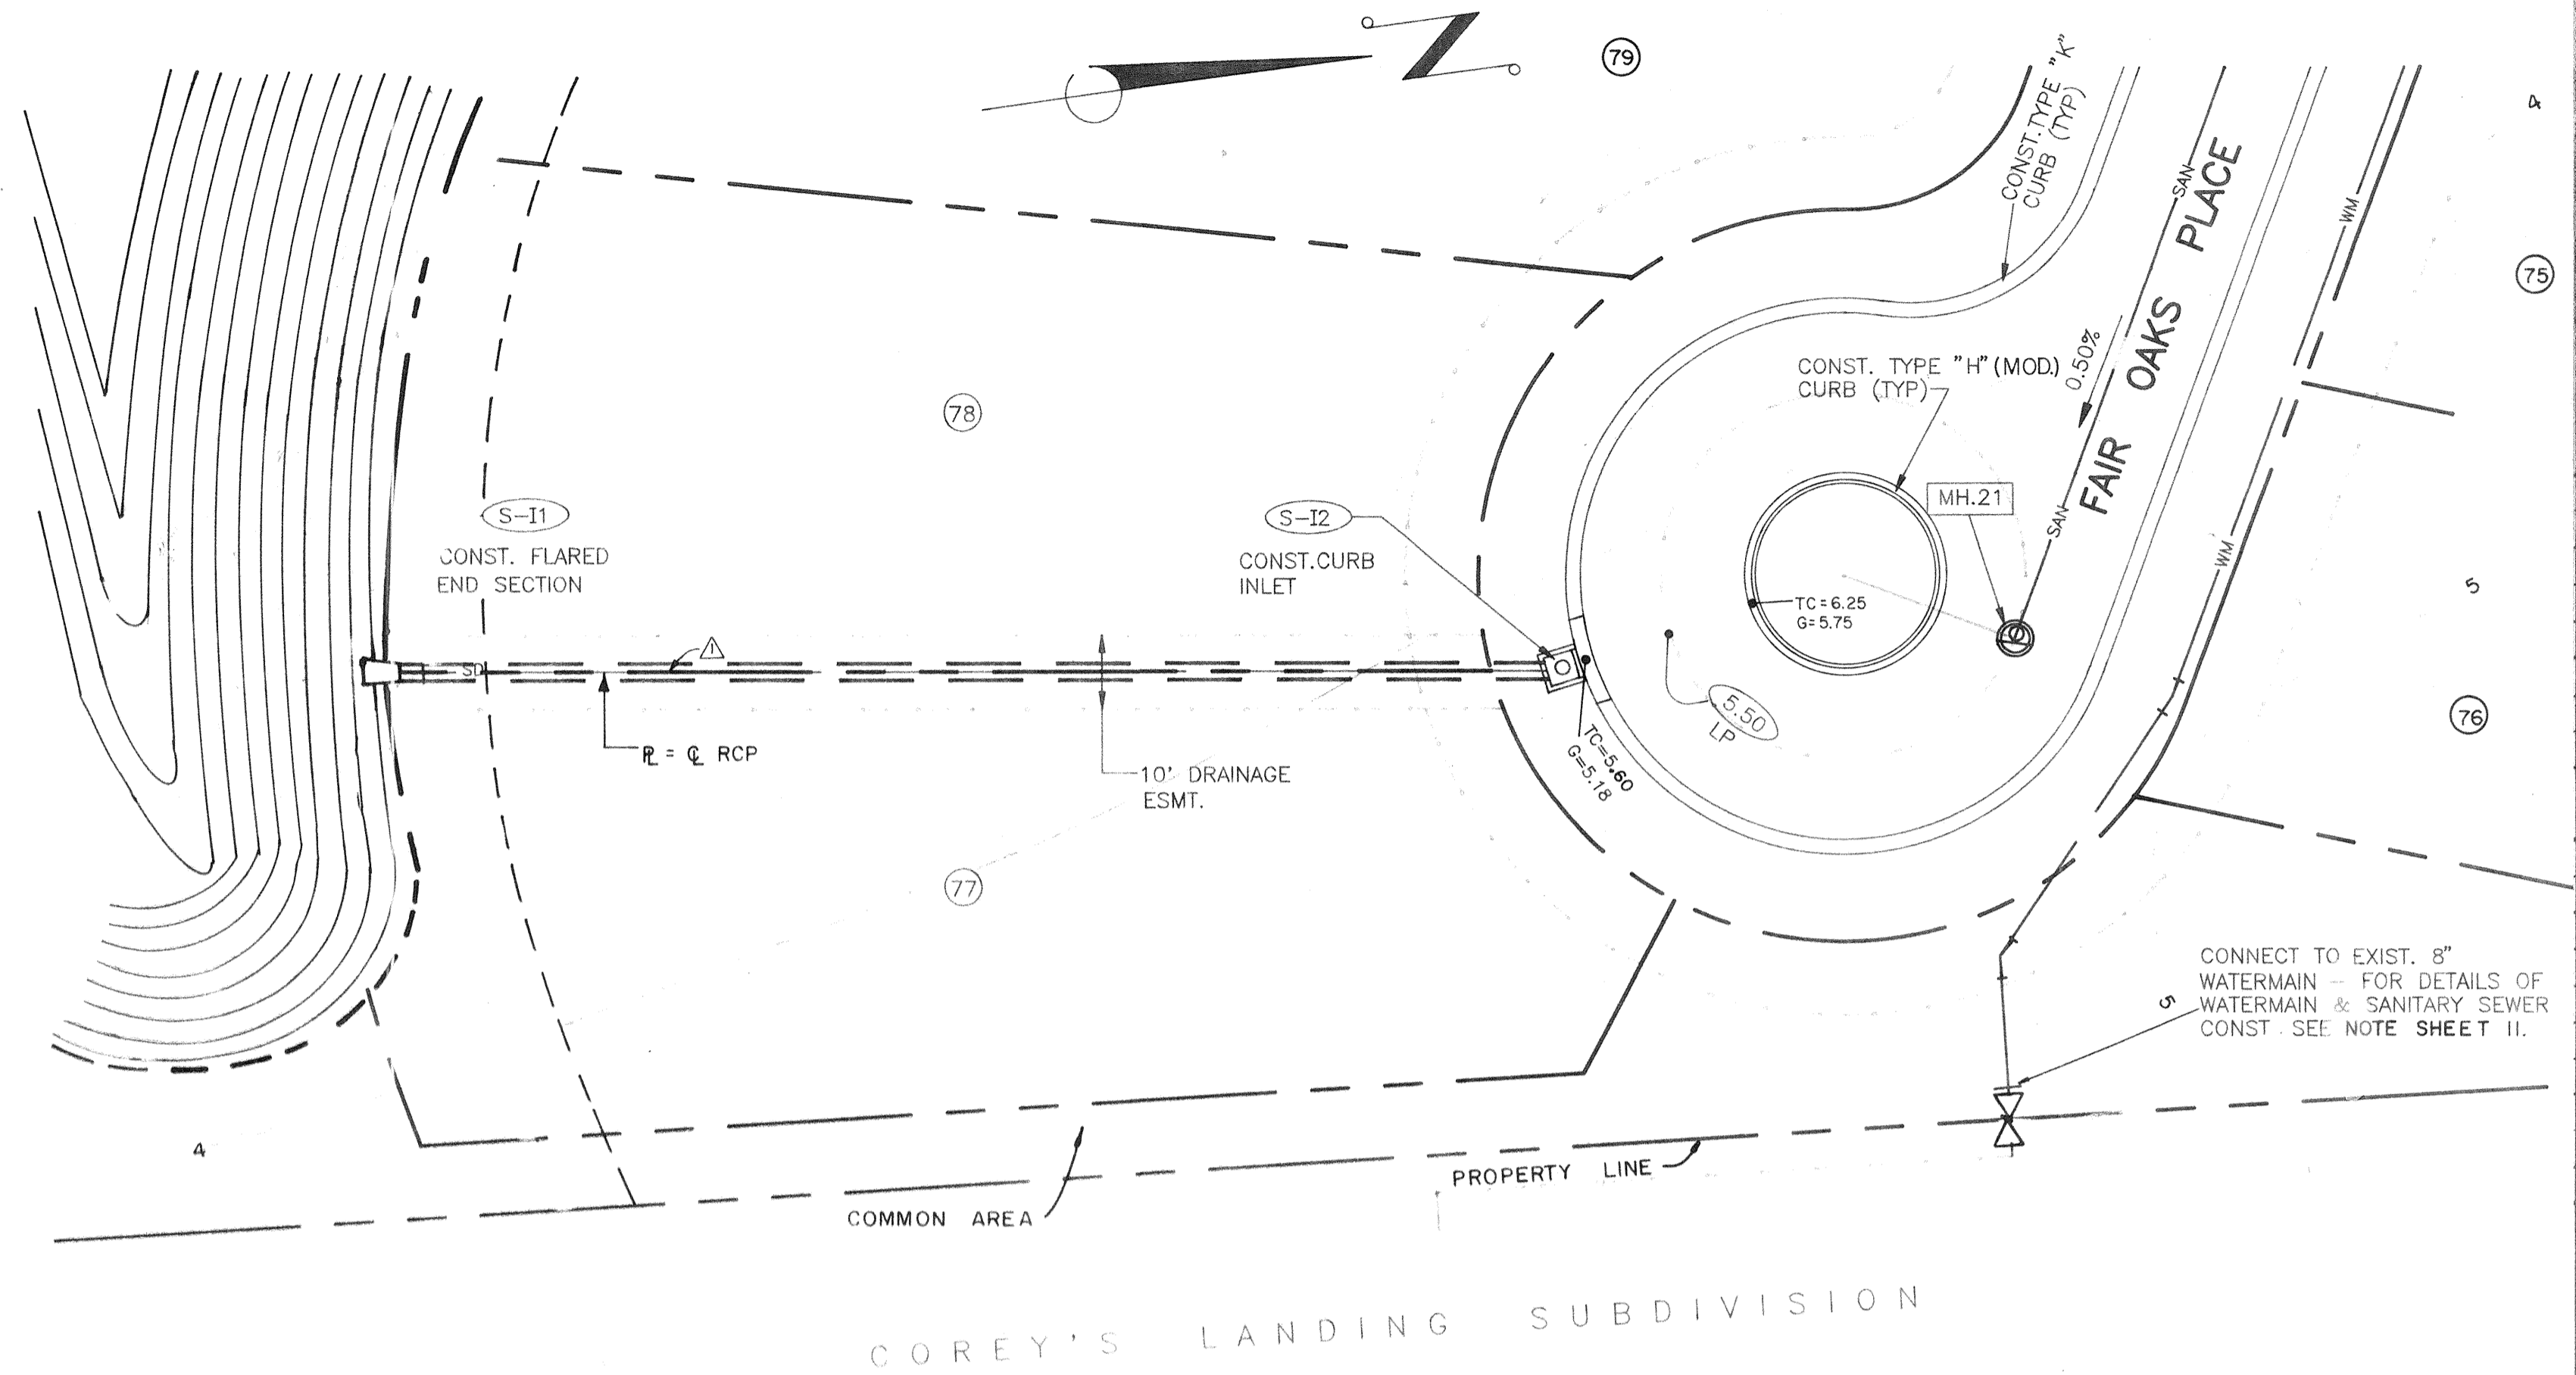

SCALE:  
 HORZ. 1" = 20'  
 VERT. 1" = 4'

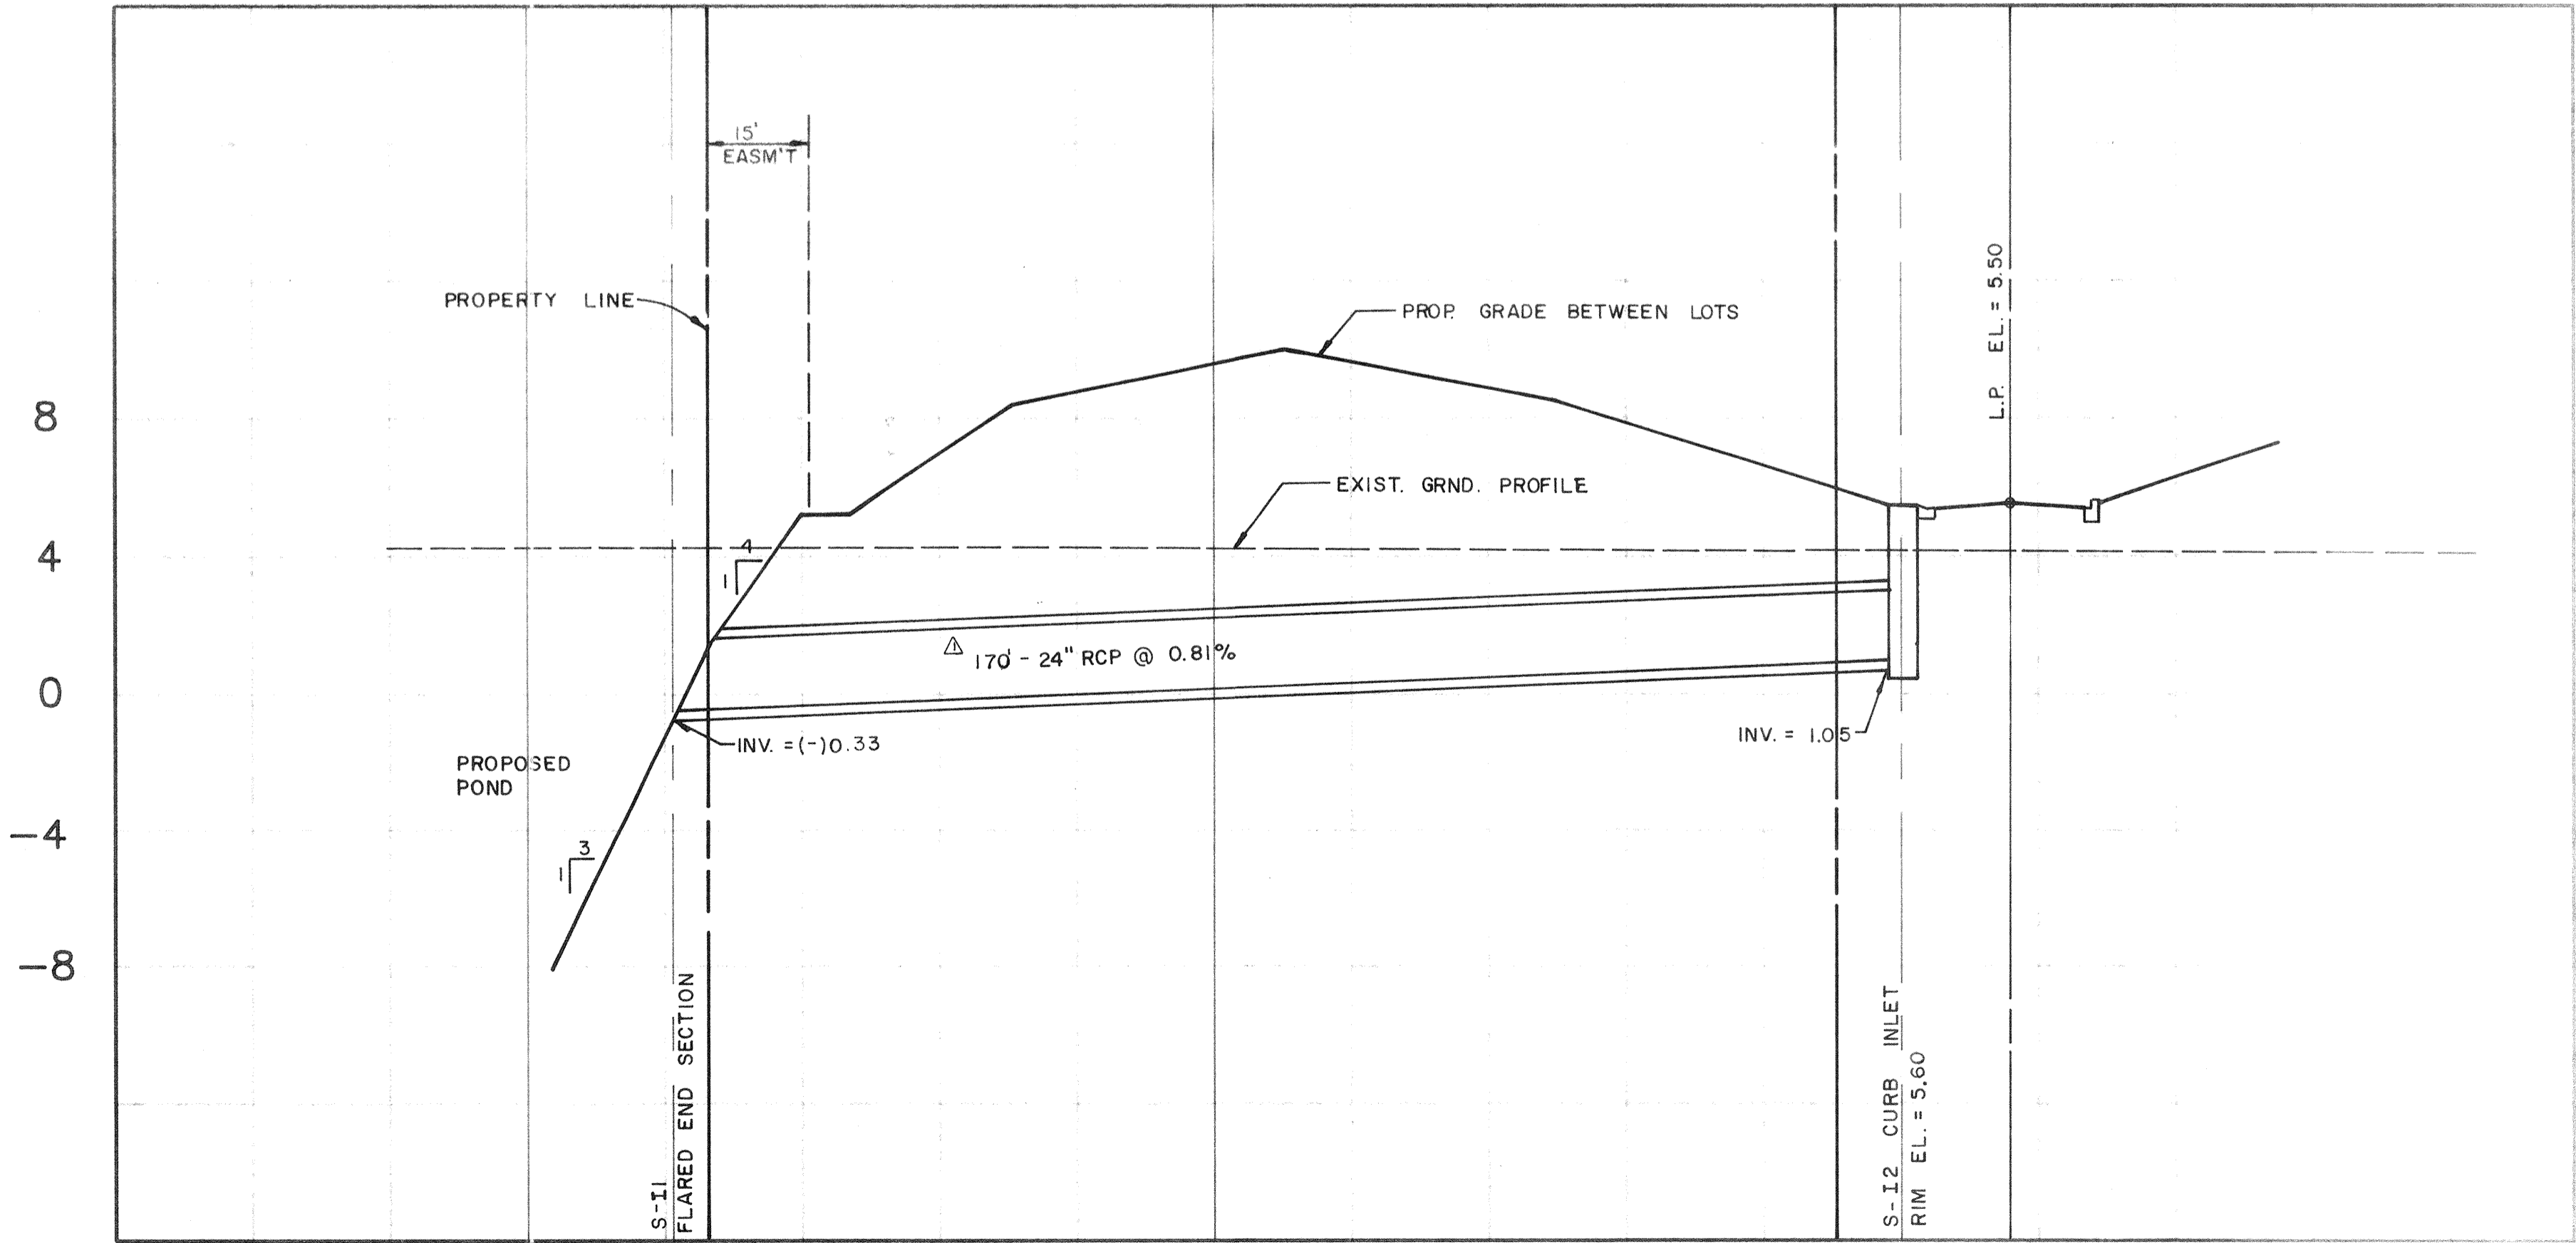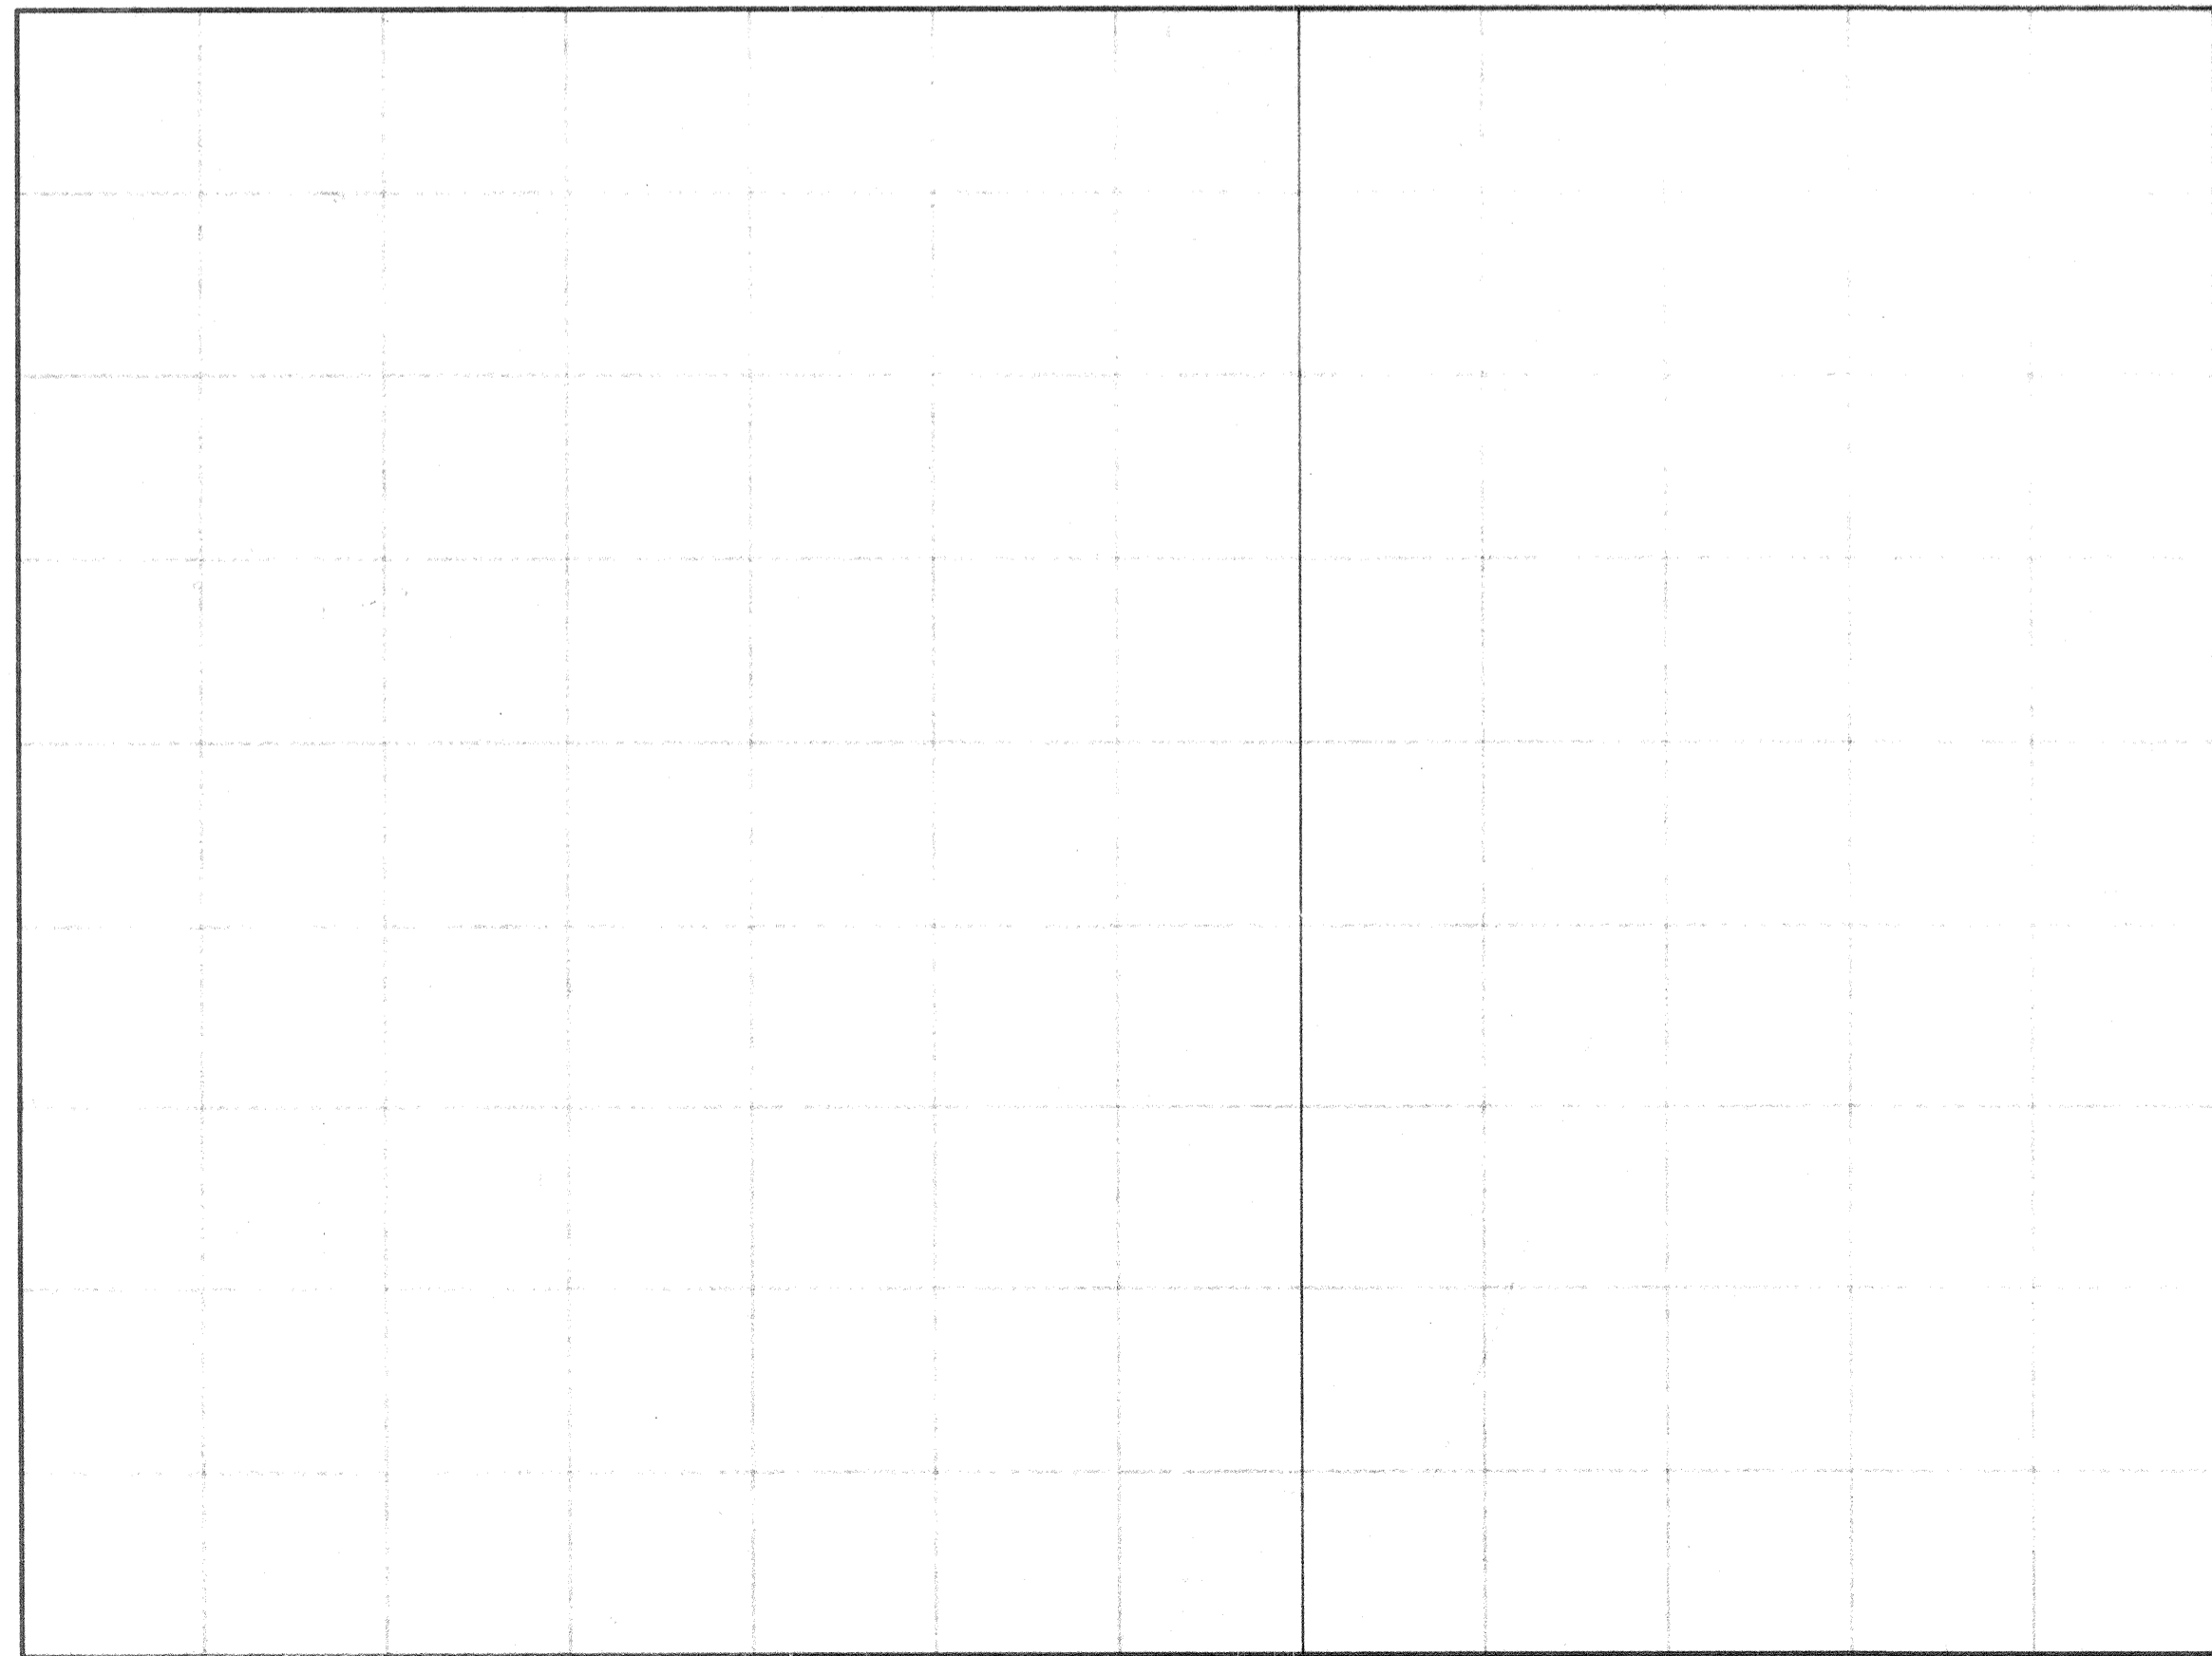

NOTE: FLARED END SECTIONS SHALL BE F.D.O.T. INDEX NO. 270.

BY	SCALE:	DATE:	DESIGNED BY
	1" = 20'	9-8-89	S.R.
REVISION	DRAWN BY	CHECKED BY	PROJECT NO.
	R.W.C.	PP/C/J/SR	DBDS-0018
L.T.R.	DATE	PROJECT ENGINEER	
		TOWN OF LONGBOAT KEY, FLORIDA	
		MANCHESTER BAY	
		DIAMOND - CARVER, INC.	
		AS-BUILT RECORD DRAWING OF STORM SEWER	
		BISHOP & ASSOCIATES, INC. CONSULTING ENGINEERS - SURVEYORS	
		78 Sarasota Center Blvd.	Sarasota, Florida 34240
			Ph (813) 371-6362