


REVISION	BY	DATE	DESIGNED BY	PROJECT ENGINEER
5				
0500-0000				
PROJECT NUMBER				
LOCATION				
ENGINEER				
TOWN OF LONGBOAT KEY, FLORIDA				
DATE				
BY				
SCALE				
DRAWN BY				
H. 1:40				
3-21-88				
CHECKED BY				
PROJECT NO.				
0500-0000				
CONSULTING ENGINEER: STURGEON				
18 SARASOTA CENTER BLVD.				
SARASOTA, FLORIDA				
WILLIAM F. BISHOP & ASSOCIATES, INC.				
SAINT LARA & STORM SEWER PROFILES RECORD DRAWING				
FAIRWAY BAY - PHASE III				
BRIDA CORPORATION				
M-2 8 8 8				
PROJECT ENGINEER				

STORM SEWER PROFILES



SANITARY SEWER PROFILES

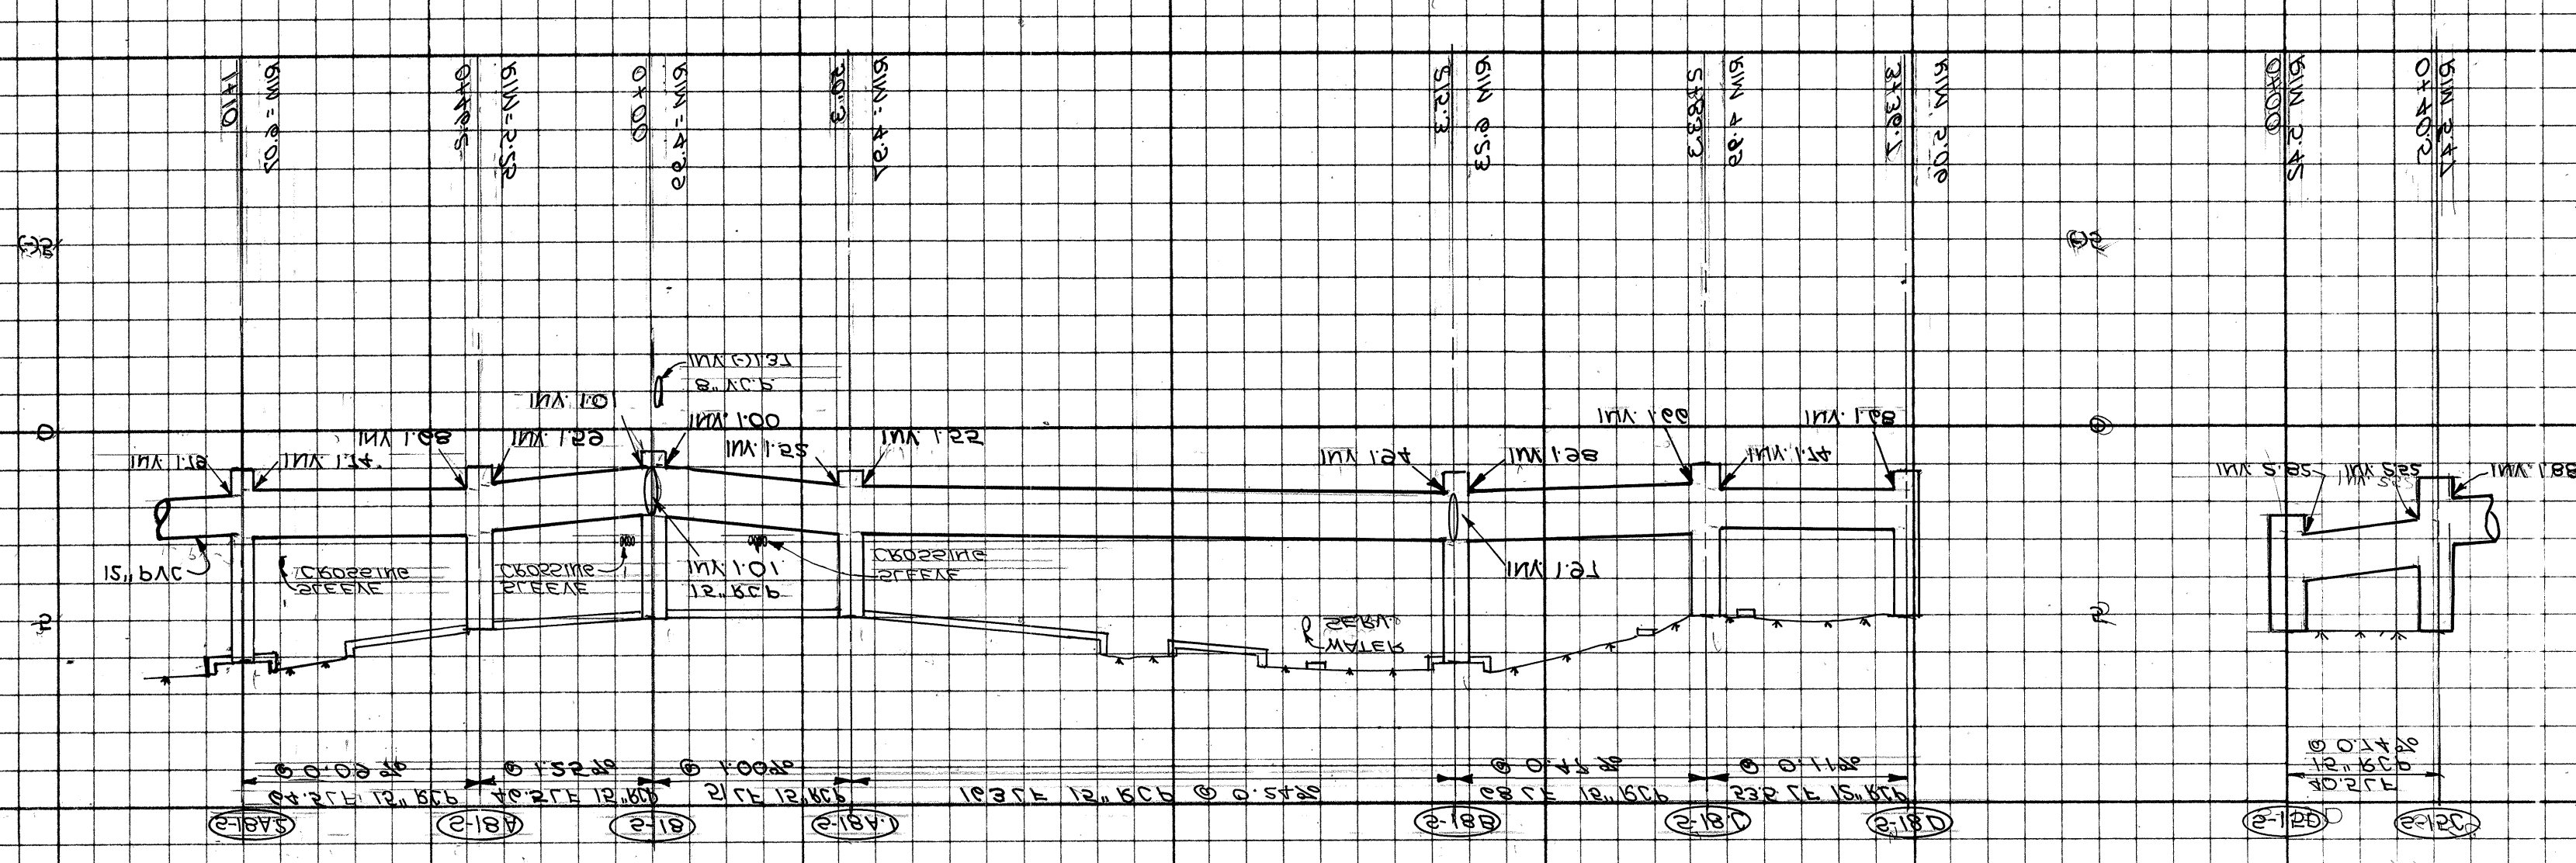