

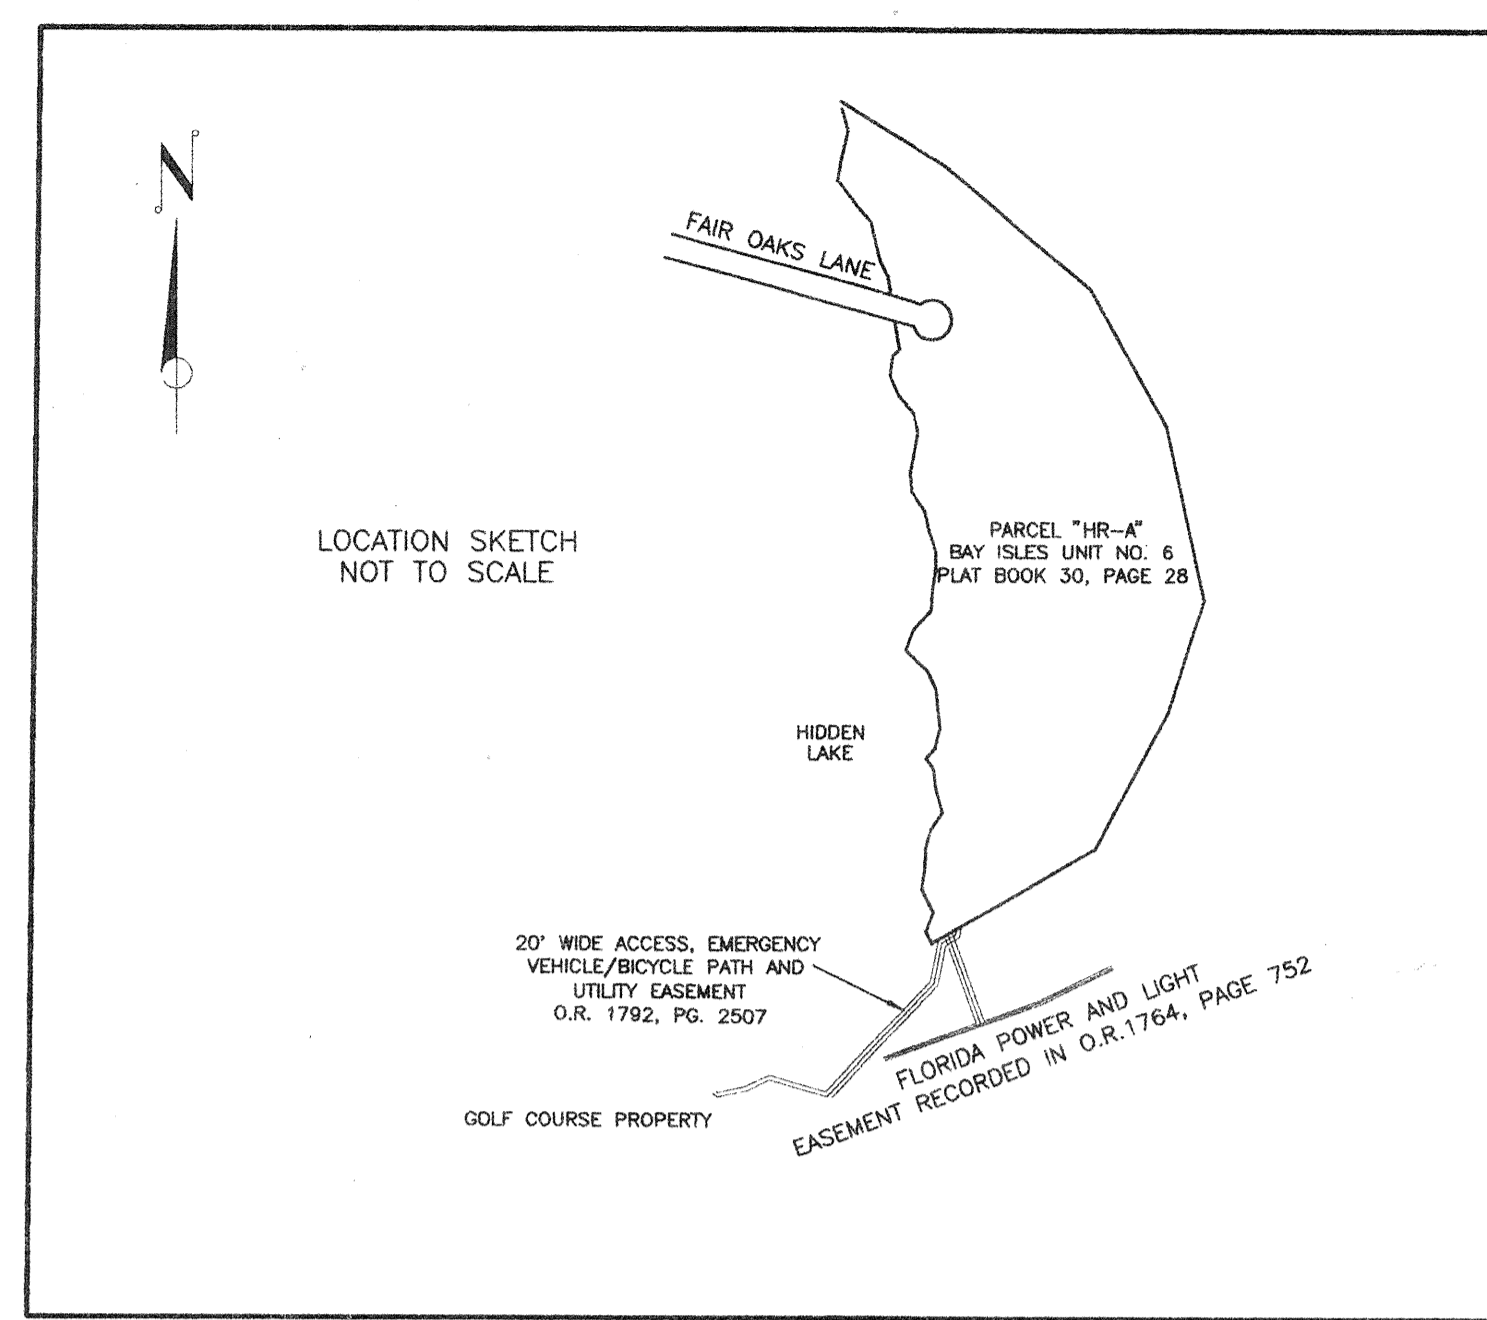




PLAT BOOK NO. 30
 PLAT DATE 10/08/93
 CAD FILE 20100809.DWG

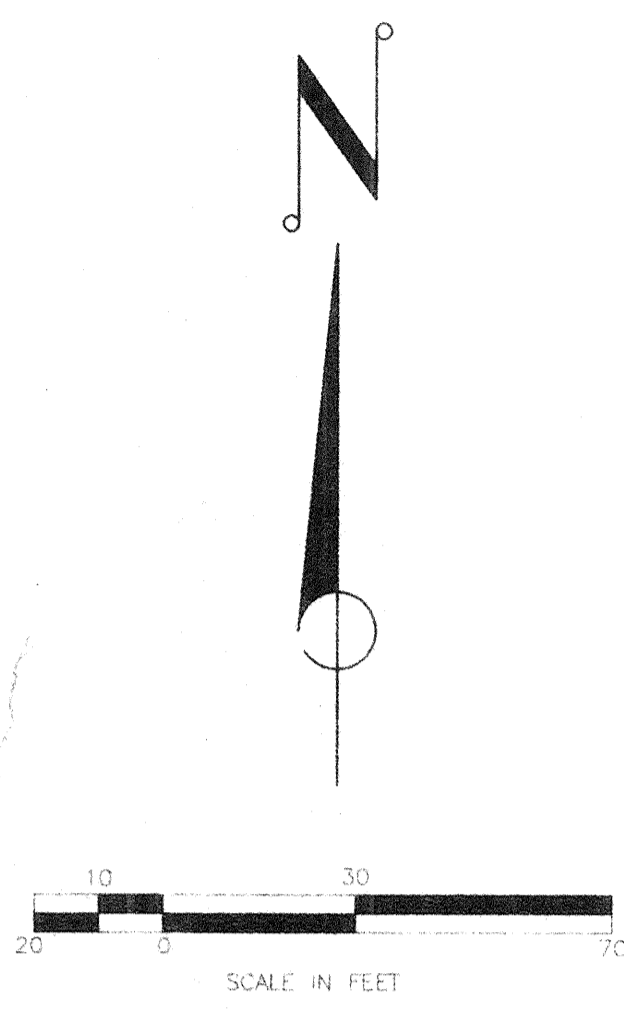

PARCEL "HR-A"
 BAY ISLES UNIT NO. 6
 PLAT BOOK 30, PAGE 28

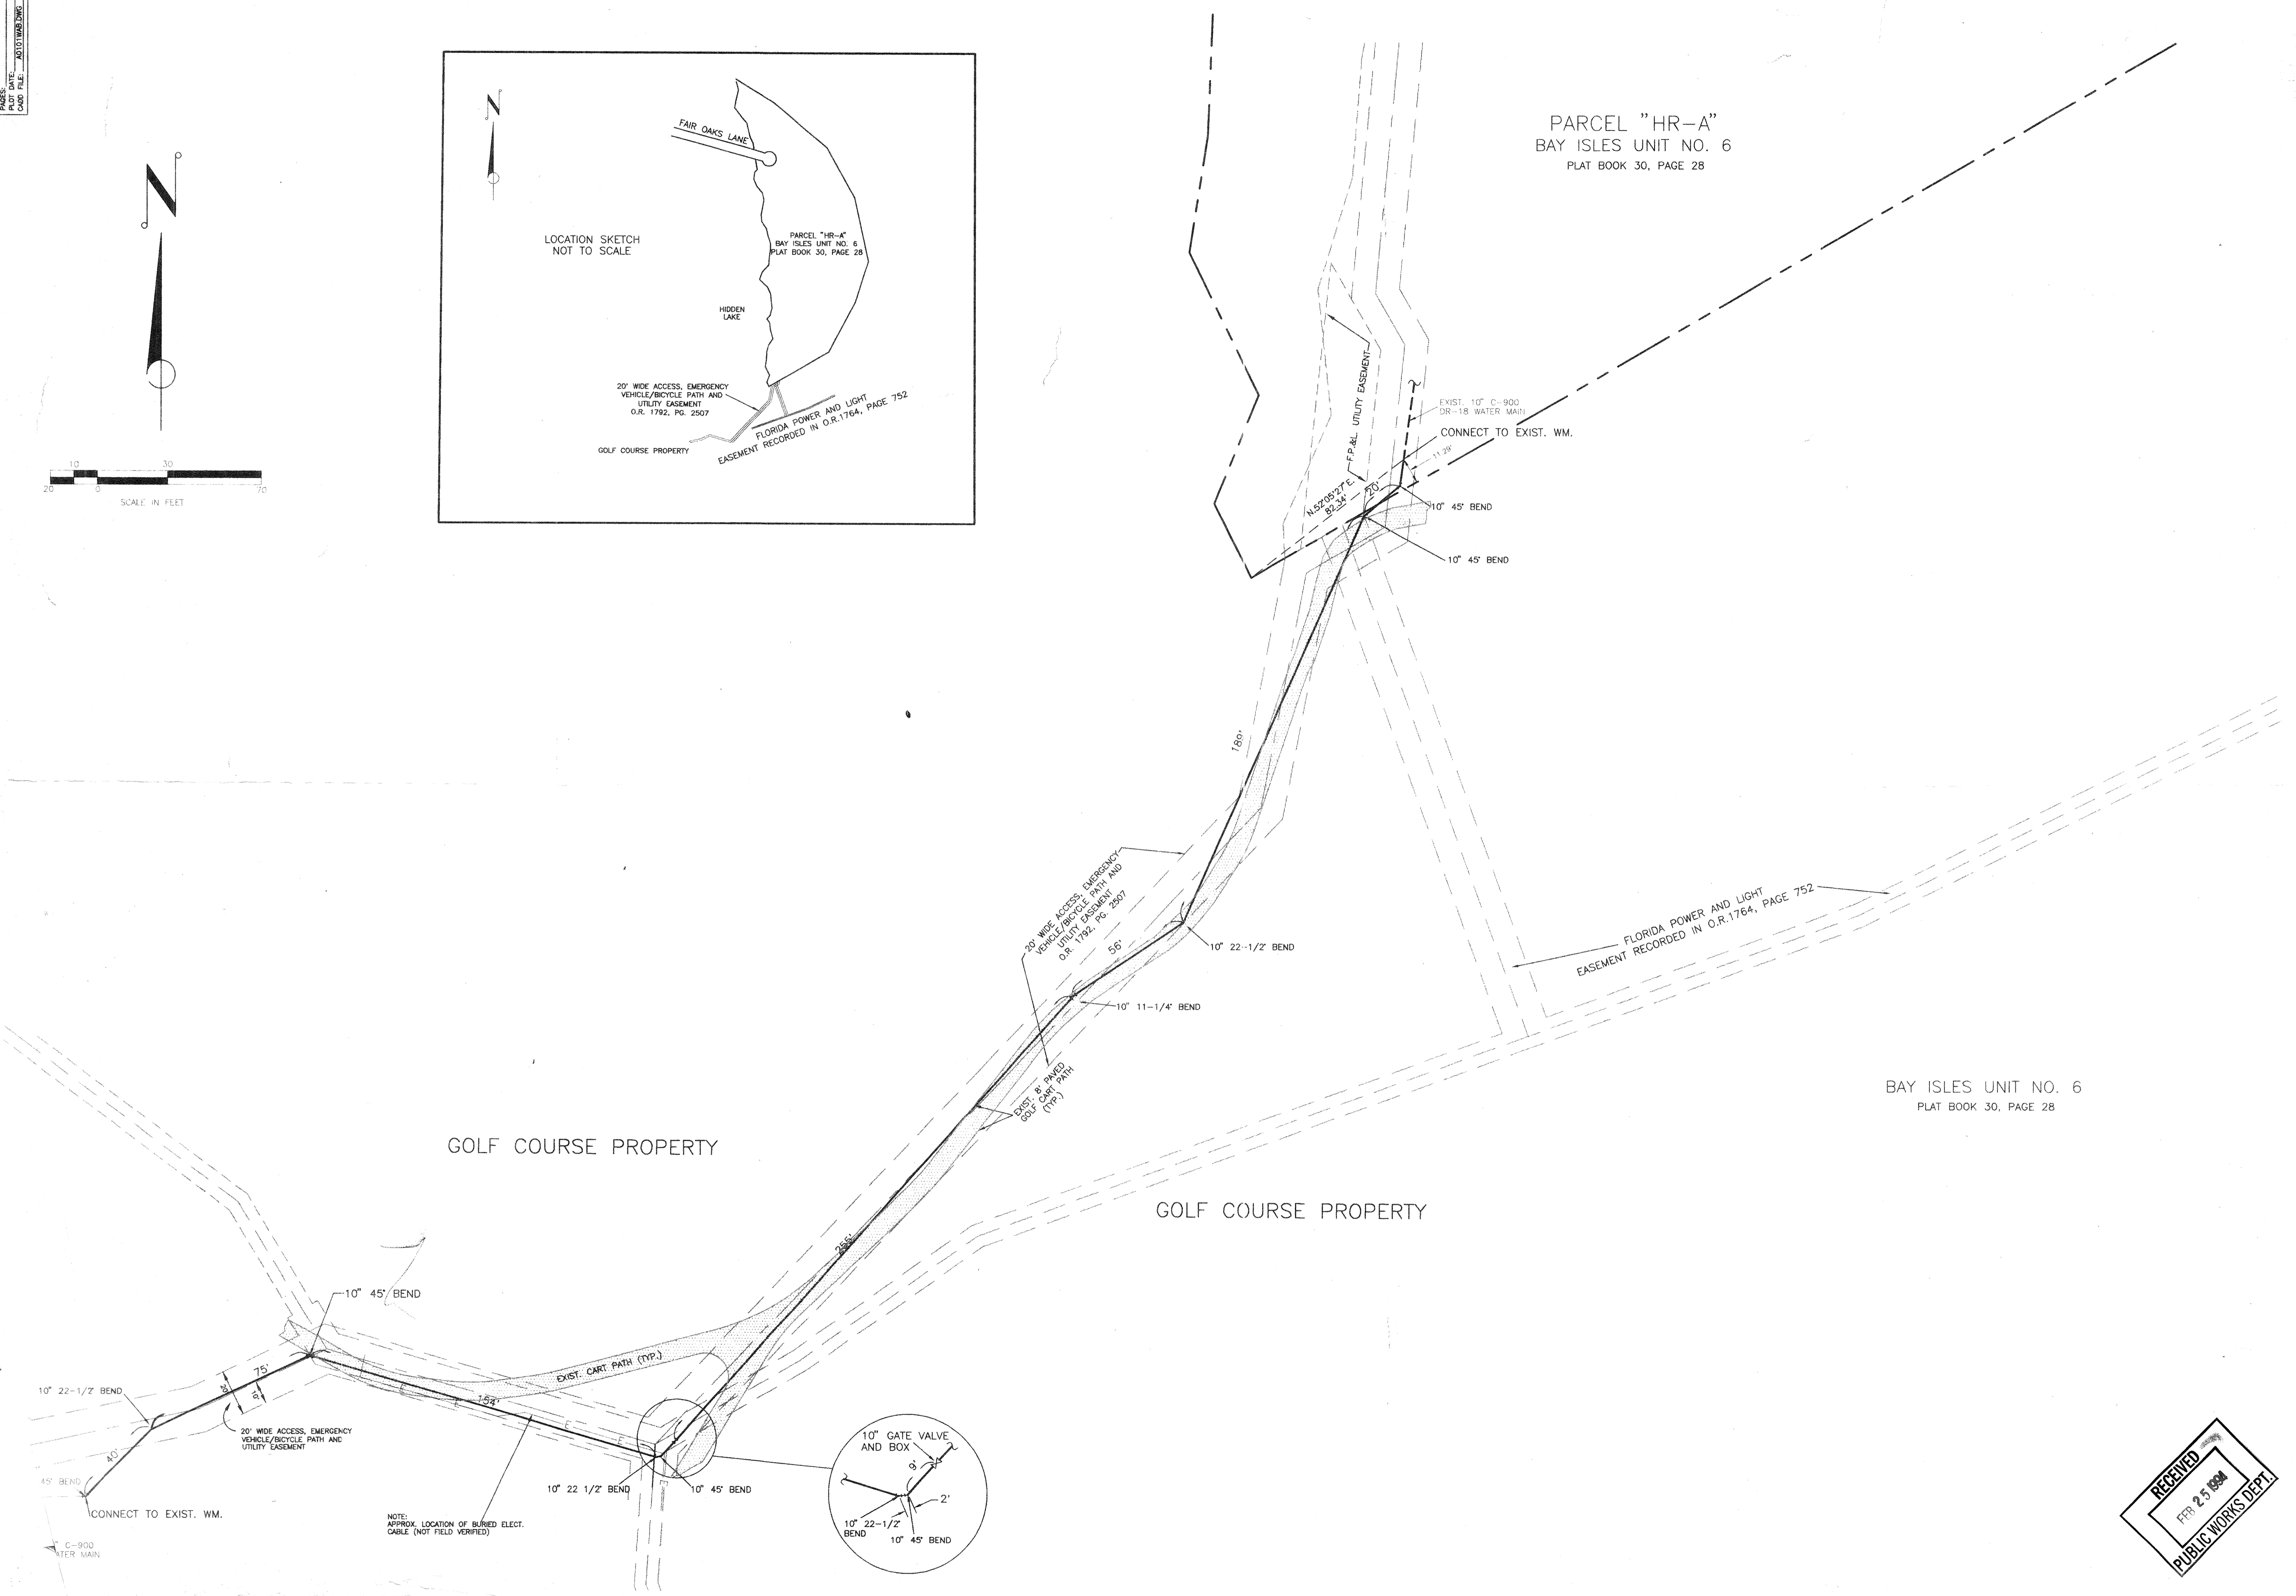

NOTE: APPROX. LOCATION OF BURIED ELECT. CABLE (NOT FIELD VERIFIED)

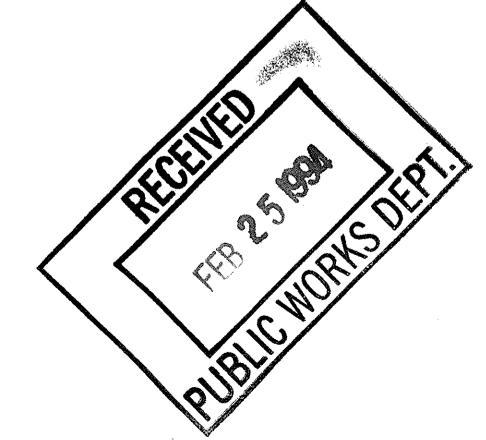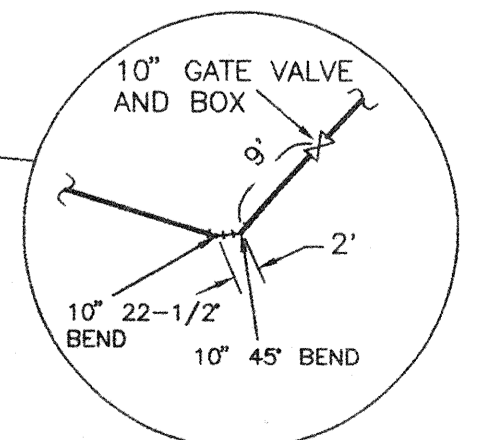

PROJECT ENGINEER <i>[Signature]</i> 4/27/94	DESIGNED BY	DATE: 10/08/93	REVISION	L.T.R.	DATE	TOWN OF LONGBOAT KEY, FLORIDA
PROJECT NO. A00101	CHECKED BY G.K.L.	SCALE: 1" = 30'				RECORD DRAWING WATER DISTRIBUTION SYSTEM ONLY
	DRAWN BY STAFF					GRAND BAY - ARVIDA/JMB PARTNERS
						LANDRY & ESBER 130 N. TAMiami TRAIL, STE. 301 SARASOTA, FLORIDA 34236 (813) 955-6004
						ENGINEER & LOCATION
						SHEET NUMBER 1 OF 1
						REVISION
						T.L.K. FILE NO.